

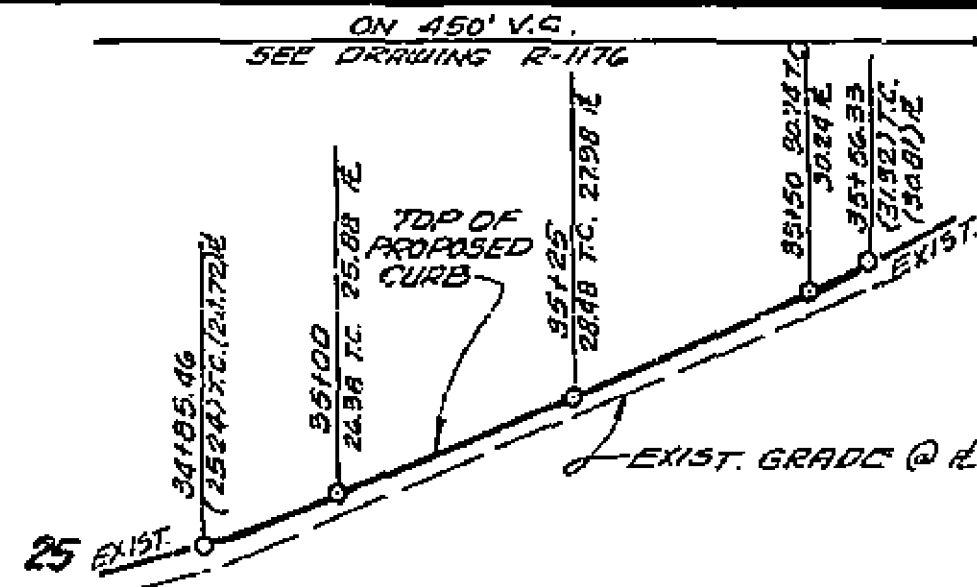


40 E

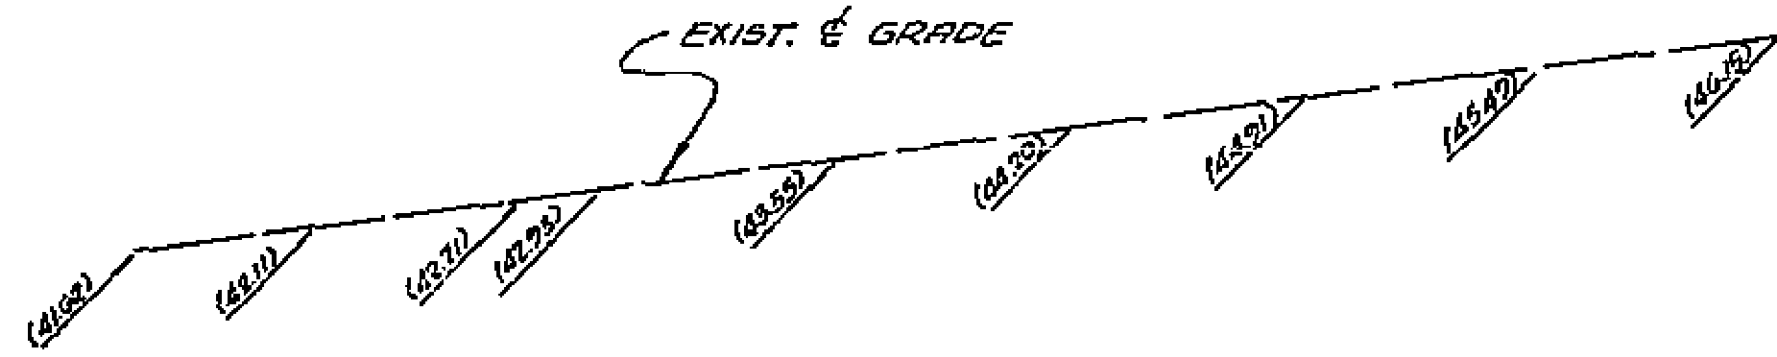


PROFILE 'B'

40 RT.

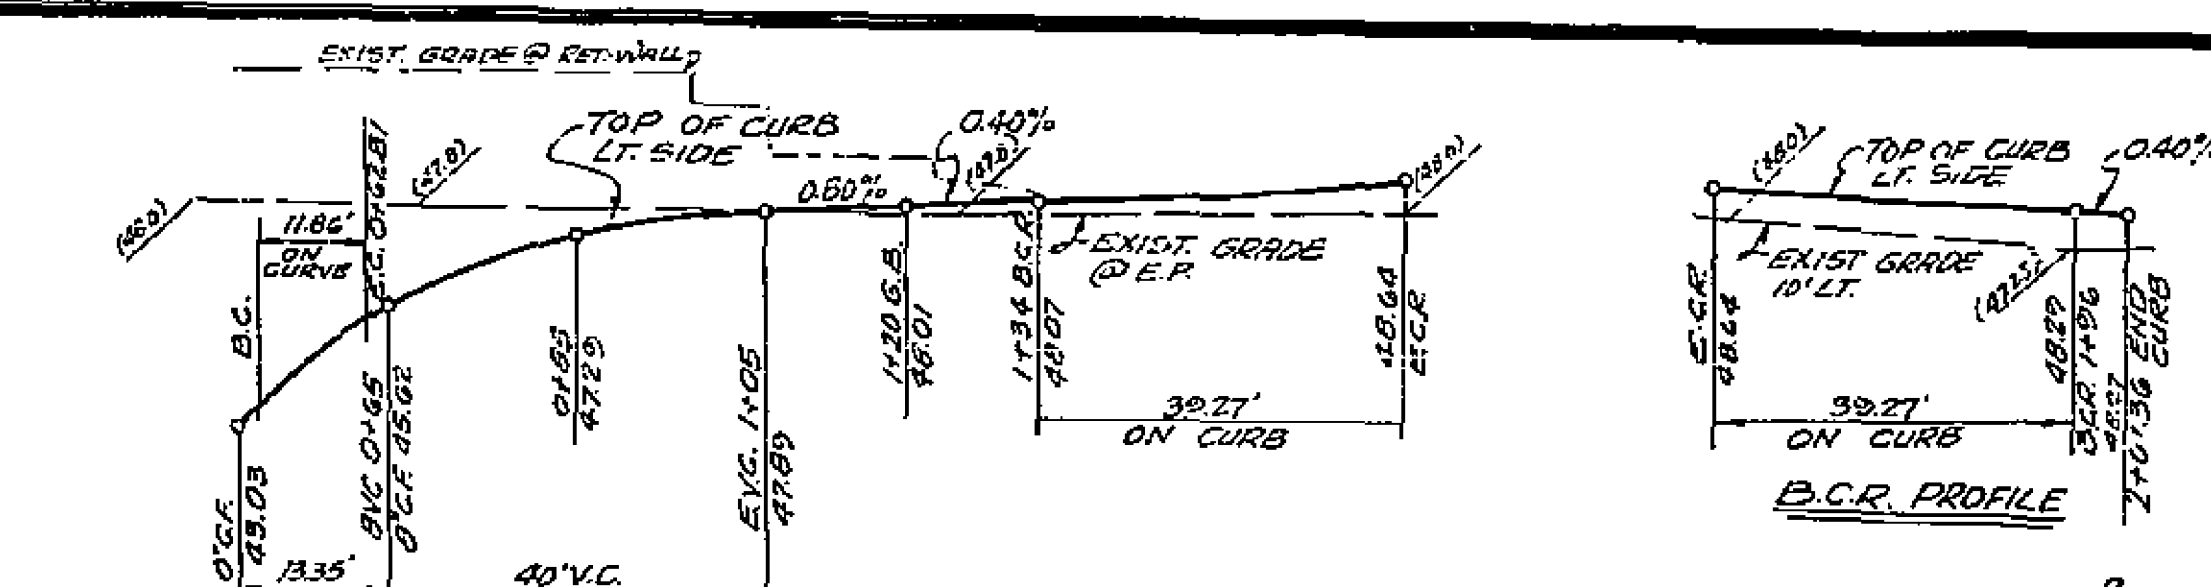


2

40 RT.

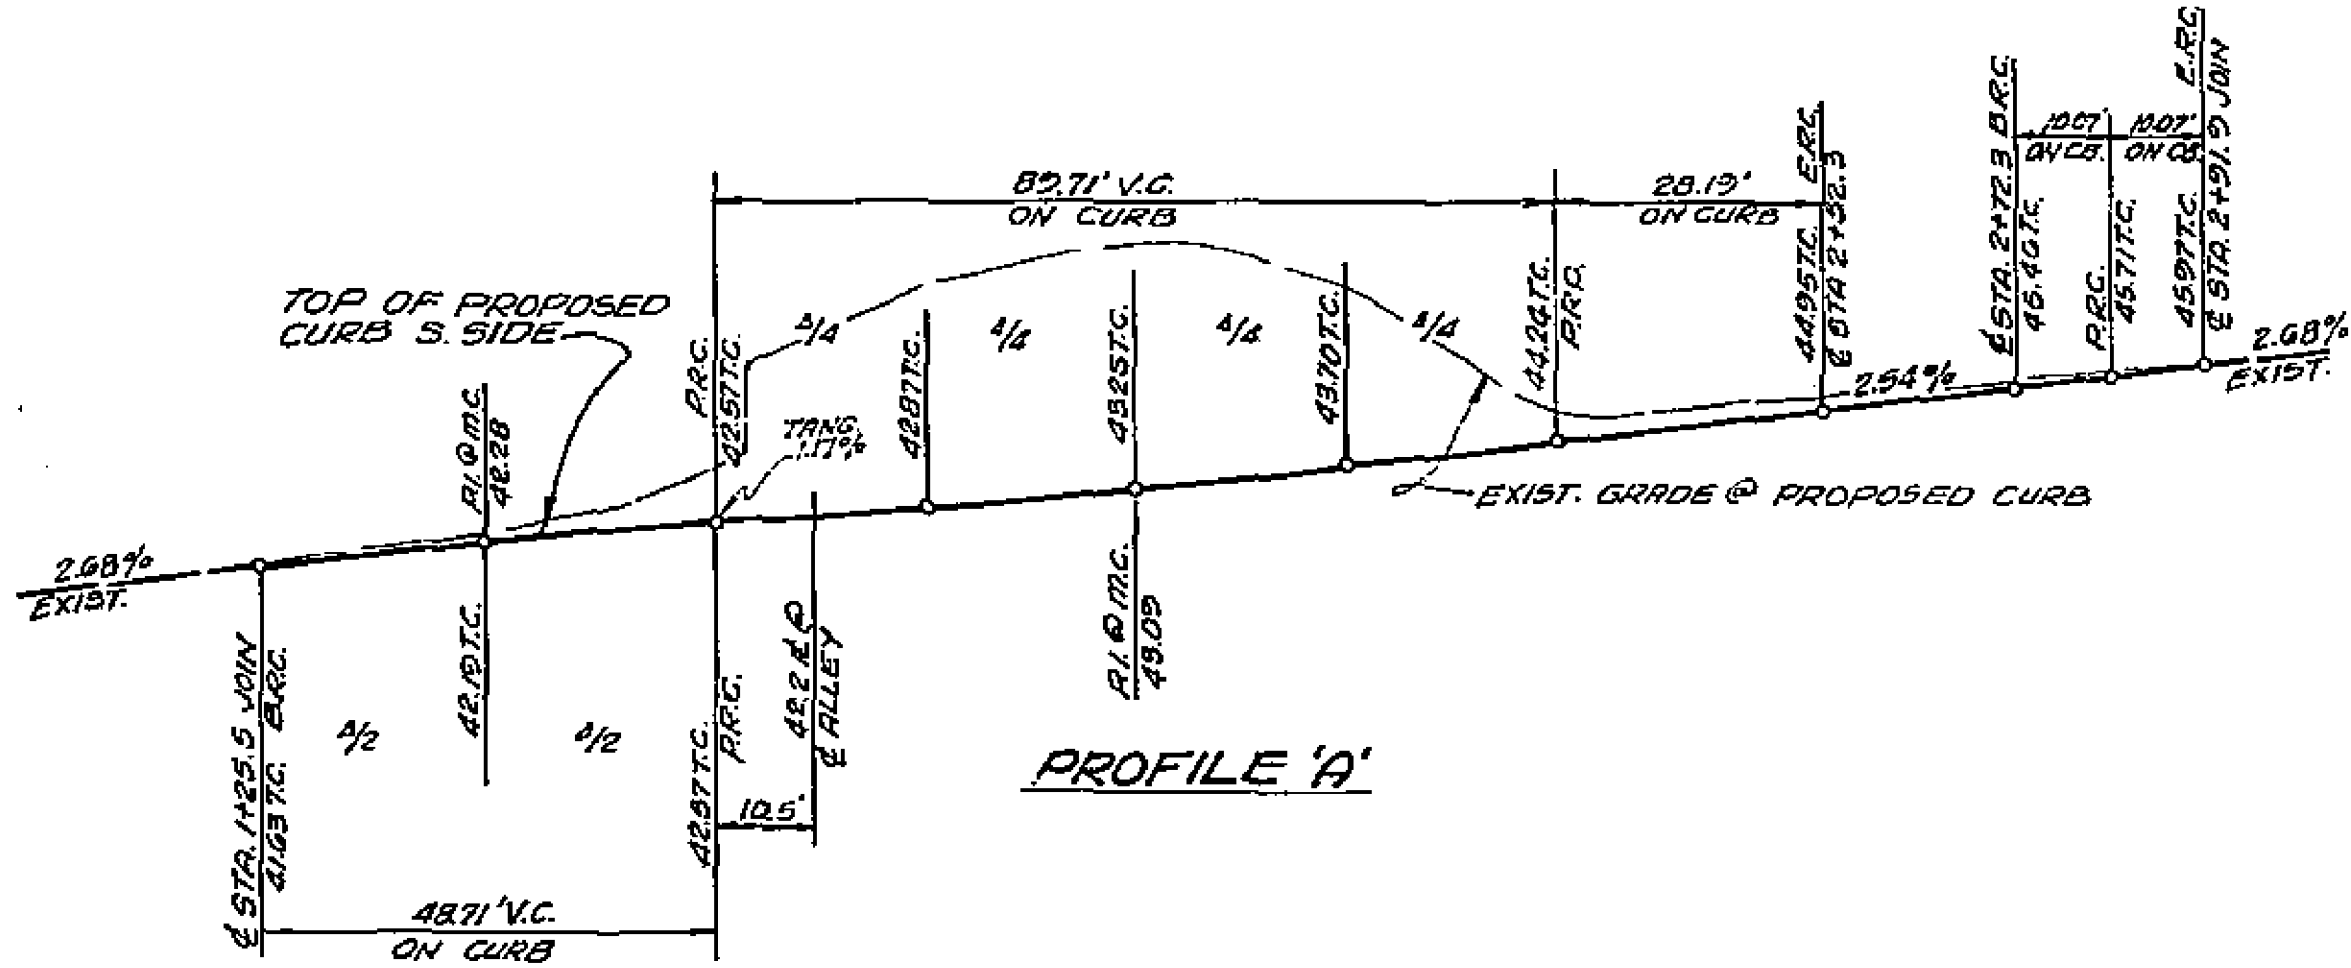


PROFILE 'A'

45 E

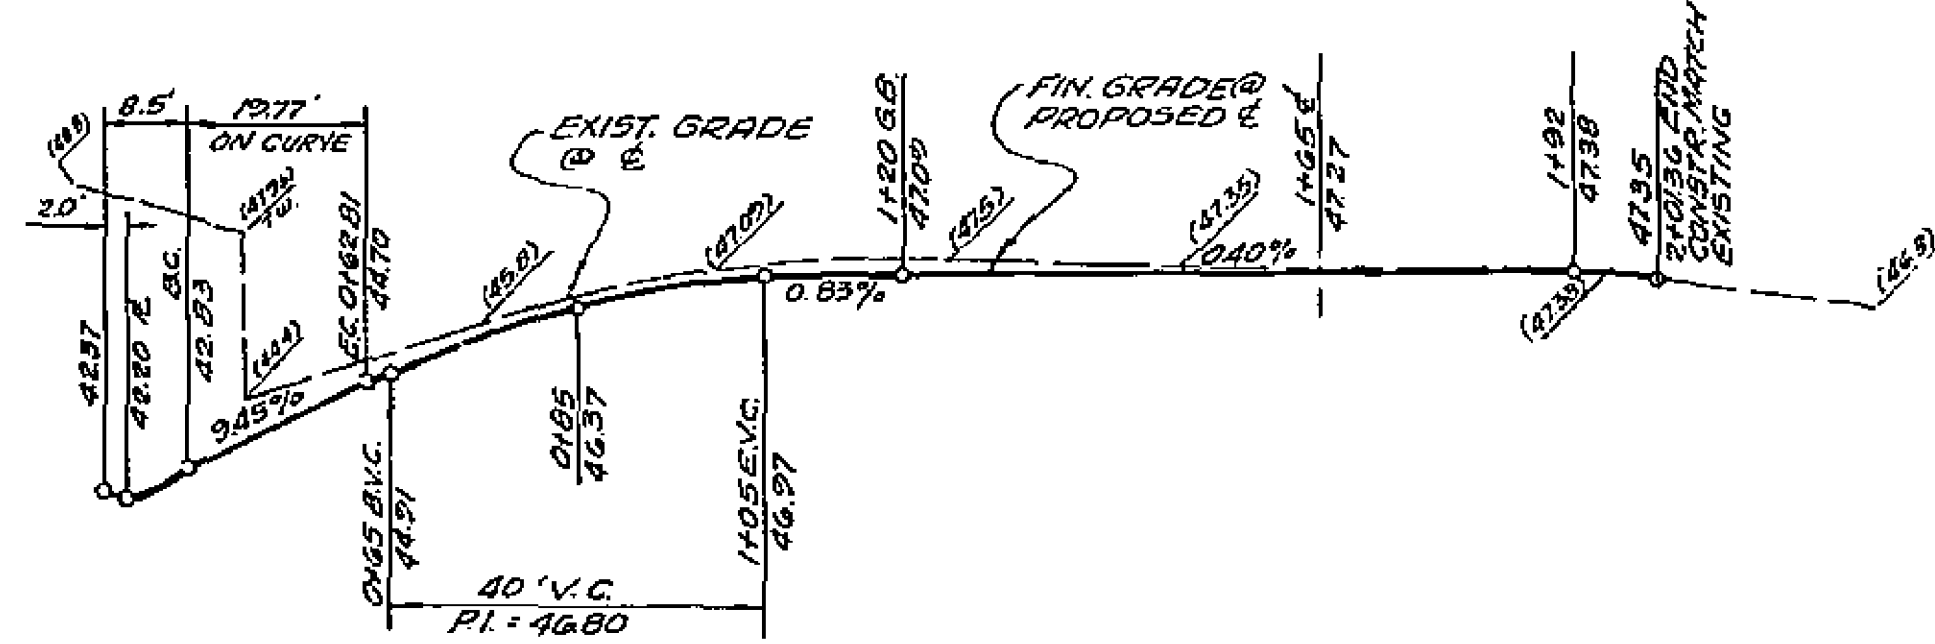

45 LT.

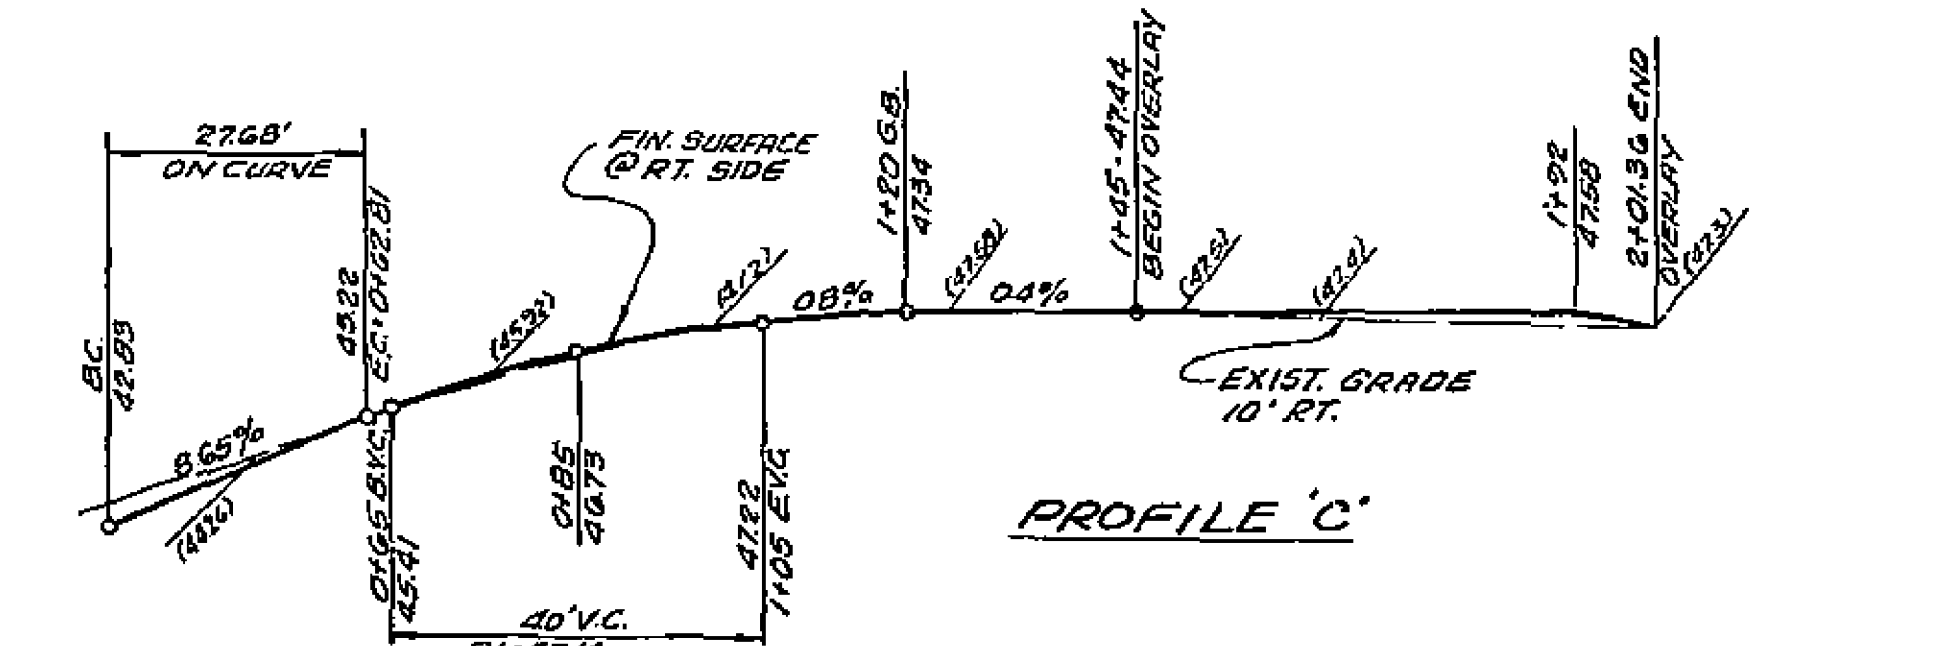

PROFILE 'C'

PROFILES


HORIZ: 1" = 20'

VERT: 1" = 4'

E CURVE DATA



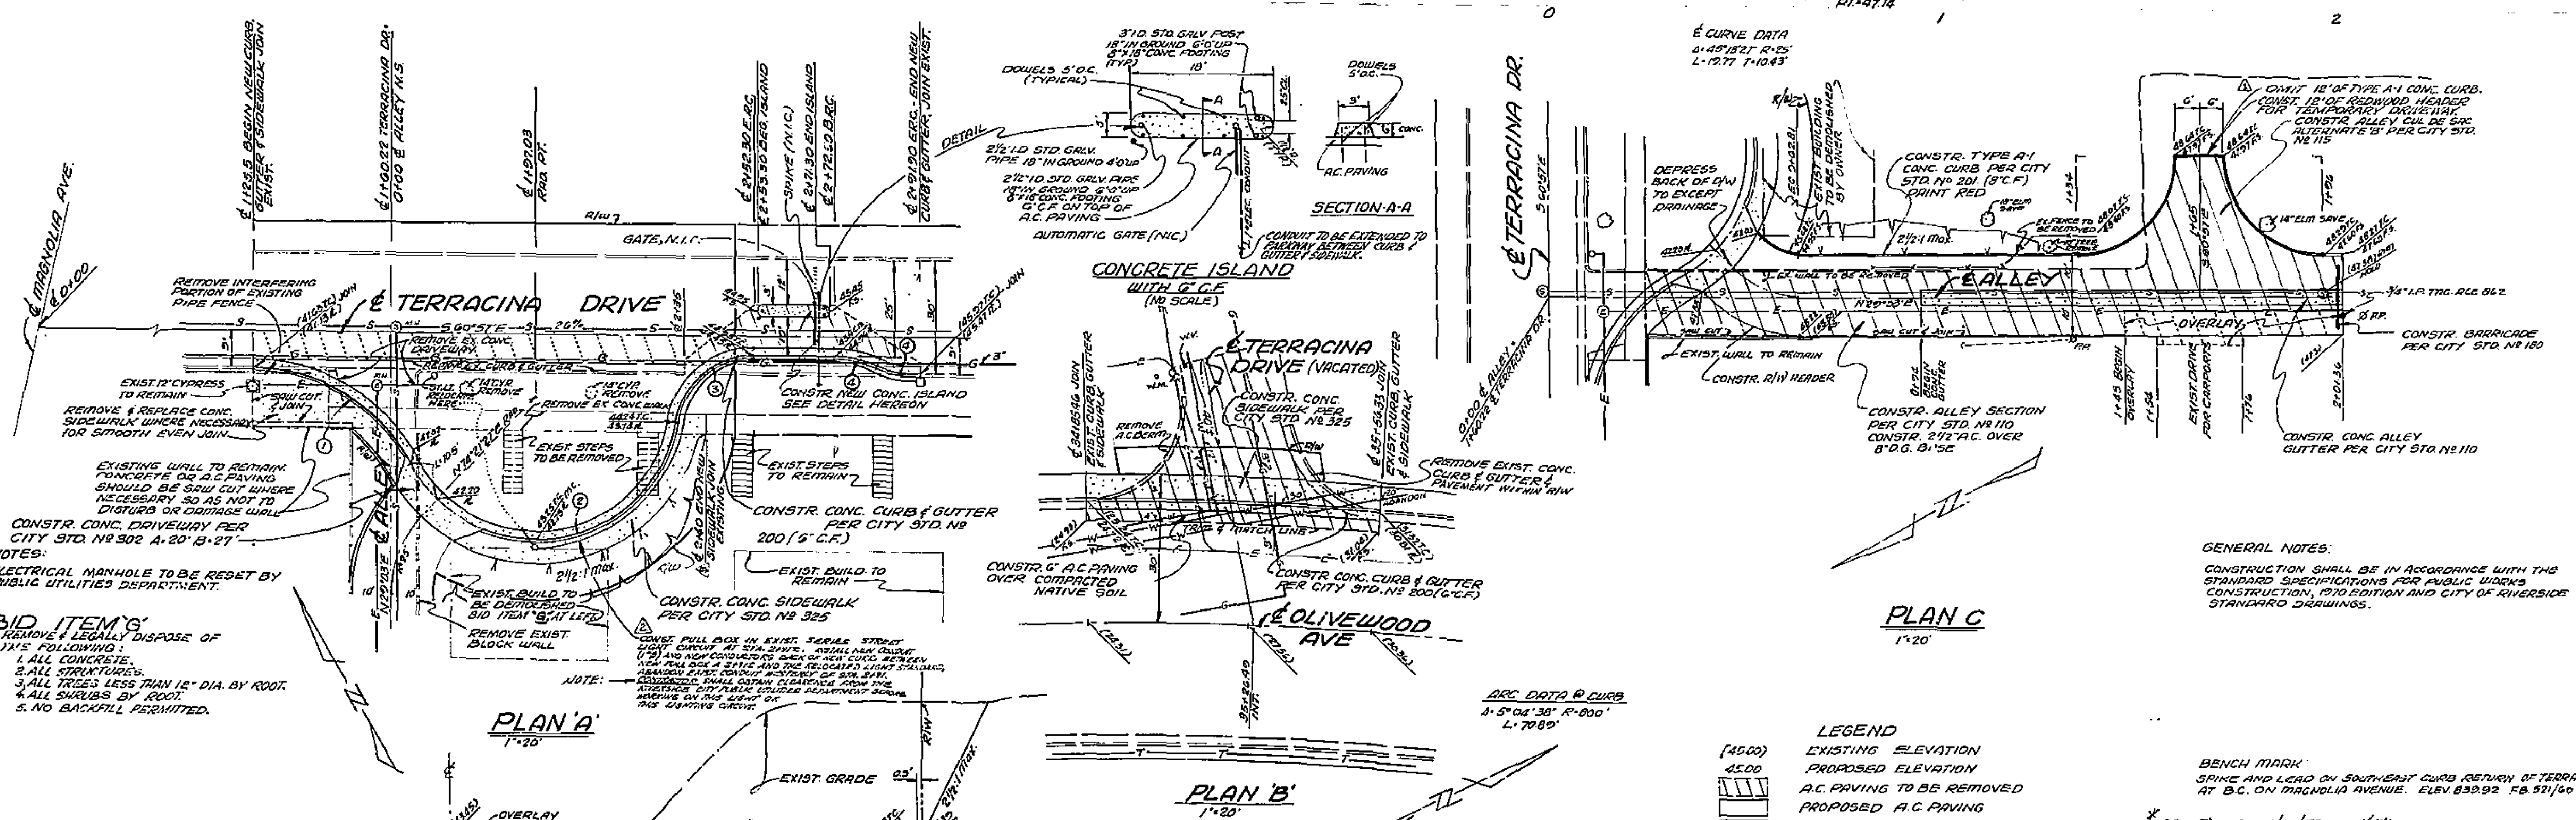

PLAN 'A'

PLAN 'B'

PLAN 'C'

- BID ITEM'S**
- REMOVE & LEGALLY DISPOSE OF 11/2" FOLLOWING:
 - ALL CONCRETE.
 - ALL STRUTS.
 - ALL TREES LESS THAN 12" DIA. BY ROOT.
 - ALL SHRUBS BY ROOT.
 - NO BACKFILL PERMITTED.

NOTES:

ELECTRICAL MANHOLE TO BE RESET BY PUBLIC UTILITIES DEPARTMENT.

REMOVE INTERFERING PORTION OF EXISTING PIPE FENCE

REMOVE & REPLACE CONC. SIDEWALK WHERE NECESSARY FOR SMOOTH EVEN JOIN


CONSTR. CONC. DRIVEWAY PER CITY STD. NO. 302 4'-20" B-27'

CURVE DATA

1	2	3	4
Δ=02°11'18"	Δ=142°42'28"	Δ=60°45'00"	Δ=23°04'25"
R=45'	R=36'	R=20'	R=25'
L=187'	L=671'	L=78'	L=107'
T=2705'	T=1701'	T=110'	T=53'

TERRACINA DRIVE SECTION @ STA. 1+97.03

HORIZ: 1" = 20'

VERT: 1" = 4'

TL: 5'

J. F. DAVIDSON ASSOCIATES

CIVIL ENGINEERS - SURVEYORS - PLANNERS

RIVERSIDE, CALIFORNIA

APPROVED BY: *[Signature]* DATE: 6-17-71

R.E. No. 2247

1	2	3	4
REVISIONS	DATE	BY	DATE

CITY OF RIVERSIDE, CALIFORNIA

DEPARTMENT OF PUBLIC WORKS

APPROVED BY: *[Signature]* DATE: 6-22-71

TRAFFIC DIVISION

STREET PLAN & PROFILE		PROJECT NO.
TERRACINA DRIVE FROM STA. 1+25 TO STA. 2+12		R-1496
ALLEY FROM STA. 0+00 TO STA. 2+10.36		
CURB @ OLIVEWOOD & TERRACINA		SHEET 1 OF 1
HORIZ. SCALE: 1" = 20'	VERT. SCALE: 1" = 4'	FILE NO. 4405

GENERAL NOTES:

CONSTRUCTION SHALL BE IN ACCORDANCE WITH THE STANDARD SPECIFICATIONS FOR PUBLIC WORKS CONSTRUCTION, 1970 EDITION AND CITY OF RIVERSIDE STANDARD DRAWINGS.


* 25 BUILT 1/12/72 L&L