


Contractor agrees that he shall assume sole and complete responsibility for job site conditions during the course of construction of this Project, including safety of all persons and property; that this requirement shall apply continuously and not be limited to normal working hours; and that the Contractor shall defend, indemnify and hold the Owner and the Engineer harmless from any and all liability, real or alleged, in connection with the performance of work on this Project, excepting for liability arising from the sole negligence of the Owner or the Engineer.

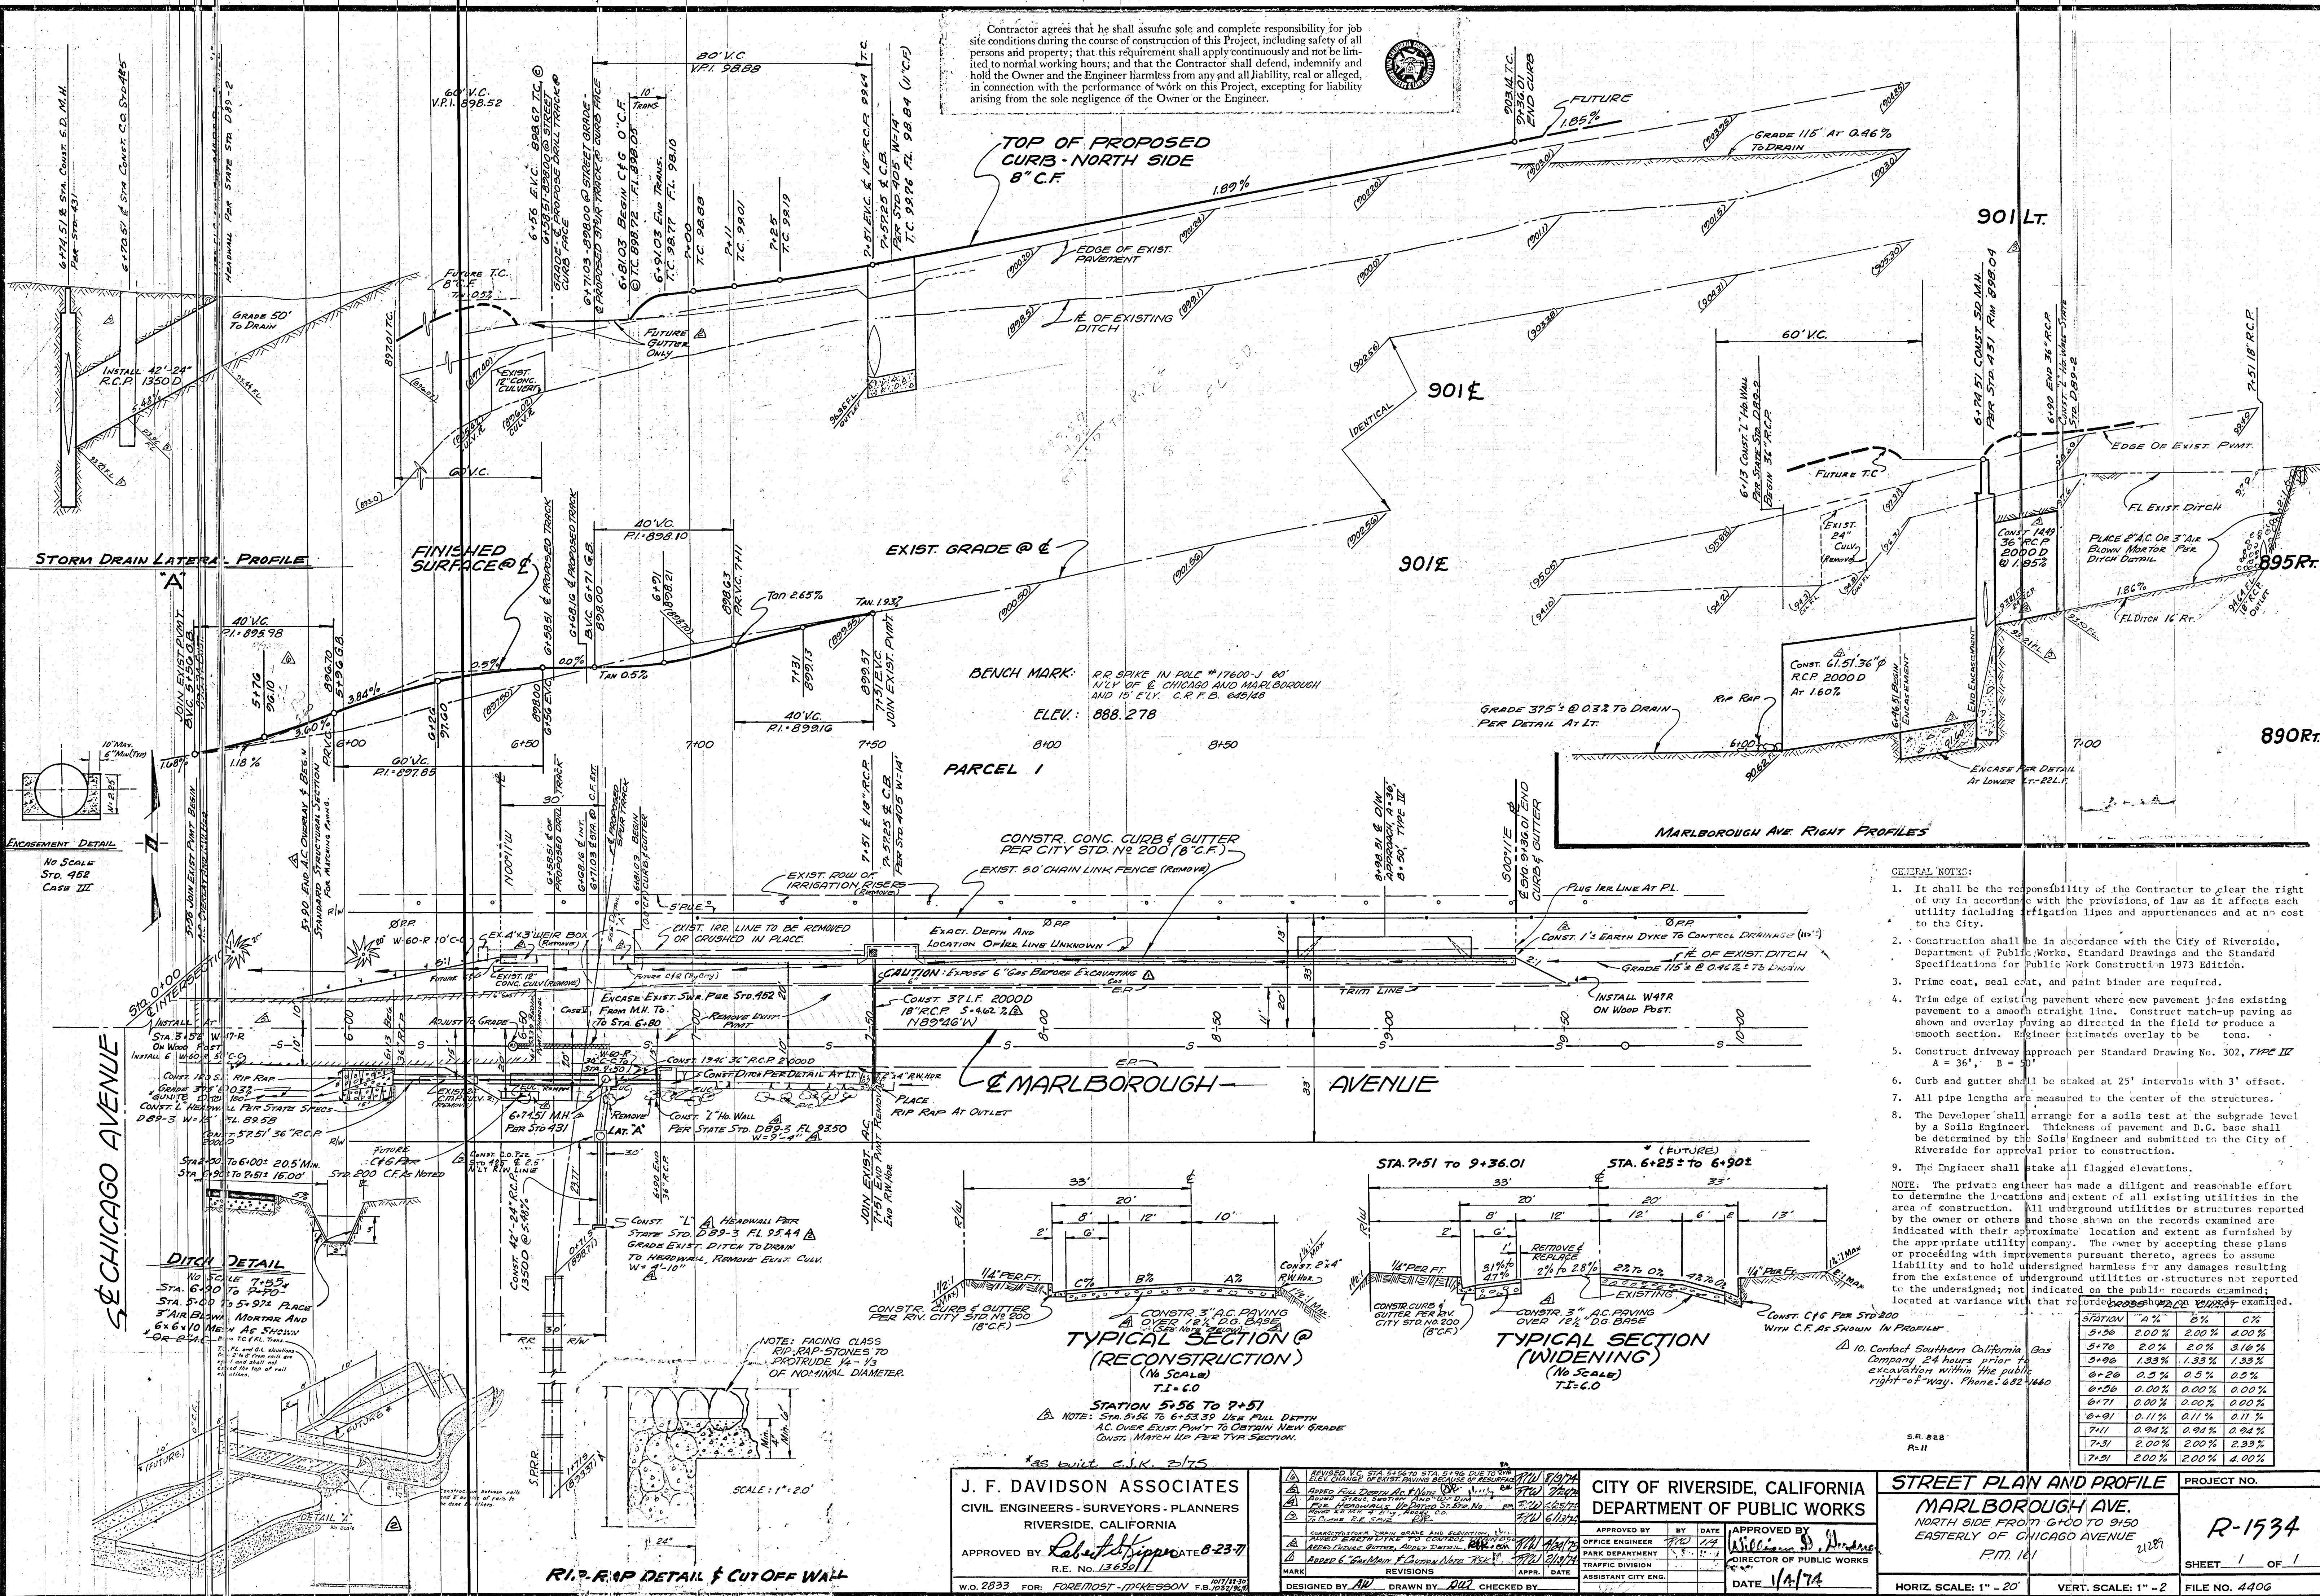

- GENERAL NOTES:
- It shall be the responsibility of the Contractor to clear the right of way in accordance with the provisions of law as it affects each utility including irrigation lines and appurtenances and at no cost to the City.
 - Construction shall be in accordance with the City of Riverside, Department of Public Works, Standard Drawings and the Standard Specifications for Public Work Construction 1973 Edition.
 - Prime coat, seal coat, and paint binder are required.
 - Trim edge of existing pavement where new pavement joins existing pavement to a smooth straight line. Construct match-up paving as shown and overlay paving as directed in the field to produce a smooth section. Engineer estimates overlay to be tons.
 - Construct driveway approach per Standard Drawing No. 302, TYPE II A = 36', B = 50'.
 - Curb and gutter shall be staked at 25' intervals with 3' offset.
 - All pipe lengths are measured to the center of the structures.
 - The Developer shall arrange for a soils test at the subgrade level by a Soils Engineer. Thickness of pavement and D.G. base shall be determined by the Soils Engineer and submitted to the City of Riverside for approval prior to construction.
 - The Engineer shall stake all flagged elevations.

NOTE: The private engineer has made a diligent and reasonable effort to determine the location and extent of all existing utilities in the area of construction. All underground utilities or structures reported by the owner or others and those shown on the records examined are indicated with their approximate location and extent as furnished by the appropriate utility company. The owner by accepting these plans or proceeding with improvements pursuant thereto, agrees to assume liability and to hold undersigned harmless for any damages resulting from the existence of underground utilities or structures not reported to the undersigned; not indicated on the public records examined; located at variance with that recorded on the public records examined.

STATION	A%	B%	C%
5+56	2.00%	2.00%	4.00%
5+70	2.0%	2.0%	3.16%
5+96	1.33%	1.33%	1.33%
6+26	0.5%	0.5%	0.5%
6+56	0.00%	0.00%	0.00%
6+71	0.00%	0.00%	0.00%
6+91	0.11%	0.11%	0.11%
7+11	0.94%	0.94%	0.94%
7+31	2.00%	2.00%	2.33%
7+51	2.00%	2.00%	4.00%

J. F. DAVIDSON ASSOCIATES
CIVIL ENGINEERS - SURVEYORS - PLANNERS
RIVERSIDE, CALIFORNIA

DESIGNED BY: *AW* DRAWN BY: *DW* CHECKED BY: *DW*
REVISIONS: *1* *2* *3* *1193*