



PROPERTY OF CITY OF RIVERSIDE

PROPERTY OF CITY OF RIVERSIDE

991.00  
970.55  
190.55

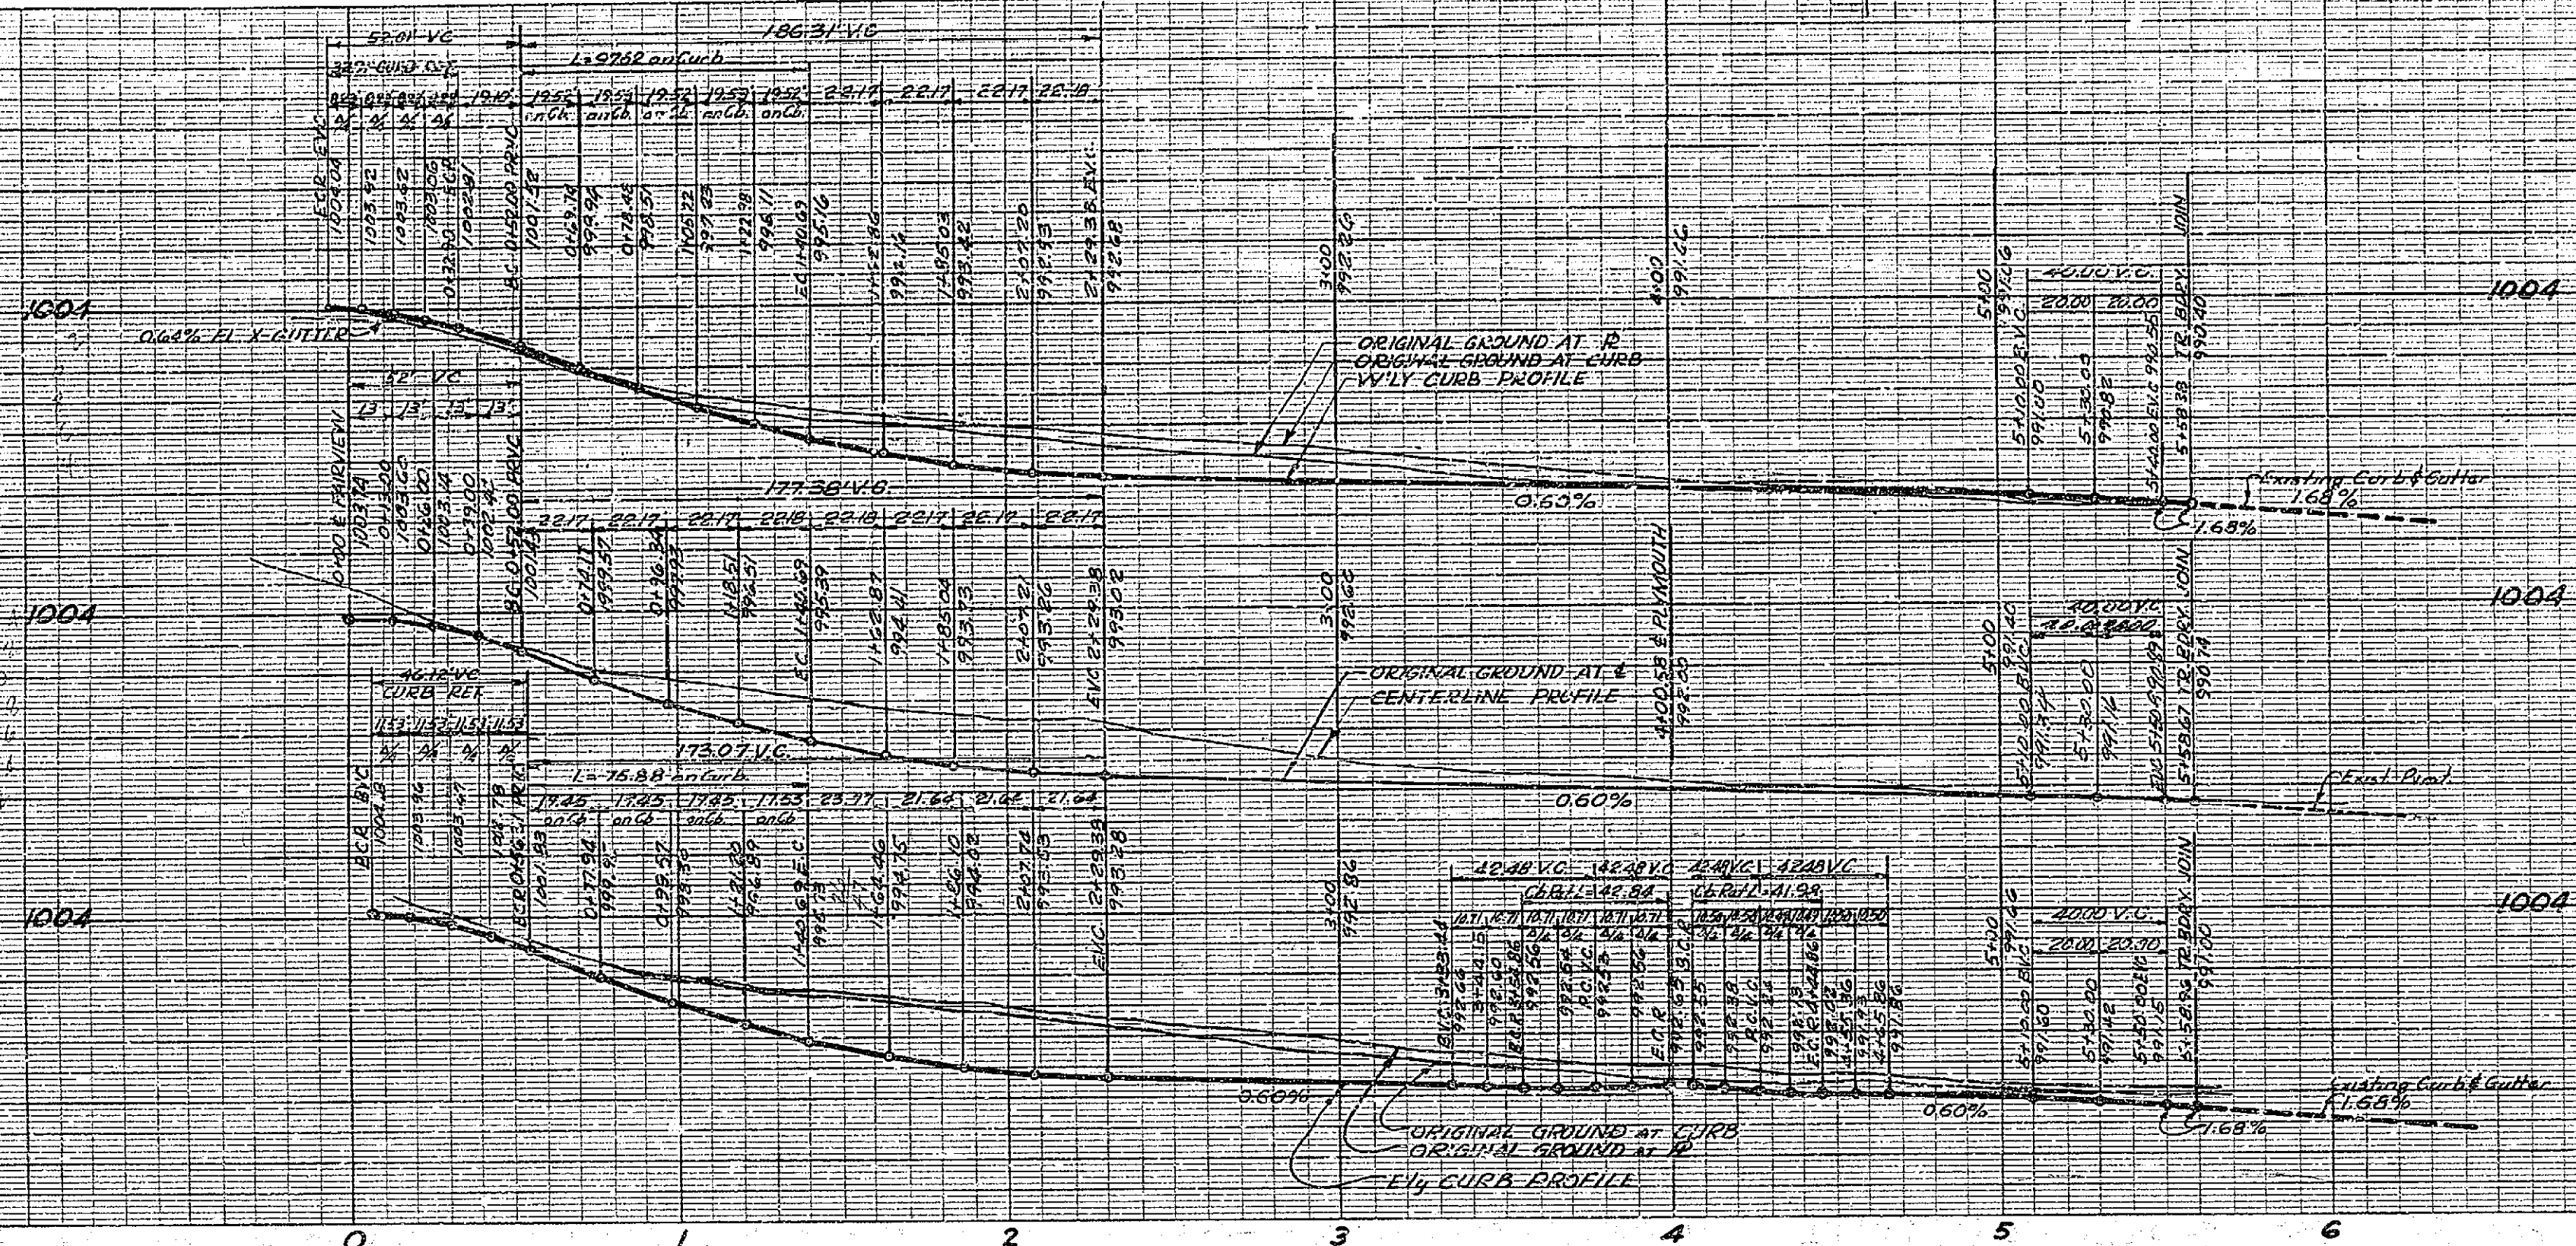

# CHATHAM DRIVE

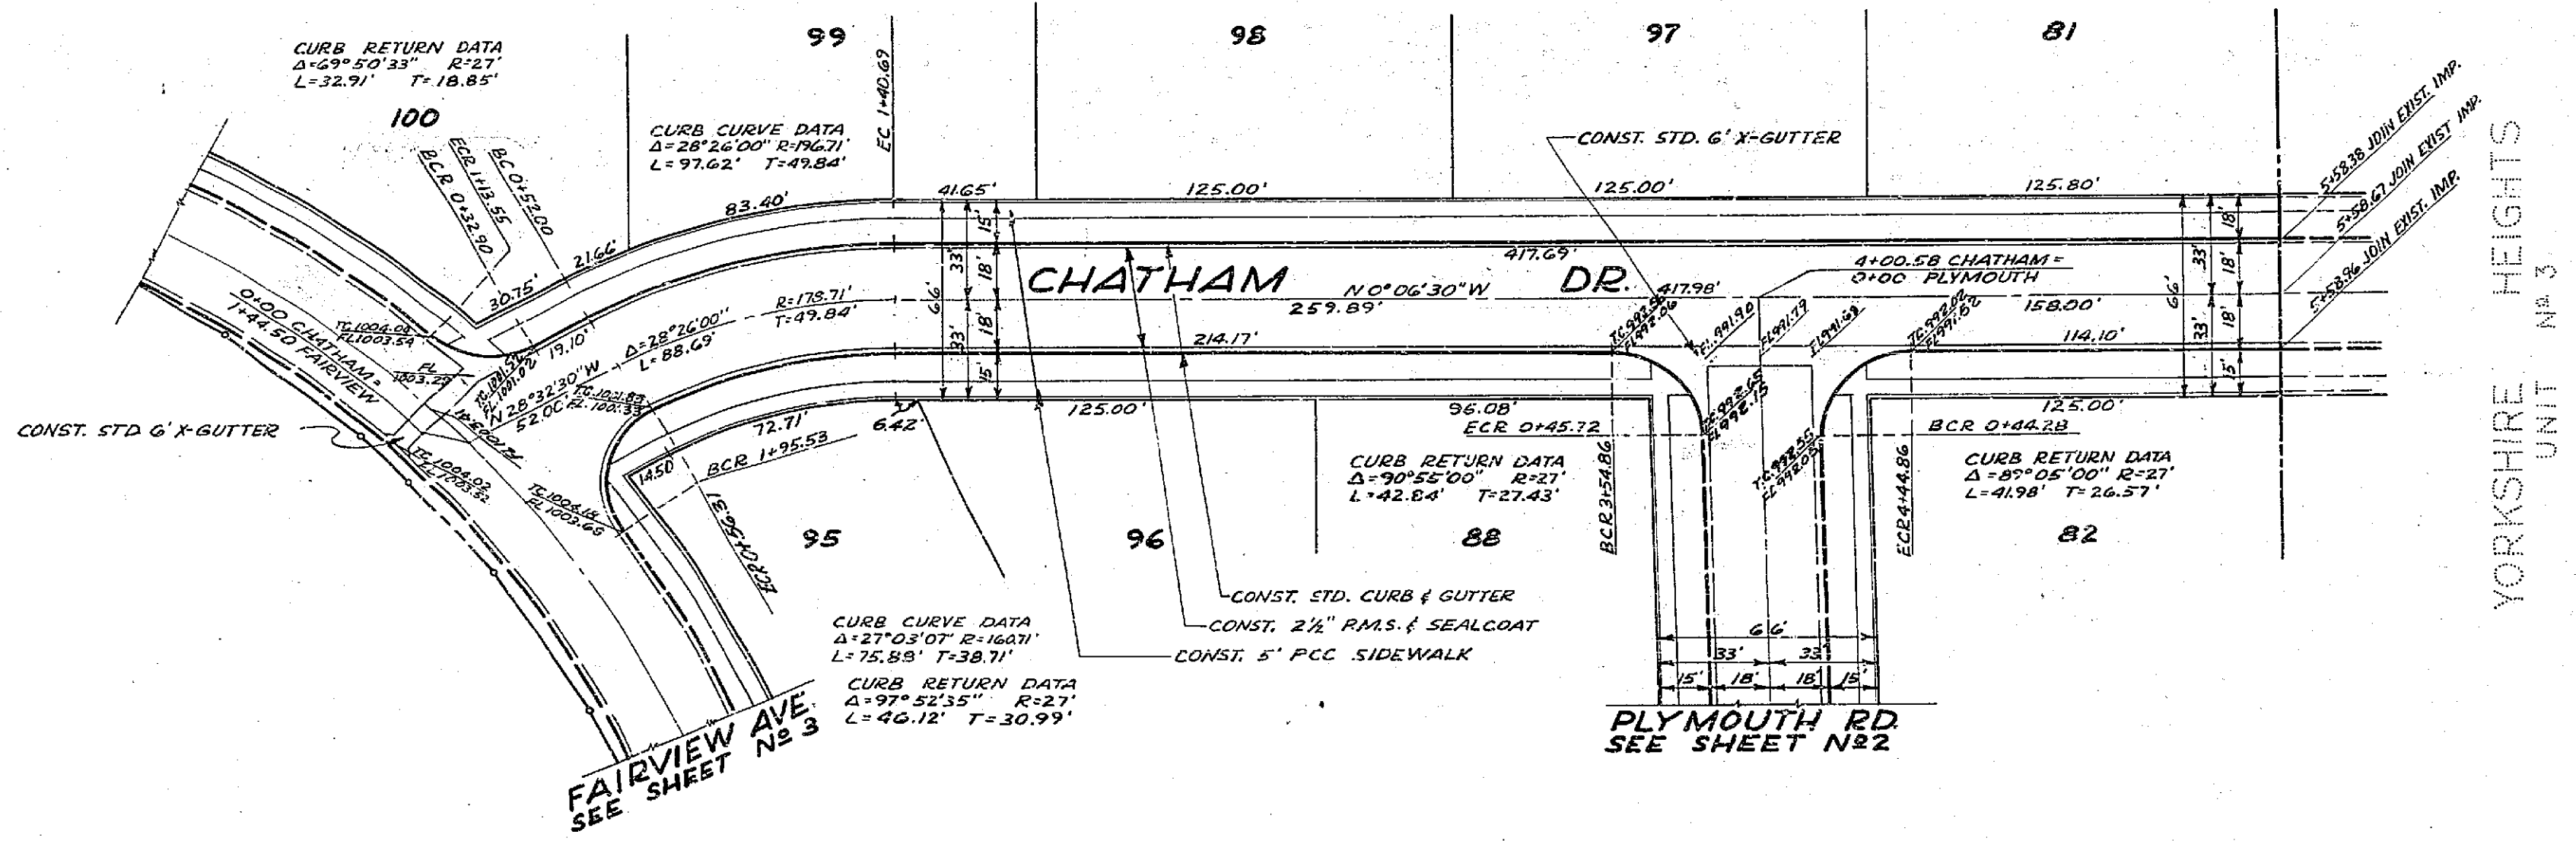

Grades Revised 0100 to 515267 Aug. 11, 1968

RAYMOND L. QUIGLEY - REGISTERED ENGINEER 7191 BULOT, QUIGLEY & CLARK INC. SANTA ANA, CALIFORNIA

APPROVED BY: [Signature] DATE: 5/29/71 1967

CITY OF RIVERSIDE CALIFORNIA DEPARTMENT OF PUBLIC WORKS


HORIZONTAL SCALE: 1"=40' VERTICAL SCALE: 1"=8'

APPROVED BY: [Signature] No R-153 SHEET 4 OF 4 SHEETS

**BENCH MARK**  
TOP OF 2" I.P. (CAPPED) AT E. INT. VICTORIA & CENTRAL PER CITY P.B. 400/110. ELEV. 987.508

PROPERTY OF CITY OF RIVERSIDE

PROPERTY OF CITY OF RIVERSIDE