


ALBERT A. WEBB ASSOCIATES  
 CIVIL ENGINEERS  
 RIVERSIDE, CALIFORNIA  


CITY OF RIVERSIDE, CALIFORNIA  
 PUBLIC WORKS DEPARTMENT  
 APPROVED BY: [Signature] DATE: [Date]  
 DIRECTOR OF PUBLIC WORKS

STREET PLAN AND PROFILE  
 SUNSET RANCH DRIVE  
 STREET EXTENSION TO TRACT 4351

ACCOUNT NO. 71-230  
 DRAWING NUMBER  
**R-1587**  
 SHEET 3 OF 4  
 71-230-A

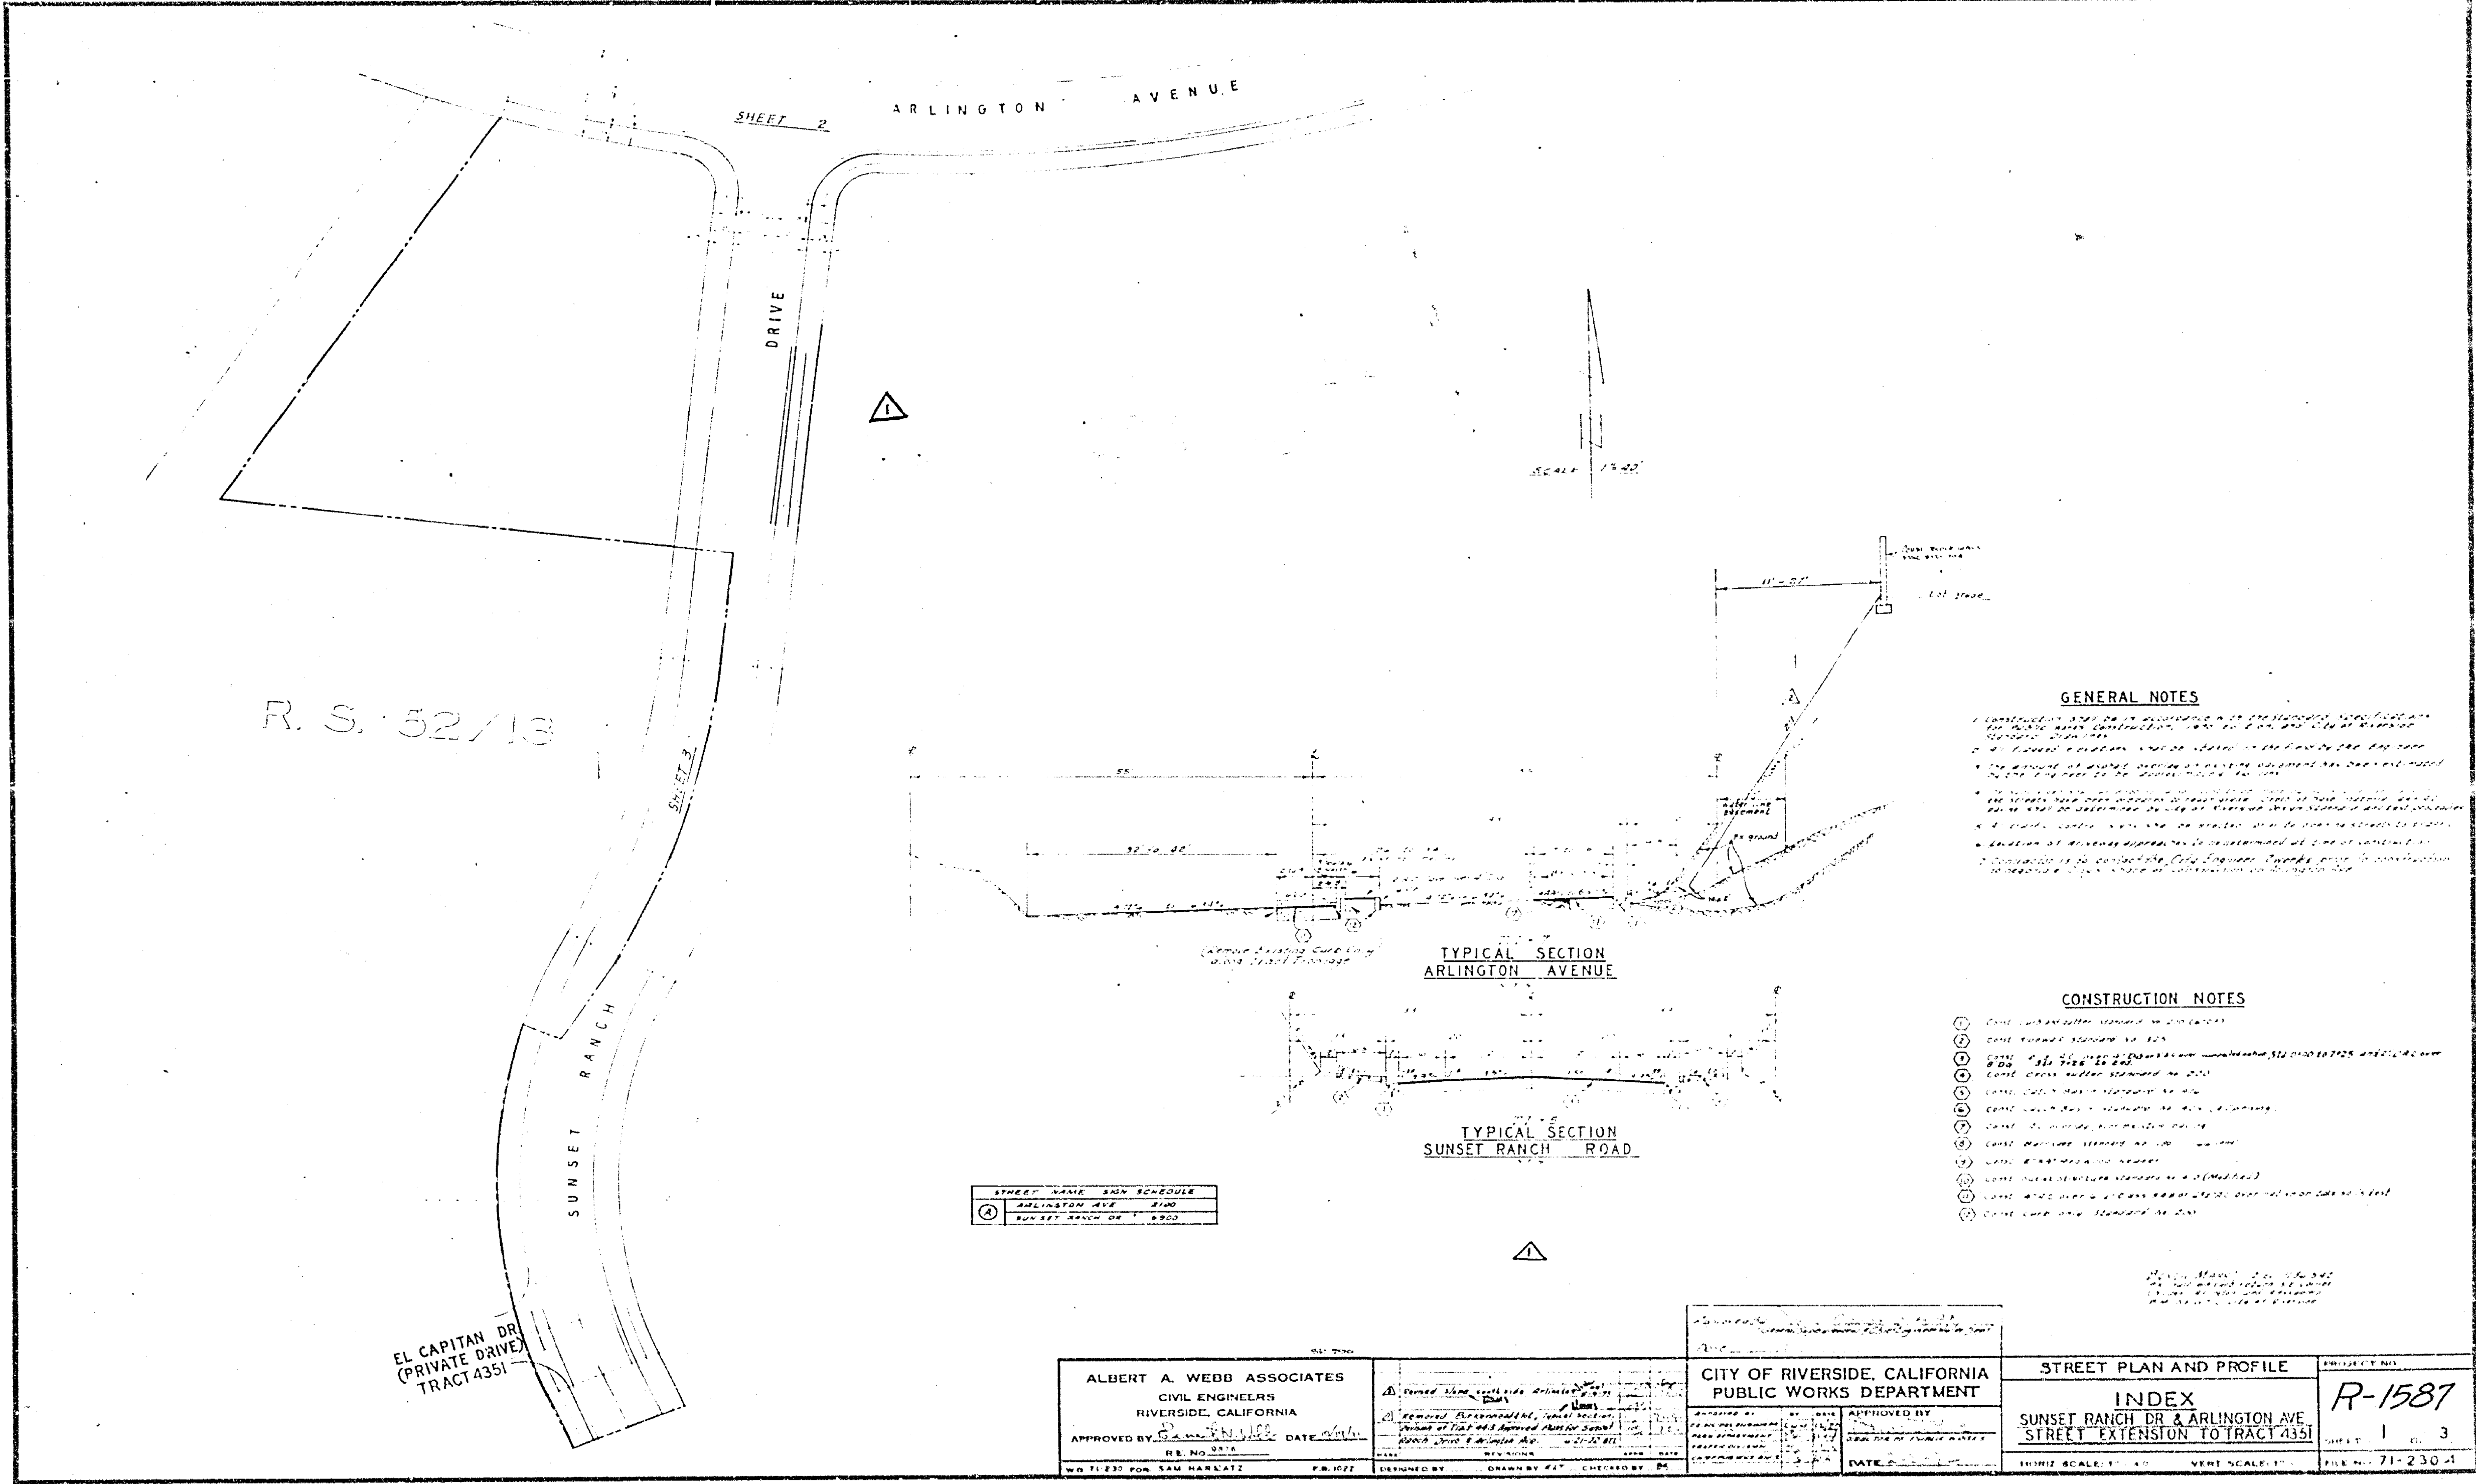

R. S. 52/13

SHEET 2

ARLINGTON AVENUE

DRIVE

SUNSET RANCH

EL CAPITAN DR  
(PRIVATE DRIVE)  
TRACT 4351

TYPICAL SECTION  
ARLINGTON AVENUE

TYPICAL SECTION  
SUNSET RANCH ROAD



**GENERAL NOTES**

**CONSTRUCTION NOTES**

|   |   |                         |             |
|---|---|-------------------------|-------------|
|   |   | INDEX                   | R-1587      |
| SUNSET RANCH DR & ARLINGTON AVE<br>STREET EXTENSION TO TRACT 4351   |   | SHEET                   | 1 of 3      |
| HORIZ SCALE: 1" = 40' VERT SCALE: 1" = 4'   |   | FILE NO.                | 71-230-1    |

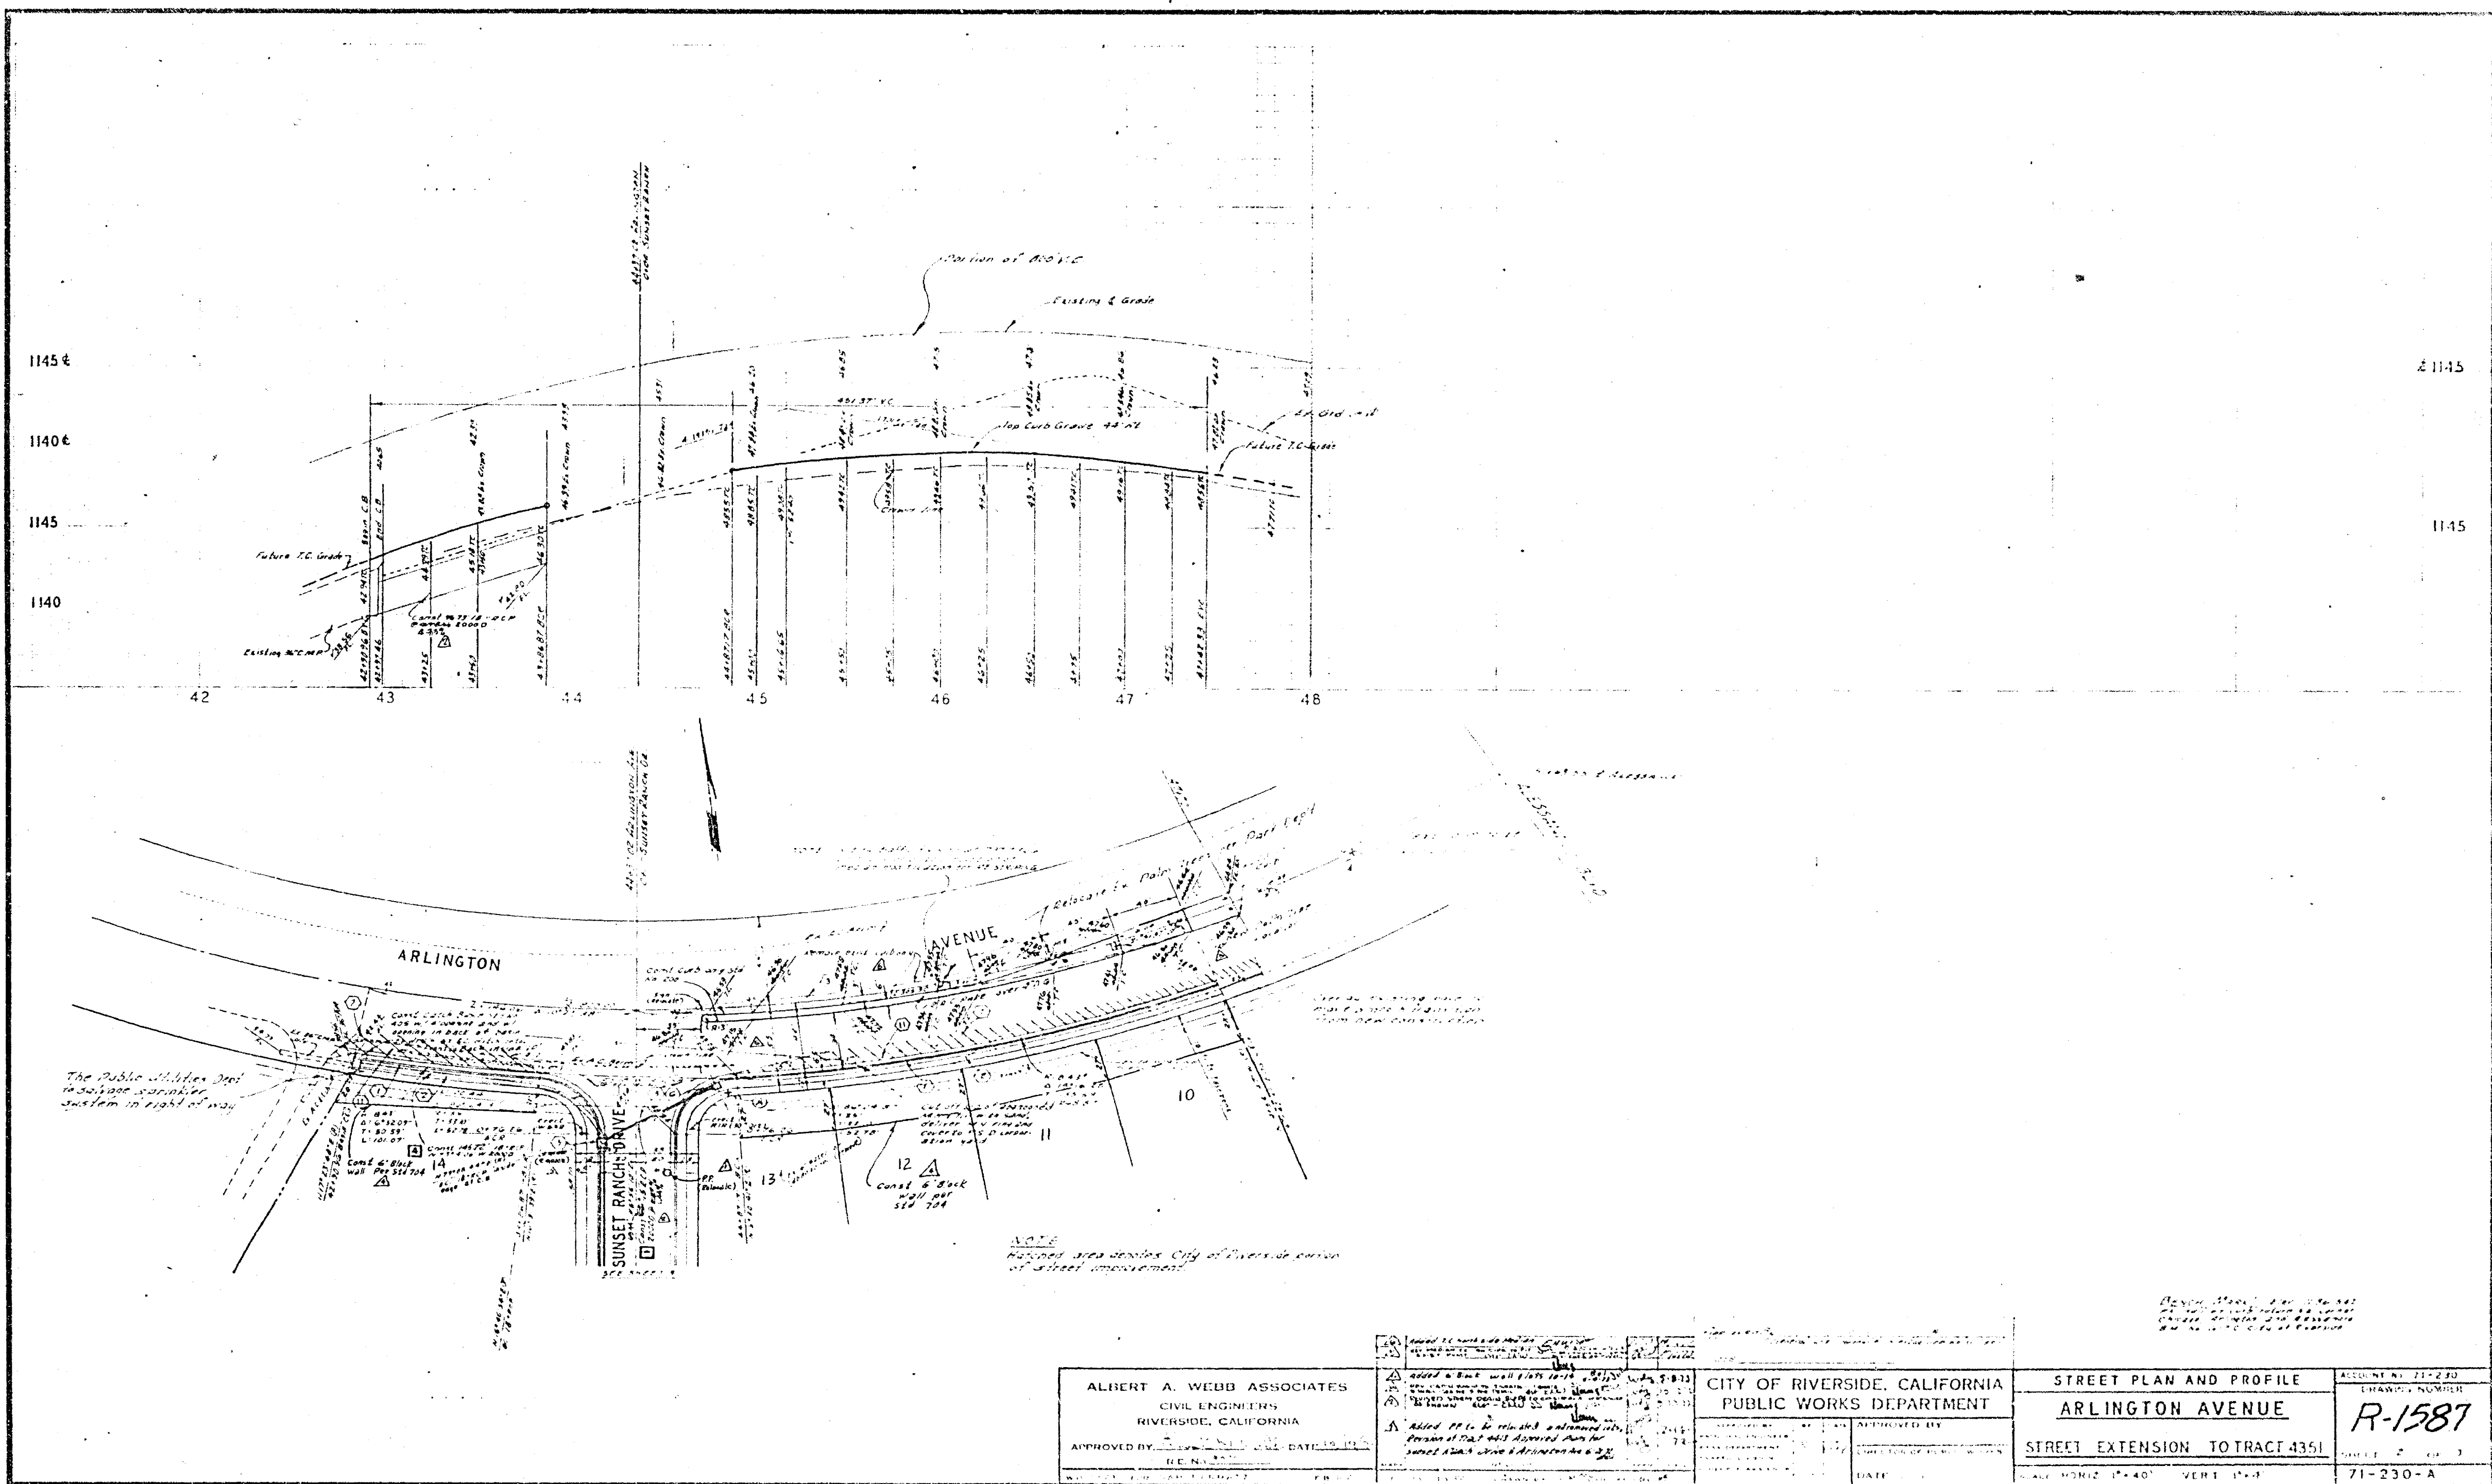

ALBERT A. WEBB ASSOCIATES  
 CIVIL ENGINEERS  
 RIVERSIDE, CALIFORNIA  
 APPROVED BY: \_\_\_\_\_ DATE: \_\_\_\_\_  
 RE: \_\_\_\_\_


CITY OF RIVERSIDE, CALIFORNIA  
 PUBLIC WORKS DEPARTMENT  
 REVIEWED BY: \_\_\_\_\_  
 DATE: \_\_\_\_\_

STREET PLAN AND PROFILE  
 ARLINGTON AVENUE  
 STREET EXTENSION TO TRACT 4351  
 SCALE: HORIZ. 1"=40' VERT. 1"=4'

ACCOUNT NO. 71-230  
 DRAWING NUMBER  
**R-1587**  
 SHEET 2 OF 3  
 71-230-A