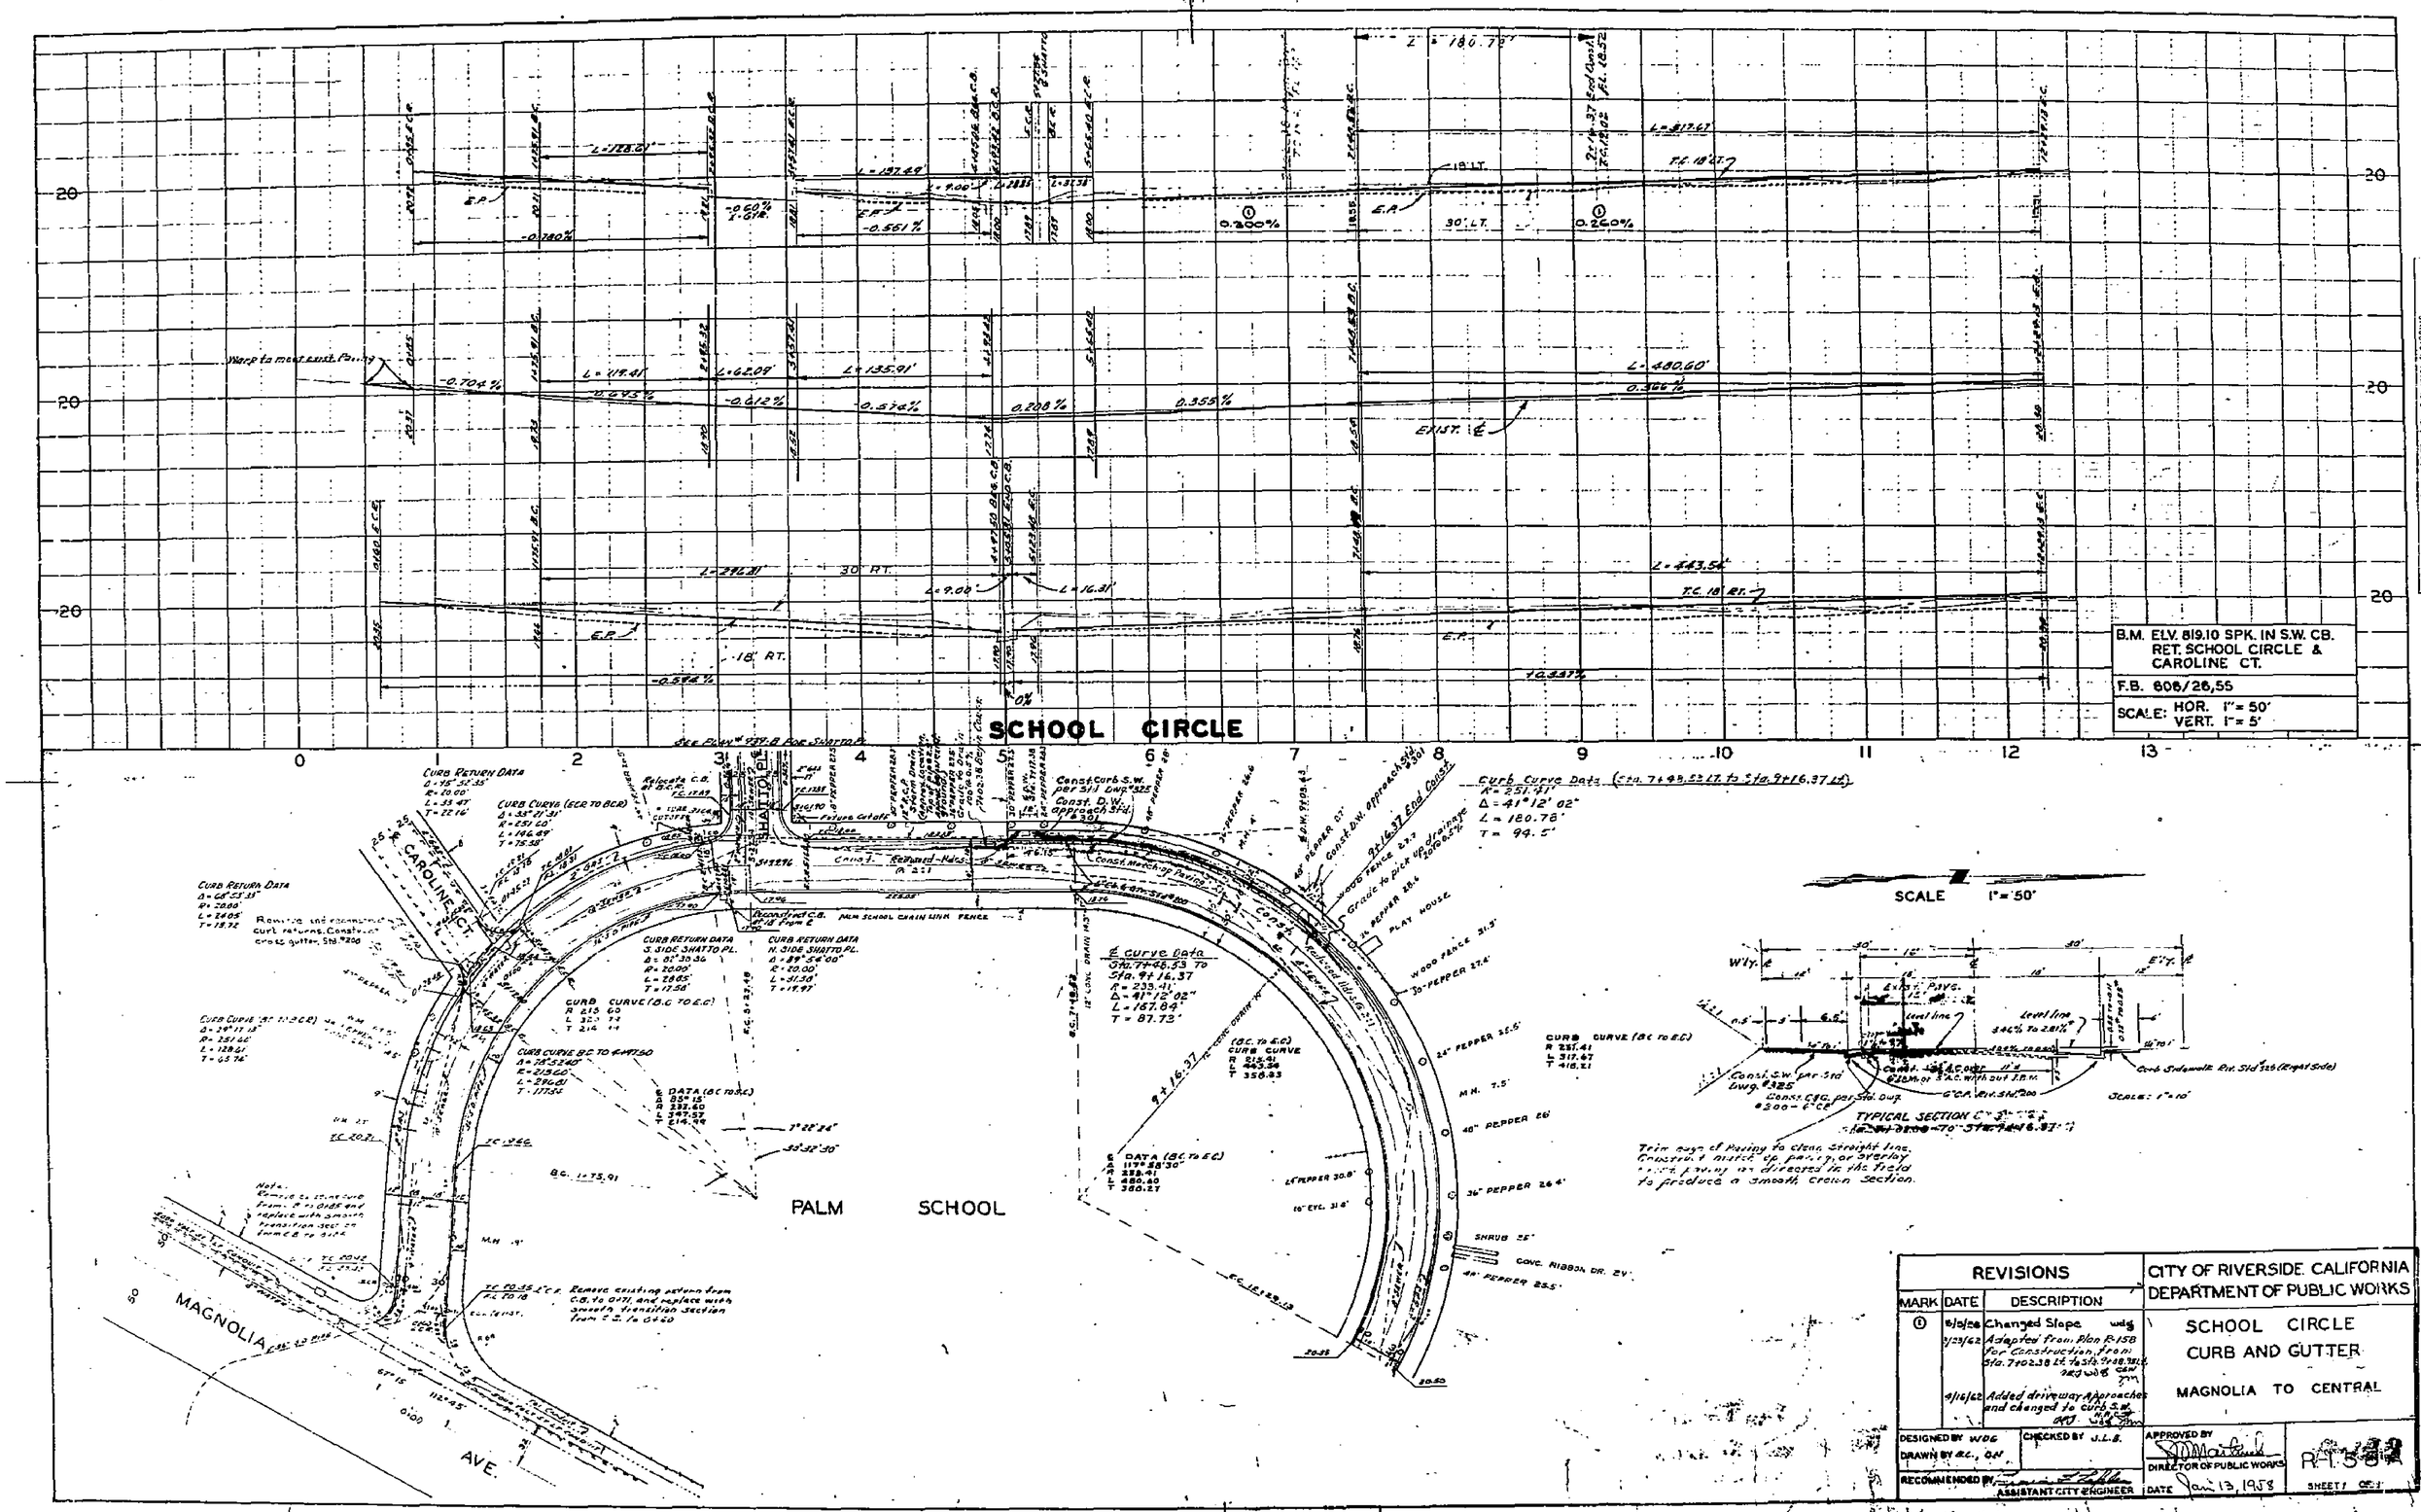
SCHOOL CIRCLE
B.M. ELV. 819.10 SPK. IN S.W. CB. RET. SCHOOL CIRCLE & CAROLINE CT.
F.B. 606/26,55
SCALE: HOR. 1"= 50' VERT. 1"= 5'
SCALE 1"= 50'
Curb Curve Data (Sta. 7+48.53 LT. to Sta. 9+16.37 LT.)
Δ = 41°12' 02"
L = 180.78'
T = 94.5'
PALM SCHOOL
CAROLINE CT.
MAGNOLIA AVE.
TYPICAL SECTION
REVISIONS
MARK DATE DESCRIPTION
6/5/62 Changed Slope
3/23/62 Adapted from Plan R-158 for Construction from Sta. 7+02.38 Lt. to Sta. 9+08.98 Lt.
4/16/62 Added driveway Approaches and changed to curb S.W.
CITY OF RIVERSIDE, CALIFORNIA
DEPARTMENT OF PUBLIC WORKS
SCHOOL CIRCLE
CURB AND GUTTER
MAGNOLIA TO CENTRAL
DESIGNED BY WDG
DRAWN BY B.C., GH
CHECKED BY J.L.B.
RECOMMENDED BY
ASSISTANT CITY ENGINEER
APPROVED BY
DIRECTOR OF PUBLIC WORKS
DATE Jan. 13, 1958
R-1582
SHEET 1 OF 2
PROFILE
PLAN