
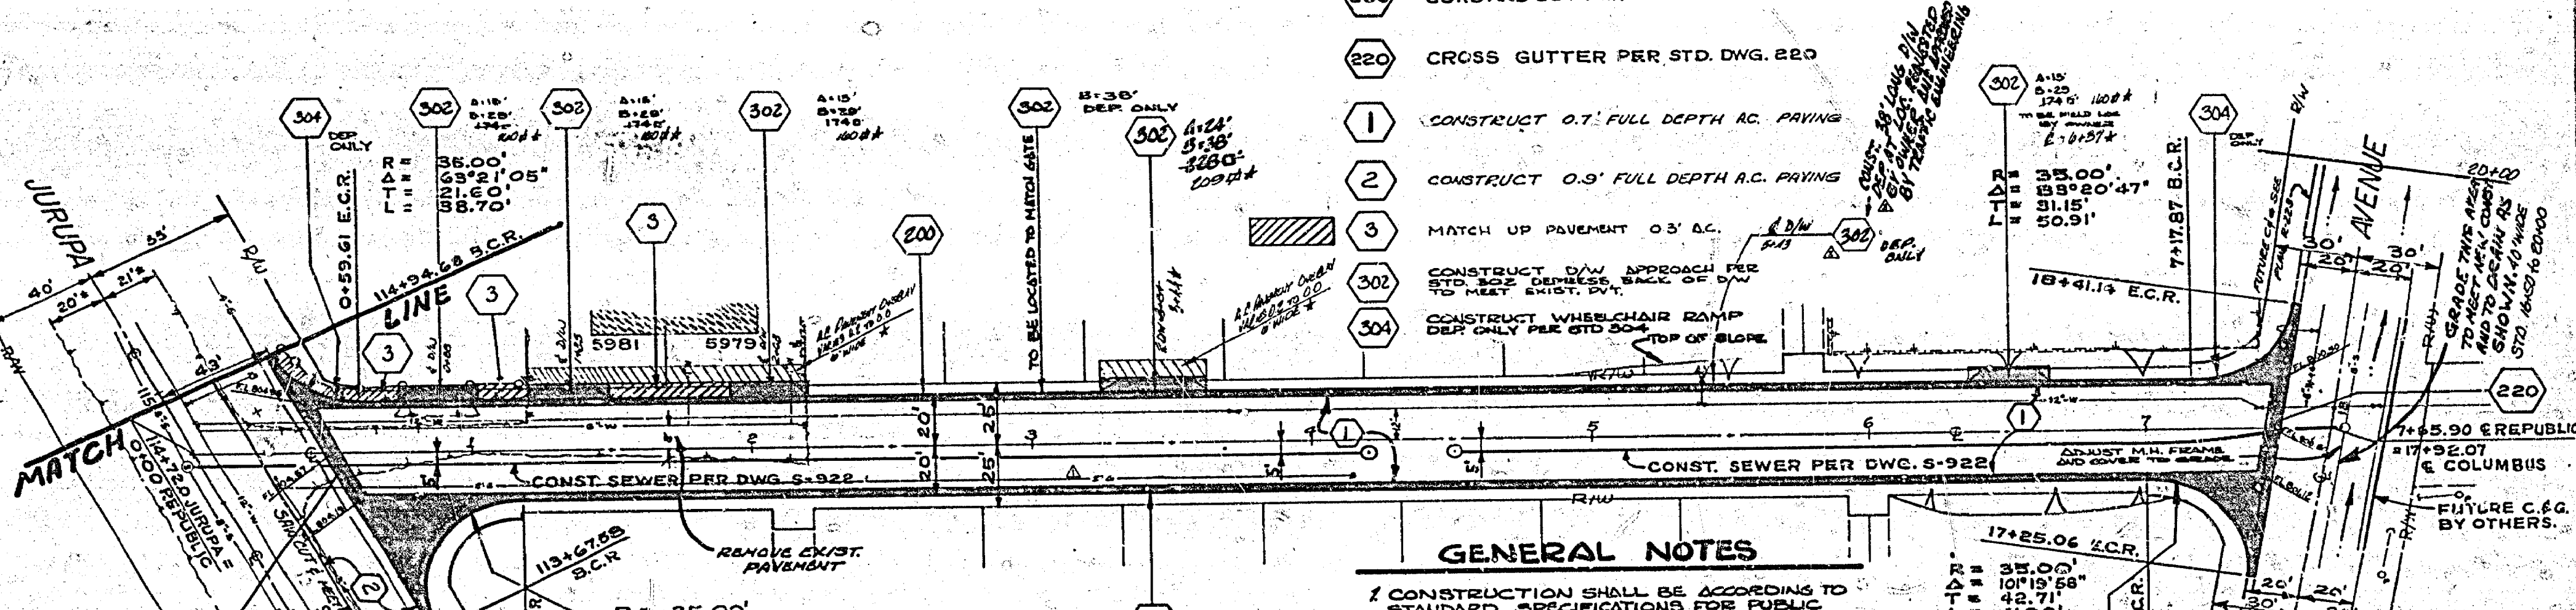


**CONSTRUCTION LEGEND**

CONSTRUCT PER CITY OF RIVERSIDE STANDARD DRAWINGS:



- (200) CURB AND GUTTER PER STD. DWG. 200 WITH 6" C.F.
- (220) CROSS GUTTER PER STD. DWG. 220
- (1) CONSTRUCT 0.7" FULL DEPTH A.C. PAVING
- (2) CONSTRUCT 0.9" FULL DEPTH A.C. PAVING
- (3) MATCH UP PAVEMENT 0.3" A.C.
- (302) CONSTRUCT D/W APPROACH PER STD. DWG. DEPENDS ON TYPE OF MEET EXIST. SW.
- (304) CONSTRUCT WHEELCHAIR RAMP PER STD. DWG. DEP. ONLY PER STD. DWG. TOP OF SLOPE

B.M. ELEV. 805.02  
 CHISELED X TOP OF  
 R.H. N.W. CORNER OF  
 REPUBLIC & COLUMBUS.  
 R.B. 561.35

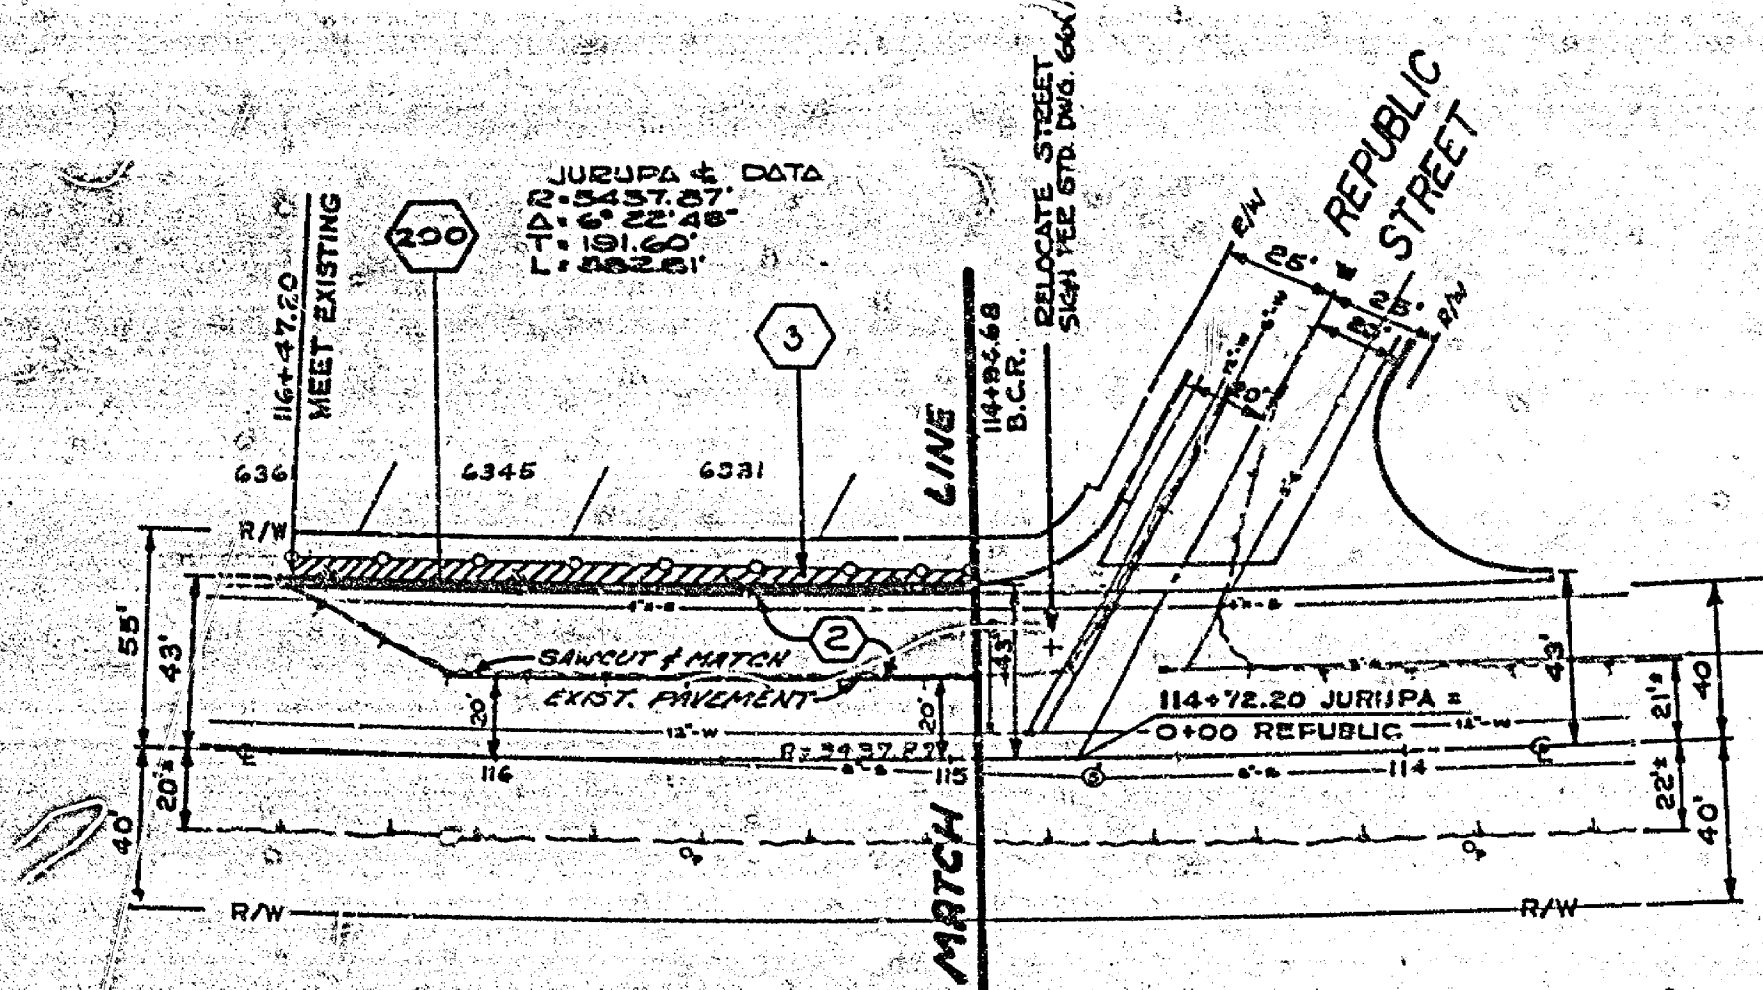

**GENERAL NOTES**

- 1 CONSTRUCTION SHALL BE ACCORDING TO STANDARD SPECIFICATIONS FOR PUBLIC WORKS CONSTRUCTION, 1975 EDITION
- 2 RIGHT OF ENTRY HAS BEEN OBTAINED FOR WORK SHOWN ON PRIVATE PROPERTY

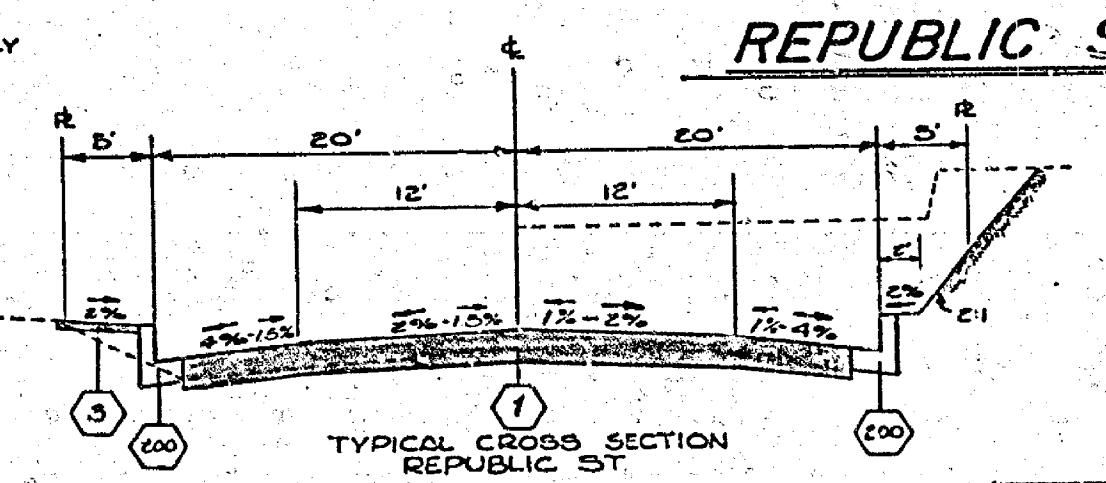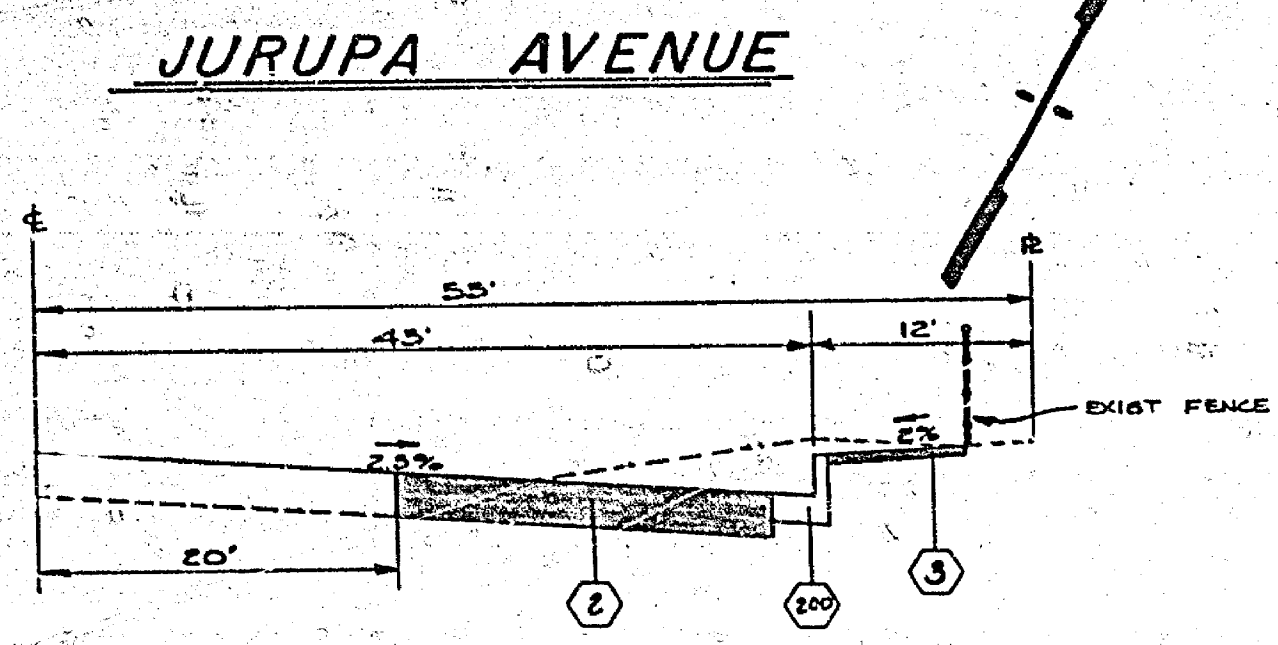

CITY OF RIVERSIDE, CALIFORNIA DEPARTMENT OF PUBLIC WORKS		<b>REPUBLIC STREET</b> ASSESSMENT DIST.		ACC. NO. 84-421-638 DRAWING NO.
DESIGNED BY: S. J. ... CHECKED BY: ... APPROVED BY: ...		BET. JURUPA AVE. AND COLUMBUS AVE. STREET CONSTRUCTION.		SHEET 1 OF 1 R-1650
HORIZ. SCALE: 1" = 40' VERT. SCALE: 1" = 4'				