


B.M. 77946 S&L IN S. C8
CALIF. OPP. STREETER.
F.B. 628/03-06, 12-15, 617/12
556/57-59
SCALE: HOR. 1" = 50'
VERT. 1" = 5'

NOTE:
FENCES TO BE REMOVED BY PROPERTY OWNERS INVOLVED, BUSHES TO BE REMOVED BY PROPERTY OWNER INVOLVED. UTILITIES TO BE RELOCATED BY UTILITIES CO. INVOLVED.

REVISIONS			CITY OF RIVERSIDE, CALIFORNIA DEPARTMENT OF PUBLIC WORKS	
MARK	DATE	DESCRIPTION		
Δ	3/19/58	CHANGE TRANSITION TO MEET EXIST. CURB & GUTTER WITH 12" AT STA. 9+10.5	CALIFORNIA AVENUE CURB & GUTTER 800' FT. W. OF ARLINGTON AVE.	
DESIGNED BY A.R.J.		CHECKED BY J.L.S.	APPROVED BY <i>[Signature]</i>	
DRAWN BY E		RECOMMENDED BY <i>[Signature]</i>	DIRECTOR OF PUBLIC WORKS	
		ASSISTANT CITY ENGINEER	DATE 12-23-57	

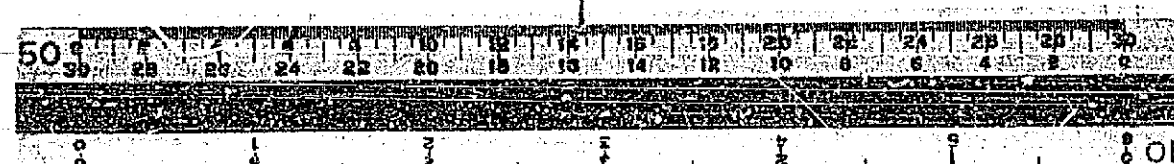

PROFILE ENGINEER	
PHOTO	
DATE	

PLAN	
DATE	
BY	

R-169
SHEET 1 OF 1