
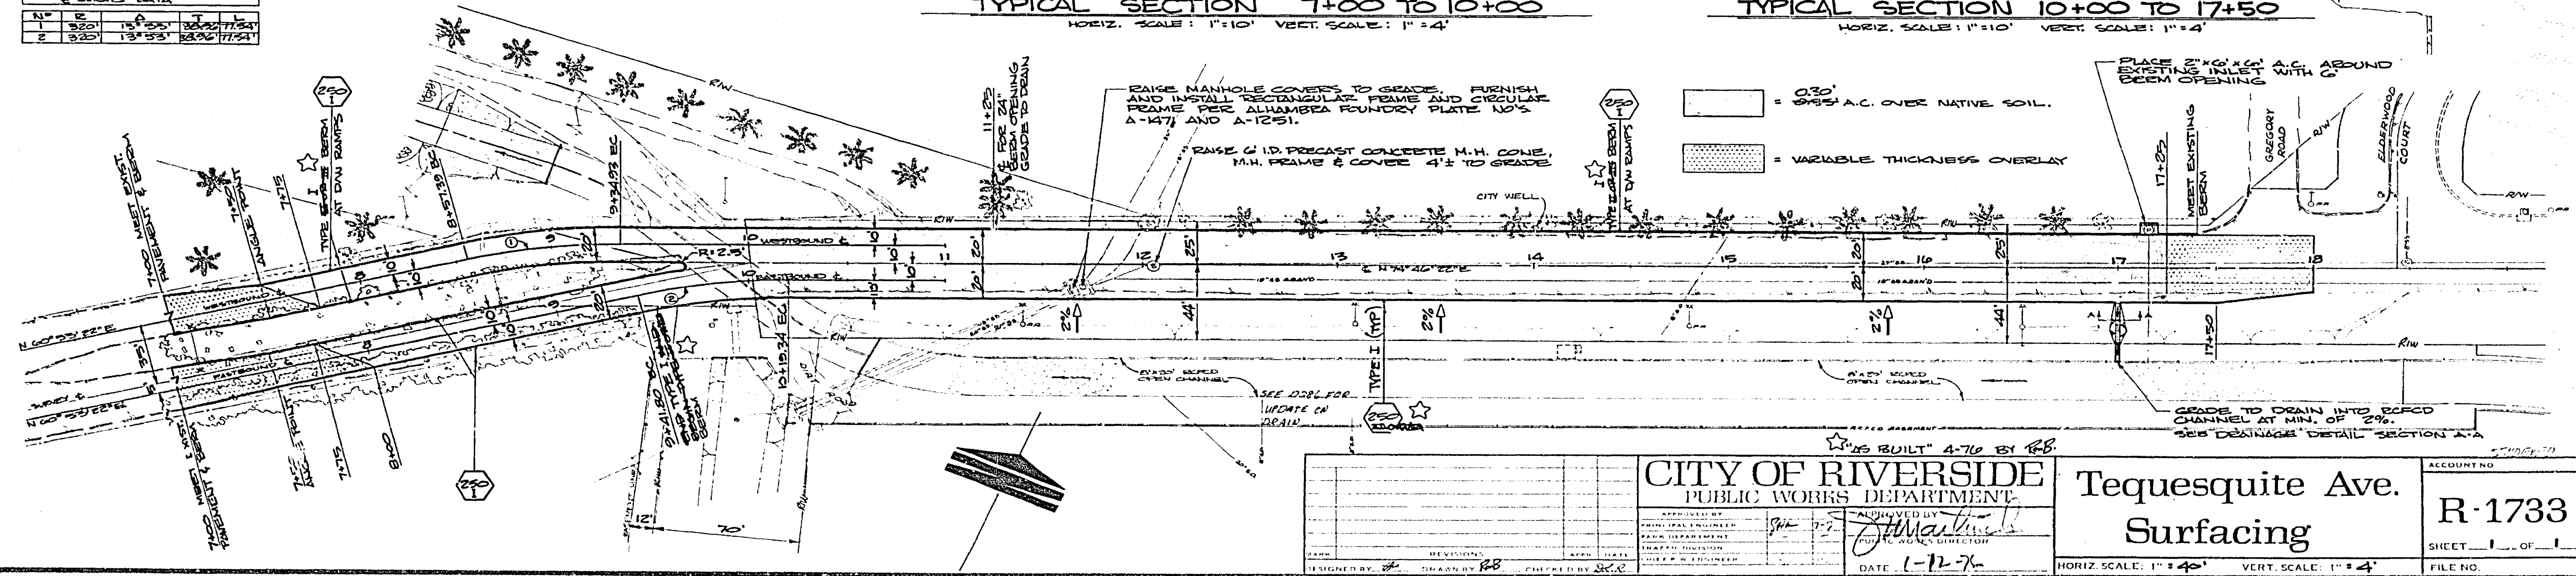
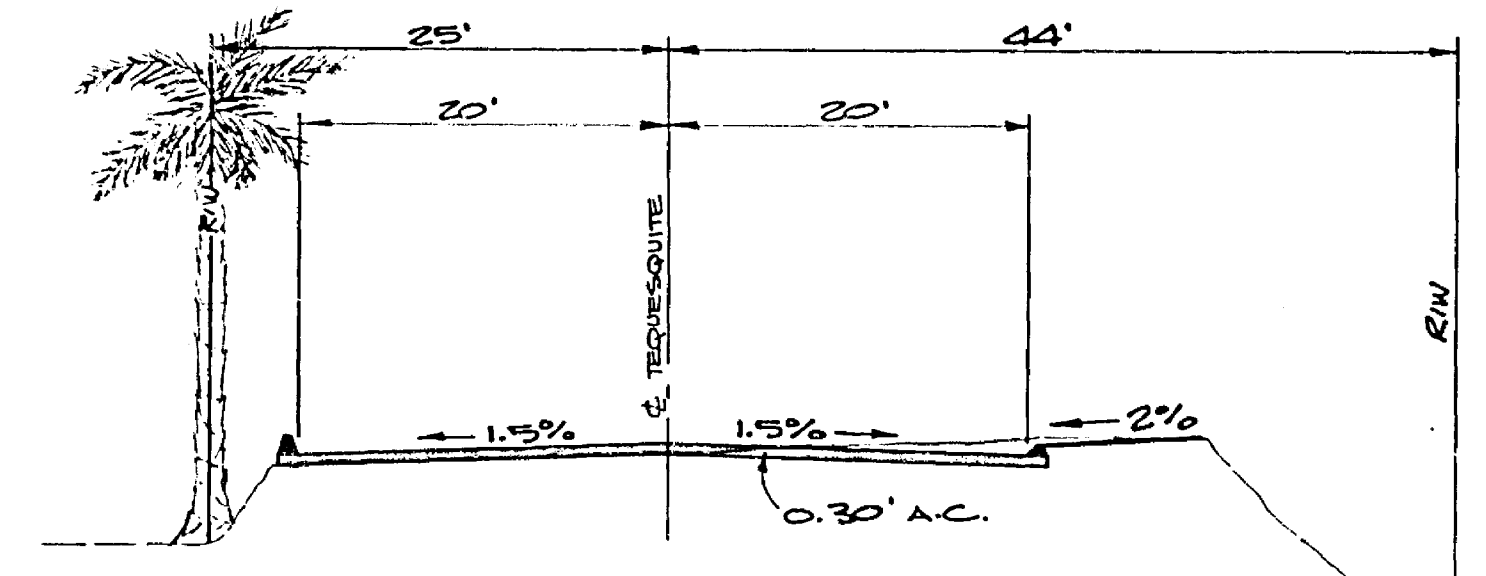
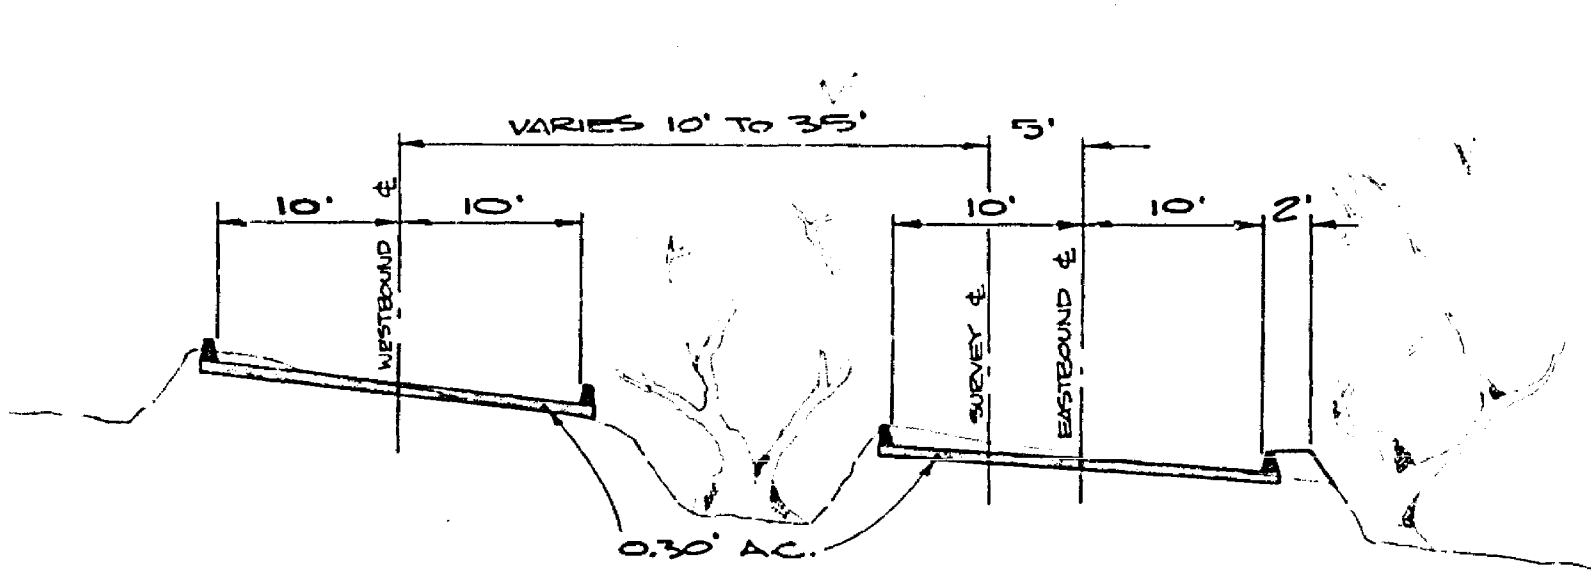


CURVE DATA			

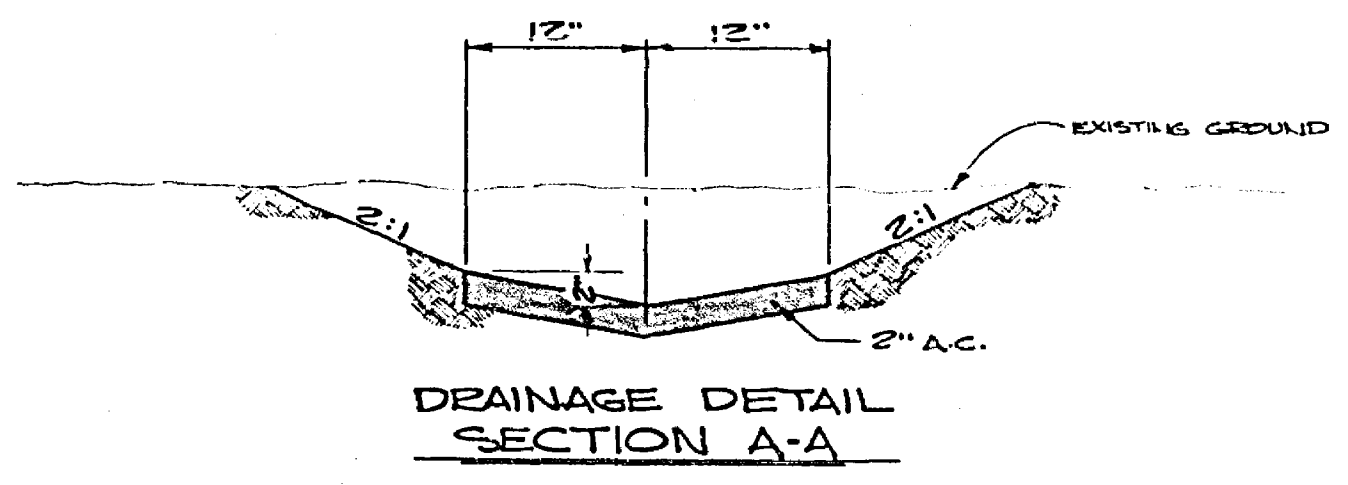

CITY OF RIVERSIDE PUBLIC WORKS DEPARTMENT		Tequesquite Ave. Surfacing		ACCOUNT NO. R-1733
APPROVED BY <i>[Signature]</i> DATE 1-12-76	CHECKED BY <i>[Signature]</i>	SHEET NO. 7 DATE 1-12-76	HORIZ. SCALE: 1" = 40' VERT. SCALE: 1" = 4'	SHEET 1 OF 1 FILE NO.