


B.M. ELEV 777.45 S&L IN W CB VAN BUREN 50' S. OF CHAYES ST.  
 B.M. ELEV 775.67 S&L IN COR. COPING AT E. SIDE CONC. WALK LIBERTY SCHOOL.  
 F.B. 614/35-41  
 SCALE: HOR. 1"=50'  
 VERT 1"=5'

PROJECT	
DATE	
BY	
CHECKED	
APPROVED	

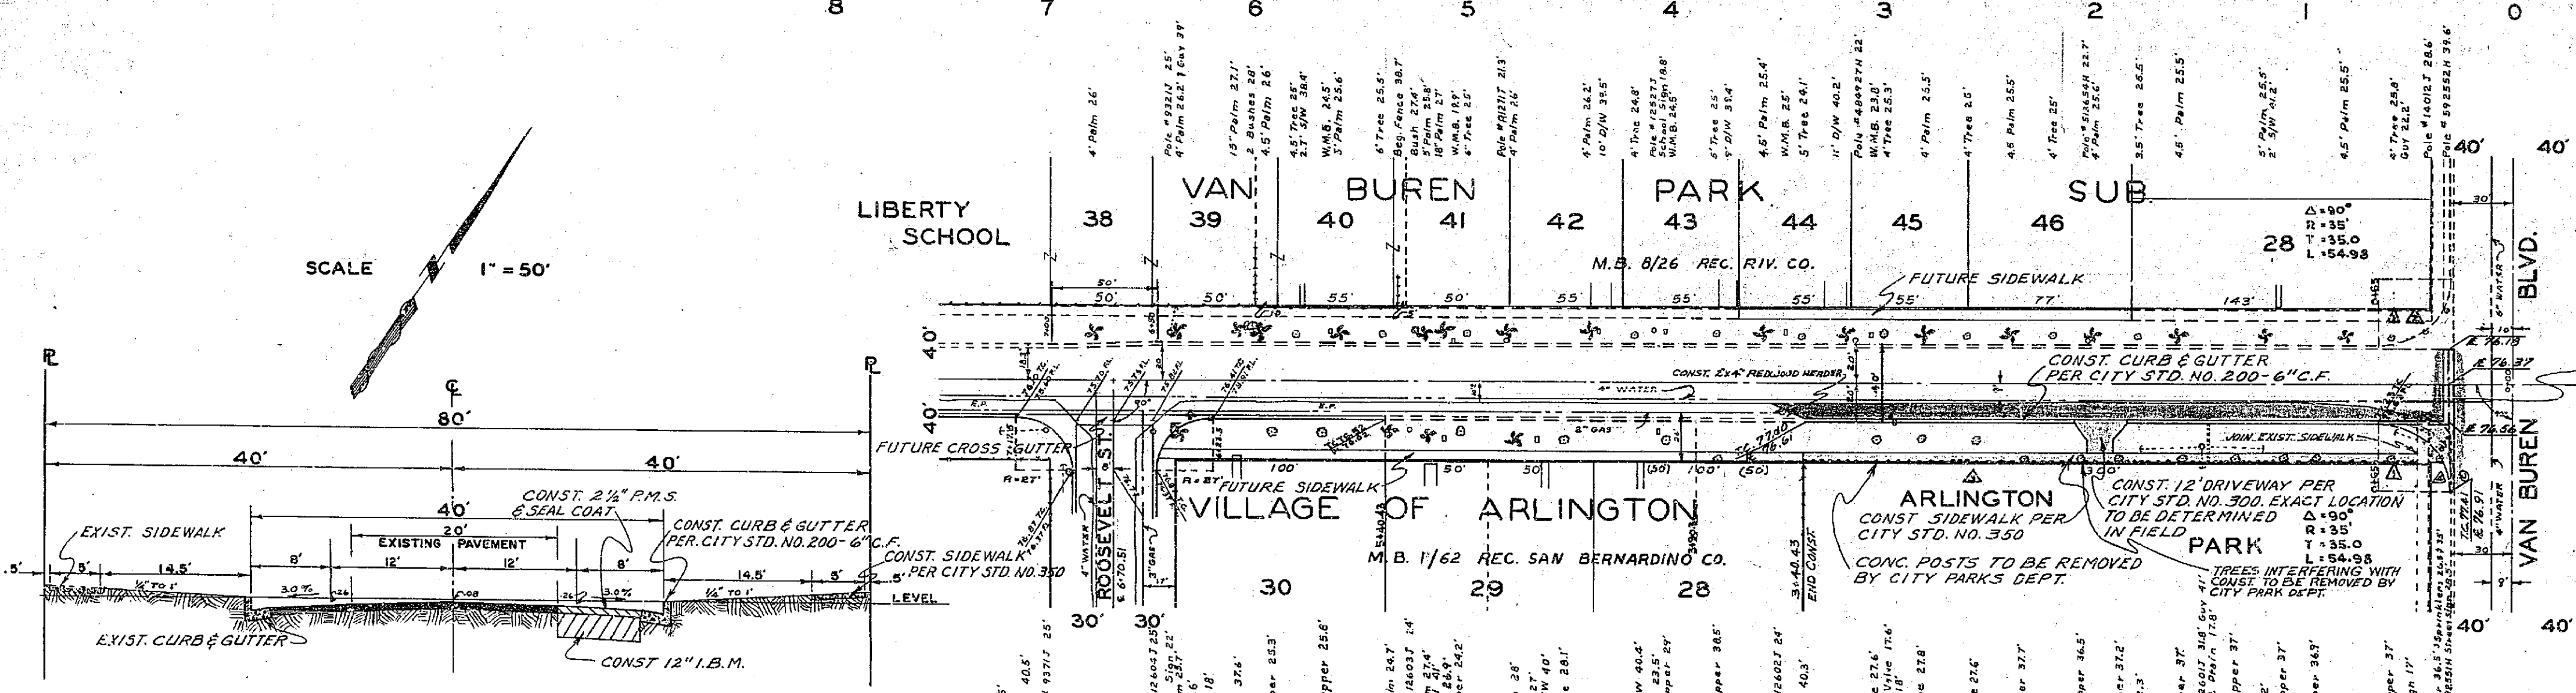

TYPICAL SECTION  
 SCALE: HOR. 1"=10'  
 VER. 1"=4'

REMOVE EXIST. CROSS GUTTER, SOUTH APRON, & CURB RETURN. CONST. NEW CROSS GUTTER PER CITY STD. NO. 220

REVISIONS		CITY OF RIVERSIDE CALIFORNIA DEPARTMENT OF PUBLIC WORKS
DATE	DESCRIPTION	
10-21-58	REVISED CR. RAD. TO 55'	<b>HAYES STREET            IMPROVEMENT            CURB &amp; GUTTER BET. VAN BUREN            AND ROOSEVELT ST.</b>
10-23-58	FIELD REVISIONS BUILT	
10-23-58	INDICATED IMPROVEMENT LIMITS FOR CONSTRUCTION PERM.	
12/11/57	REVISED C.R. ELEVATIONS	
12/11/57	REVISED CURB GRADE & ELEV. S.P.	

NOTE: It shall be the responsibility of the Contractor to clear the right of way in accordance with the provisions of the law or if affects each utility including irrigation lines and appurtenances and of no cost to the City.

DESIGNED BY A.K.J.  
 DRAWN BY B. J. Law  
 RECOMMENDED BY J. J. [Signature]  
 ASSISTANT CITY ENGINEER

CHECKED BY J.L.B.

APPROVED BY [Signature]  
 DIRECTOR OF PUBLIC WORKS

DATE March 7, 1958

**R-177**  
 SHEET 1 OF 1

