
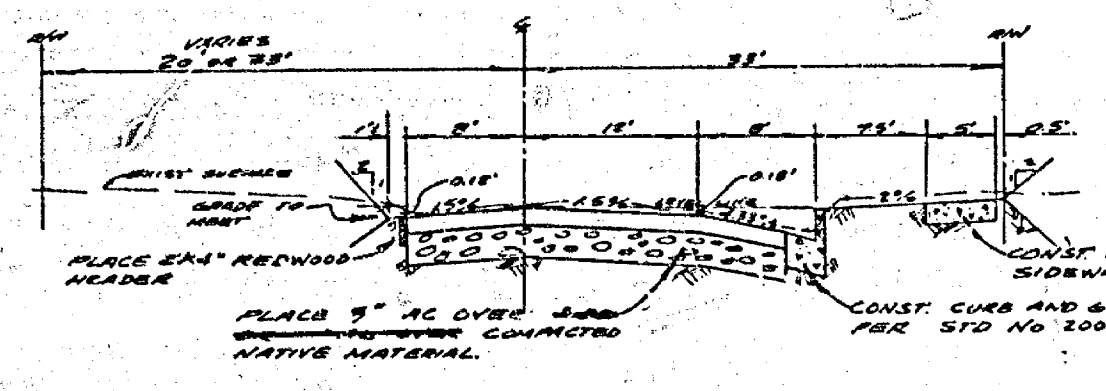


- GENERAL NOTES**
- CONSTRUCTION SHALL BE IN ACCORDANCE WITH THE STANDARD SPECIFICATIONS FOR PUBLIC WORKS CONSTRUCTION, 1973 EDITION AND THE 2011 AND 2012 AMENDMENTS THEREON.
 - EXISTING DIRT ROAD TO BE GRADED AS REQUIRED TO MEET NEW FINISH.

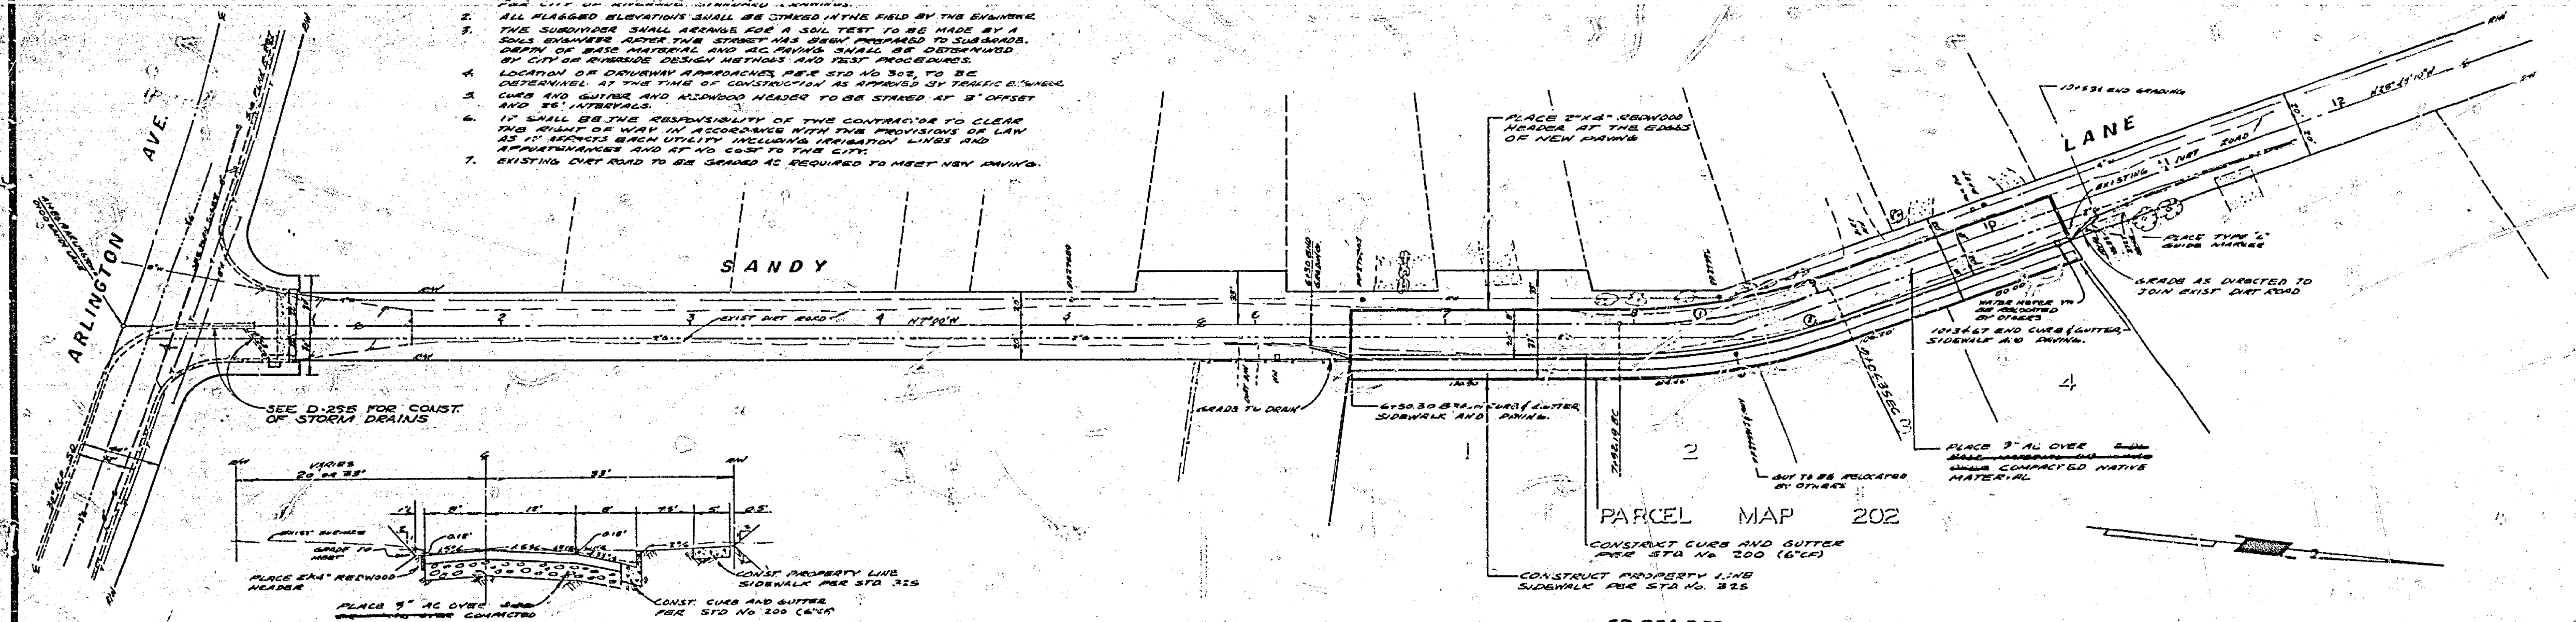

TYPICAL SECTION SANDY LANE
711.6 NO SCALE


ALBERT A. WEBB ASSOCIATES CIVIL ENGINEERS RIVERSIDE, CALIFORNIA		CITY OF RIVERSIDE, CALIFORNIA PUBLIC WORKS DEPARTMENT		ACCOUNT NO. R-1800
APPROVED BY: <i>[Signature]</i> R.E. No. <i>[Blank]</i>	DATE: <i>[Blank]</i>	APPROVED BY: <i>[Signature]</i> DIRECTOR OF PUBLIC WORKS	DATE: <i>11-14-14</i>	SHEET 1 OF 1
W&J 74-221 FOR A11 McCullom P.S. 1035		DESIGNED BY: <i>[Blank]</i> DRAWN BY: <i>[Blank]</i> CHECKED BY: <i>[Blank]</i>		SCALE: Horiz. 1" = 40' Vert. 1" = 4' 74-223-A