


PROFILE	DATE
PLAN	DATE
SECTION	DATE
DETAIL	DATE

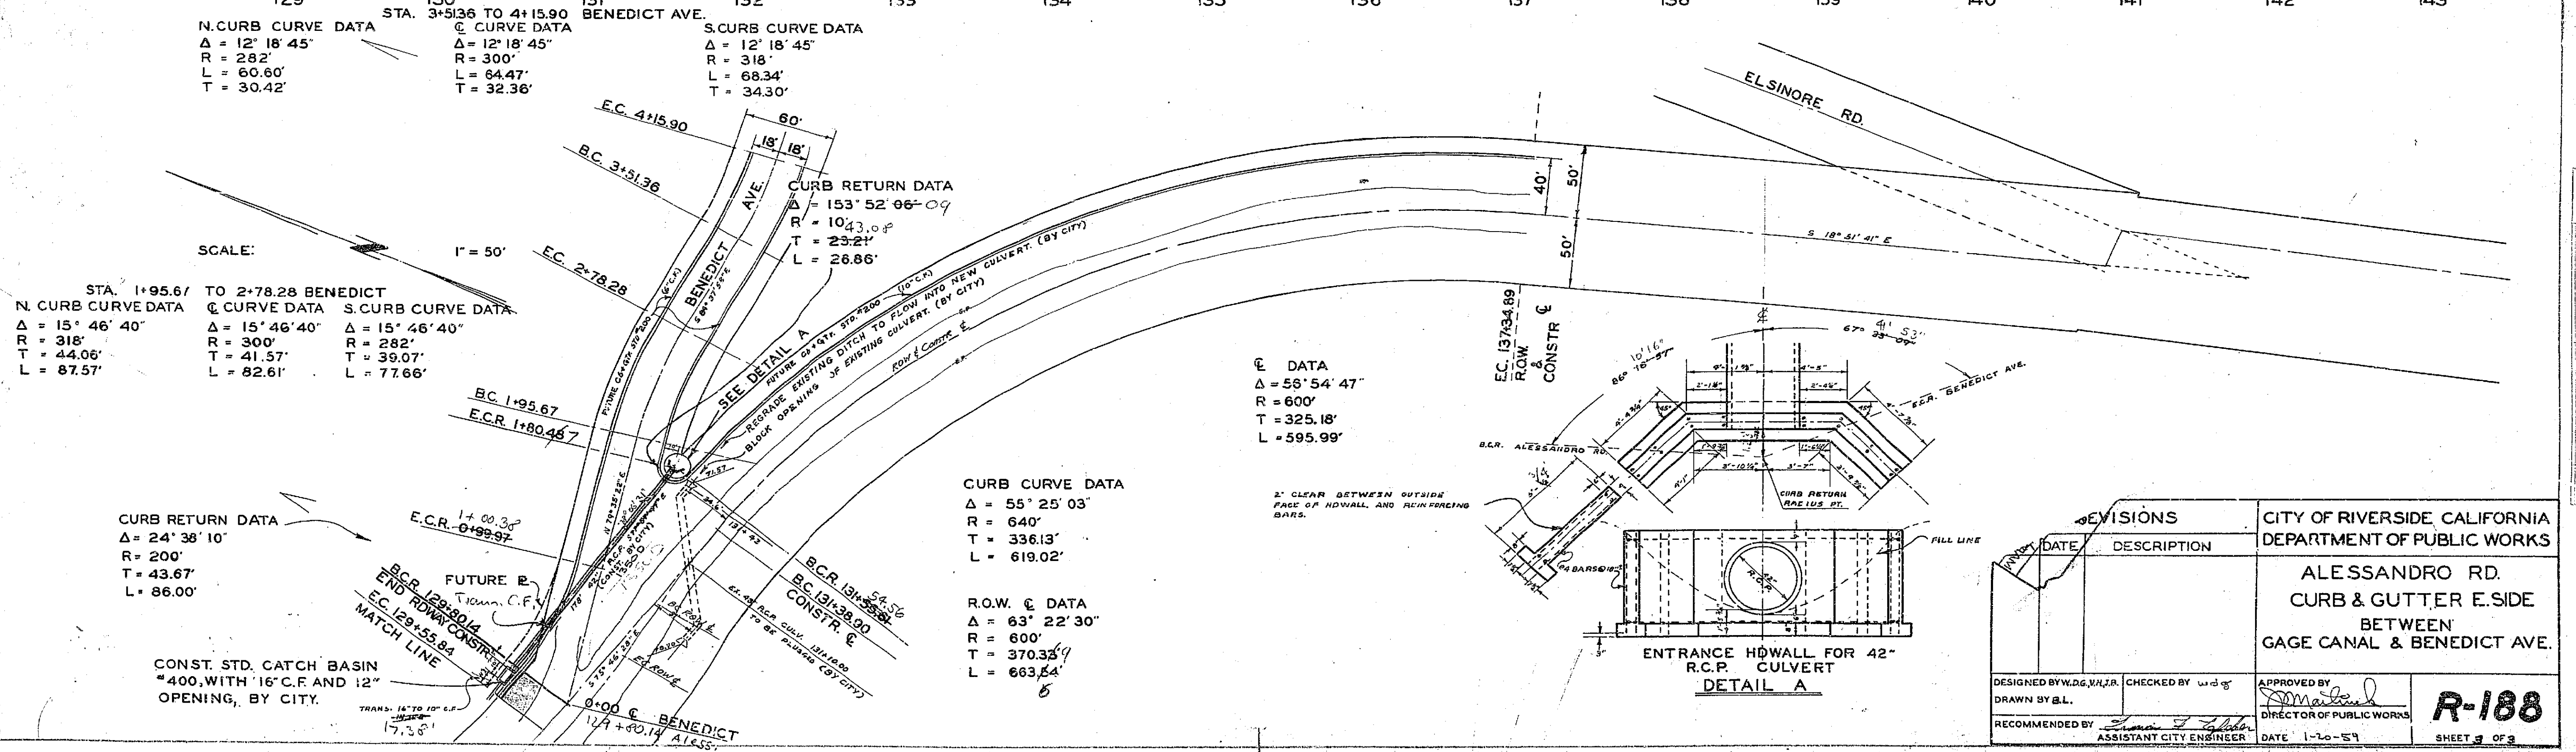

PROFILE	DATE
PLAN	DATE
SECTION	DATE
DETAIL	DATE

REVISIONS		CITY OF RIVERSIDE, CALIFORNIA DEPARTMENT OF PUBLIC WORKS
NO.	DESCRIPTION	
DESIGNED BY W.D.G. VAJRA		APPROVED BY <i>[Signature]</i> DIRECTOR OF PUBLIC WORKS
DRAWN BY B.L.		
RECOMMENDED BY <i>[Signature]</i>		DATE 1-20-59
ASSISTANT CITY ENGINEER		

R-188
SHEET 3 OF 3