


5' WIDE SIDEWALK

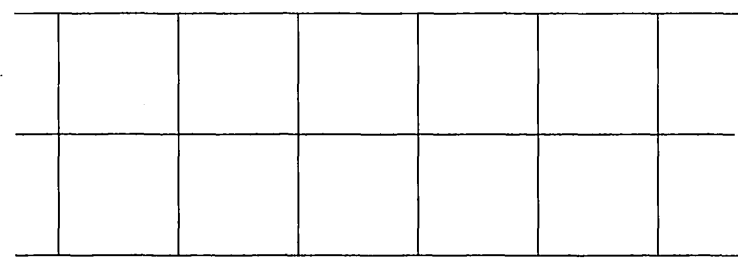


2.5'x2.5' SQUARE PATTERN

SCORING DETAIL

NO SCALE


LAKE EVANS

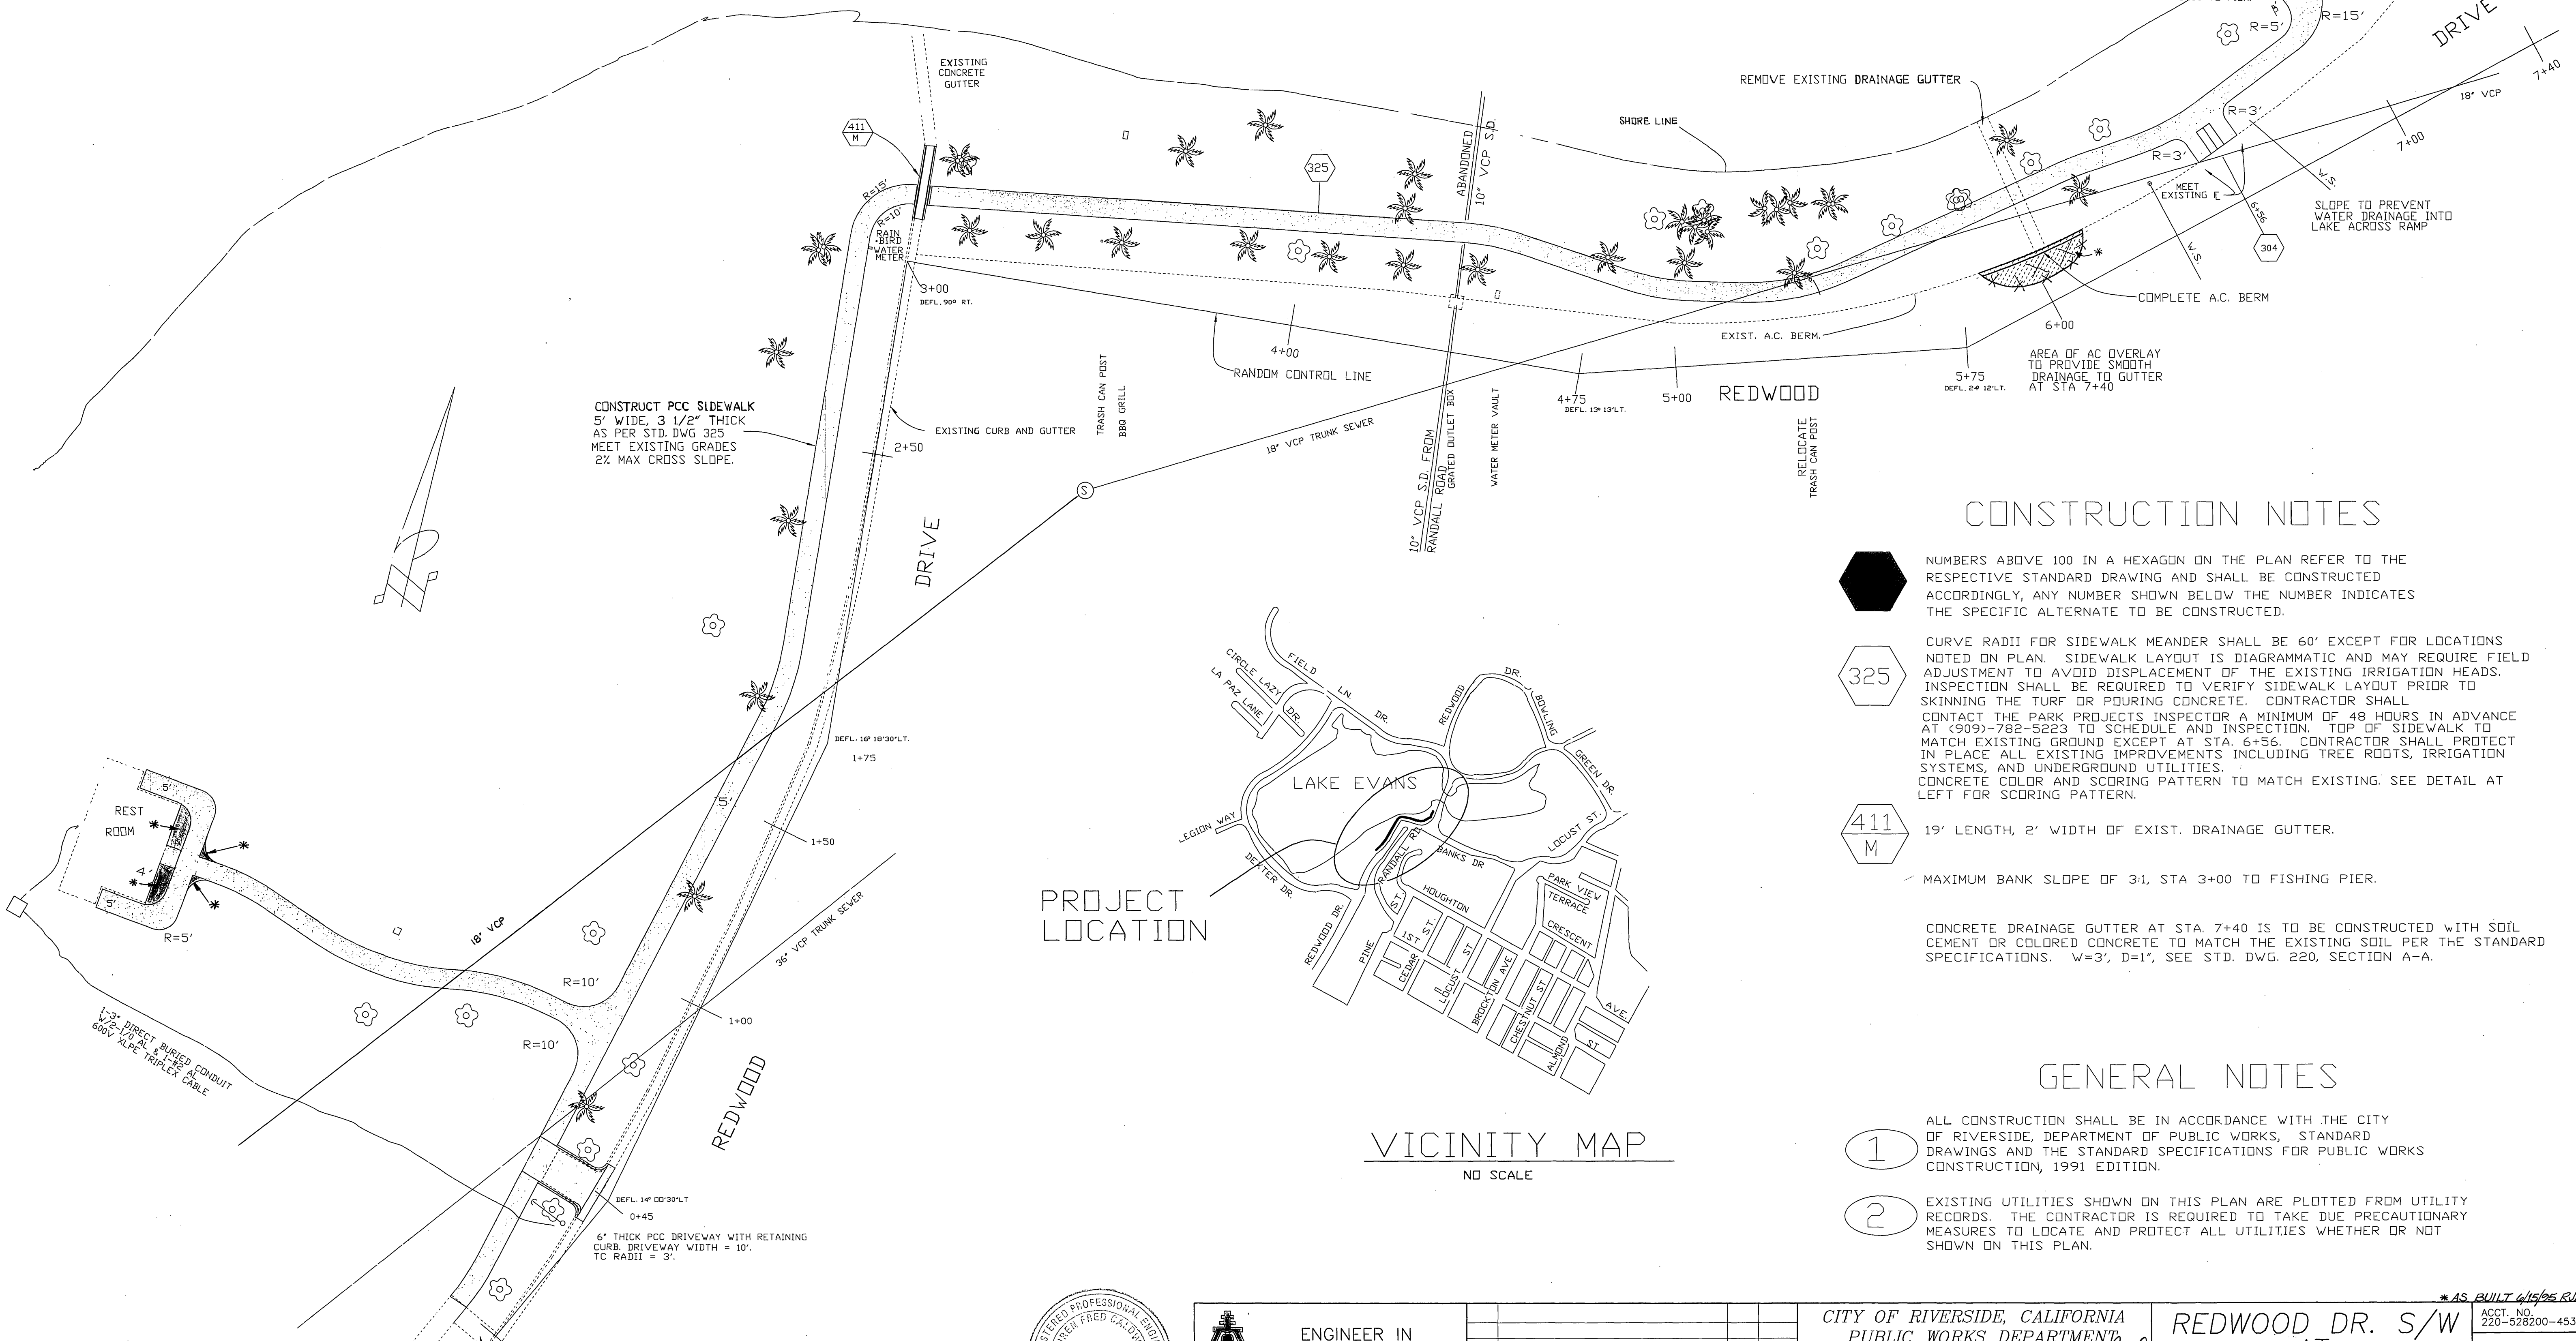


CONSTRUCT PCC SIDEWALK
5' WIDE, 3 1/2" THICK
AS PER STD. DWG 325
MEET EXISTING GRADES
2% MAX CROSS SLOPE.

6" THICK PCC DRIVEWAY WITH RETAINING
CURB. DRIVEWAY WIDTH = 10'.
TC RADII = 3'.


CONSTRUCTION NOTES

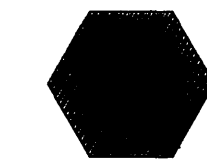

NUMBERS ABOVE 100 IN A HEXAGON ON THE PLAN REFER TO THE RESPECTIVE STANDARD DRAWING AND SHALL BE CONSTRUCTED ACCORDINGLY, ANY NUMBER SHOWN BELOW THE NUMBER INDICATES THE SPECIFIC ALTERNATE TO BE CONSTRUCTED.

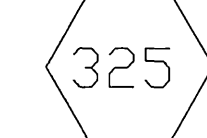

CURVE RADII FOR SIDEWALK MEANDER SHALL BE 60' EXCEPT FOR LOCATIONS NOTED ON PLAN. SIDEWALK LAYOUT IS DIAGRAMMATIC AND MAY REQUIRE FIELD ADJUSTMENT TO AVOID DISPLACEMENT OF THE EXISTING IRRIGATION HEADS. INSPECTION SHALL BE REQUIRED TO VERIFY SIDEWALK LAYOUT PRIOR TO SKINNING THE TURF OR POURING CONCRETE. CONTRACTOR SHALL CONTACT THE PARK PROJECTS INSPECTOR A MINIMUM OF 48 HOURS IN ADVANCE AT (909)-782-5223 TO SCHEDULE AND INSPECTION. TOP OF SIDEWALK TO MATCH EXISTING GROUND EXCEPT AT STA. 6+56. CONTRACTOR SHALL PROTECT IN PLACE ALL EXISTING IMPROVEMENTS INCLUDING TREE ROOTS, IRRIGATION SYSTEMS, AND UNDERGROUND UTILITIES. CONCRETE COLOR AND SCORING PATTERN TO MATCH EXISTING. SEE DETAIL AT LEFT FOR SCORING PATTERN.

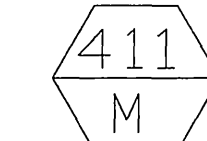


19' LENGTH, 2' WIDTH OF EXIST. DRAINAGE GUTTER.


MAXIMUM BANK SLOPE OF 3:1, STA 3+00 TO FISHING PIER.

CONCRETE DRAINAGE GUTTER AT STA. 7+40 IS TO BE CONSTRUCTED WITH SOIL CEMENT OR COLORED CONCRETE TO MATCH THE EXISTING SOIL PER THE STANDARD SPECIFICATIONS. W=3', D=1', SEE STD. DWG. 220, SECTION A-A.

GENERAL NOTES

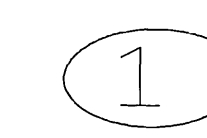

ALL CONSTRUCTION SHALL BE IN ACCORDANCE WITH THE CITY OF RIVERSIDE, DEPARTMENT OF PUBLIC WORKS, STANDARD DRAWINGS AND THE STANDARD SPECIFICATIONS FOR PUBLIC WORKS CONSTRUCTION, 1991 EDITION.

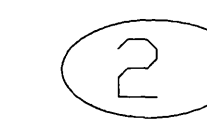

EXISTING UTILITIES SHOWN ON THIS PLAN ARE PLOTTED FROM UTILITY RECORDS. THE CONTRACTOR IS REQUIRED TO TAKE DUE PRECAUTIONARY MEASURES TO LOCATE AND PROTECT ALL UTILITIES WHETHER OR NOT SHOWN ON THIS PLAN.



ENGINEER IN RESPONSIBLE CHARGE
Lauren Caldwell
LAUREN CALDWELL
R.C.E. No. 39441 expires 12/31/97
DATE 7/28/94

MARK	REVISIONS	APPR.	DATE
DESIGNED BY DPY	DRAWN BY	CHECKED BY	

CITY OF RIVERSIDE, CALIFORNIA PUBLIC WORKS DEPARTMENT			
APPROVED BY	BY	DATE	APPROVED BY
DEPUTY P.W. DIRECTOR	Barry	8/18/94	Barry
PRINCIPAL ENGINEER			
CHIEF P.W. INSPECTOR			
SUPERVISOR			
TRAFFIC DIVISION			
PARKS DEPARTMENT			

REDWOOD DR. S/W
AT
FAIRMOUNT PARK
(HUD FUNDED PROJECT)

ACCT. NO.
220-526200-453002-12053
R-3146
SHEET 1 OF 1
FILE NO.

SURVEY CONTROL
RANDOM LINE AS PER LL27, PG 86-87A.