



PROJECT	DATE
NO. 100	1920
BY	
CHECKED	
APPROVED	

DATE	BY
1920	

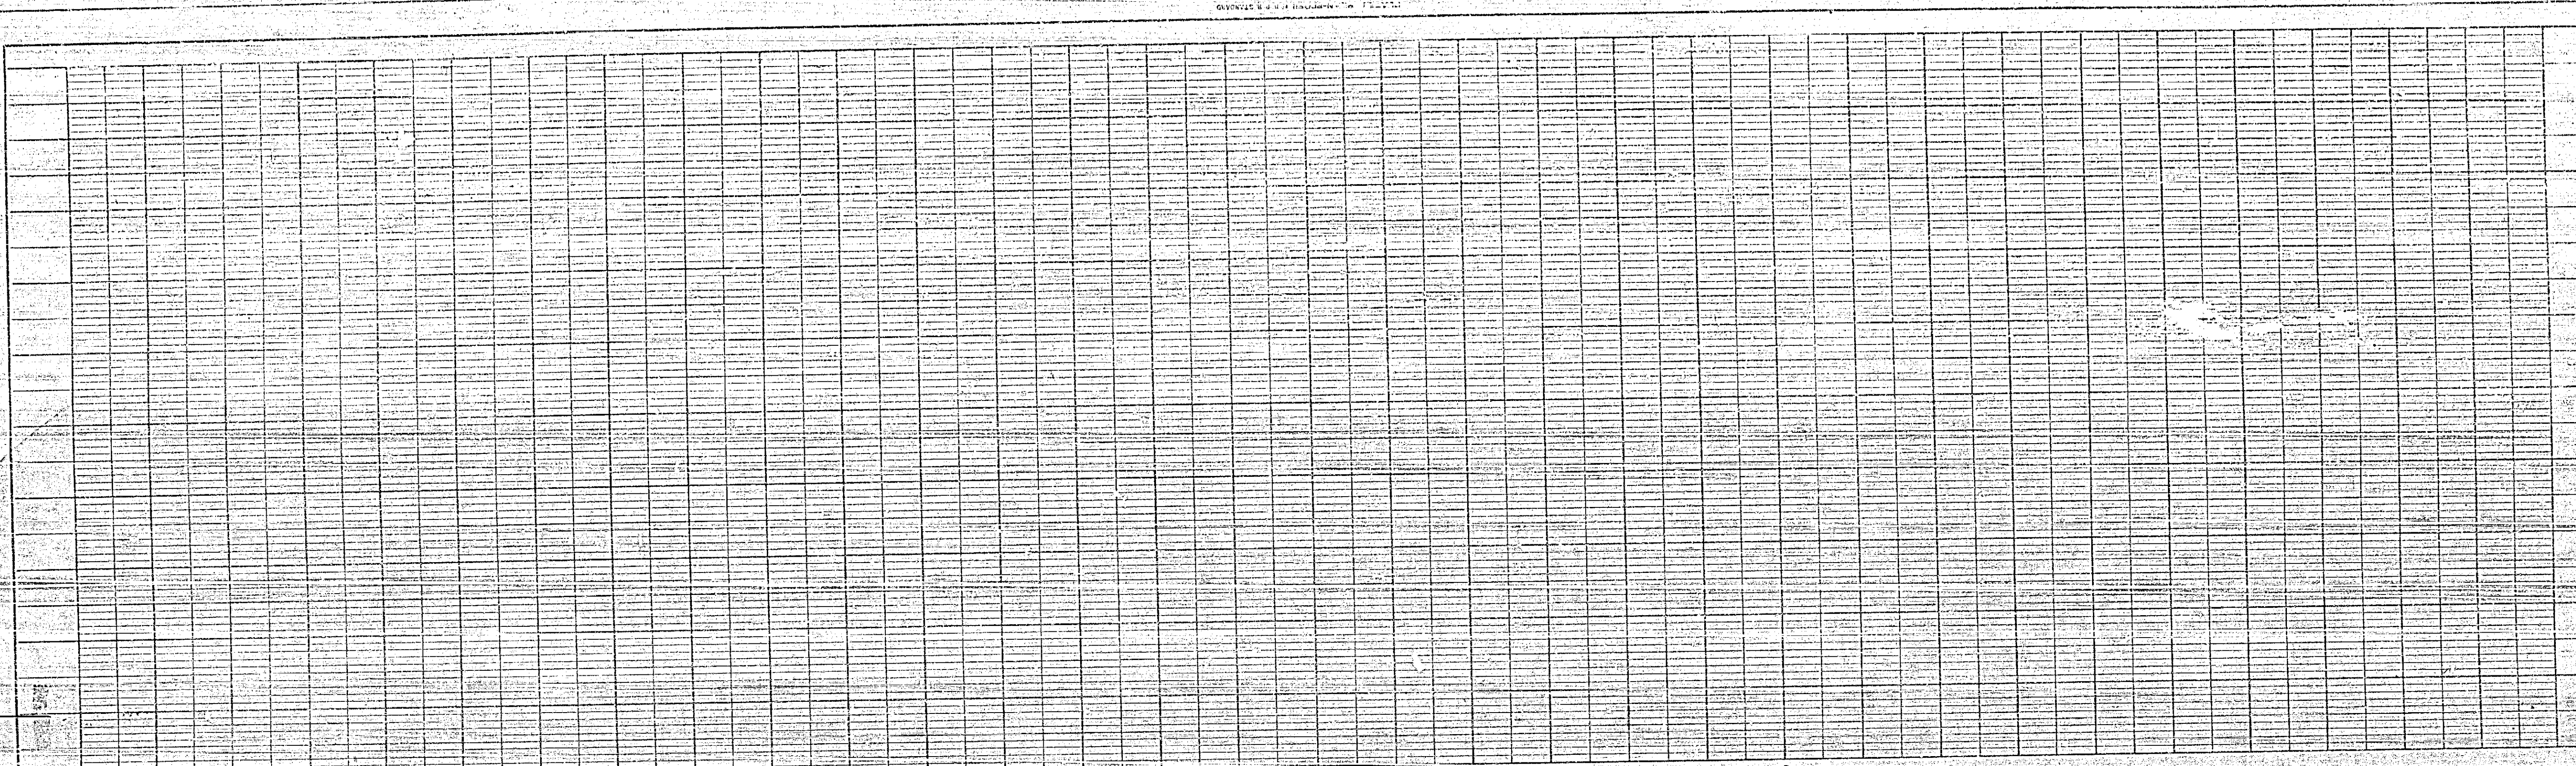

SCALE  $\frac{1}{2}$  1" = 50'

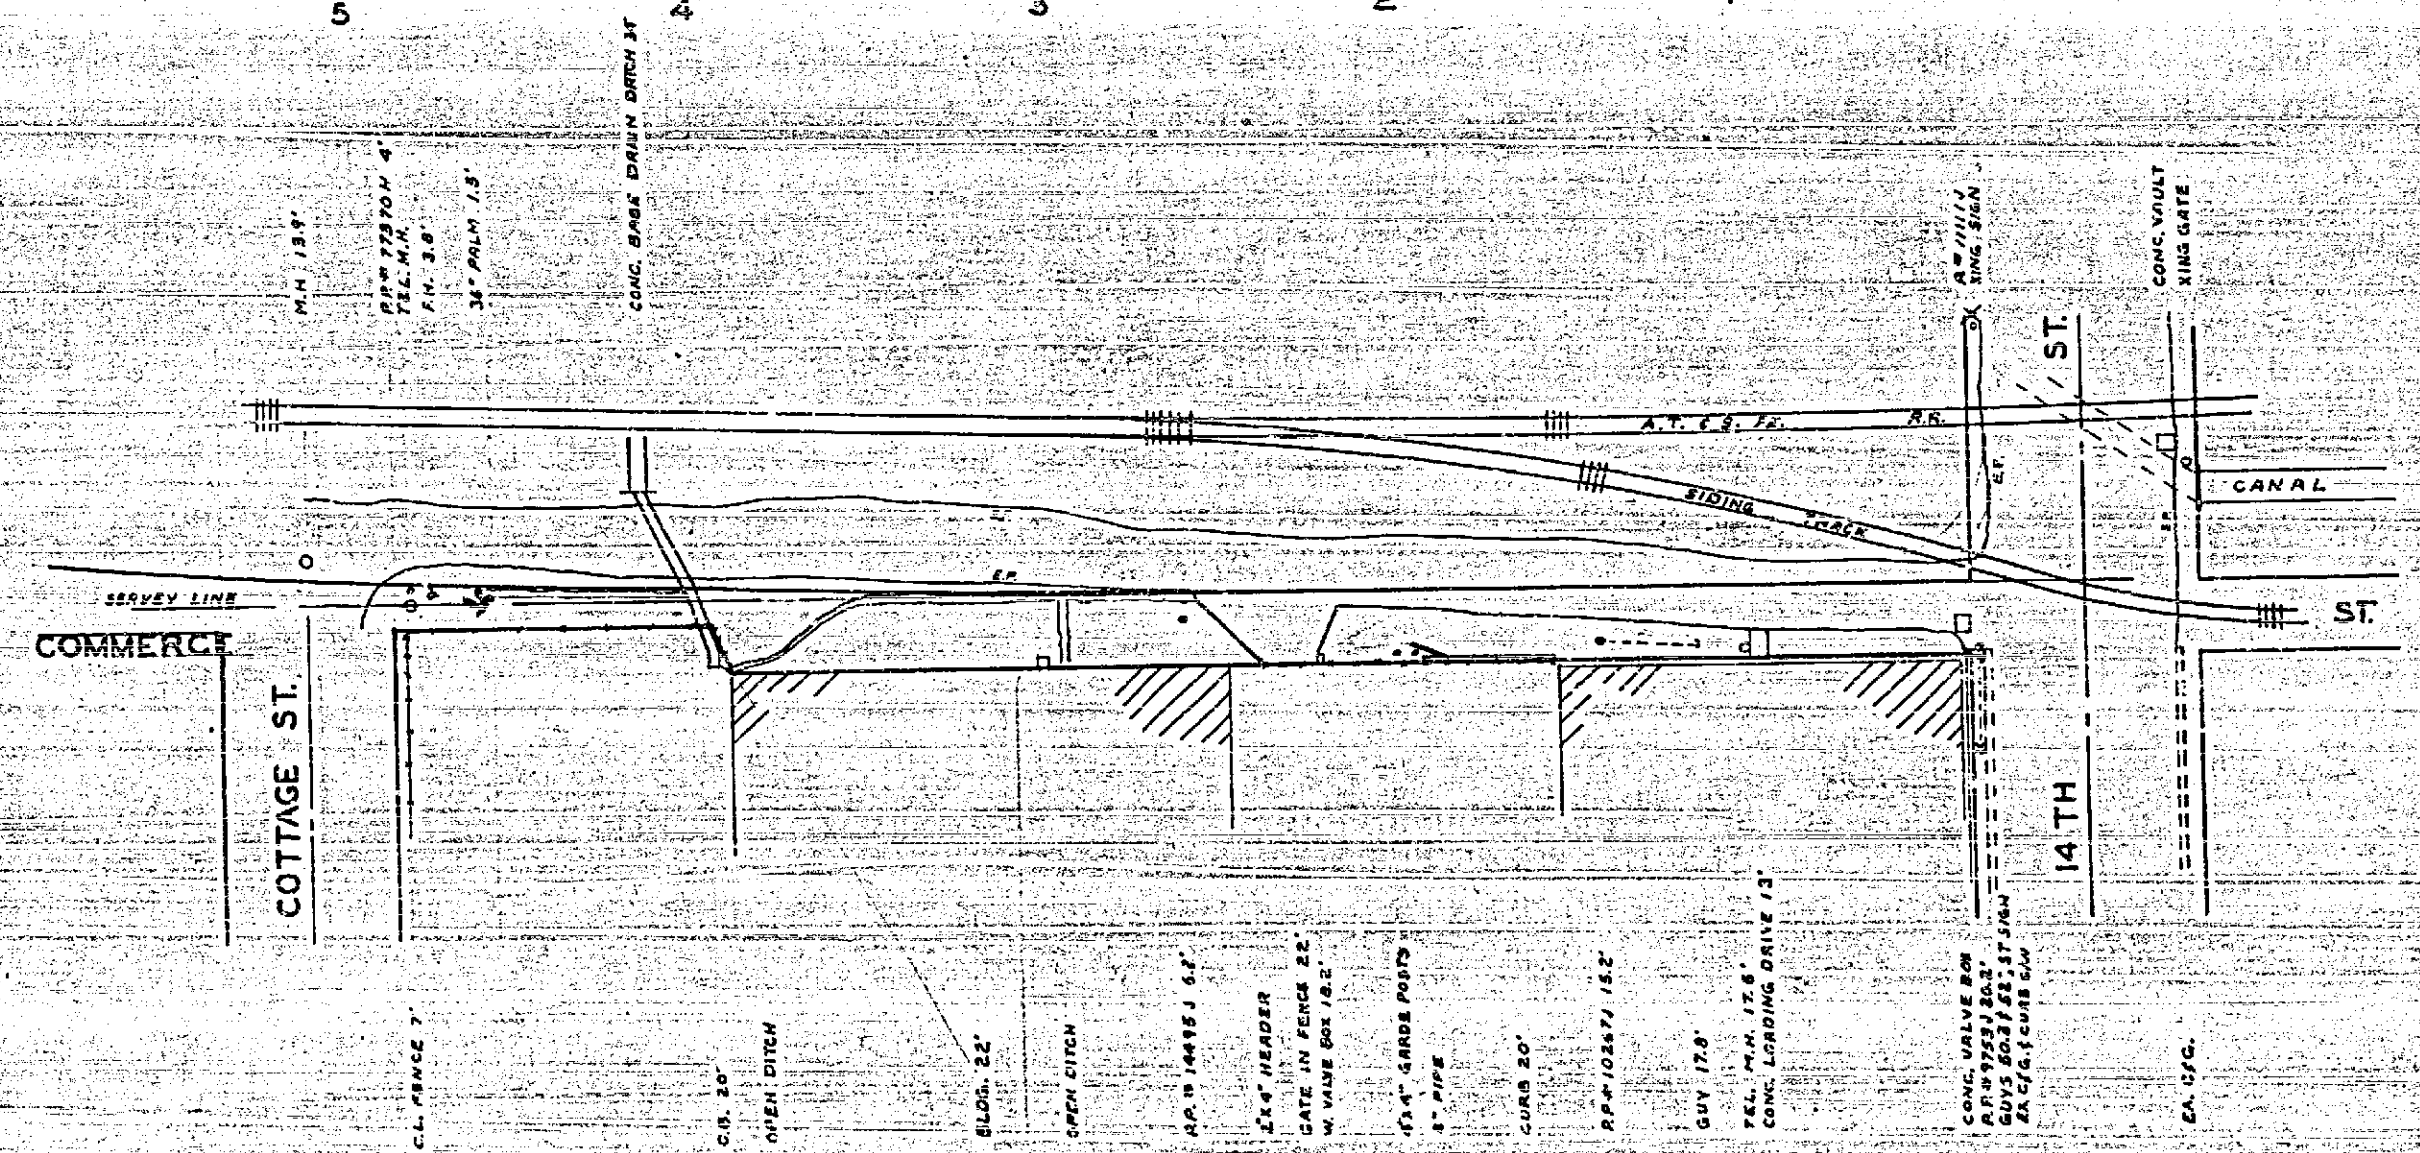

REVISIONS		CITY OF RIVERSIDE, CALIFORNIA DEPARTMENT OF PUBLIC WORKS
MARK	DATE	
		COMMERCE STREET BET. 14TH ST. & COTTAGE ST.
DESIGNED BY	CHECKED BY	APPROVED BY
DRAWN BY B.L.		DIRECTOR OF PUBLIC WORKS
RECOMMENDED BY	ASSISTANT CITY ENGINEER	DATE

R-320  
SHEET 1 OF 1

