


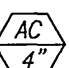






INCORPORATED 1883

RIVERSIDE CALIFORNIA
PUBLIC WORKS DEPARTMENT

SIDEWALK CONSTRUCTION AT VARIOUS LOCATIONS (1998/99)
AND
WHEELCHAIR ACCESSIBILITY (1999)


GENERAL CONSTRUCTION NOTES

- 1 EXISTING UTILITIES SHOWN ON THIS PLAN ARE PLOTTED FROM UTILITY RECORDS. THE CONTRACTOR IS REQUIRED TO TAKE DUE PRECAUTIONARY MEASURES TO LOCATE AND PROTECT ALL UTILITIES WHETHER OR NOT SHOWN ON THIS PLAN.
- 2 PRIME CONTRACTORS BIDDING THIS WORK SHALL HAVE A CLASS A, C-8 OR C-12 LICENSE.
- 3 CONFLICTING UTILITIES, SHOWN WITHIN CONSTRUCTION AREA, WILL BE RELOCATED PRIOR TO CONSTRUCTION.
- 4 RIGHTS OF ENTRY HAVE BEEN OBTAINED FOR WORK SHOWN OUTSIDE OF CITY RIGHT OF WAY.
- 5 TREES AND SHRUBS, AFFECTED BY THE PROPOSED SIDEWALK CONSTRUCTION, SHALL BE TRIMMED TO AT LEAST 8' VERTICALLY ABOVE THE SIDEWALK SURFACE AND TO AT LEAST 3' LATERALLY OF THE SIDEWALK, WHERE RIGHT-OF-WAY PERMITS.
- 6 MAIL BOXES, INTERFERING WITH PROPOSED SIDEWALK CONSTRUCTION, SHALL BE TEMPORARILY RELOCATED TO ENABLE PROPERTY OWNERS TO RECEIVE THEIR MAIL AND BE REINSTALLED IN FINAL POSITION BY THE CONTRACTOR.
- 7 WATER METERS, GAS METERS AND STREET LIGHT PULL BOXES AFFECTED BY CONSTRUCTION, SHALL BE ADJUSTED TO THE PROPOSED SIDEWALK GRADE.
- 8 EXISTING SPRINKLERS AND IRRIGATION LINES, AFFECTED BY THE CONSTRUCTION OF THE PROPOSED SIDEWALK, SHALL BE RELOCATED TO THE BACK OF THE SIDEWALK.


SPECIFIC CONSTRUCTION NOTES

- NUMBERS, ABOVE 100 IN A HEXAGON ON THE PLAN, REFER TO THE RESPECTIVE STANDARD DRAWING AND SHALL BE CONSTRUCTED ACCORDINGLY, UNLESS MODIFICATIONS ARE NOTED ON THE PLAN OR COVER SHEET. ANY NUMBER SHOWN BELOW THE STANDARD DRAWING NUMBER INDICATES THE SPECIFIC ALTERNATE TO BE CONSTRUCTED.
- REMOVE & REPLACE EXISTING PAVEMENT TO CONSTRUCT A 5% MAXIMUM SLOPE AT BOTTOM OF THE WHEELCHAIR RAMP AS SHOWN ON STD. 304.
-  REMOVE AND REPLACE 4" AC PAVEMENT FOR MATCHING PURPOSE.
-  CONSTRUCT P.C.C. RETAINING CURB (W= 6", H= Variable).
-  GRIND EXISTING CURB FACE TO 0" AT WHEELCHAIR RAMP DEPRESSION AS SHOWN ON STD. 304.
-  PROTECTION IN PLACE.
-  REMOVE EXISTING STREET TREE (CLASS I - 6" TO 18", CLASS II - OVER 18" TO 36", CLASS III - OVER 36").
-  RELOCATE CHAIN LINK FENCE 0.5' OUTSIDE R/W (NOTE: REUSE EXISTING FENCE FABRIC AND USE NEW IN KIND POSTS.)
-  TRANSPLANT TREE TO BACK OF THE PROPOSED SIDEWALK AS DIRECTED BY THE TREE INSPECTOR.


SITE	LOCATION
1	CALIFORNIA AVENUE - MONROE ST. TO ADAMS ST. (N'LY SIDE)
2	ARLINGTON AVENUE - MITCHELL AVE. TO COPPER LANTERN DR. (N'LY SIDE)
3	SIERRA VISTA STREET - ANACAPA PL. (E'LY SIDE)

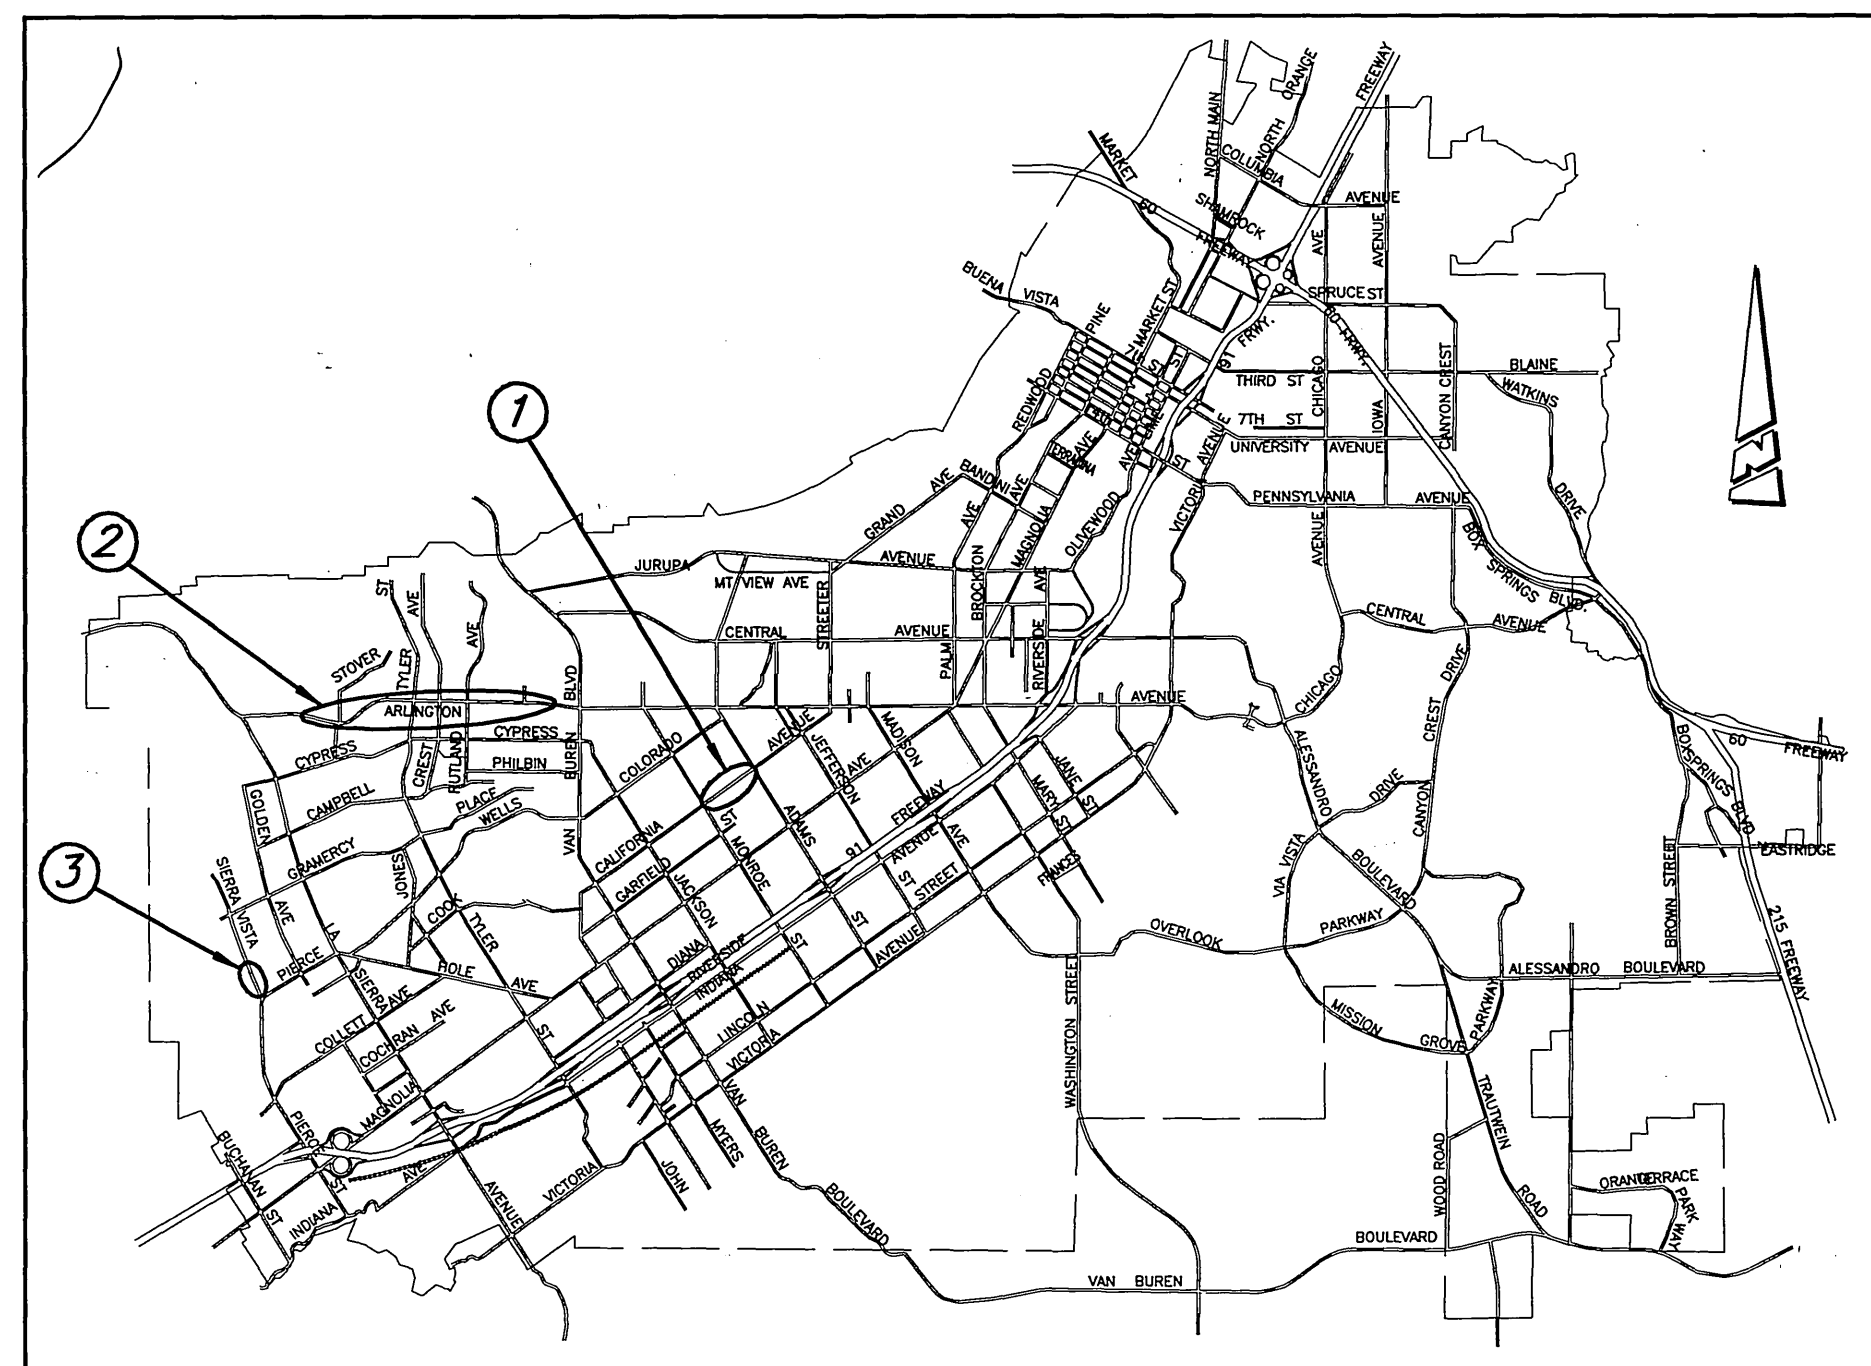

PROJECT LOCATION MAP

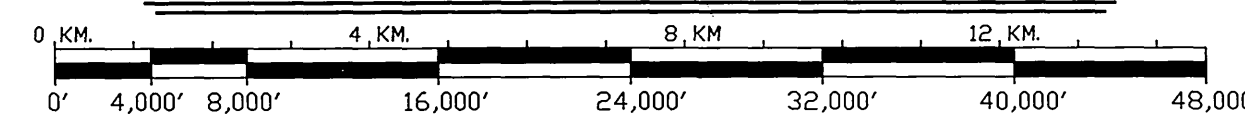

SCALE: 1" = 8,000'

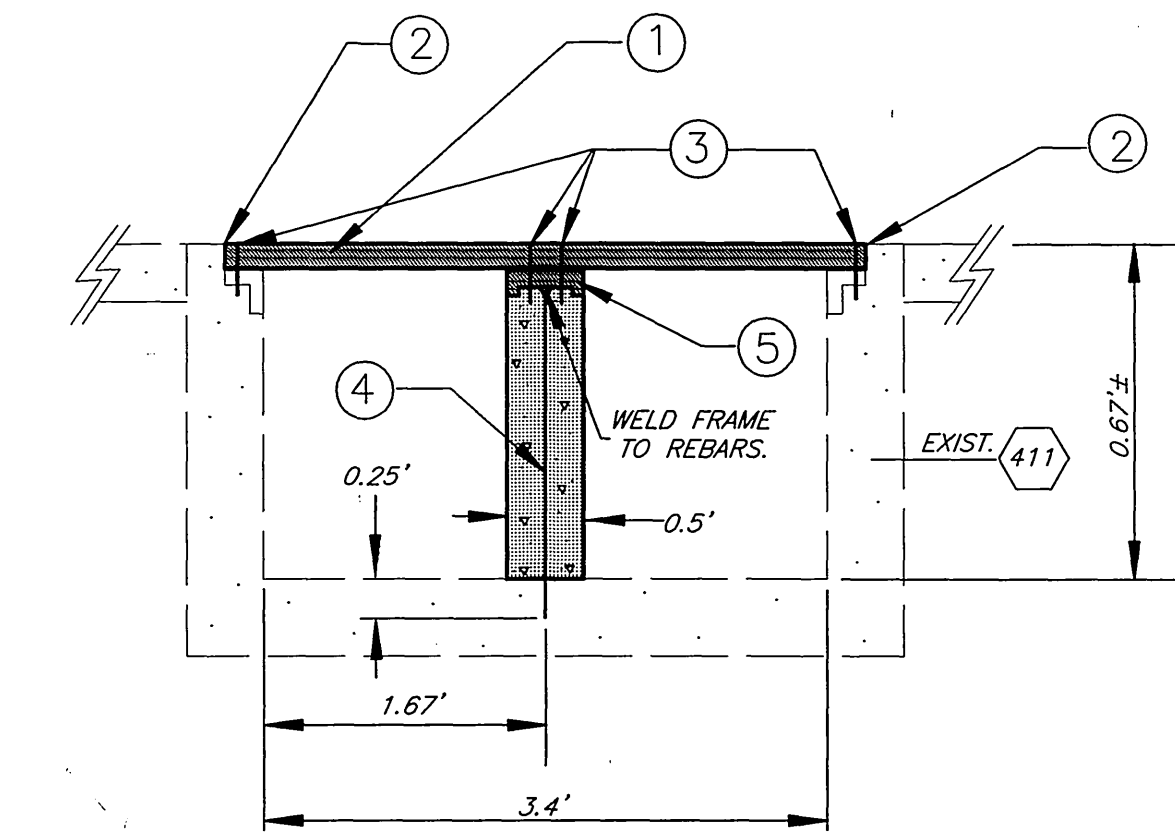


REPAIR UNDER S/W DRAIN

AT 8207 ARLINGTON AVENUE (NTS)


NOTES:

- 1 3/8" GALVANIZED CHECKERED PLATE.
- 2 GRIND PLATE EDGES TO MATCH SIDEWALK AND RE-GALVANIZE EDGES AFTER GRINDING.
- 3 FASTEN PLATE WITH 1/4" COARSE-THREAD METAL SCREW @ 24" O.C.
- 4 #4 STEEL REBAR @ 12" O.C.
- 5 WELD 6"x1"x3/8" "C" SHAPE GALVANIZED STEEL FRAME OVER THE 1/2" REBAR.

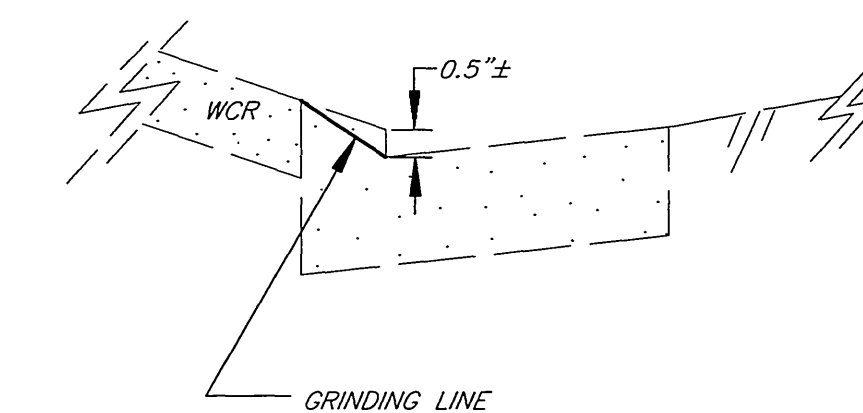

WCR CURB FACE GRINDING DETAIL

(NTS)

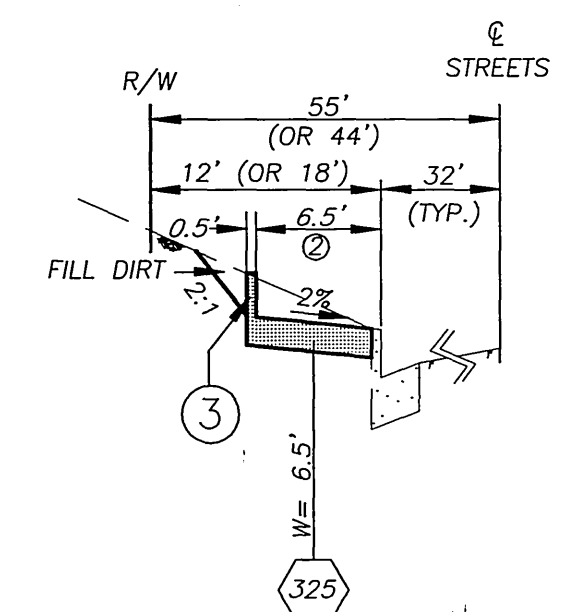

SIDEWALK TYPICAL SECTIONS

(NTS)

NOTES:

- 1 MIN. S/W CLEARNESS IS 4' AT UTILITIES OR TREES.
- 2 5' WIDE S/W AT 10571 & 10573 ARLINGTON AVE.
- 3 PCC RETAINING CURB REQUIRED AT 8665, 10555, 10563, 10571, 10573, 10621 & 10707 ARLINGTON AVE. ONLY.

IMPORTANT NOTICE
 Section 4216/4217 of the Government Code requires a Dig Alert Identification Number to be issued before a "Permit to Excavate" will be valid. For your Dig Alert I.D. Number call CALL TOLL FREE 48 HOURS BEFORE YOU DIG UNDERGROUND SERVICE ALERT 1-800-227-2600

ENGINEER IN RESPONSIBLE CHARGE
 LAUREN F. CALDWELL
 R.C.E. No. 39441 expires 12/31/2001
 DATE 4/19/99

MARK	REVISIONS	APPR.	DATE

CITY OF RIVERSIDE, CALIFORNIA
 PUBLIC WORKS DEPARTMENT

APPROVED BY	BY	DATE
ENGINEERING MANAGER	TRB	4/20/99
PRINCIPAL ENGINEER	CS	4/16/99
TRAFFIC DIVISION	CS	4/16/99
SURVEYOR	CS	4/16/99
STREET SERVICES	CS	4/16/99
PARKS DEPARTMENT	CS	4/16/99

APPROVED BY: R. Mc. Heath
 PUBLIC WORKS DIRECTOR
 DATE: 4-21-99





SIDEWALK CONSTRUCTION AT VARIOUS LOCATIONS (1998/99) AND WHEELCHAIR ACCESSIBILITY (1999)

HORIZ. SCALE: 1" = 100'


ACCT. NO. 230-541500-440223-30029
R-3511
 SHEET 1 OF 2
 FILE: MDICK\U:\DWG\R3511-01.PAK & REC. PC-4140-S

INDEXED 5-4-99 LPH

ARLINGTON AVENUE

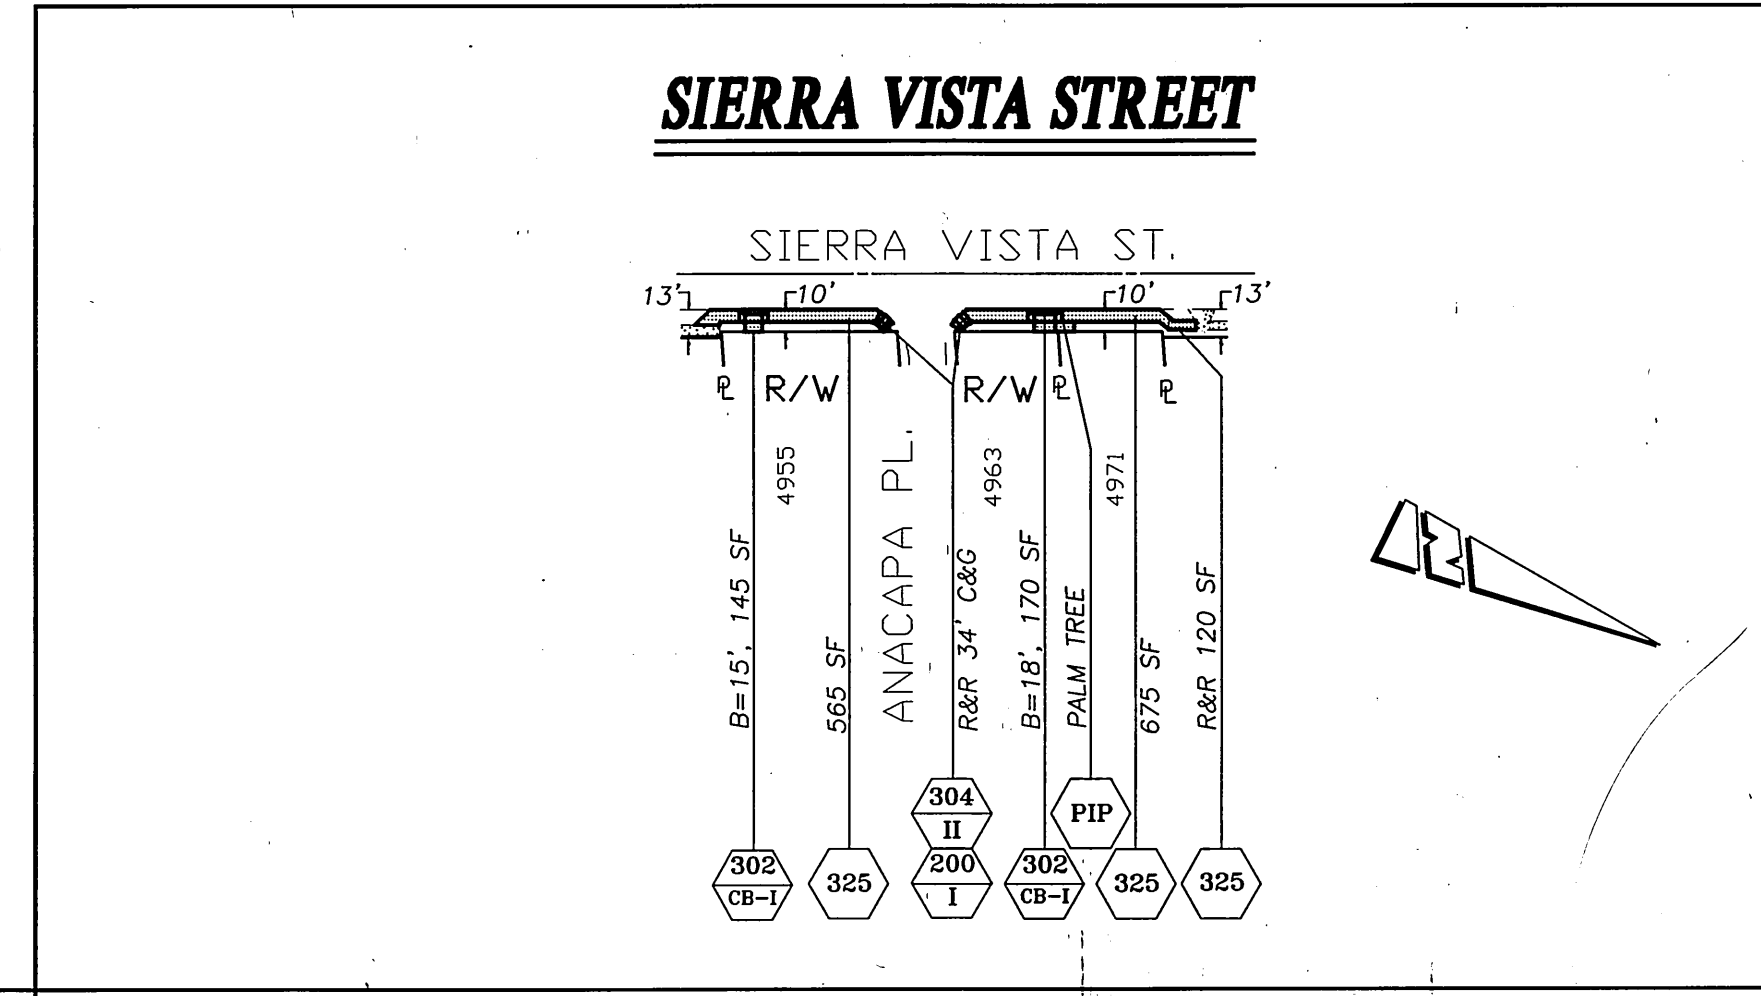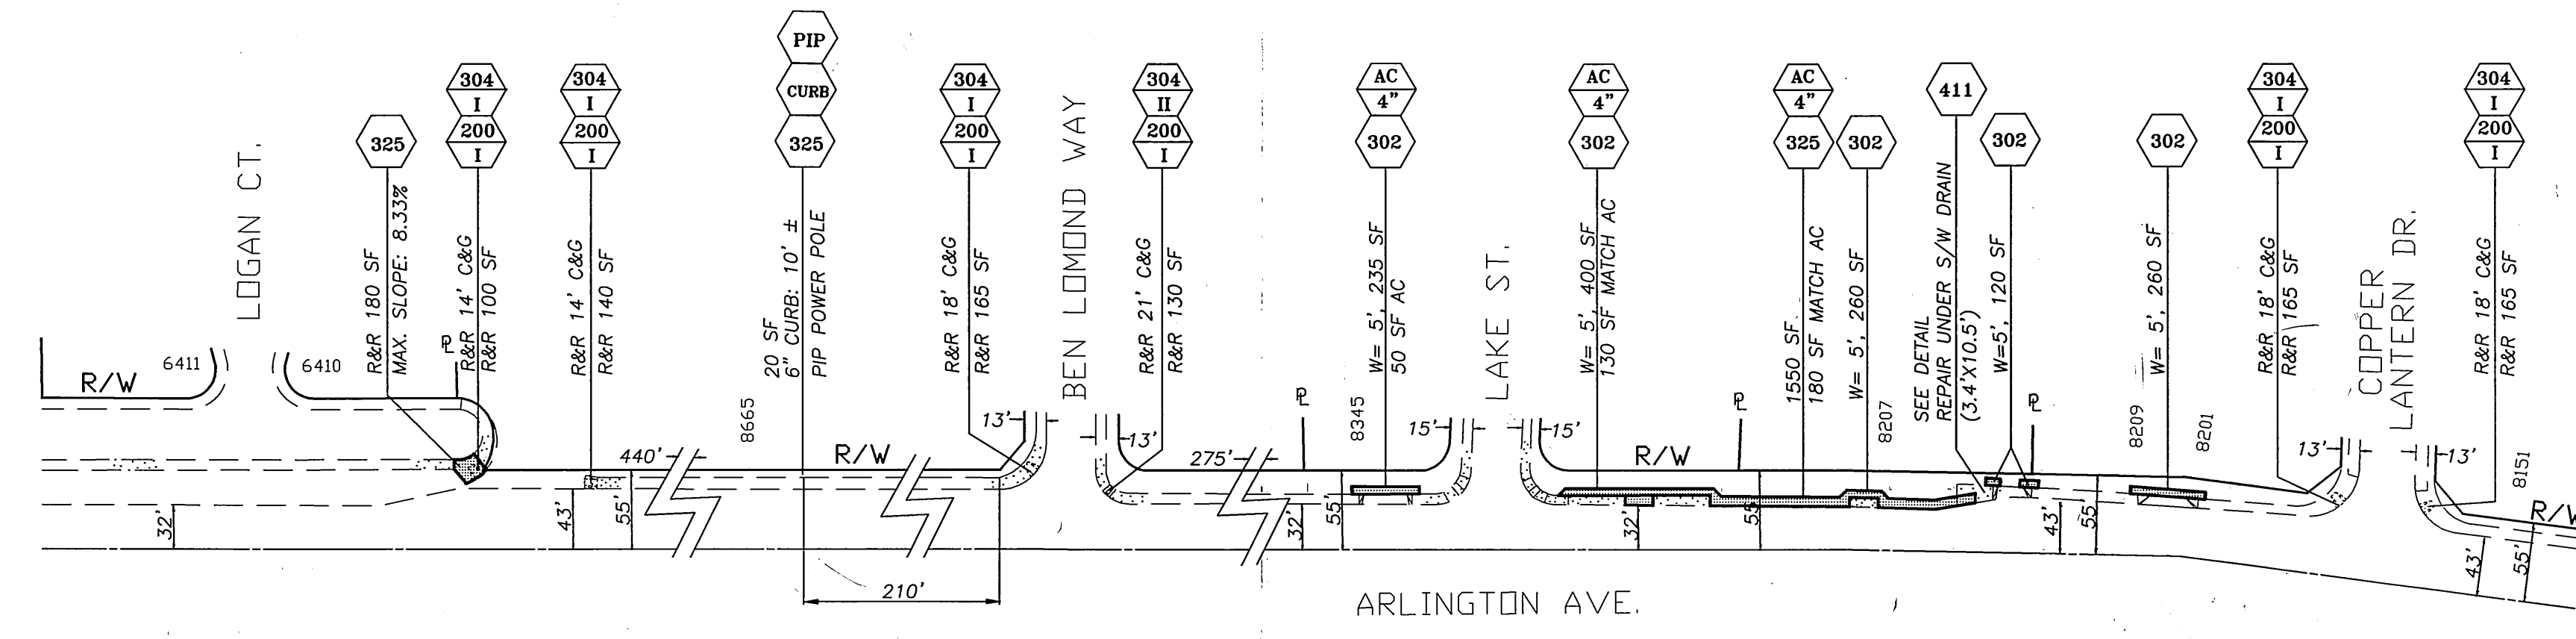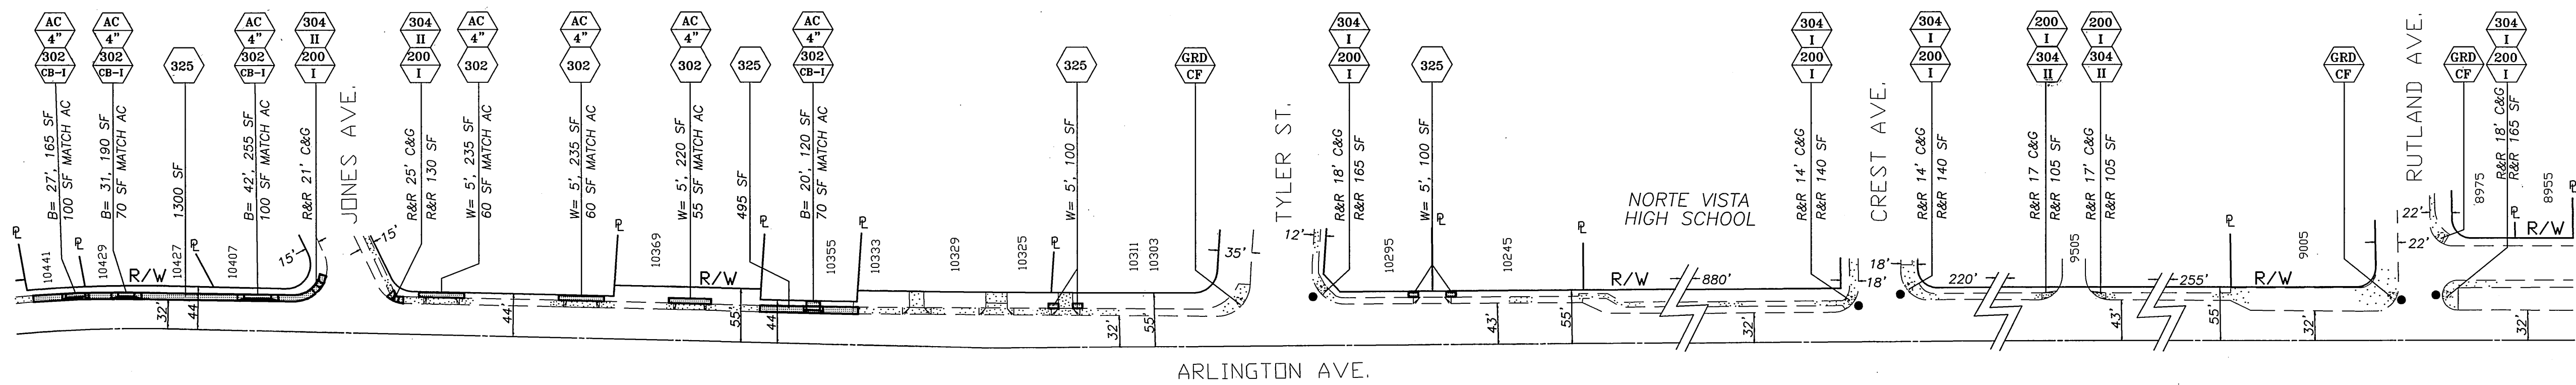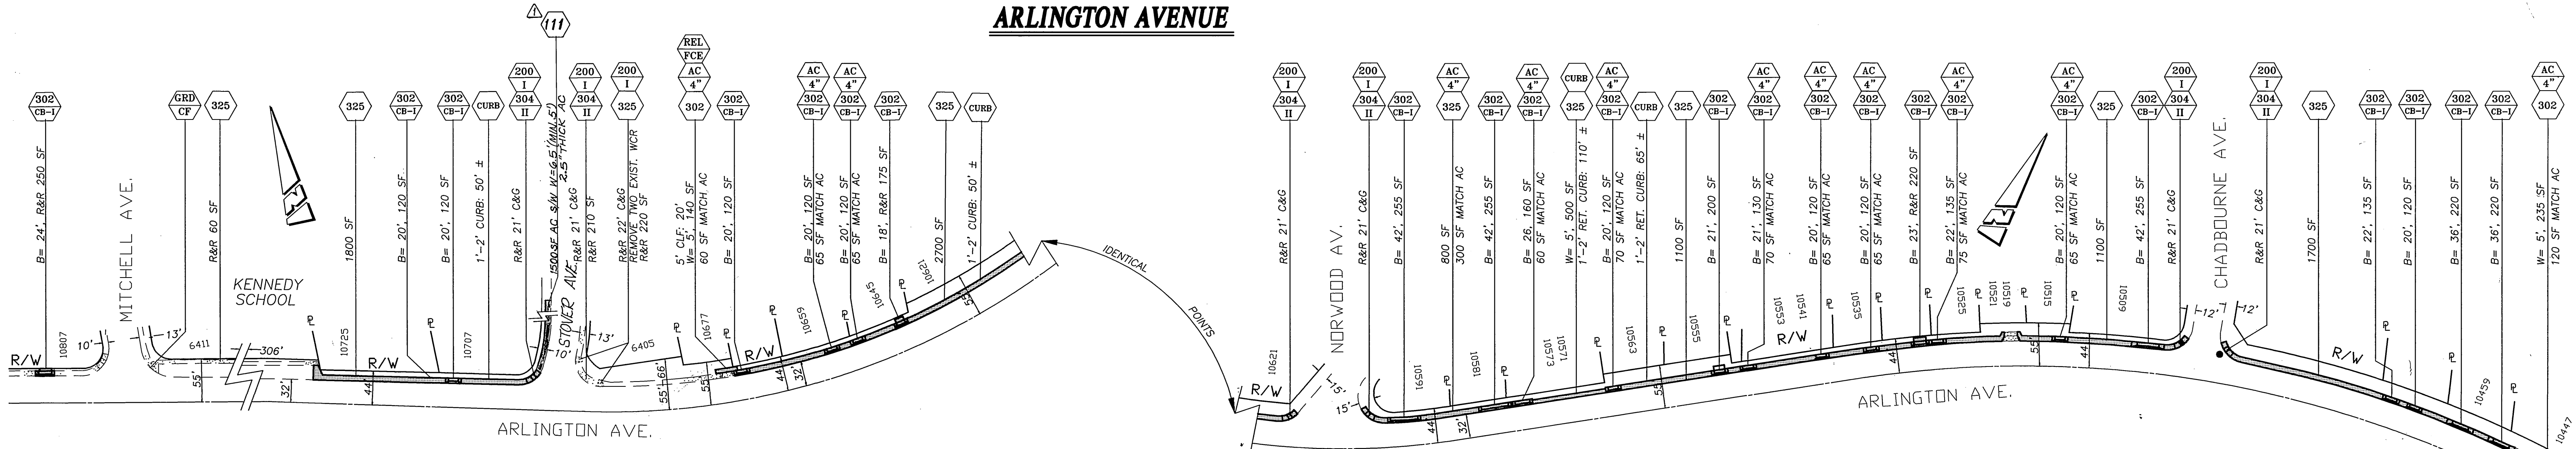

CALIFORNIA AVENUE

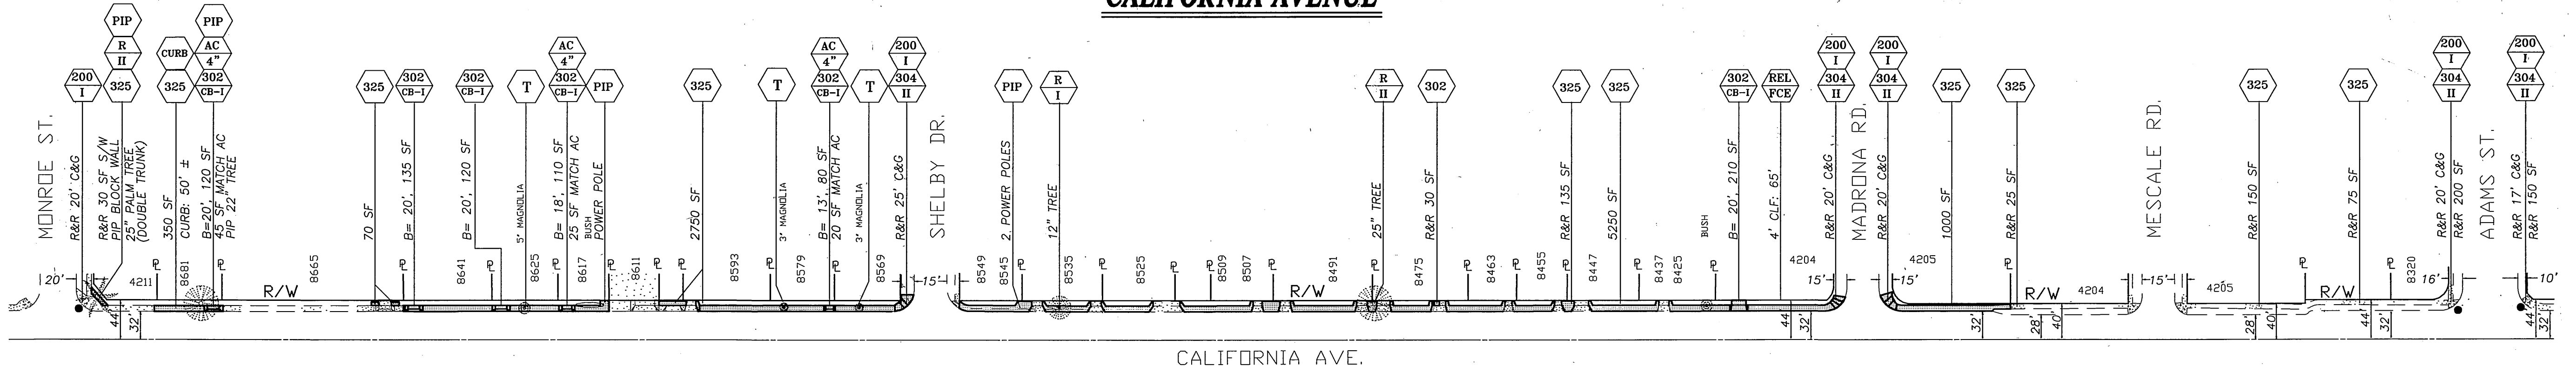

ENGINEER IN RESPONSIBLE CHARGE
Lauren F. Caldwell
 LAUREN F. CALDWELL
 R.C.E. No. 39441 expires 12/31/2001
 DATE 4/19/99



DESIGNED BY	FYL	DRAWN BY	RJM	FYL	CHECKED BY	
MARK		REVISIONS		APPR.	DATE	

CITY OF RIVERSIDE, CALIFORNIA PUBLIC WORKS DEPARTMENT			
APPROVED BY	BY	DATE	APPROVED BY
ENGINEERING MANAGER	MS	4/21/99	R. Mc Grath
PRINCIPAL ENGINEER	MS	4/19/99	PUBLIC WORKS DIRECTOR
TRAFFIC DIVISION	MS	4/19/99	
SURVEYOR	MS	4/19/99	
STREET SERVICES	MS	4/19/99	
PARKS DEPARTMENT	MS	4/19/99	

SIDEWALK CONSTRUCTION AT VARIOUS LOCATIONS (1998/99) AND WHEELCHAIR ACCESSIBILITY (1999)

HORIZ. SCALE: 1" = 100'

ACCT. No. 230-541500-440223-30029
R-3511
 SHEET 2 OF 2
 FILE: MDICKU:\DWG\3511-02 PARK & REC.: PC-4140-S

INDEXED 5-4-99 left