




**PROFILE DETAIL**  
OLIVEWOOD AVENUE  
Sta. 11125 to 11205

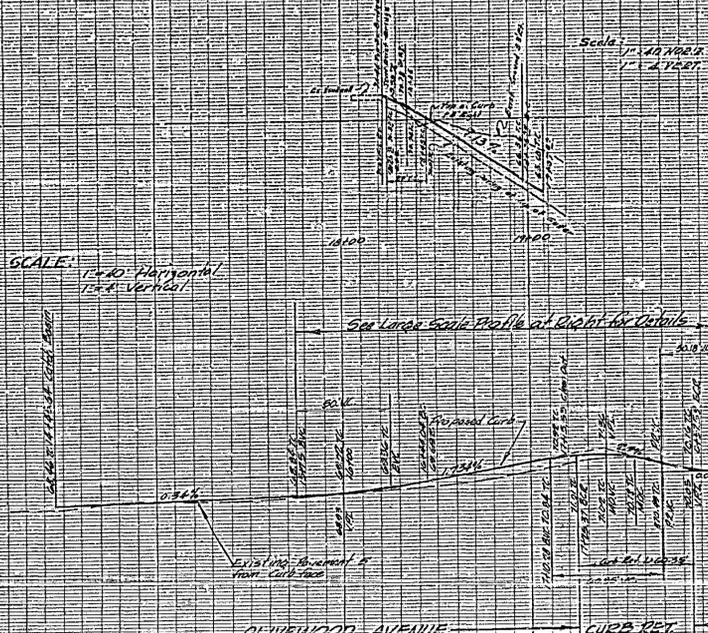


**PROFILE DETAIL**

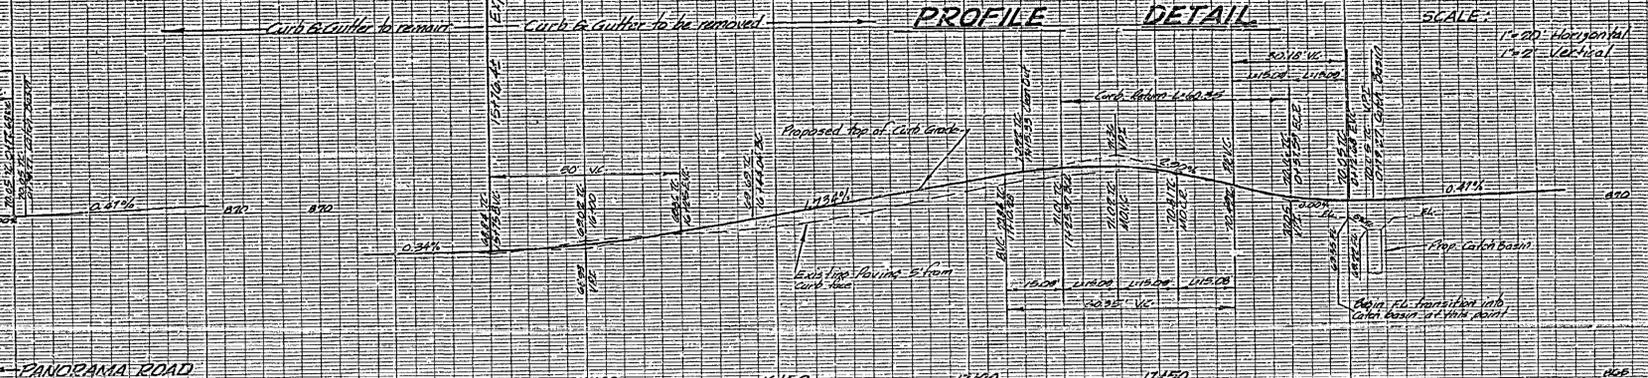

SEE SHEETS 1 & 2 FOR PLAN DRAWINGS

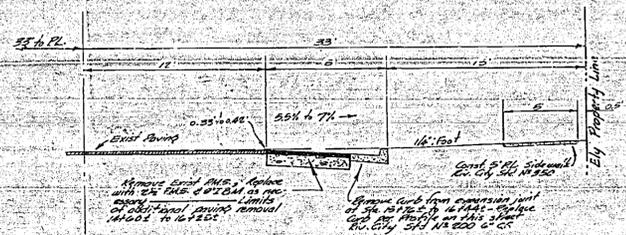

NOTE: This sheet shows revised profiles previously shown on sheets 1 & 2, now marked ② & ③

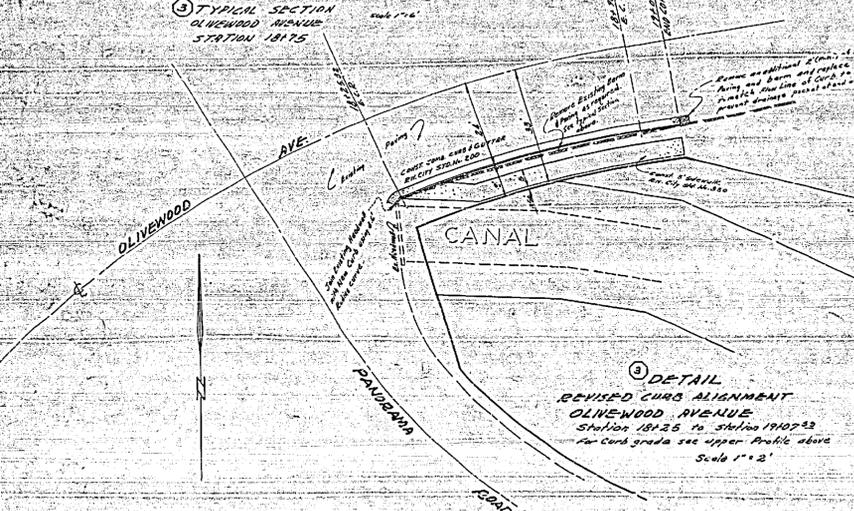



J. F. DAVIDSON - CIVIL ENGINEER  
R.E. NO. 862  
RIVERSIDE, CALIFORNIA  
APPROVED BY *J. P. ...* DATE 7-19-51

CITY OF RIVERSIDE, CALIFORNIA  
DEPARTMENT OF PUBLIC WORKS

REVISIONS	
MARK	DATE
③	6-2-51

STREET PLAN & PROFILE  
Curb grade revisions - Olivewood Ave. & Panorama Rd. curb return CHRISTENSEN SUBDIVISION  
HORIZ. SCALE 1" = 40' VERT. SCALE 1" = 4'

DESIGNED BY *J. F. Davidson*  
DRAWN BY *J. F. Davidson*  
RECOMMENDED BY *J. F. Davidson*  
CHECKED BY *J. P. ...*  
APPROVED BY *J. F. Davidson*  
DATE 7-19-51  
NO. R-370  
SHEET 3 OF 3

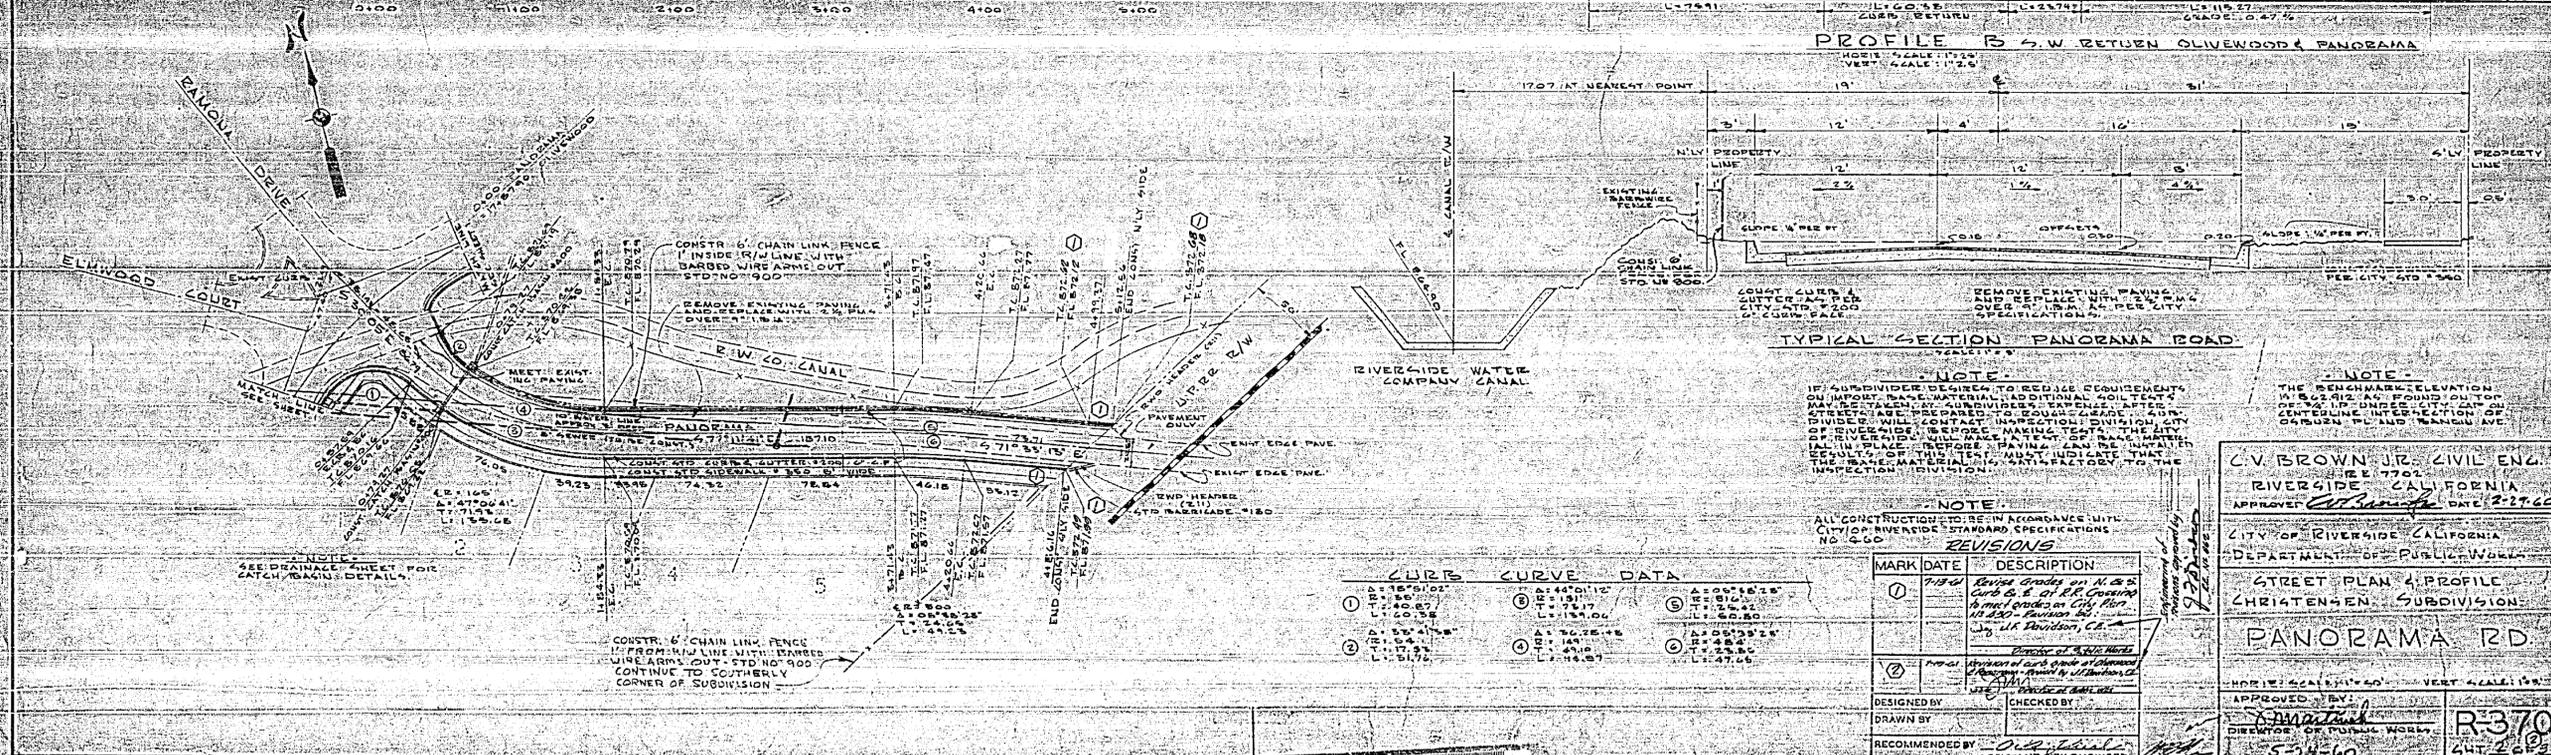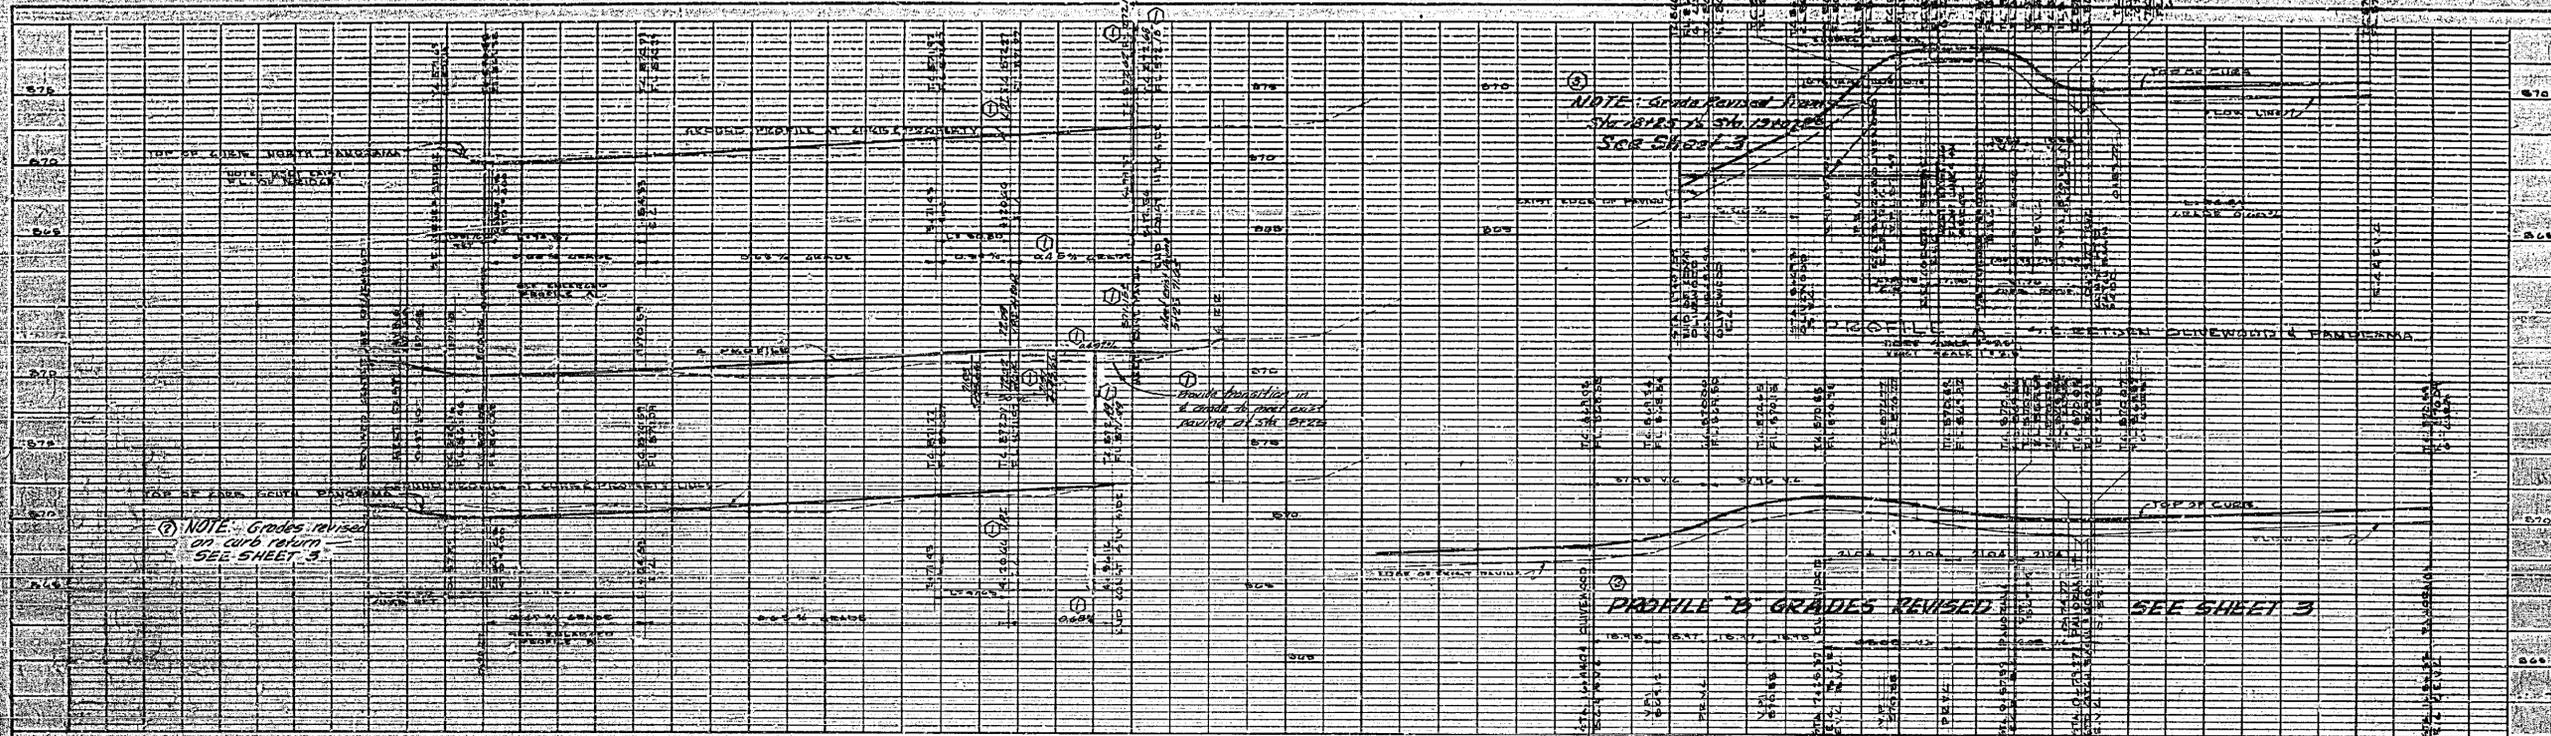

MARK	DATE	DESCRIPTION
1	7/15/60	Grades Revised on A.C.S. Curbs E. of R.R. Crossing to meet grades on City Plan 1/2" = 100' - 5/24/60
2	7/15/60	Grades Revised on City Plan 1/2" = 100' - 5/24/60


**C.V. BROWN JR., CIVIL ENG.**  
 RIVERSIDE, CALIFORNIA  
 APPROVED: *[Signature]* DATE: 5-24-60

CITY OF RIVERSIDE, CALIFORNIA  
 DEPARTMENT OF PUBLIC WORKS  
 STREET PLAN & PROFILE  
 CHRISTENGEN SUBDIVISION  
 PANORAMA RD.

DESIGNED BY: *[Signature]*  
 DRAWN BY: *[Signature]*  
 RECOMMENDED BY: *[Signature]* ASSISTANT CITY ENGINEER


APPROVED BY: *[Signature]*  
 DIRECTOR OF PUBLIC WORKS  
 5-24-60

R-370  
 5-24-60






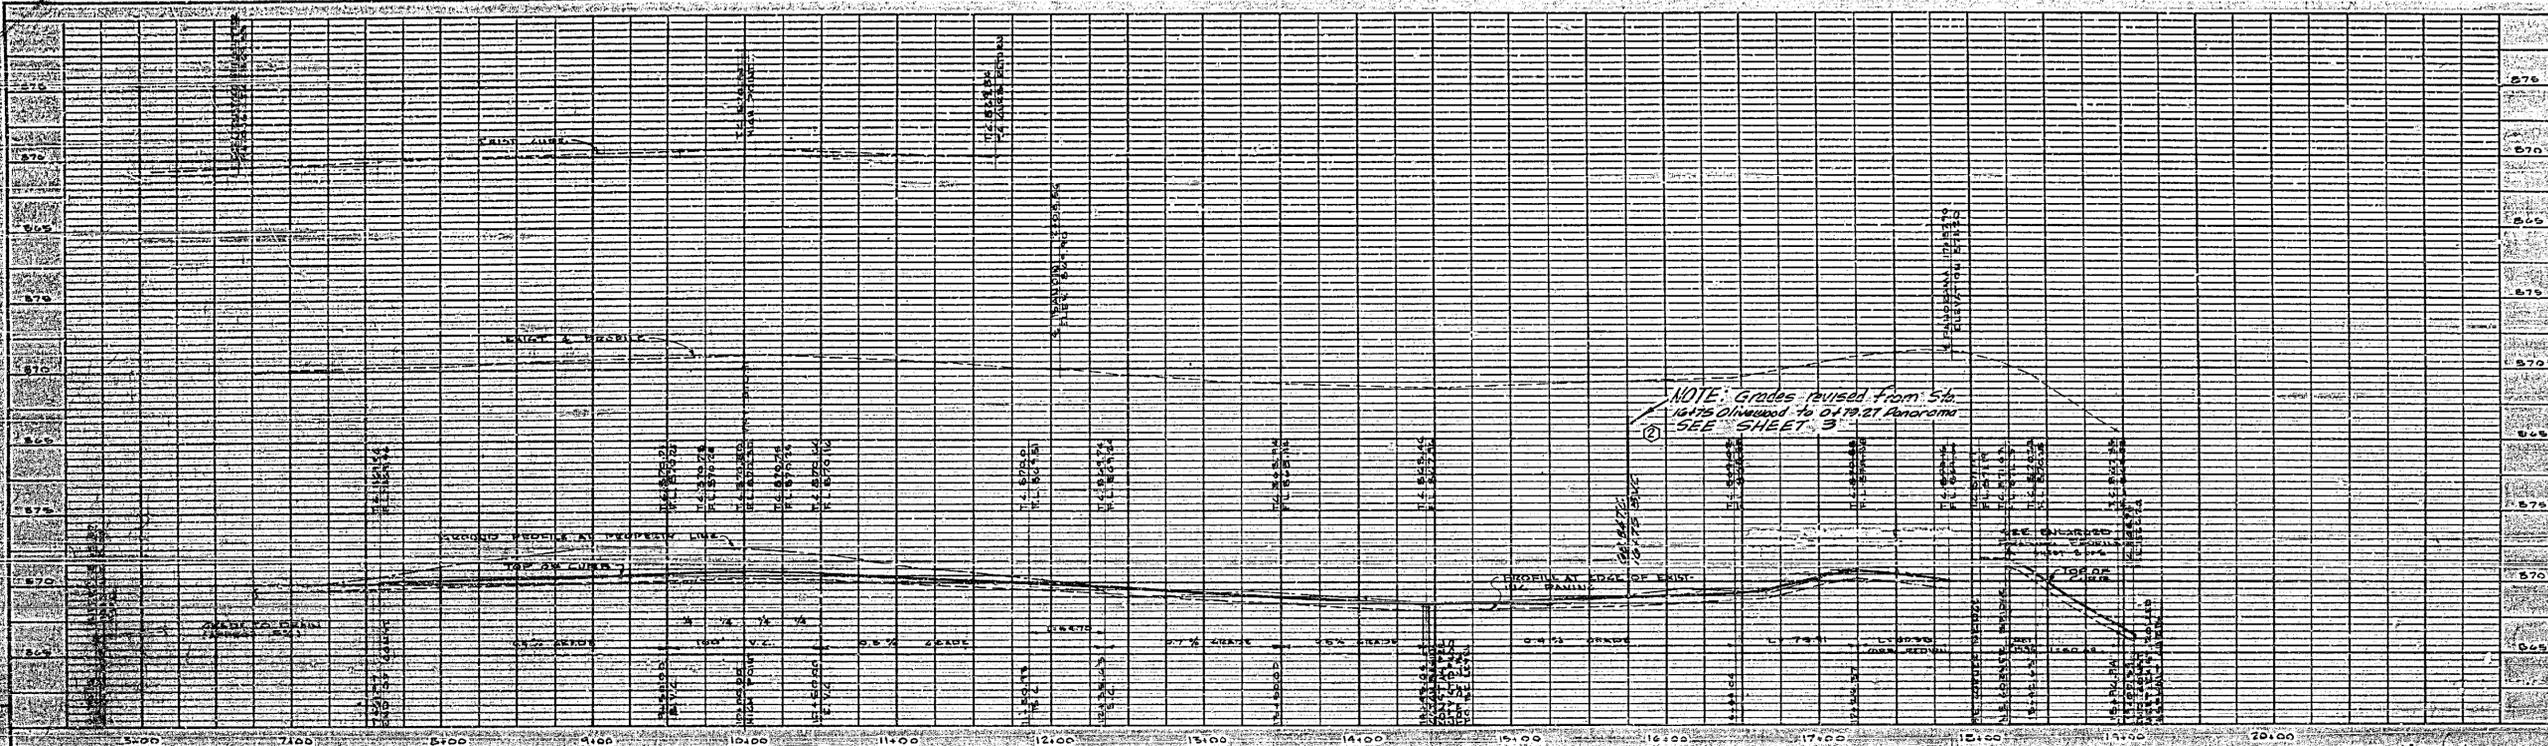


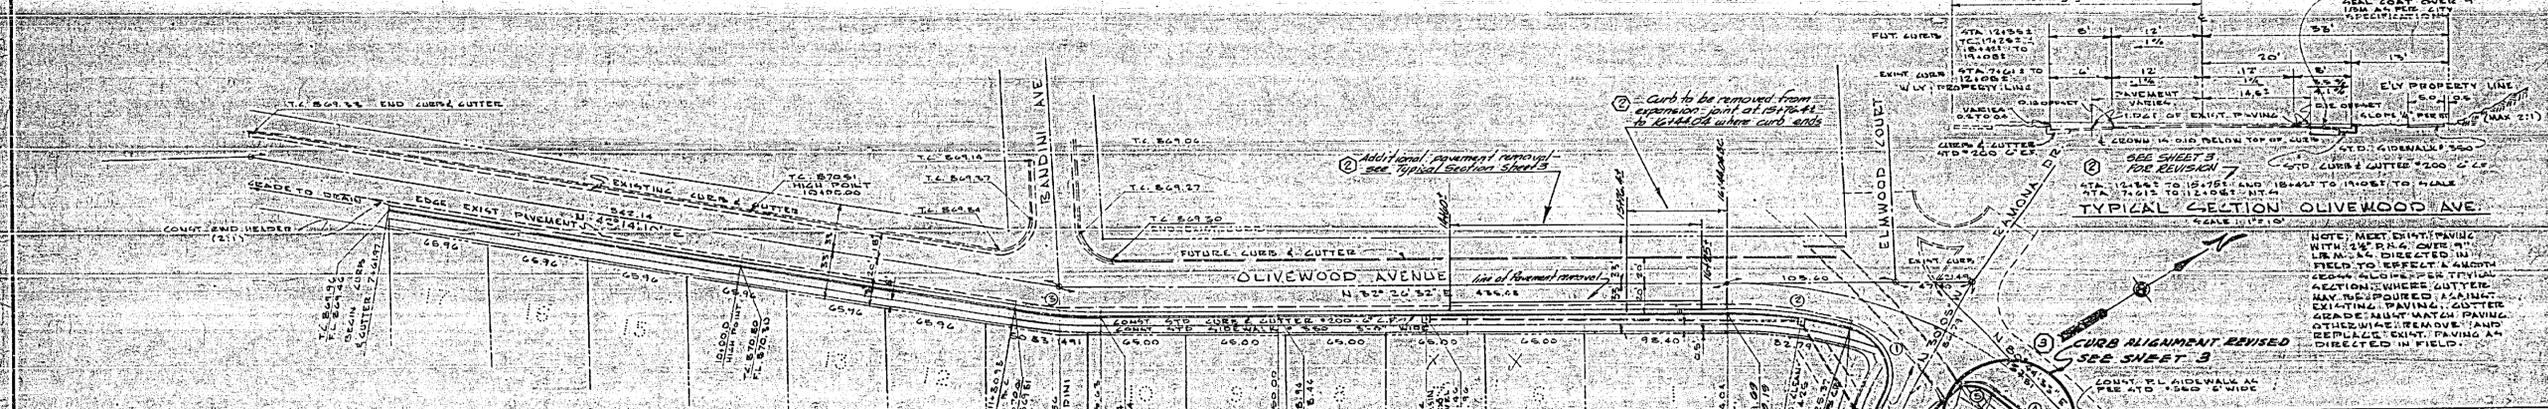

**CURVE CURVE DATA**




**REVISIONS**

NO.	DATE	DESCRIPTION

**C.V. BROWN JR. CIVIL ENGR.**  
 R.C. 7702  
 RIVERSIDE, CALIFORNIA  
 APPROVED: [Signature] DATE: 11-22-50

**CITY OF RIVERSIDE, CALIFORNIA**  
 DEPARTMENT OF PUBLIC WORKS  
 STREET PLANS & PROFILES  
 CHRISTENSEN SUBDIVISION  
**OLIVEWOOD AVE**

HORIZONTAL SCALE: 1" = 30' VERTICAL SCALE: 1" = 5'  
 APPROVED: [Signature]  
 DIRECTOR OF PUBLIC WORKS  
 5-24-50

