

**CURB CURVE DATA**

NO.	R	Δ	L	T
1	27	90°-00'-18"	42.41	27
2	27	55°-03'-42"	44.80	29.50
3	27	84°-56'-18"	40.08	24.71
6	27	90°-55'-00"	42.04	27.44
7	27	50°-00'-00"	42.41	27

**STREET NAME SIGN SCHEDULE**

Ⓐ	DIANA AVE.	2600
Ⓑ	WILMA CT.	2400
Ⓒ	EMILY CT.	2400

- NOTES:**
- If the subdivider desires to reduce requirements on imports, use material additional soil tests may be taken at the Subdividers expense after streets are prepared to rough grade. Subdivider will contact inspection division, City of Riverside, before making tests.
  - The City of Riverside will make a test of base material in place before paving can be installed. Results of this test must indicate that the base material is satisfactory to the inspection department.
  - Construction to be in accordance with standards and specifications of the City of Riverside, Department of Public Works.
  - Street name signs and posts to be furnished and installed by the Subdivider as per City Standard H-62.

**NOTE:** It shall be the responsibility of the Contractor to clear the right of way in accordance with the provisions of the law as it affects each utility including irrigation lines and appurtenances and of no cost to the City.

**BRUSH MARK**  
 2" DIA. PINE, BARK, SW. CORNER  
 WILMA & EMILY, N.E. CORNER  

**QUANTITY ESTIMATE**

Remove EXIST. C&G	202 LF
5" CONC. SIDEWALK STD#350	6000 SF
C&G AND GUTTER STD#100	1007 LF
REMOVE ASPHALT BERM	228 LF
ASPHALT BERM	10 LF
2 1/2" P.M.S	12186 SF
1.0 M.	115 CY
EXCAVATION	1200 CY

**REVISION**

MARK	DATE	DESCRIPTION

**ALBERT A. WEBB ASSOCIATES**  
 CIVIL ENGINEERS - RIVERSIDE, CALIFORNIA  
 APPROVED: *[Signature]* DATE 2/15/60  
 C.E. 5876

**CITY OF RIVERSIDE, CALIFORNIA**  
 DEPARTMENT OF PUBLIC WORKS

**STREET PLAN & PROFILE**  
 MONROE ST  
 DIANA AVE  
 DIANA PARK

APPROVED BY: *[Signature]*  
 DIRECTOR OF PUBLIC WORKS  
 NO. R-376  
 DATE 4-1-60  
 SHEET 1 OF 2







PLATE 1 - PLAN - PROFILE  
 REVISIONS & NOTES  
 DATE 4-1-60

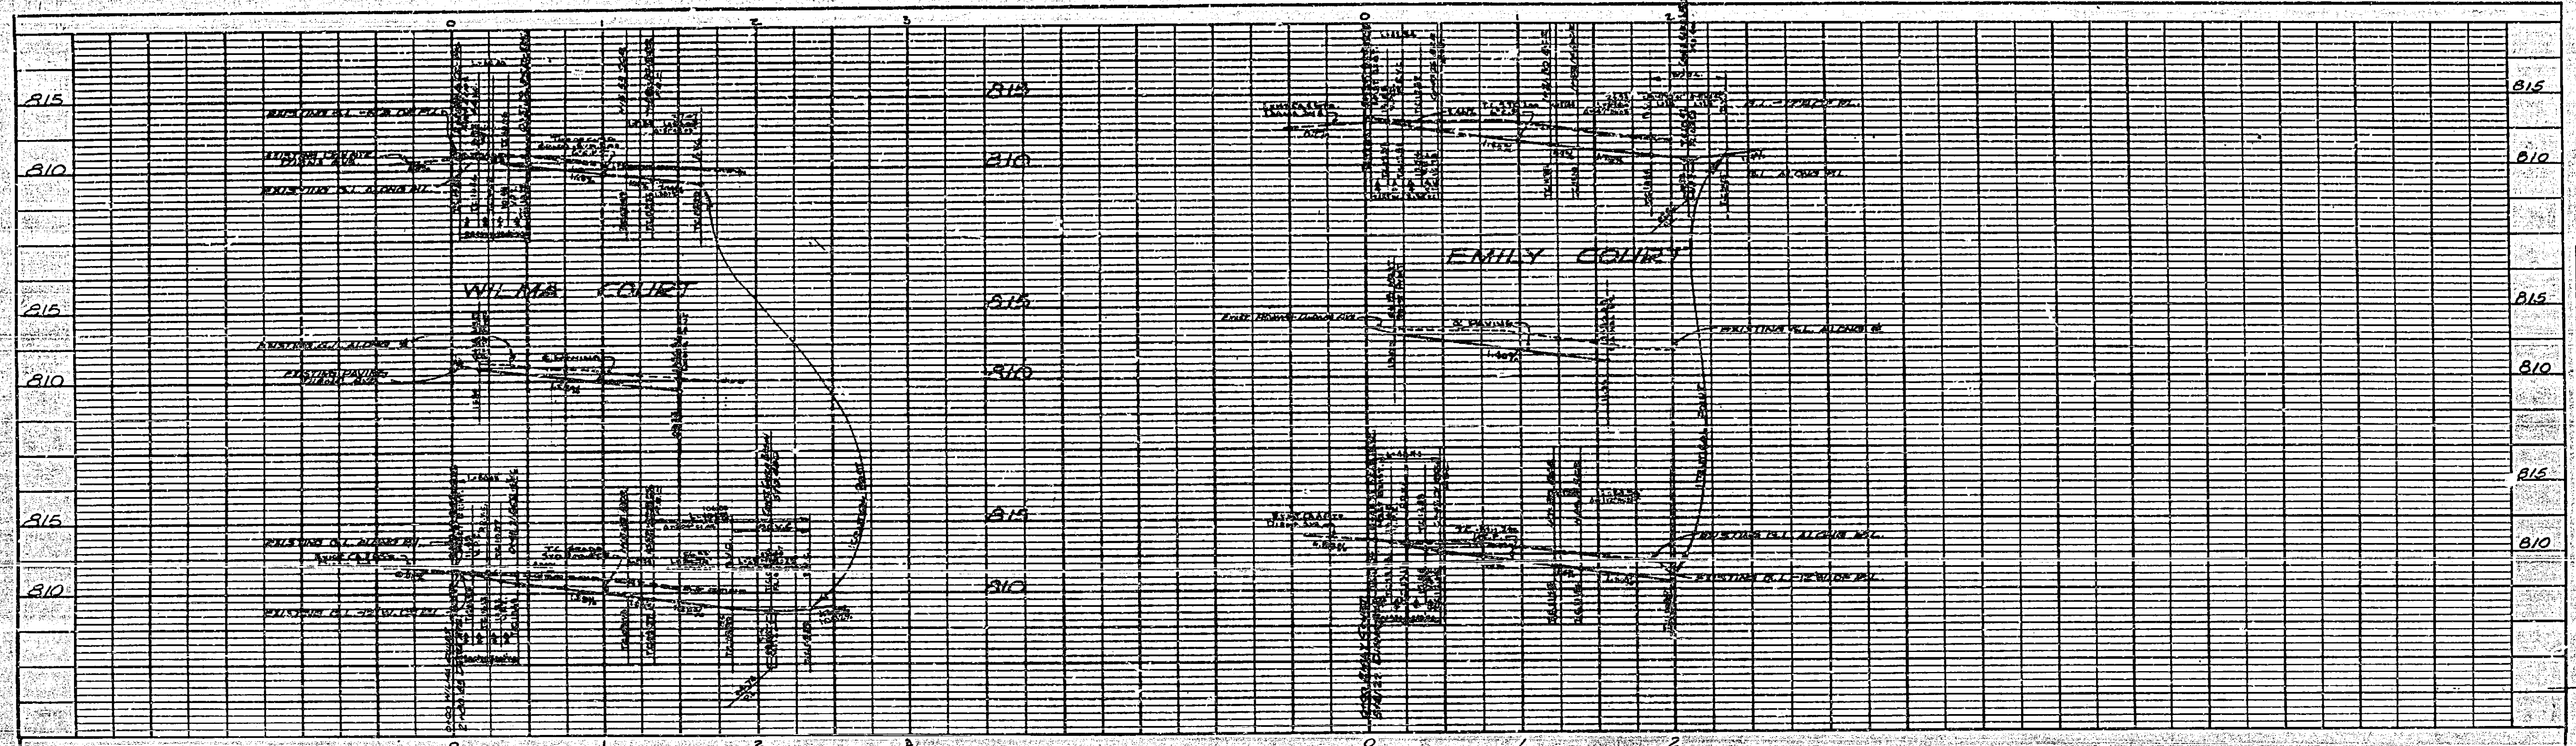


NO.	DATE	DESCRIPTION
1		AS SHOWN

BENCH MARK  
 'X' ON F.H. POST S.W. CORNER  
 MAGNOLIA & MONTELEONE - ELEV. 701.75

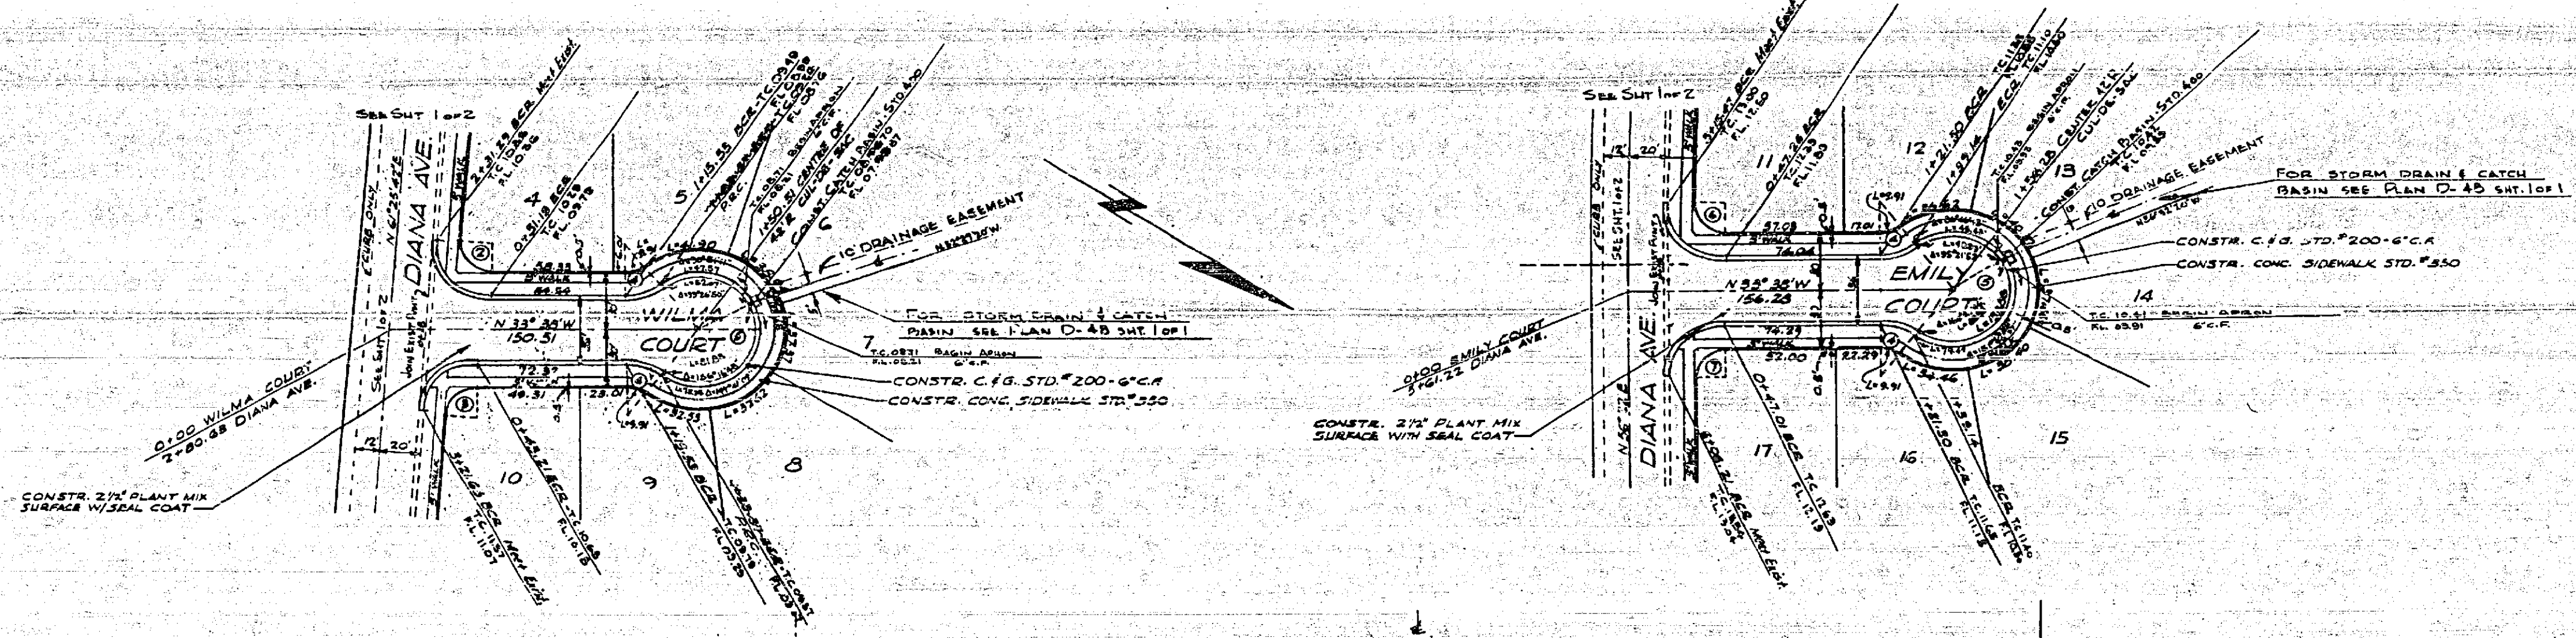

NO.	IR	Δ	L	T
2	27	25°-02'-12"	11.20	29.50
3	27	84°-56'-18"	70.03	24.71
6	27	90°-55'-08"	42.84	27.44
7	27	90°-00'-00"	42.41	27
4	27	37°-51'-49"	17.04	9.26
5	30	255°-23'-30"	73.55	-

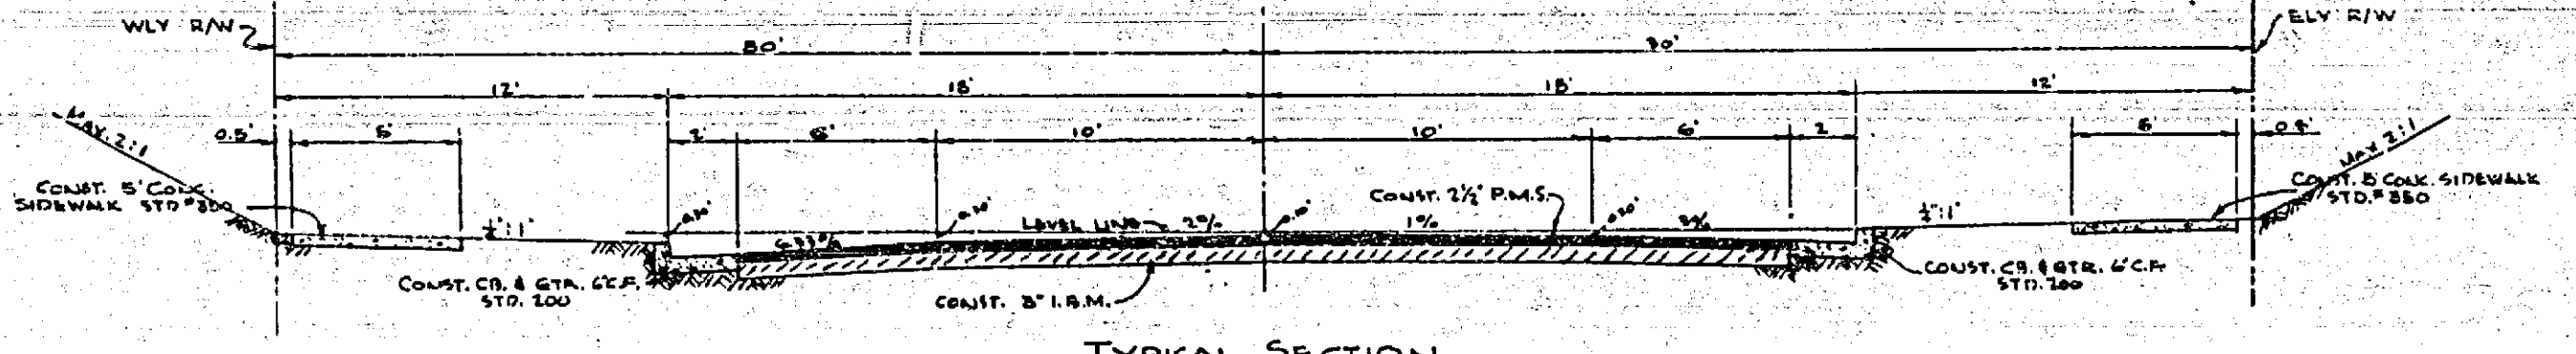

TYPICAL SECTION  
 WILMA CT. & EMILY CT.  
 SCALE 1" = 1'-0"

ALBERT A. WEBB ASSOCIATES  
 CIVIL ENGINEERS - RIVERSIDE, CALIFORNIA  
 APPROVED: *[Signature]* DATE 2/15/60

CITY OF RIVERSIDE, CALIFORNIA  
 DEPARTMENT OF PUBLIC WORKS

STREET PLAN & PROFILE  
 WILMA COURT  
 EMILY COURT  
 DIANA PARK

MARK	DATE	DESCRIPTION
	8-6-60	Revised CURB DATA (PLAN, PROFILE) SHOWING CURB DATA (PLAN, PROFILE) DATED 8/18/60 (SHEET 2 OF 2)

DATE DEC 1959  
 DRAWN AB1  
 CHECKED E.J.L.

APPROVED BY: *[Signature]*  
 ENGINEER TO PUBLIC WORKS  
 DATE 4-1-60  
 NO. R-376  
 SHEET 2 OF 2

NO.	DATE	DESCRIPTION
1		AS SHOWN