



STATION	ELEVATION
315	855.00
316	855.00
HESS ARLINGTON HEIGHTS

B.M. ELEV 859.67 TOP F.H.N.W. COR. VICTORIA & HARRISON.  
 F.B. 683/5-10, 15-16  
 SCALE: HOR. 1"=50'  
 VERT. 1"=5'

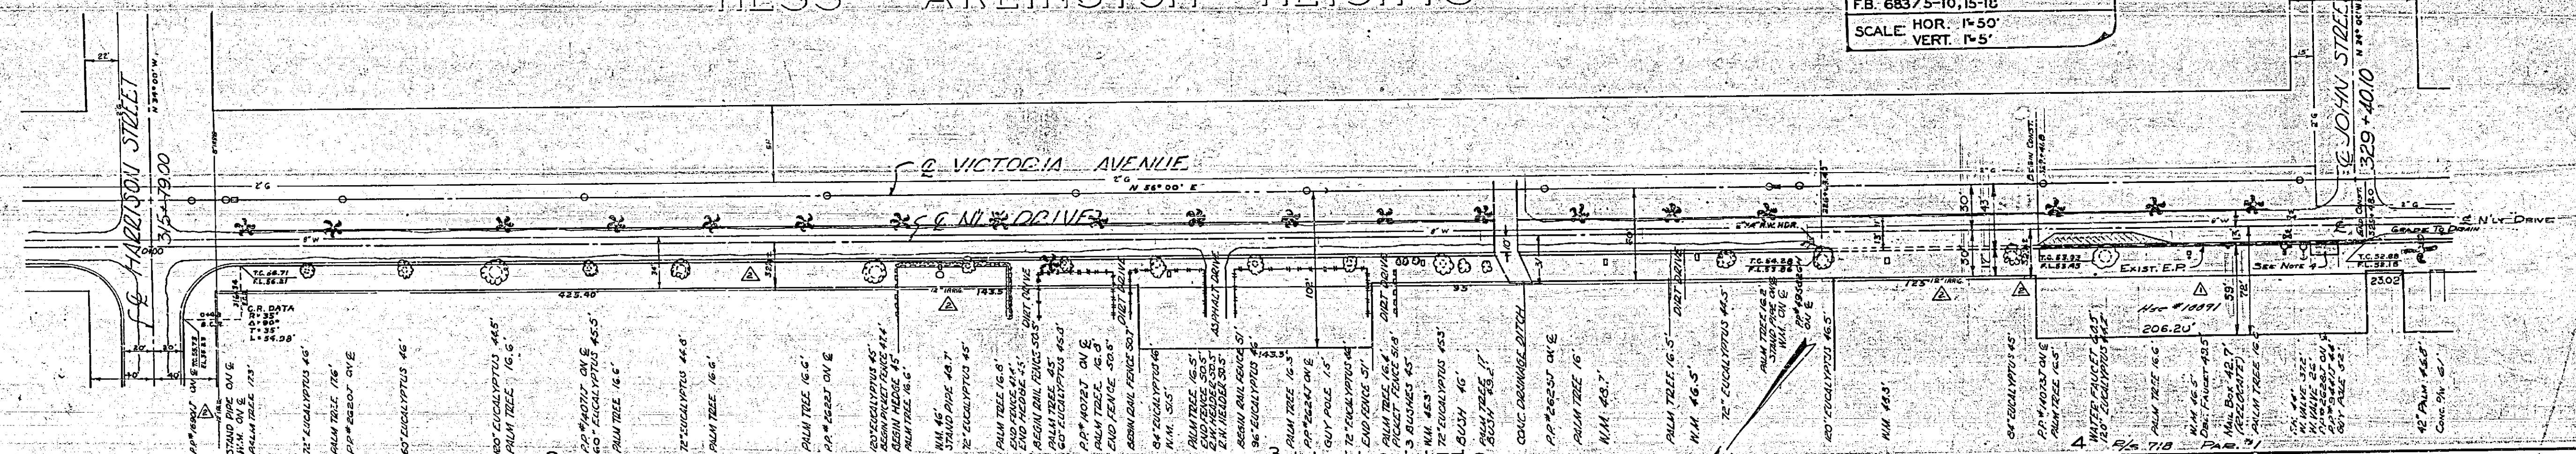

- Notes**
- All construction shall be in accordance with standards and specifications No. 441 of the City of Riverside, Dept. of Public Works.
  - Prime coat, sand binder, and seal coat will be required.
  - Remove concrete curb and pavement to 10' from center of NLY Drive and construct 5' of A.C. Match-up Pavement, Or 2 1/2" A.C. Over 6" A.B.

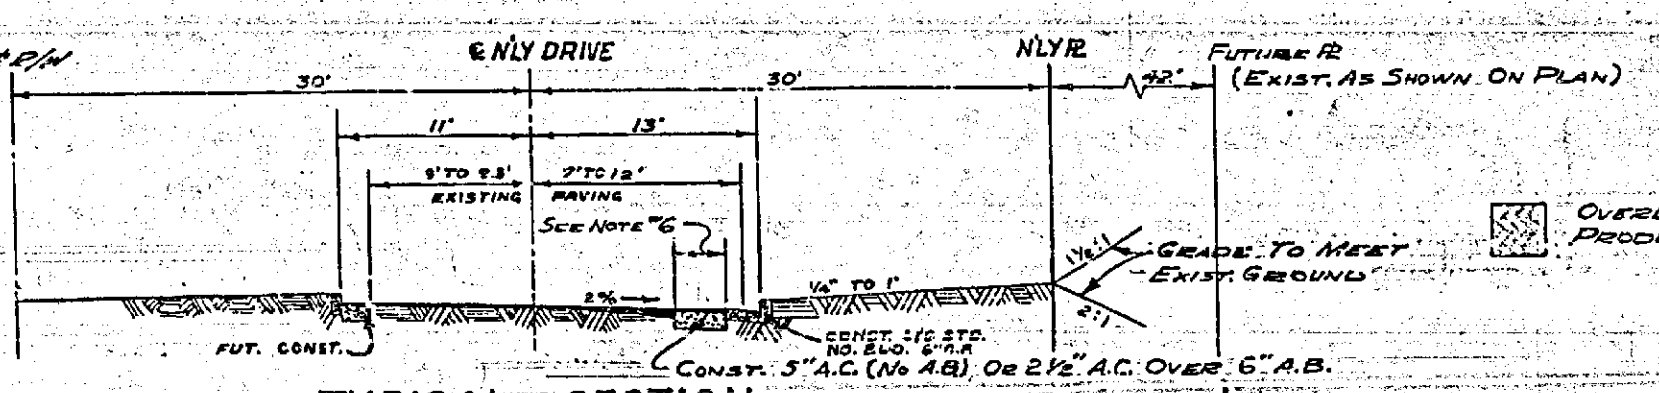

REVISIONS			CITY OF RIVERSIDE, CALIFORNIA DEPARTMENT OF PUBLIC WORKS
MARK	DATE	DESCRIPTION	
1	4-1-63	REVISED LIMITS OF CONSTRUCTION STA. 325+48.25 TO 325+48.00	VICTORIA AVENUE CURB & GUTTER HARRISON STREET TO JOHN STREET
2	5-11-68	CHANGED 5' SIDE TO 12' SIDE FROM THE LOCATION SHOWN ON PLAN	

DESIGNED BY: [Signature]    CHECKED BY: [Signature]    APPROVED BY: [Signature]    PROJ. NO. R-378

DRAWN BY: [Signature]    PARK DEPT. TRAFFIC DIV.    DATE: May 22 1968    SHEET 1 OF 1

