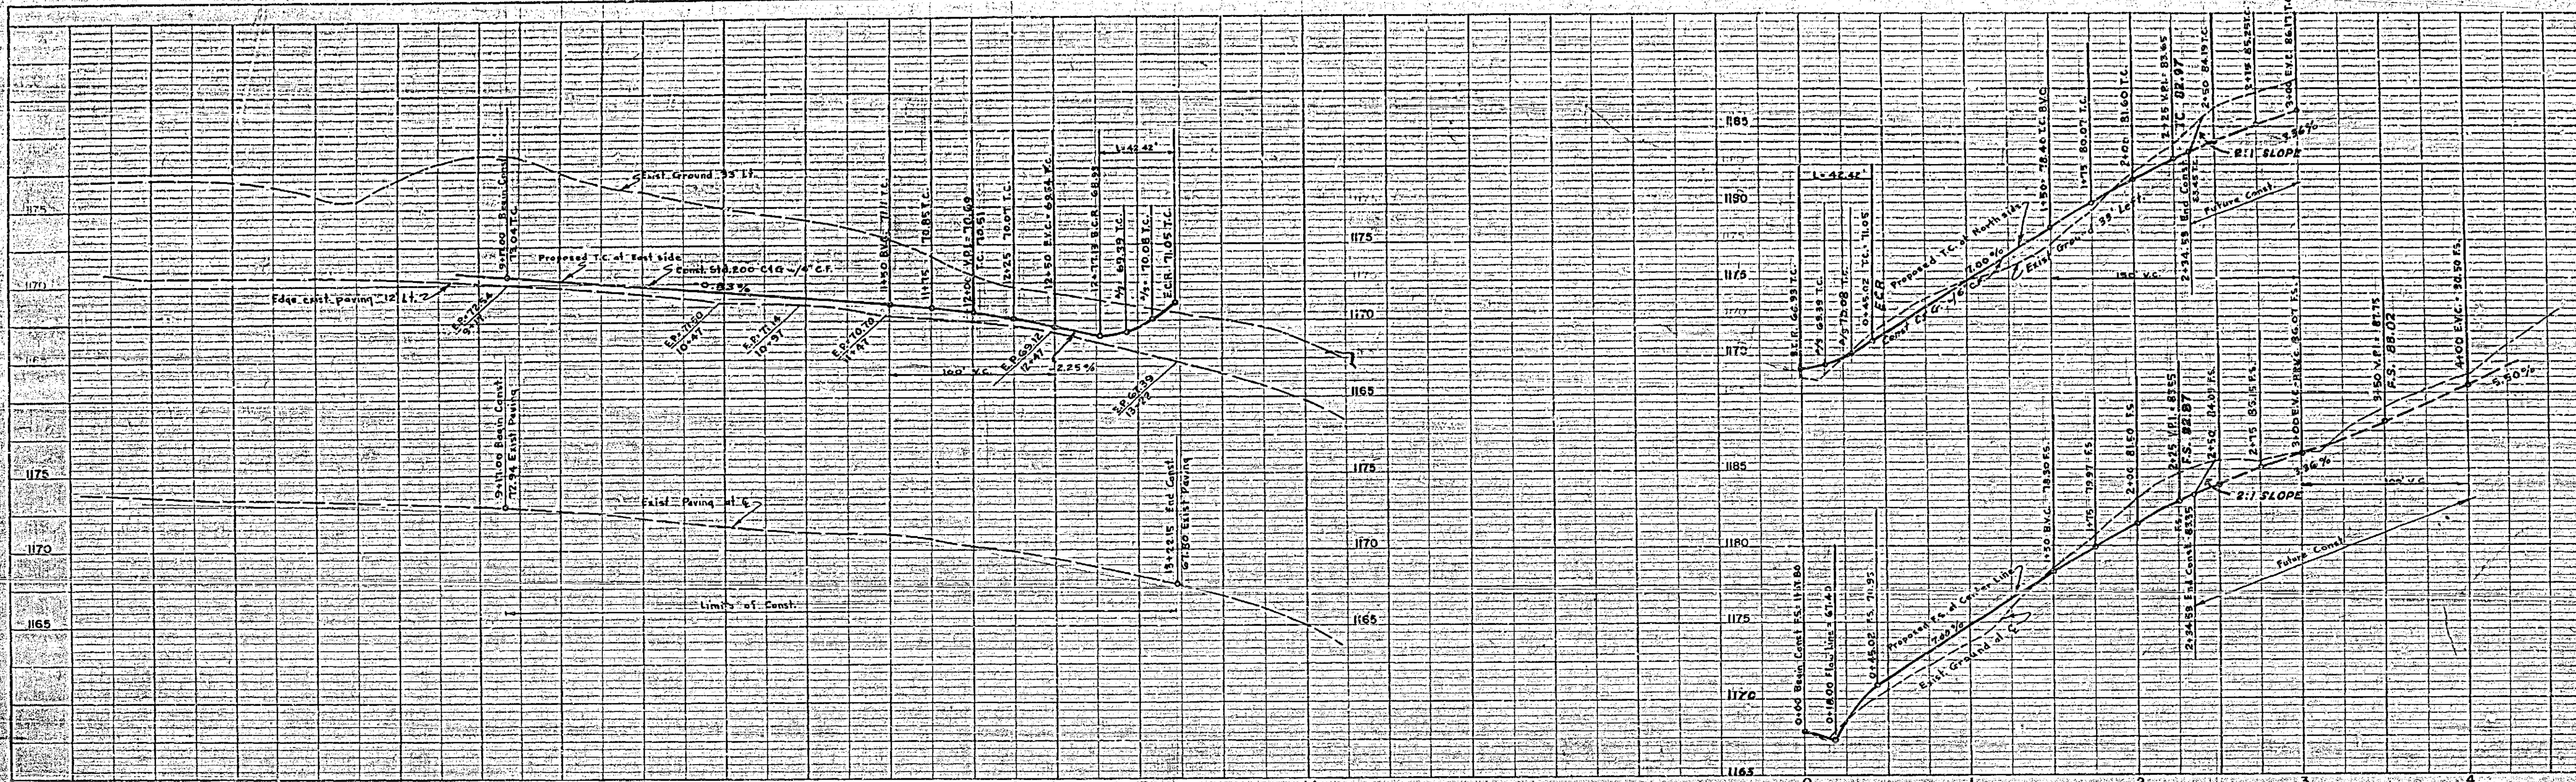

BM= TOP OF 1 1/2" CAPPED I.P. CORNER OF BRADLEY & GOLDEN STAR. ELEV. = 1170.50

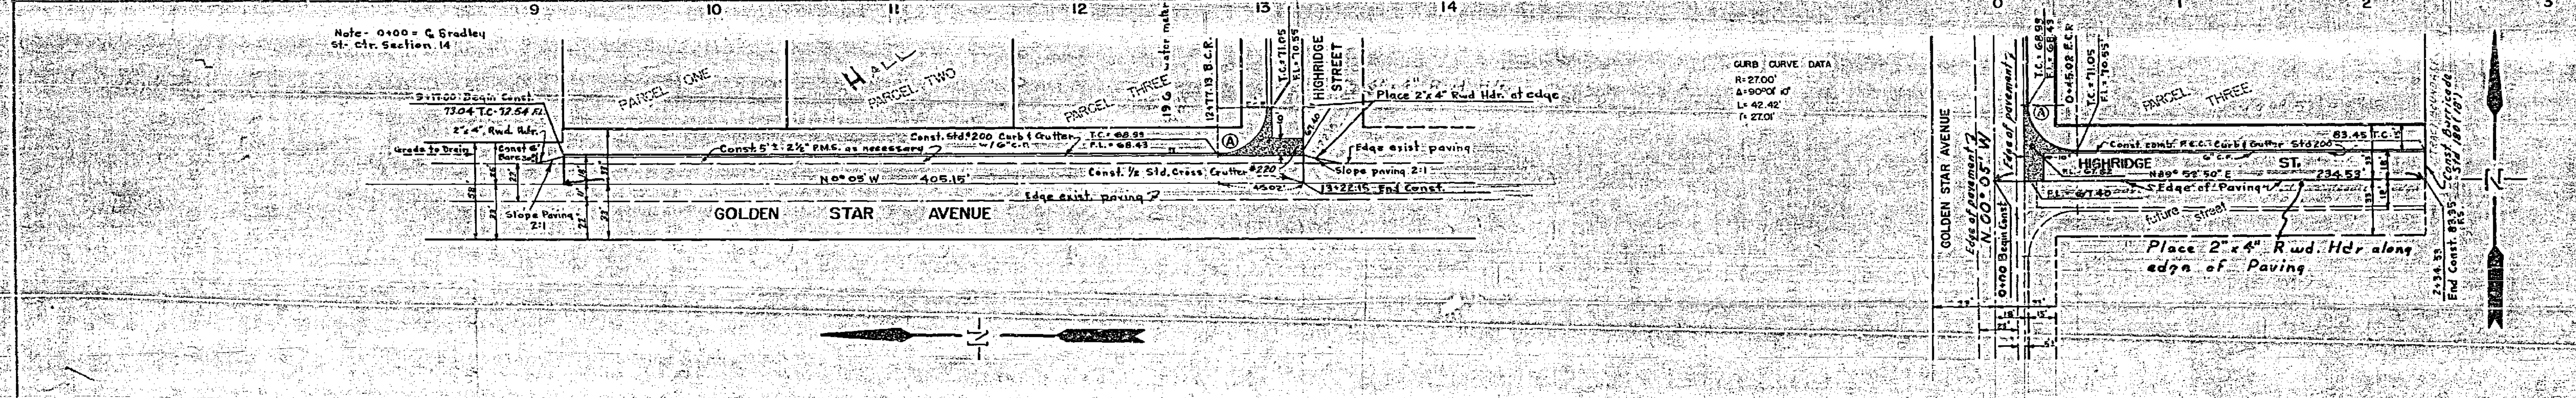

NOTE: If subdivider desires to reduce requirements on imported base material additional soil tests may be taken at subdividers expense after streets are prepared to rough grade. Subdivider will contact inspection division, City of Riverside, before taking tests. The City of Riverside will make a test of base material in place before paving can be installed. Results of this test must indicate that the base material is satisfactory to the inspection division.

Street Sign Sched.

Ⓐ	GOLDEN STAR AVE.	7900
	HIGHRIDGE STREET	1200

Note: Street Name signs and posts to be furnished and erected by the subdivider in accordance with City Specifications & Standard Dwg. Nº 662.

All construction shall be in accordance with City Standard Specifications Nº 460.

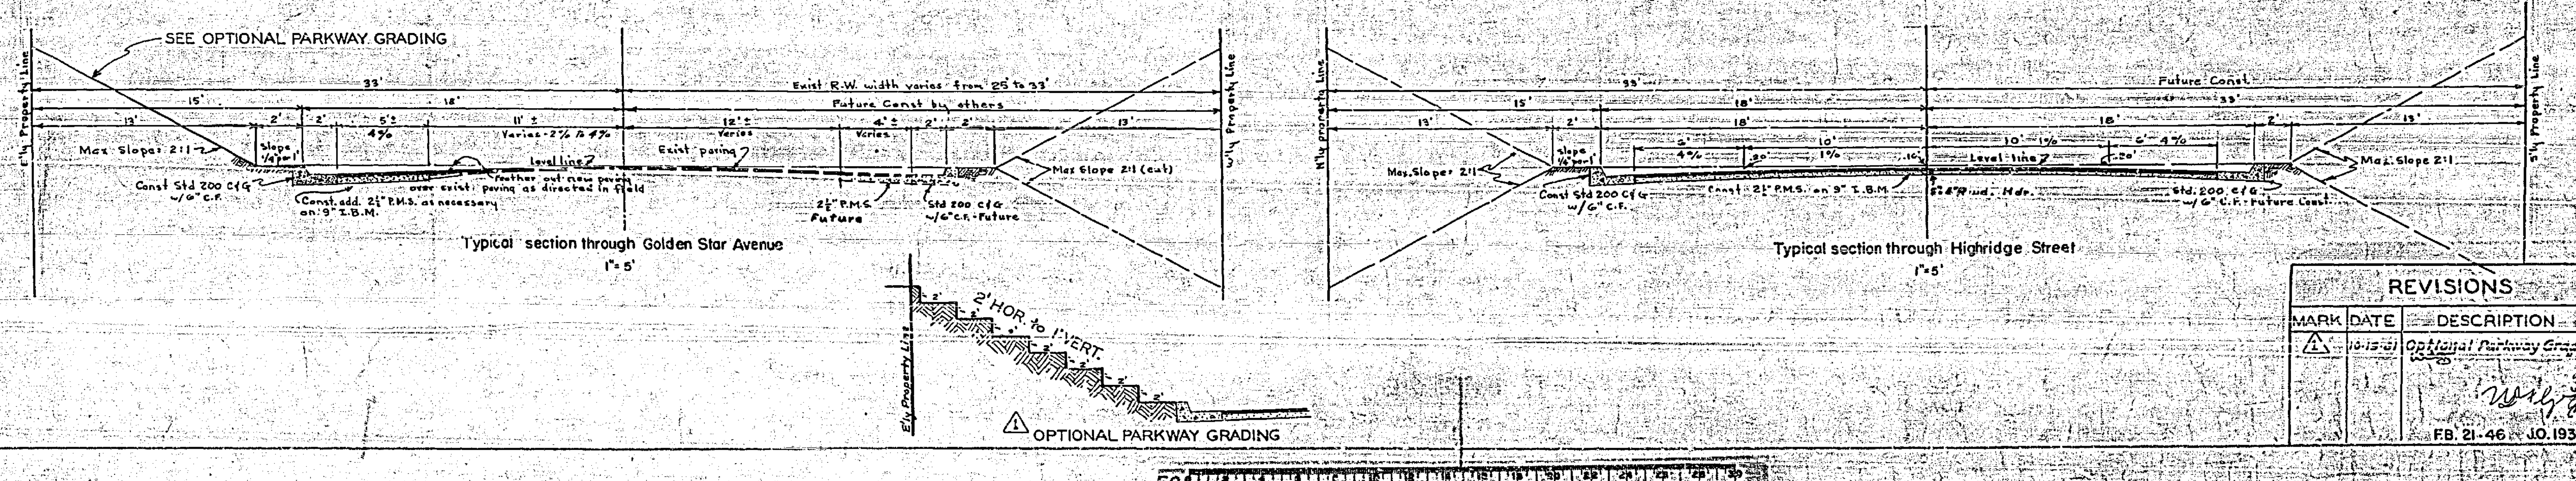

PROFILE		
NOTE BOOK	SURVEYED	
	PLOTTED	
	GRADES CHECKED	
	B. M.S NOTED	
NO.	STRUCTURE NOTAT'NS CHKD.	

PLAN		
NOTE BOOK	SURVEYED	
	PLOTTED	
	ALIGNMENT CHECKED	
NO.	PT. OF WAY CHECKED	

RIVERSIDE ENGINEERING CO. INC.
RIVERSIDE, CALIFORNIA
APPROVED [signature] DATE 3/4/60

CITY OF RIVERSIDE, CALIFORNIA
DEPARTMENT OF PUBLIC WORKS

STREET PLAN & PROFILE
GOLDEN STAR AVENUE
HIGHRIDGE STREET
RECORD OF SURVEY FOR JOHN J. KUNNY

HORZ. 1"=50' VERT. 1"=5'

APPROVED [signature]
DIRECTOR OF PUBLIC WORKS
Date April 27, 1960

Nº R-386
Sheet 1 of 1

REVISIONS

MARK	DATE	DESCRIPTION
⚠1	10-13-61	Optional Parkway Grading

F.B. 21-46 J.O. 1939