

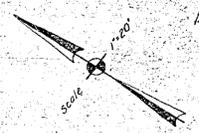


Note
 Shaded Area Indicates
 A.C. to be Placed.

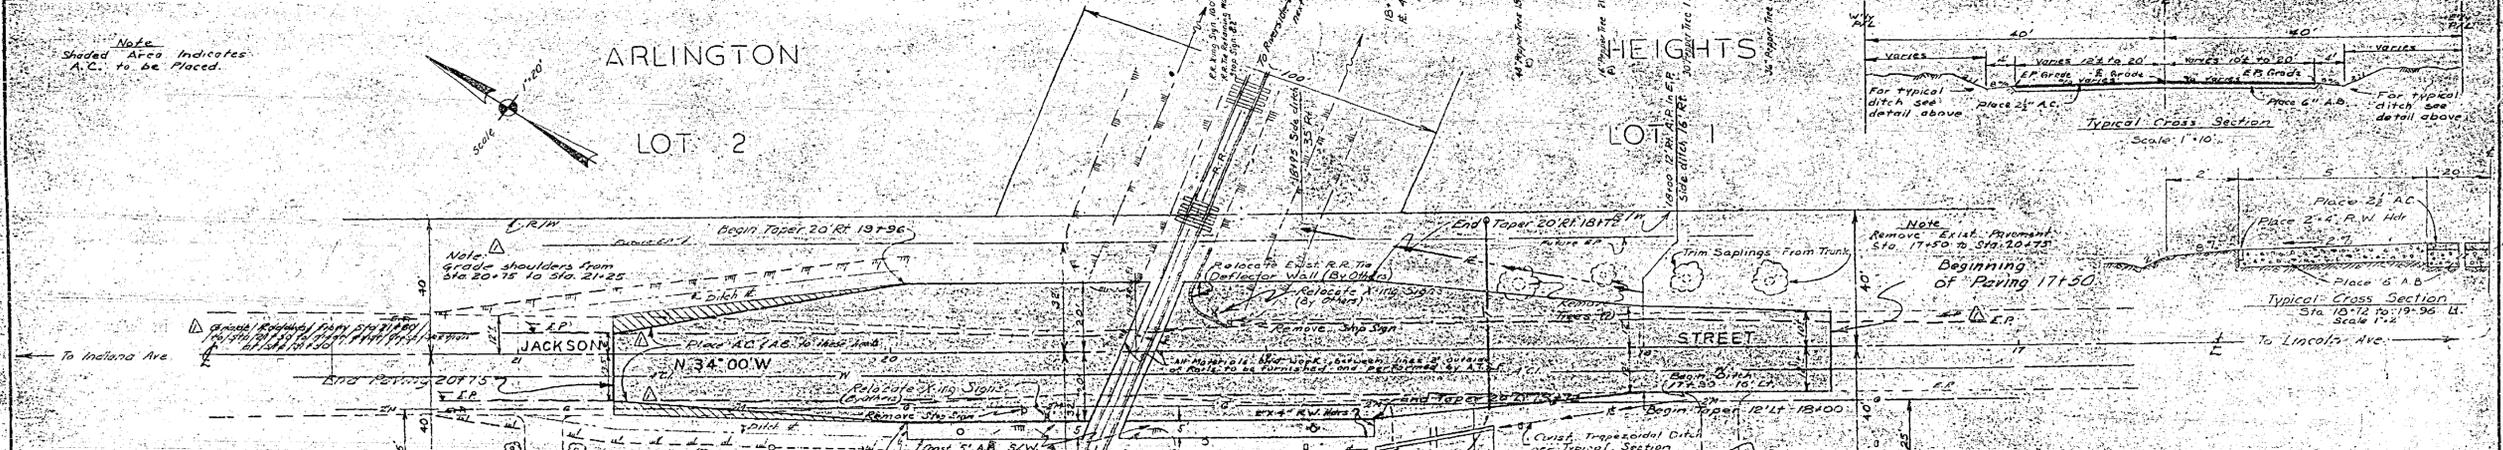

ARLINGTON
 LOT 2

HEIGHTS
 LOT 1

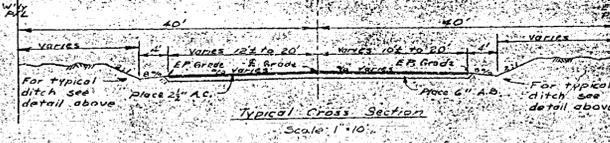

Estimated Pav Quantities

Earthwork	608.577 C.Y.
Remove Bituminous Pavement	701.823 S.Y.
Aggregate Base Material	210.247 C.Y.
Asphalt Concrete	162.1468 Tons
Redwood Headers	125 L.F.
15" C.M.P. (6 days)	32 L.F.
Remove Trees	1 Ea
(18)	1 Ea

COMPOSITE STREET WIDENING Account No. 01-3060-3016			CITY OF RIVERSIDE, CALIFORNIA DEPARTMENT OF PUBLIC WORKS	
REVISIONS			JACKSON STREET AT A.T. & S.F. CROSSING AT/SF CROSSING NO 2B158	
MARK	DATE	DESCRIPTION	DESIGNED BY	CHECKED BY
