
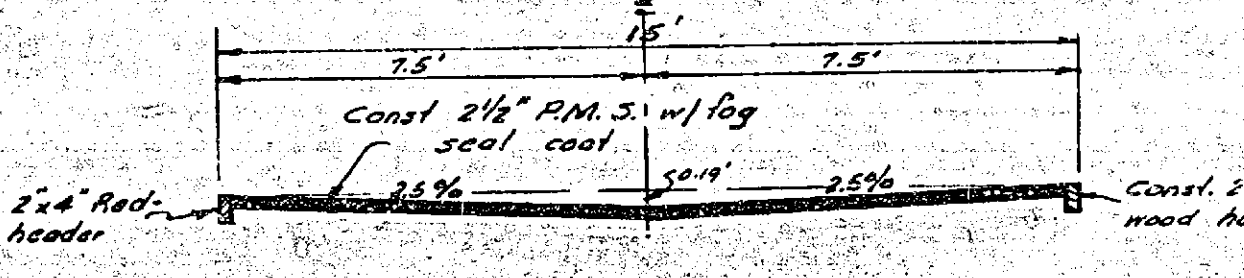
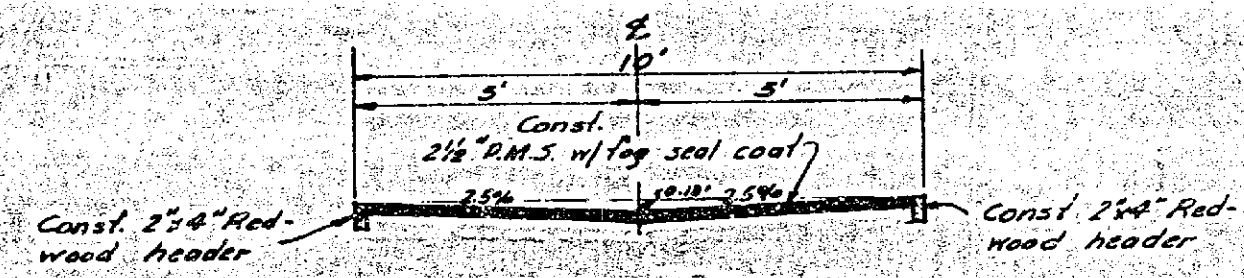


**PROFILE**

NOTE BOOK: PAINTS CHECKED  
 NO. 5, 11, 12, 13,100

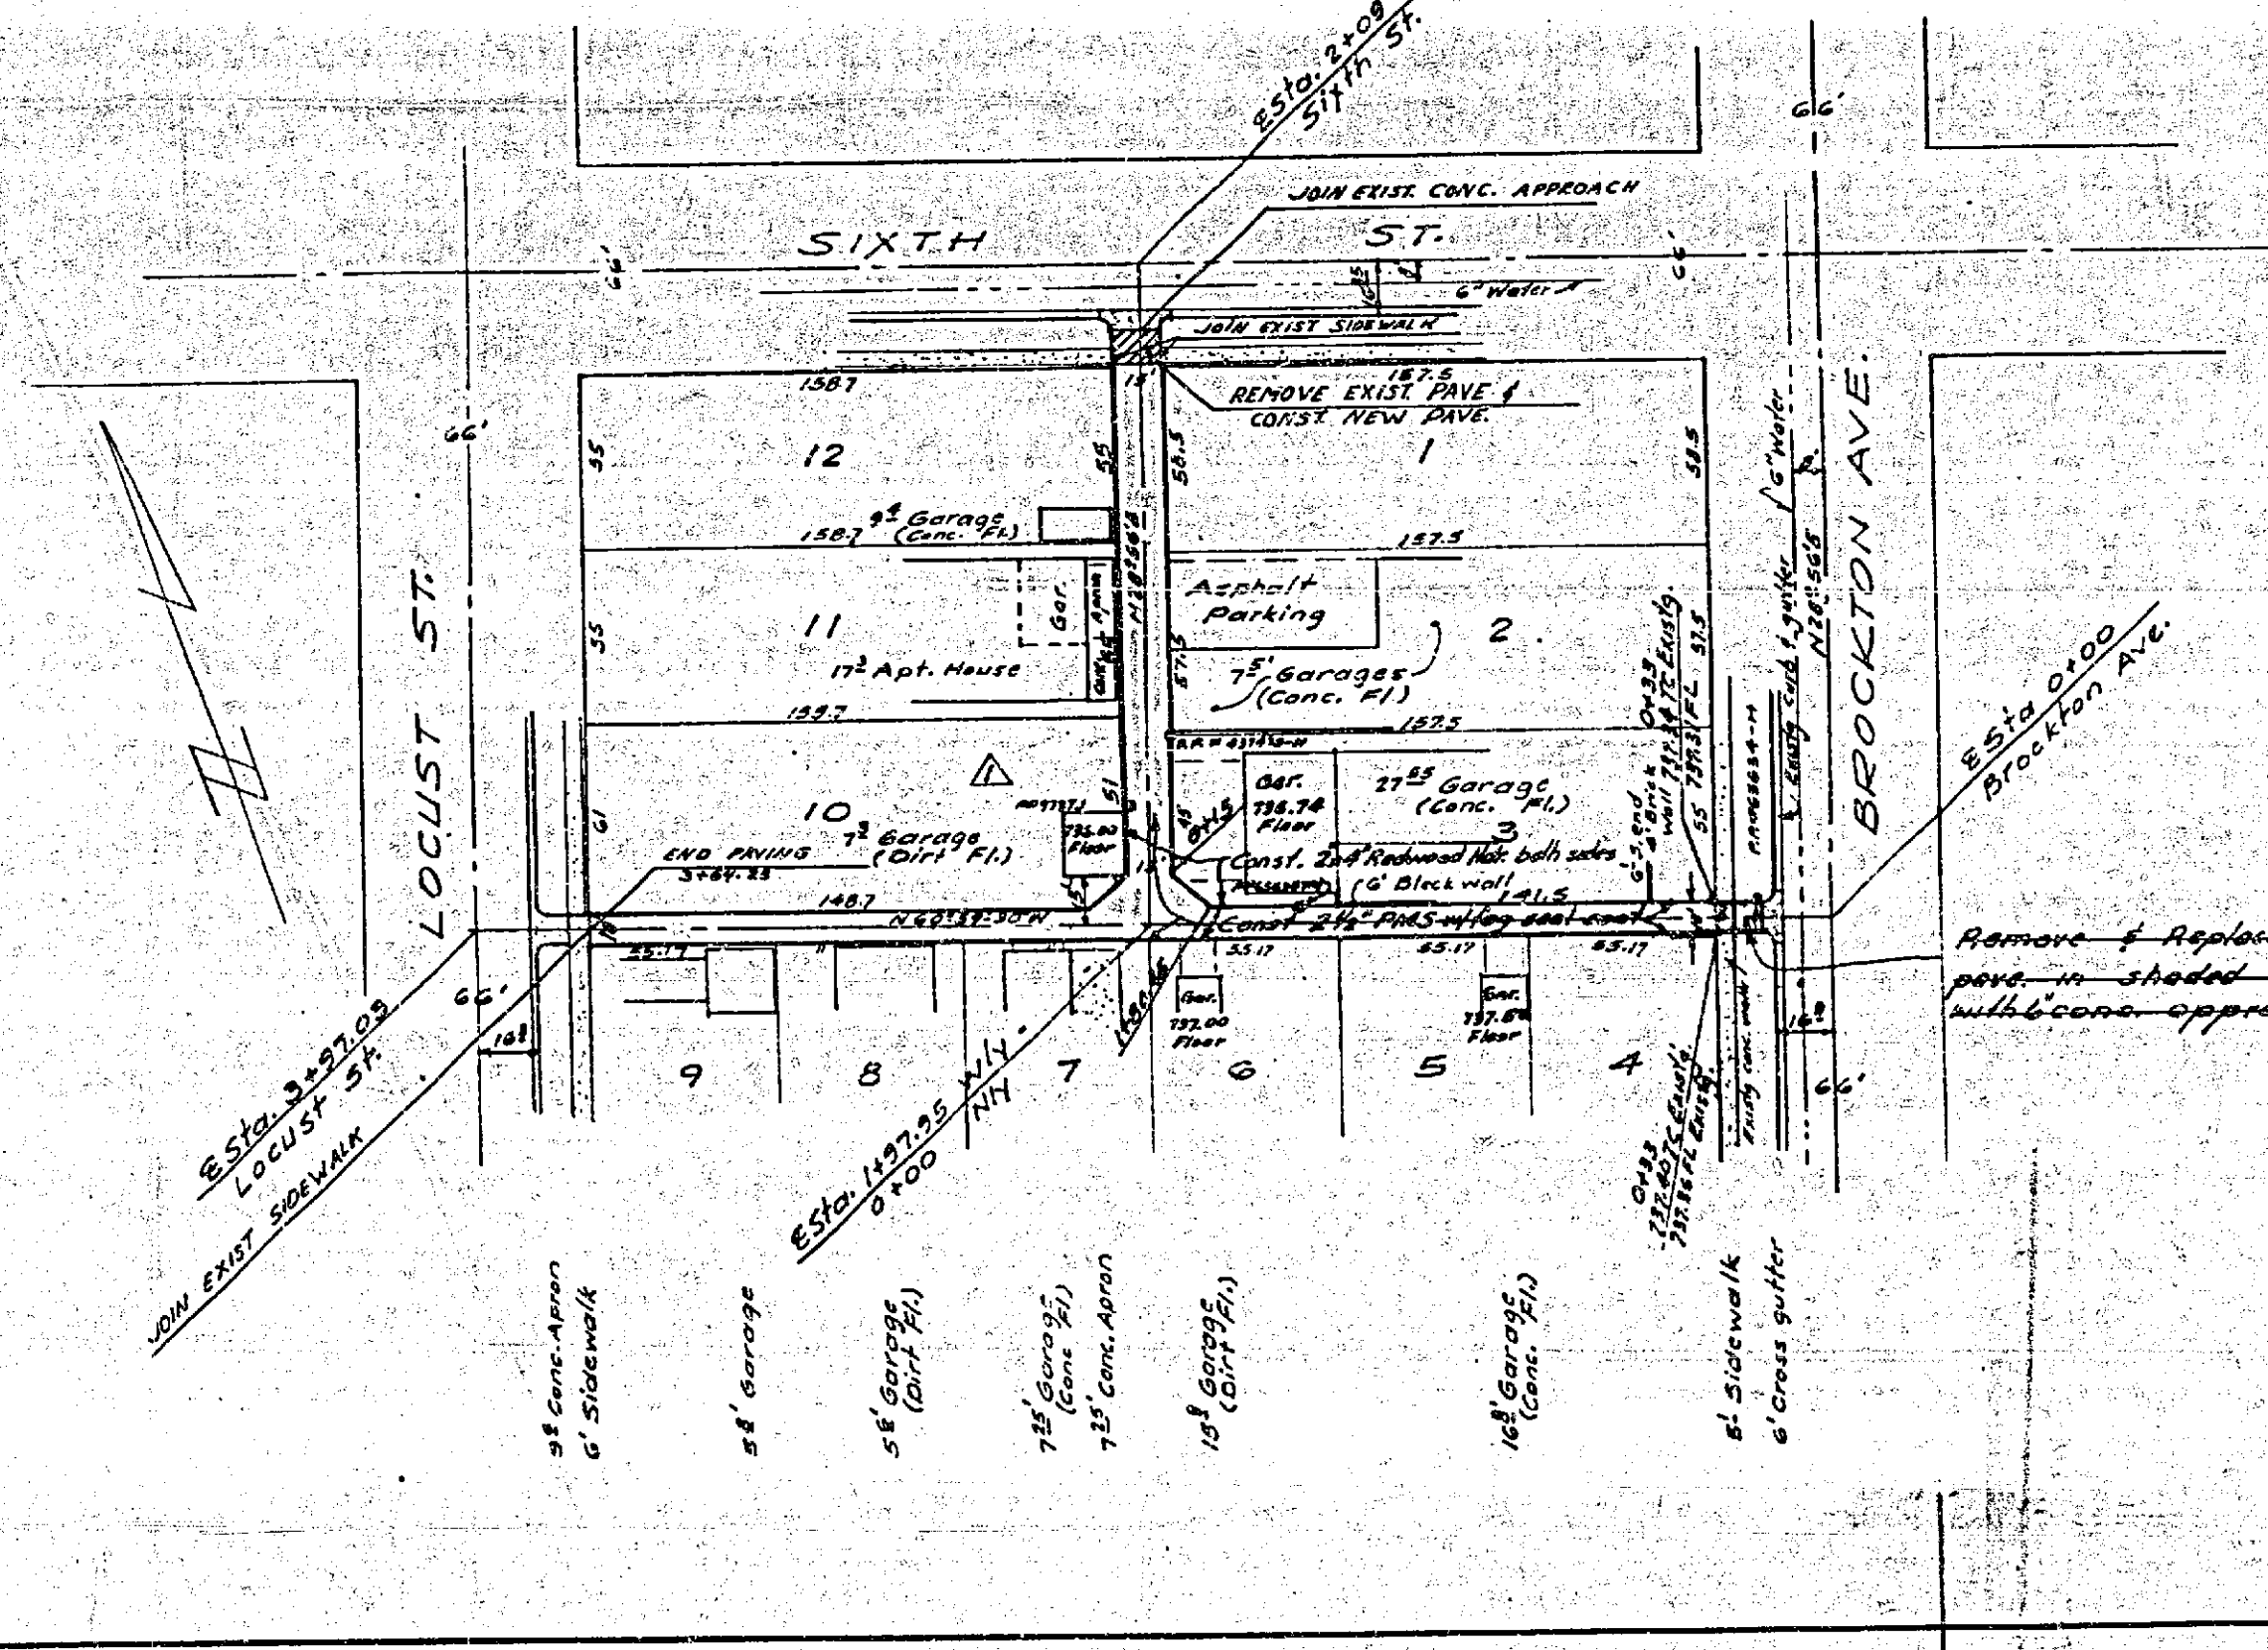

**QUANTITY ESTIMATE**  
 2 1/2" R.M.S. with log seal coat 2,335 sq. ft.  
 conc. approach 150 sq. ft.  
 2x4" Redwood Header 460 lin. ft.

- BENCH MARK**
- Spike & Lead - Curb E.O.S. NW-Curb Return 744.7 - Brockton Elev. 838.594
  - Spike & Lead in North curb 9' East of East Property Line of Brockton. Elev. 837.450

**GENERAL NOTES**

- Construction shall be in accordance with Standards & Specifications No. 461 of the City of Riverside, Department of Public Works.
- CITY OF RIVERSIDE F.B. 4776

**ALBERT A. WEBB ASSOCIATES**  
 CIVIL ENGINEERS - RIVERSIDE, CALIFORNIA  
 APPROVED: [Signature] DATE 10-21-60  
 BY 2876

| REVISION |         | DESCRIPTION                        | APPROVED BY                             |
|----------|---------|------------------------------------|---|
| MARK     | DATE    |                                    |   |
| A        | 2-15-61 | Imparled Base Metered Offset, REC. | [Signature]<br>DIRECTOR OF PUBLIC WORKS |
| A        | 12-8-61 | Raise Limits of Const. on Wing     |   |

**CITY OF RIVERSIDE, CALIFORNIA**  
 DEPARTMENT OF PUBLIC WORKS  
**ALLEY PLAN & PROFILE**  
 FOR LOT 3 OF ROSEDALE  
 TRACT - MB 4/86

DATE 10-21-60  
 DRAWN NLM REC  
 CHECKED [Signature]  
 SCALE Horiz. 1"=50'  
 Vert. 1"=5'  
 NO. 60-218  
 DATE 11-1-60  
 SHEET 1 OF 1

**PLAN**

NOTE BOOK: PAINTS CHECKED  
 NO. 1, 2, 100