

- NOTES**
- Adopted from Plan R-422 prepared by J.F. Davidson-Civil Engineer, Riverside, California.
 - This Contract includes I.B.M., P.M.S., Seal Coat, Redwood Headers and Raising manholes to grade.
 - Shaded area indicates present construction.

APPROVED *[Signature]* 1-10-61
 PLANK SUPERINTENDENT

REVISIONS		
MARK	DATE	DESCRIPTION
①	5-22-61	Change grade on Braemar Avenue at Pine St.
②	May 21	Place width changed from 28' to 40' and Change Grade M.H. and Change Grade E.P. 10'11' added

DESIGNED BY *[Signature]* CHECKED BY *[Signature]*
 RECOMMENDED BY *[Signature]*

CITY OF RIVERSIDE, CALIFORNIA
 DEPARTMENT OF PUBLIC WORKS





**TEQUESQUITE AVENUE
 PAVING**

FROM PALM AVE TO BROCKTON AVENUE

HORIZ. SCALE 1"=40' VERT. SCALE 1"=4'

APPROVED BY *[Signature]*
 Director of Public Works

NO. R-478
 DATE 5-7-61 SHEET 1 OF 2

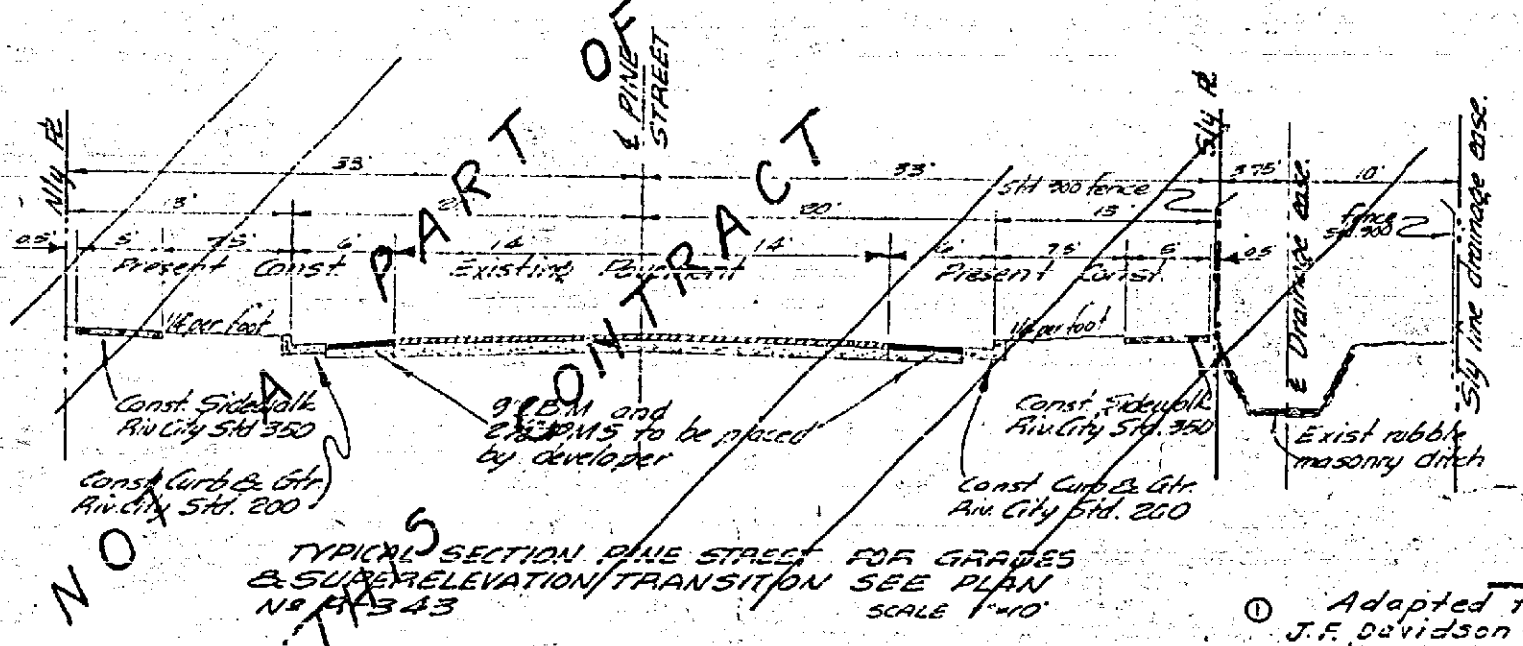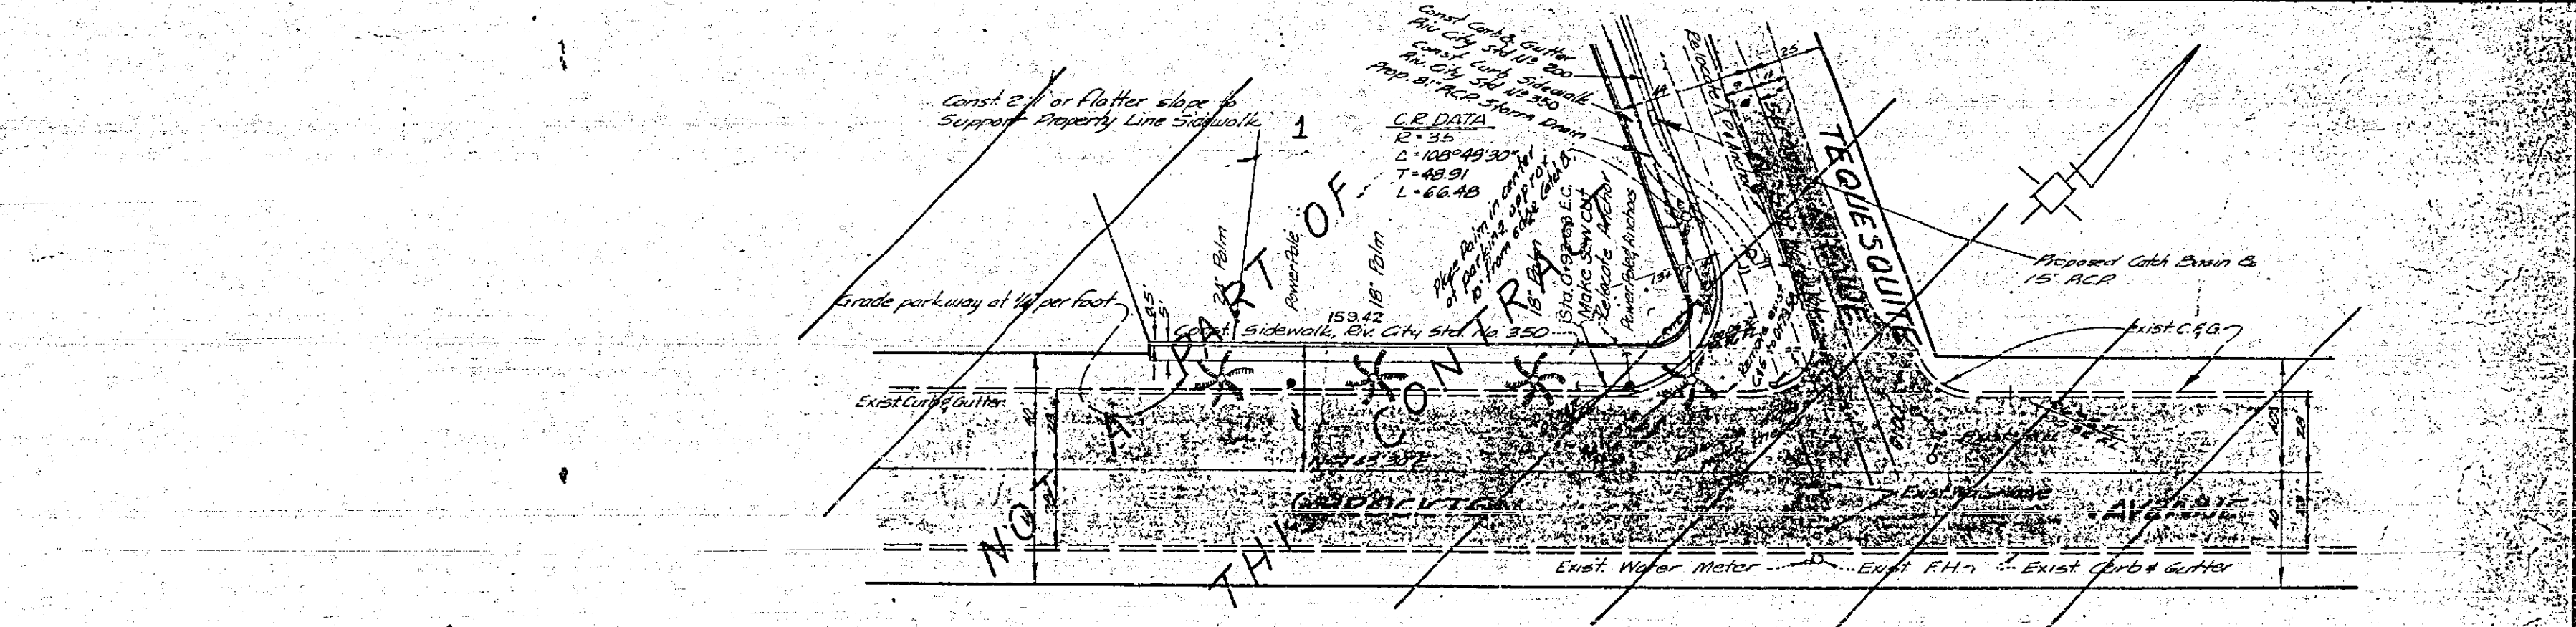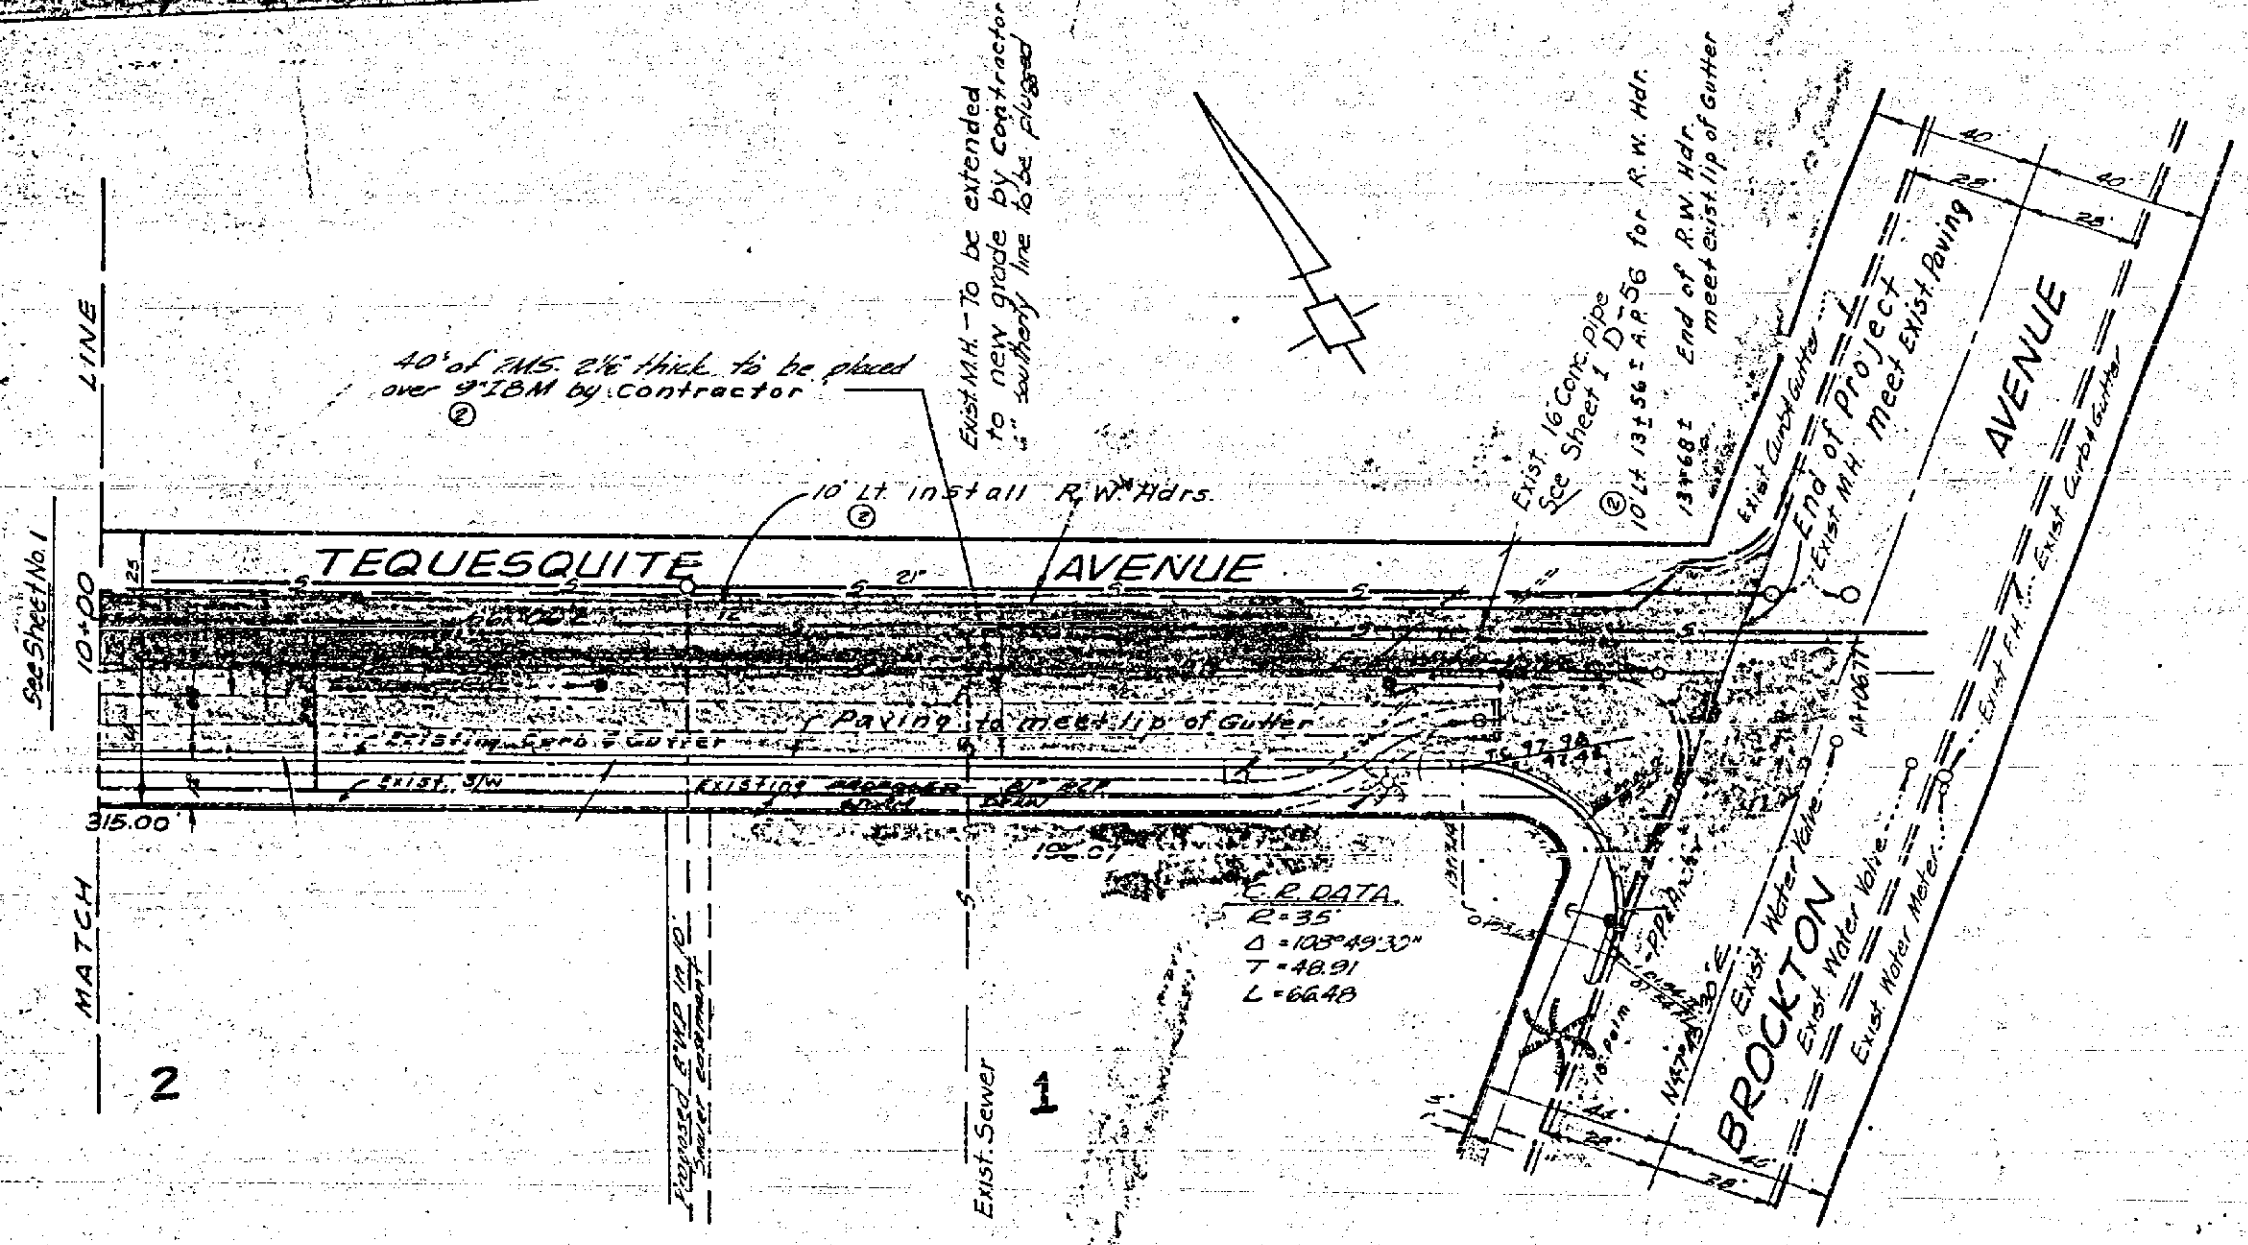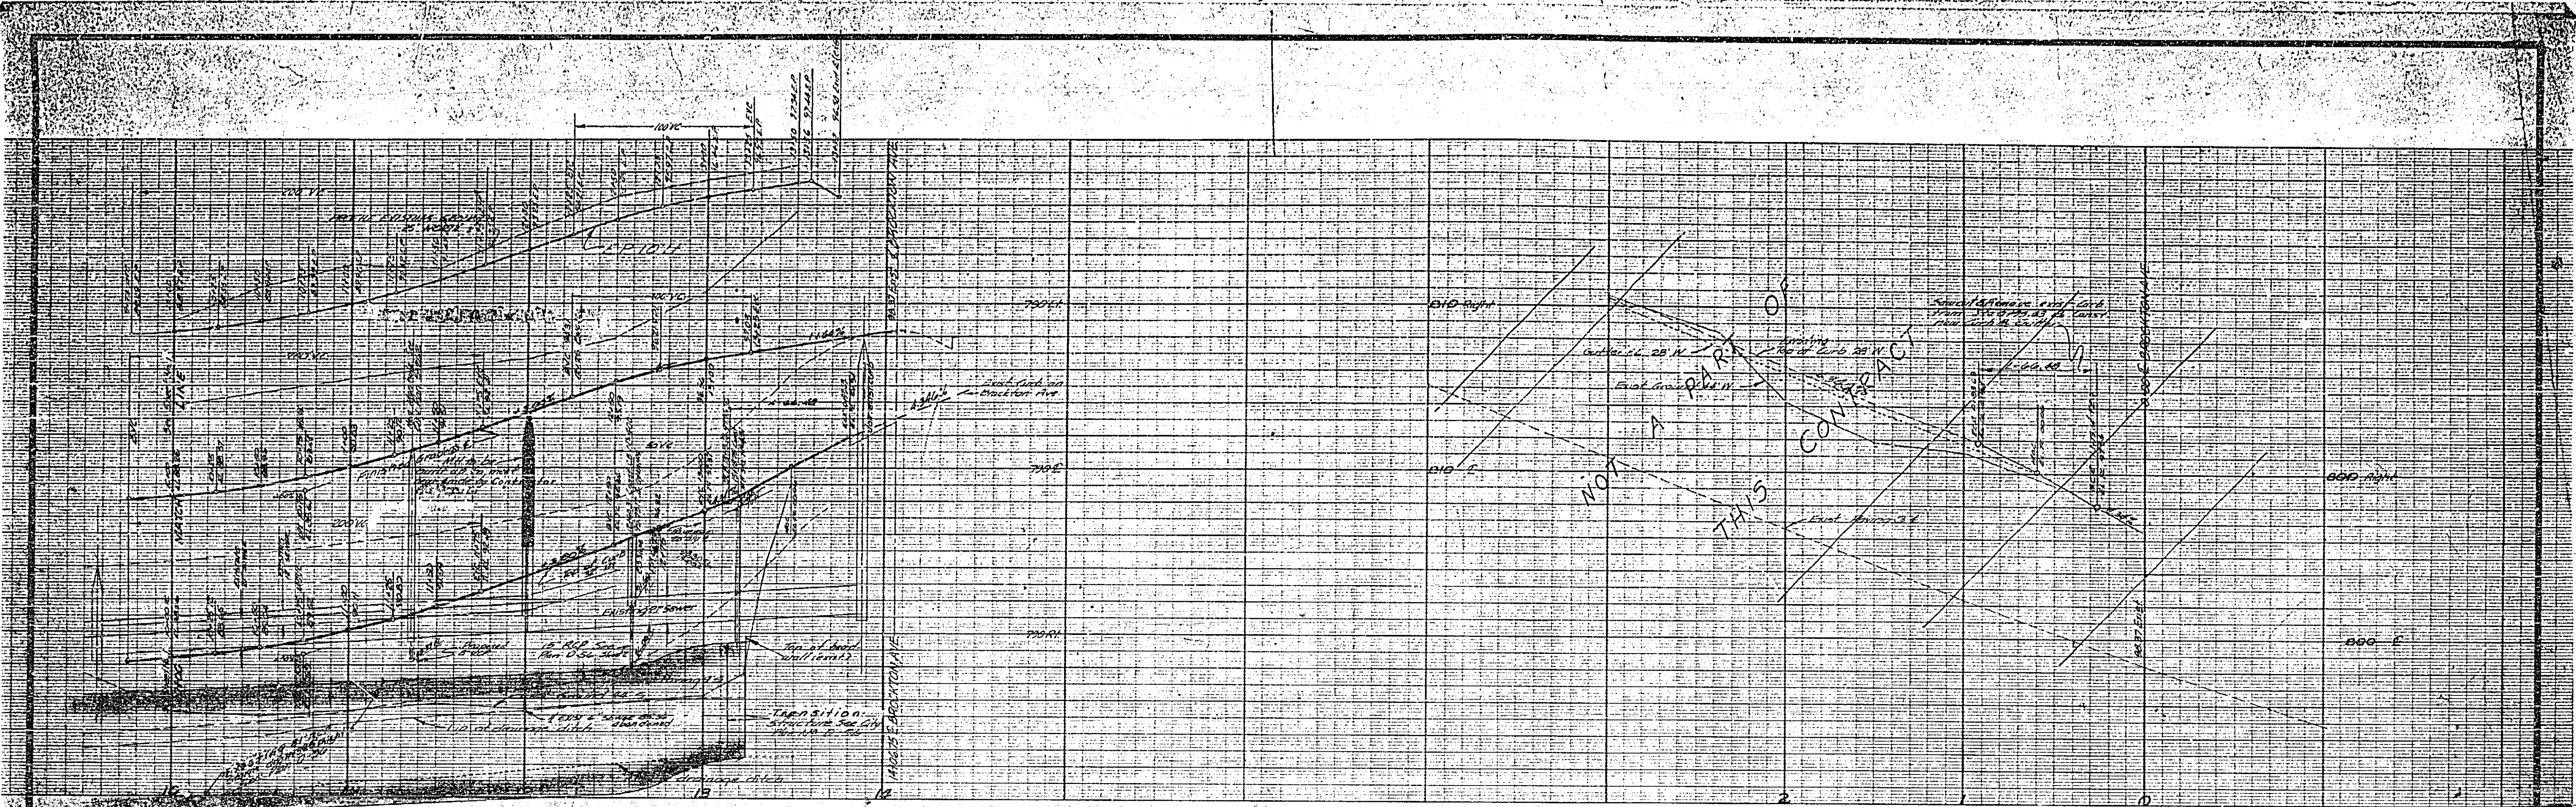

- NOTES**
- 1 Adopted from Plan R-422 prepared by J.F. Davidson - Civil Engineer, Riverside, California.
 - 2 This Contract includes 1.5 M. P.M.S. Seal coat, red wood headers, and raising manholes to grade.
 - 3 Shaded area indicates present construction to be 9" 1.5 M. 2 1/2" P.M.S. and seal coat.

REVISIONS	
MARK	DESCRIPTION
1	Final with changes from 10/16/60 per Change Order No. 1, 2, 3, 100.

APPROVED *Edith B. ...* 1-10-61
 PARK SUPERINTENDENT

CITY OF RIVERSIDE, CALIFORNIA
 DEPARTMENT OF PUBLIC WORKS

**TEQUESQUITE AVENUE
 PAVING**

FROM PALM AVE TO BROCKTON
 AVENUE

HORIZ. SCALE 1"=40' VERT. SCALE 1"=4'

APPROVED BY *...*
 Director of Public Works

DESIGNED BY *...*
 DRAWN BY *...*

CHECKED BY *...*

RECOMMENDED BY *...*
 ASSIST. CITY ENGINEER

DATE 9-7-61 SHEET 2 OF 3

NO. R-440