


RIVERSIDE

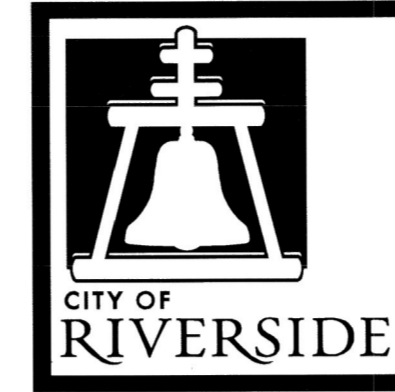

CALIFORNIA

PUBLIC WORKS DEPARTMENT ADAIR AVE SIDEWALK PROJECTS

GENERAL CONSTRUCTION NOTES:

1. THE CONTRACTOR SHALL PROVIDE AND MAINTAIN TRAFFIC AS INDICATED IN THE ASSOCIATED PROJECT SPECIAL PROVISIONS.
2. CONSTRUCTION SHALL BE IN ACCORDANCE WITH THE CITY OF RIVERSIDE STANDARD DRAWINGS AND STANDARD SPECIFICATIONS FOR PUBLIC WORKS CONSTRUCTION, 2012 EDITION.
3. EXISTING UTILITIES SHOWN ON THIS PLAN ARE PLOTTED FROM UTILITY RECORDS. THE CONTRACTOR IS REQUIRED TO TAKE DUE PRECAUTIONARY MEASURES TO LOCATE AND PROTECT ALL UTILITIES WHETHER OR NOT SHOWN ON THIS PLAN.
4. CONFLICTING UTILITIES SHOWN WITHIN CONSTRUCTION AREA WILL BE RELOCATED PRIOR TO CONSTRUCTION.
5. ALL STREET PULL BOXES, GATE VALVES, MANHOLES, ETC, AFFECTED BY CONSTRUCTION, SHALL BE ADJUSTED TO THE PROPOSED GRADE.
6. PRIME CONTRACTOR BIDDING THIS WORK SHALL HAVE A CLASS "A" OR "C-8" AND "C-12".
7. CONTRACTOR SHALL REMOVE ALL VEGETATION WITHIN ALL SIDEWALK PANELS WITHIN THE PROJECT LIMITS.
8. ALL EXISTING IMPROVEMENTS INCLUDING, BUT NOT LIMITED TO, CURB, GUTTERS, CROSS GUTTERS, SIDEWALK, DRIVEWAYS, PARKWAY CULVERTS, INLETS, ETC, SHALL BE PROTECTED IN PLACE UNLESS OTHERWISE NOTED.
9. EXISTING IRRIGATION SHALL BE PROTECTED OR MODIFIED, INCLUDING FURNISHING NEW MATERIALS, AS NECESSARY TO CONSTRUCT NEW CONCRETE IMPROVEMENTS.
10. ALL FENCE POSTS SHALL BE PROTECTED OR MODIFIED AS NECESSARY IF POST FOUNDATION IS WITHIN A SIDEWALK PANEL THAT HAS BEEN CALLED OUT FOR REPLACEMENT.
11. ADEQUATE FLOW LINES SHALL BE MAINTAINED AT ALL LOCATIONS.
12. CONTRACTOR SHALL GRIND AND OVERLAY EXISTING PAVEMENT AS REQUIRED ADJACENT TO 5% MAX. PEDESTRIAN RAMP BOTTOM LANDING INDICATED ON STANDARD DRAWING NO 304. CONTRACTOR SHALL GRIND AND OVERLAY AS NECESSARY BEYOND LANDING TO JOIN EXISTING PAVEMENT TO PROVIDE A FINISHED JOIN GRADE OF 16% MAXIMUM.
13. CONTRACTOR SHALL RECONSTRUCT EXISTING SIDEWALK OR ADD NEW SIDEWALK PER CITY STANDARD 325 AS NECESSARY TO ADEQUATELY JOIN NEW RAMP TO BE CONSTRUCTED PER CITY STD 304, WHETHER INDICATED OR NOT.

EXISTING TOPOGRAPHY:

- ⊙ SANITARY SEWER M.H.
- ⊙ STORM DRAIN M.H.
- ⊙ FIRE HYDRANT
- ⊙ GATE VALVE
- ⊙ ELECTRICAL TEST STATION (GAS)
- ⊙ WATER M.H.
- ⊙ ELECTRIC M.H.

LEGEND:

- DRIVEWAY
- PROPOSED PCC

ABBREVIATION:

- CG CURB AND GUTTER
- CF CURB FACE
- C/L CENTERLINE
- DWY DRIVEWAY
- EX. EXISTING
- FH FIRE HYDRANT
- FL FLOW LINE
- FS FINISH SURFACE
- GB GRADE BREAK
- GV GATE VALVE
- M.H. MANHOLE
- M.U. MATCH-UP
- N.T.S. NOT TO SCALE
- TC TOP OF CURB



INDEX MAP

NTS

LEGEND

--- SHEET LIMITS

CONSTRUCTION NOTES:

- REMOVE AND REPLACE IN KIND EXISTING FACILITY. NUMBERS ABOVE 100 IN A HEXAGON ON THE PLAN REFER TO THE RESPECTIVE STANDARD DRAWING AND SHALL BE CONSTRUCTED ACCORDINGLY. ANY NOTE SHOWN BELOW THE STANDARD DRAWING NUMBER INDICATES THE SPECIFIC TYPE, ACTION, OR MODIFICATION TO BE CONSTRUCTED. DIMENSIONS OF NEW FACILITY SHALL BE MODIFIED AS NECESSARY, EXCLUDING ADA REQUIREMENTS, TO MATCH EXISTING FACILITY REMOVED.
- ADJUST TO GRADE, DESCRIPTION PER PLAN (---): (WM) WATER METER (GV) GAS GATE VALVE & WATER GATE VALVE (SL) STREET LIGHT (PB) PULLBOX. (GM) MODIFY GATE AND GATE MOTOR FOR FULLY FUNCTIONAL GATE.
- PROTECT IN PLACE, DESCRIPTION PER PLAN (---): (MB) MAILBOX (GT) CHAIN LINK OR WROUGHT IRON GATE. (CLF) CHAIN LINK FENCE (WIF) WROUGHT-IRON FENCE AND/OR MASONRY WALL (TR) TREE. (SGN) STREET SIGN. (DWY) DRIVEWAY (BW) BLOCK WALL (PB) ELECTRIC PULL BOX (SWD) SIDEWALK DRAIN (PP) POWER POLE (SL) STREET LIGHT (COR) CURB CORE DRAIN
- RELOCATE EXISTING TO PROPOSED LOCATION, DESCRIPTION PER PLAN (---): (MB) MAILBOX. (CLF) CHAIN LINK FENCE. (GT) CHAIN LINK OR WROUGHT IRON GATE. (WM) WATER METER (WATER SERVICE SHALL BE EXTENDED AND WATER METER SHALL BE RELOCATED BY CITY FORCES. CONTACT CITY CONSTRUCTION SUPERINTENDENT AT 951-351-6368 TO SCHEDULE METER RELOCATION. PLEASE ALLOW 2 WEEKS FOR CONSTRUCTION SCHEDULING). (SGN) STREET SIGNS (STOP SIGN, SPEED LIMITS ETC.) SEE SIGNING AND STRIPING PLANS (MP) MASONRY PILASTERS AND WROUGHT IRON FENCING PER MASONRY PILASTER STD. PLAN. (FH) FIRE HYDRANT. (PP) POWER POLE-BY CITY FORCES. (CO) CLEAN-OUT. (TR) TREE
- REMOVE EXISTING AND REPLACE WITH NEW AT PROPOSED LOCATION, DESCRIPTION PER PLAN. (MB) MAILBOX. (CLF) CHAIN LINK FENCE. (SHR) SHRUB (GP) GUY POLE-BY CITY FORCE (XG) CROSS GUTTER (BPW) BLOCK PLANTER WALL (SGN) STREET SIGN AND POST.
- REMOVE EXISTING, DESCRIPTION PER PLAN (---): (T1) CLASS I TREE AND ROOTS. (T2) CLASS II TREE AND ROOTS. (T3) CLASS III TREE AND ROOTS. (SHR) SHRUB. (BDR) LANDSCAPE BORDER. (STP) STEPPED WALKWAY (PLN) PLANTER. (PVR) BRICK PAVERS. (RET) RETAINING WALL (XG) CROSS GUTTER (BW) BLOCK WALL (SGN) STREET SIGN AND POST (PIP) PIPE
- CONSTRUCT 6' WIDE CROSS GUTTER
- CONSTRUCT DRIVEWAY PER CITY STD 302 WITH THE FOLLOWING MODIFICATIONS (---): (C1) = CONSTRUCT TYPE CURB-1 DRIVEWAY PER STD. PLANS
- CONSTRUCT WHEELCHAIR RAMP PER CITY STD 304 WITH THE FOLLOWING TYPE OR MODIFICATION (---): (I) = TYPE I. (VII) = TYPE VII @ MID BLOCK DWY
- CONSTRUCT SIDEWALK PER CITY STD 325 WITH THE FOLLOWING TYPE OR MODIFICATION (---): (STD) = CONSTRUCT CURBSIDE SIDEWALK PER STD. PLANS. (RET) = CONSTRUCT RETAINING CURB BEHIND SIDEWALK. INCLUDES CURB HEIGHTS UP TO 18".
- CONSTRUCT NON-STEPPED WALKWAY WITH MAXIMUM SLOPE OF 8.33% TO MATCHUP FROM BACK OF SIDEWALK TO EXISTING WALKWAY.
- CORE NEW CURB WITH 4" DIA. AND CONNECT EXISTING OUTLET THROUGH CURB SEE DETAIL ON SHEET 3 (AS NEEDED)

SHEET INDEX:

| SHEET NO. | SHEET NAME (LIMITS) |
|-----------|-------------------------------------|
| 1. | TITLE SHEET |
| 2. | ADAIR AVE STA. 40+00.00 TO 51+00.00 |
| 3. | ADAIR AVE STA. 51+00.00 TO 54+62.22 |

As Built 5/09/23 B.O

| | | | | | | | | | | | | | | | | | | | | | | | | | | | | |
|---|---|--|---------------|----|------|-------------|---------------------|--------------------|---------|---------------|---------------------|--------------------|---------|--|------------------|--------------------|---------|--|--------|--|--|--|---------|--|--|--|---|---|
| <p>Under Ground Service Alert of Southern California Call: TOLL FREE 1-800-227-2600 TWO WORKING DAYS BEFORE YOU DIG</p> | <p>ENGINEER IN RESPONSIBLE CHARGE</p> <p><i>Ehsanid Mohammadi</i></p> <p>Forshid A. Mohammadi R.C.E. No. 51304 EXPIRES: 6-30-22 DATE: 7/21/20</p> | <p>CITY OF RIVERSIDE, CALIFORNIA DEPARTMENT OF PUBLIC WORKS</p> <table border="1"> <tr> <td>APPROVED BY</td> <td>BY</td> <td>DATE</td> <td>APPROVED BY</td> </tr> <tr> <td>ENGINEERING MANAGER</td> <td><i>[Signature]</i></td> <td>7-28-20</td> <td>CITY ENGINEER</td> </tr> <tr> <td>CONSTRUCTION ADMIN.</td> <td><i>[Signature]</i></td> <td>7-28-20</td> <td></td> </tr> <tr> <td>TRAFFIC DIVISION</td> <td><i>[Signature]</i></td> <td>7/28/20</td> <td></td> </tr> <tr> <td>SURVEY</td> <td></td> <td></td> <td></td> </tr> <tr> <td>STREETS</td> <td></td> <td></td> <td></td> </tr> </table> | APPROVED BY | BY | DATE | APPROVED BY | ENGINEERING MANAGER | <i>[Signature]</i> | 7-28-20 | CITY ENGINEER | CONSTRUCTION ADMIN. | <i>[Signature]</i> | 7-28-20 | | TRAFFIC DIVISION | <i>[Signature]</i> | 7/28/20 | | SURVEY | | | | STREETS | | | | <p>SIDEWALK IMPROVEMENTS</p> <p>ADAIR AVENUE SIDEWALK IMPROVEMENTS</p> <p>TITLE SHEET</p> <p>HORIZ. SCALE: 1"=20' VERT. SCALE: NA</p> | <p>DESIGN WORK ORDER NO.: 1931284 CONSTR. WORK ORDER NO.: XXXXXX</p> <p>R-4495</p> <p>SHEET 1 OF 3</p> <p>FILE NAME: R4495-01.DWG</p> |
| | | | APPROVED BY | BY | DATE | APPROVED BY | | | | | | | | | | | | | | | | | | | | | | |
| ENGINEERING MANAGER | <i>[Signature]</i> | 7-28-20 | CITY ENGINEER | | | | | | | | | | | | | | | | | | | | | | | | | |
| CONSTRUCTION ADMIN. | <i>[Signature]</i> | 7-28-20 | | | | | | | | | | | | | | | | | | | | | | | | | | |
| TRAFFIC DIVISION | <i>[Signature]</i> | 7/28/20 | | | | | | | | | | | | | | | | | | | | | | | | | | |
| SURVEY | | | | | | | | | | | | | | | | | | | | | | | | | | | | |
| STREETS | | | | | | | | | | | | | | | | | | | | | | | | | | | | |
| <p>MARK</p> <p>REVISIONS</p> <p>APPR. DATE</p> <p>DESIGNED BY: CG DRAWN BY: CG CHECKED BY: FM</p> | | | | | | | | | | | | | | | | | | | | | | | | | | | | |

