



DATE	BY	REVISION

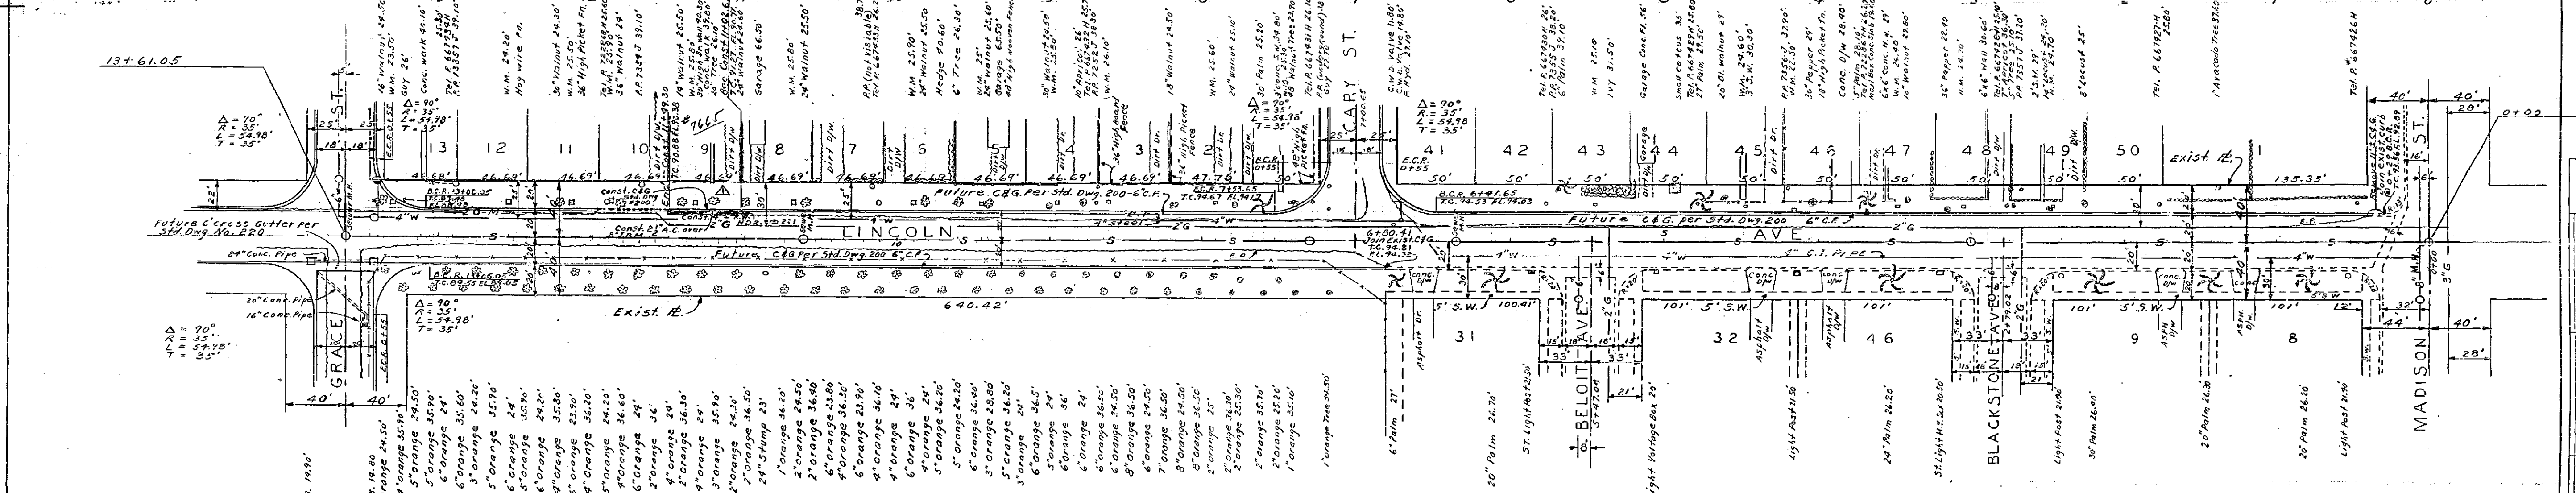

DATE	BY	REVISION

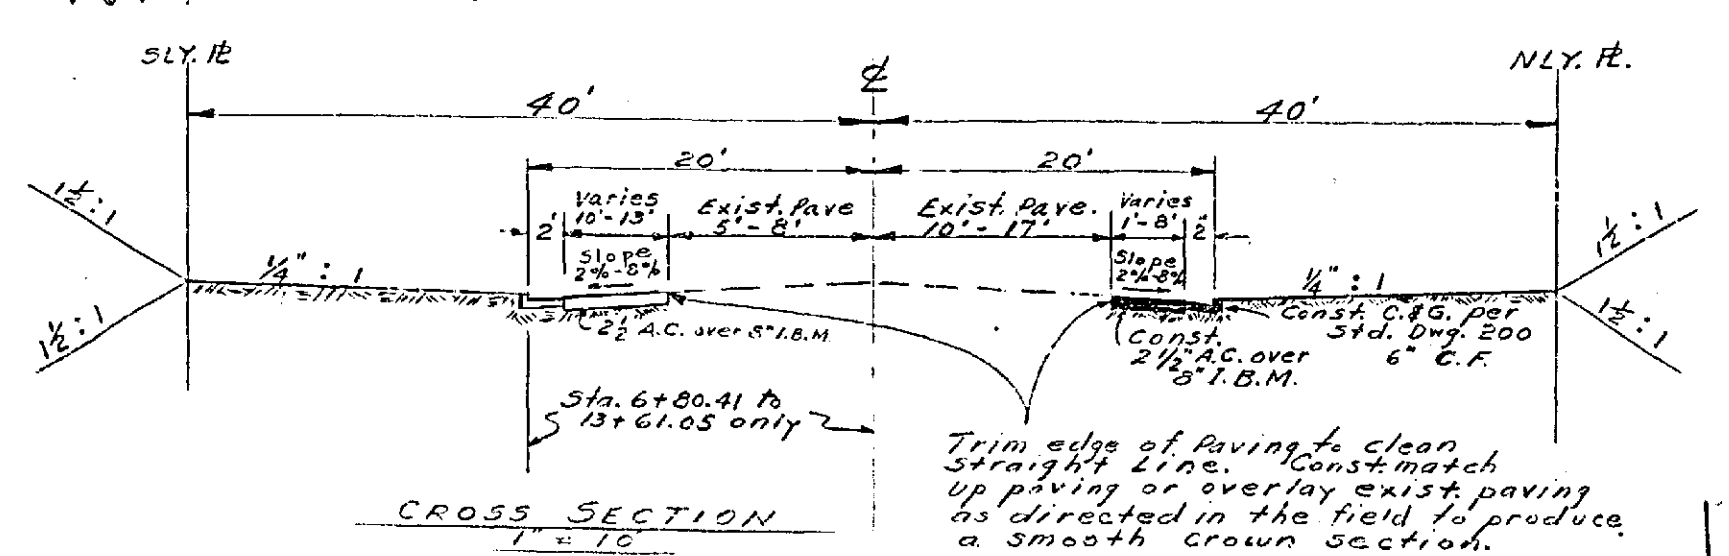

NOTE:
All construction shall be in accordance with Standard Drawings & Specifications No. 461 of the Department of Public Works, City of Riverside.

REVISIONS			CITY OF RIVERSIDE CALIFORNIA DEPARTMENT OF PUBLIC WORKS	
MARK	DATE	DESCRIPTION		
DESIGNED BY		CHECKED BY	APPROVED BY	R-534 SHEET 1 OF 1
DRAWN BY	H.R.C.		DIRECTOR OF PUBLIC WORKS	
RECOMMENDED BY		ASSISTANT CITY ENGINEER	DATE: 7-17-1942	