


W 14 R.

E 14 R.

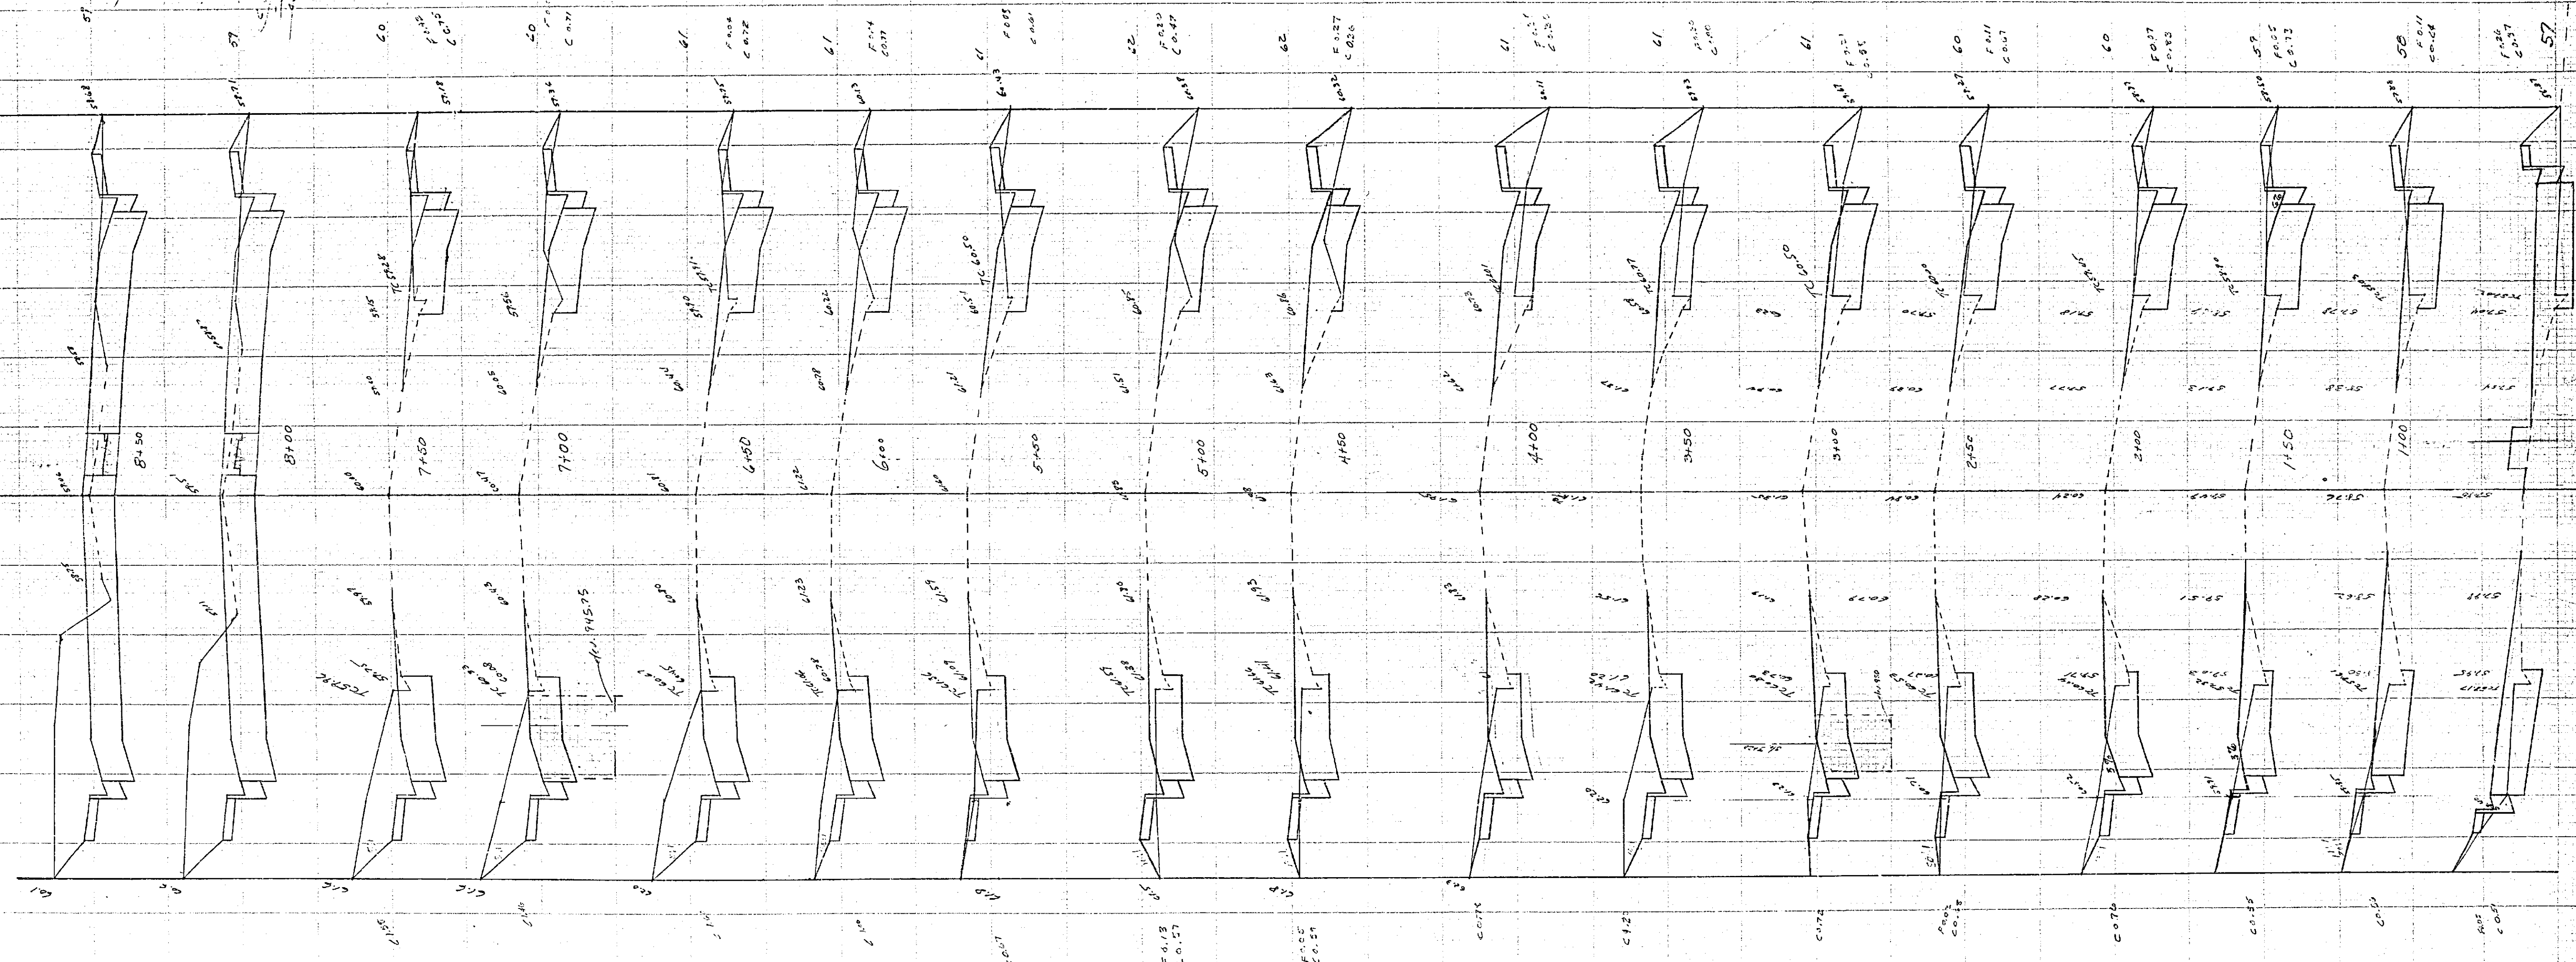

2-536  
 Scale  
 1/2" = 1'-0"  
 1/4" = 1'-0"  
 Chicago Ave. Widening  


CLEVELAND, OHIO

CLEVELAND, OHIO

CLEVELAND, OHIO


R-536



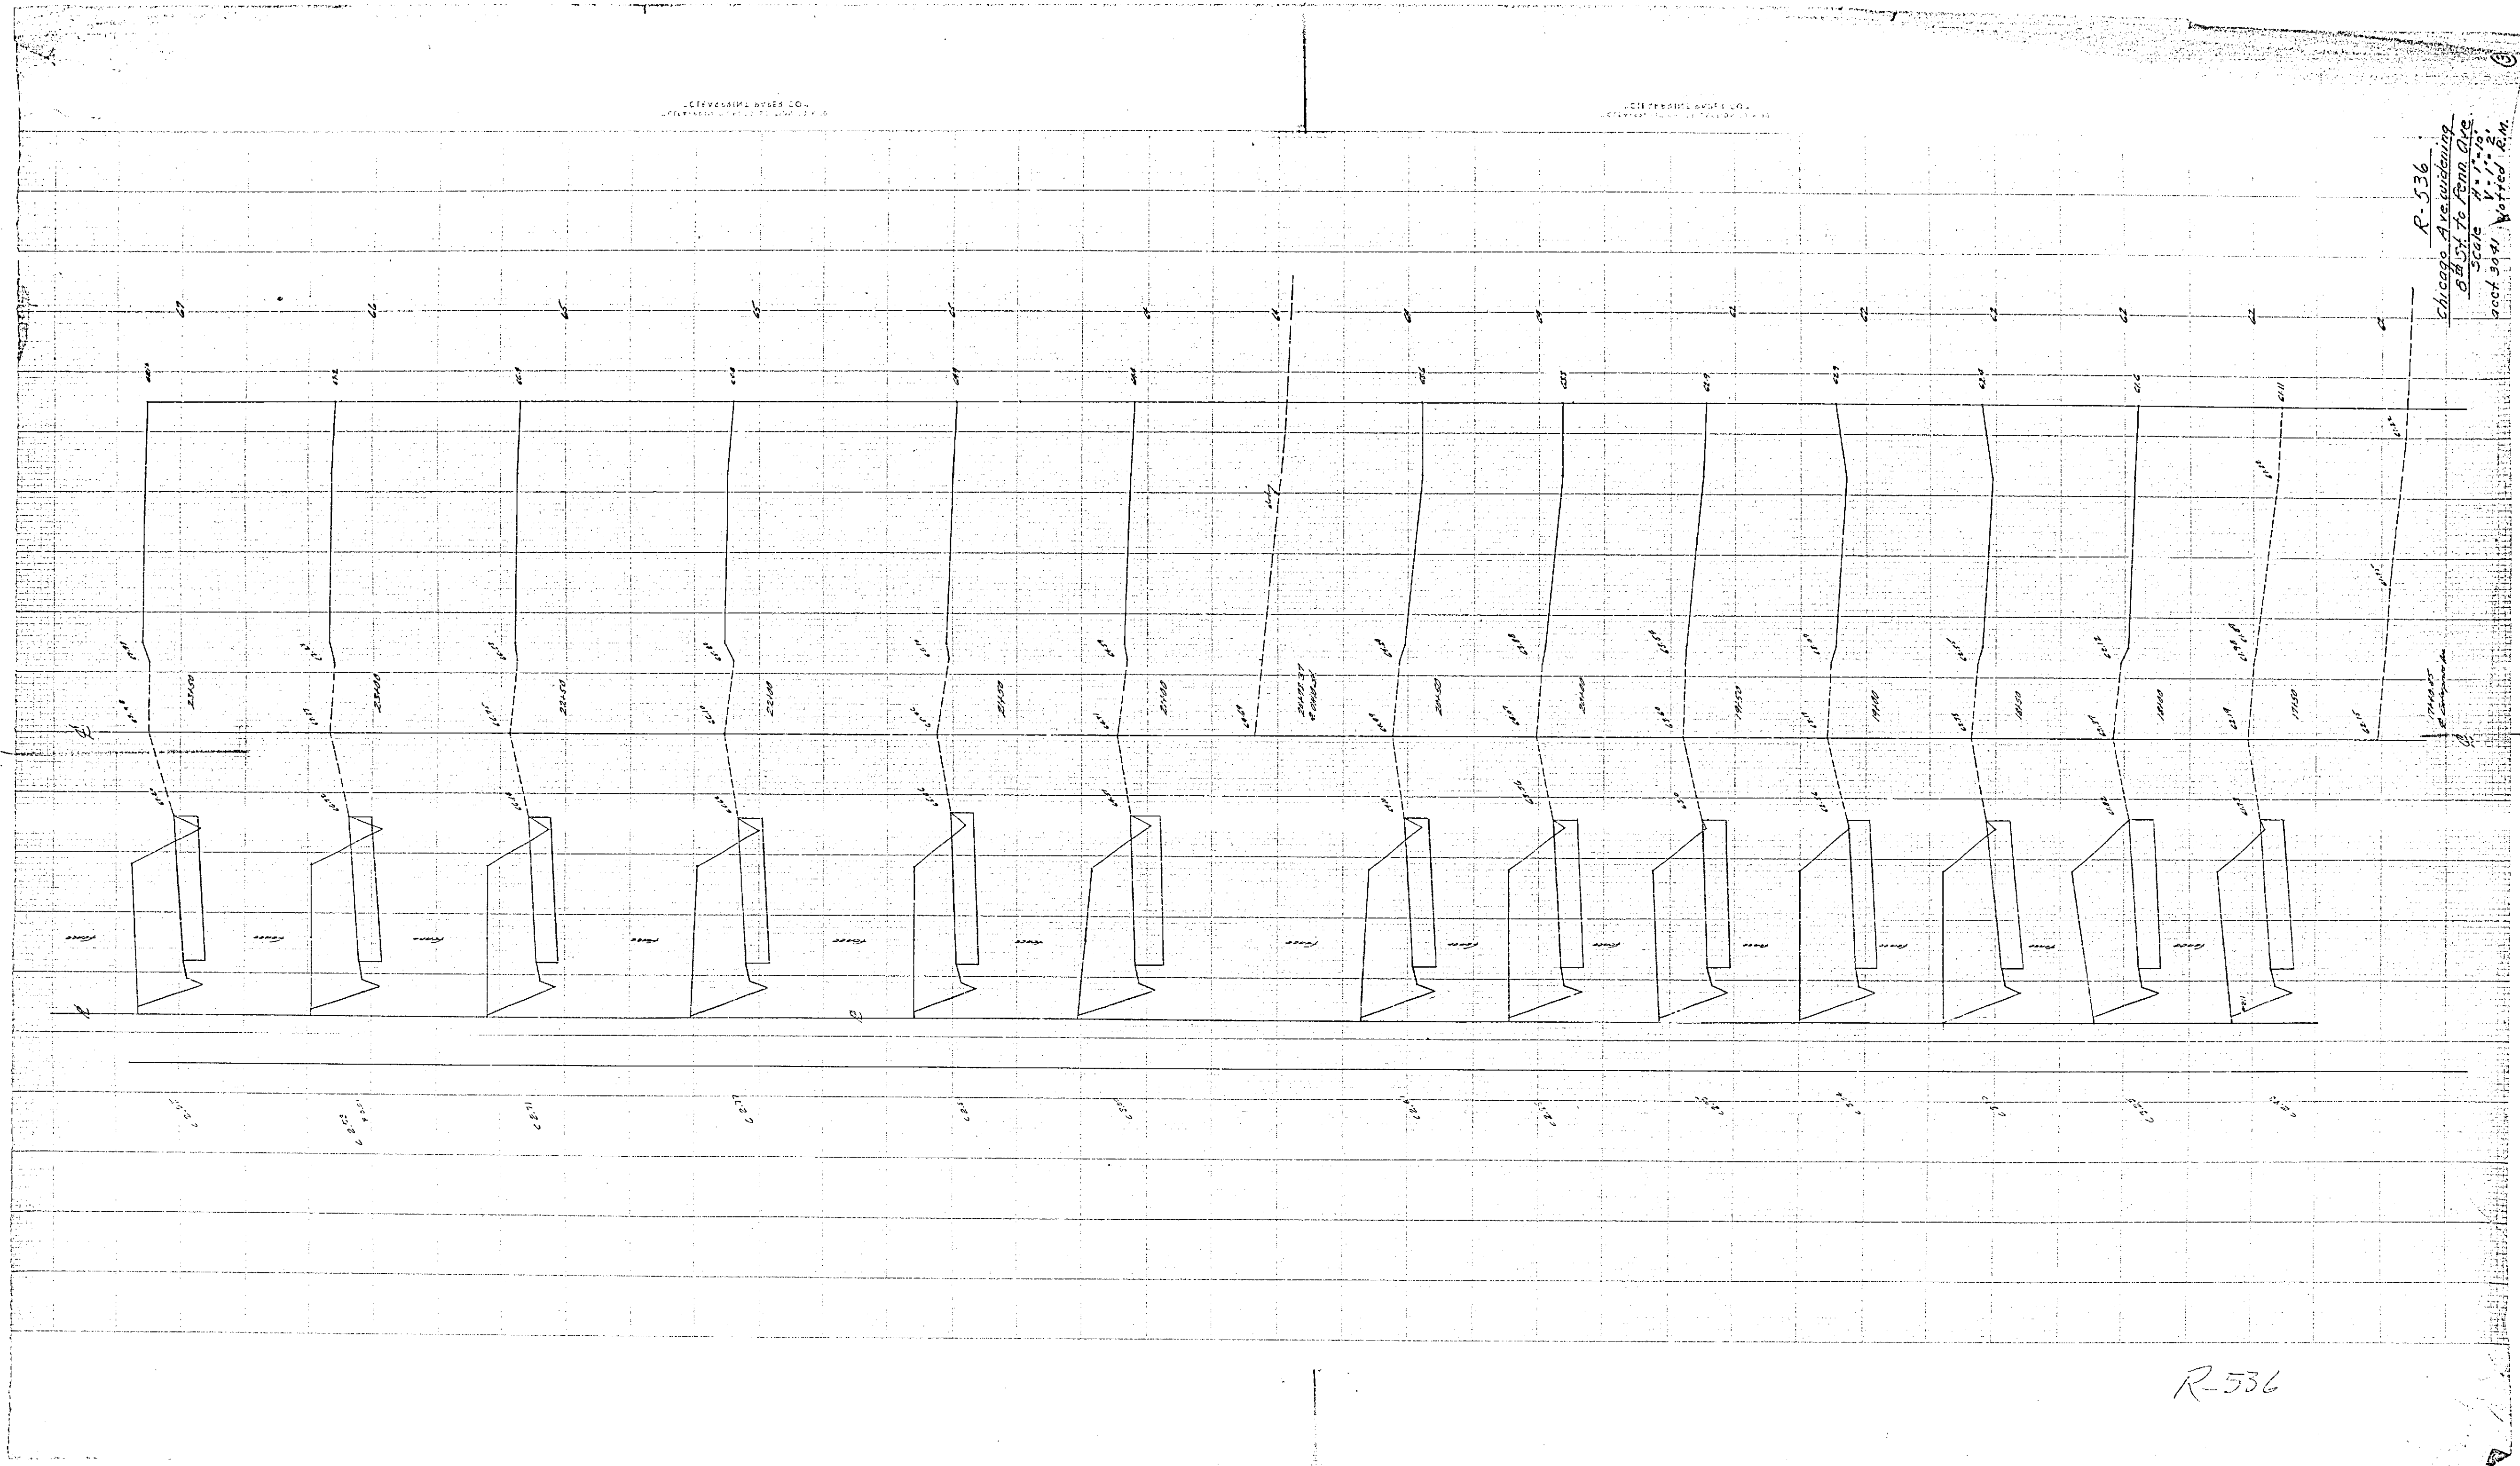


R-536  
Chicago Ave. widening  
SCALE 1" = 20'  


R-536

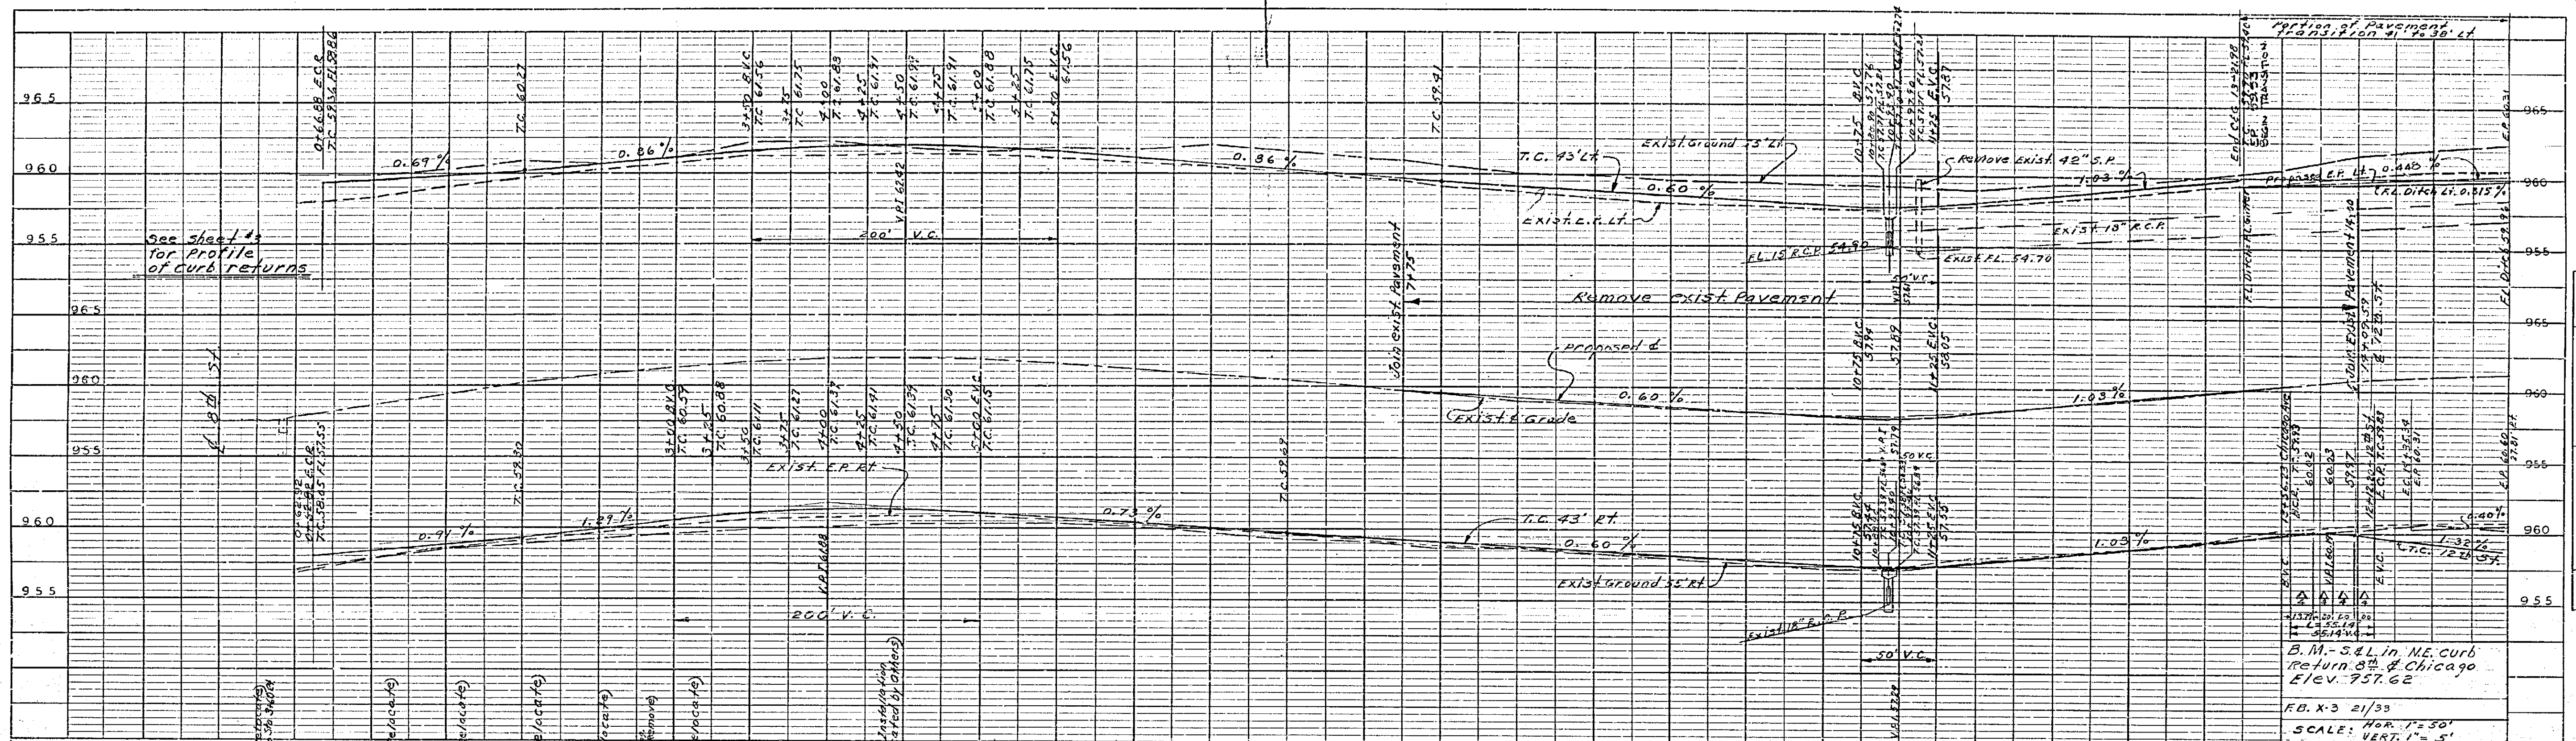



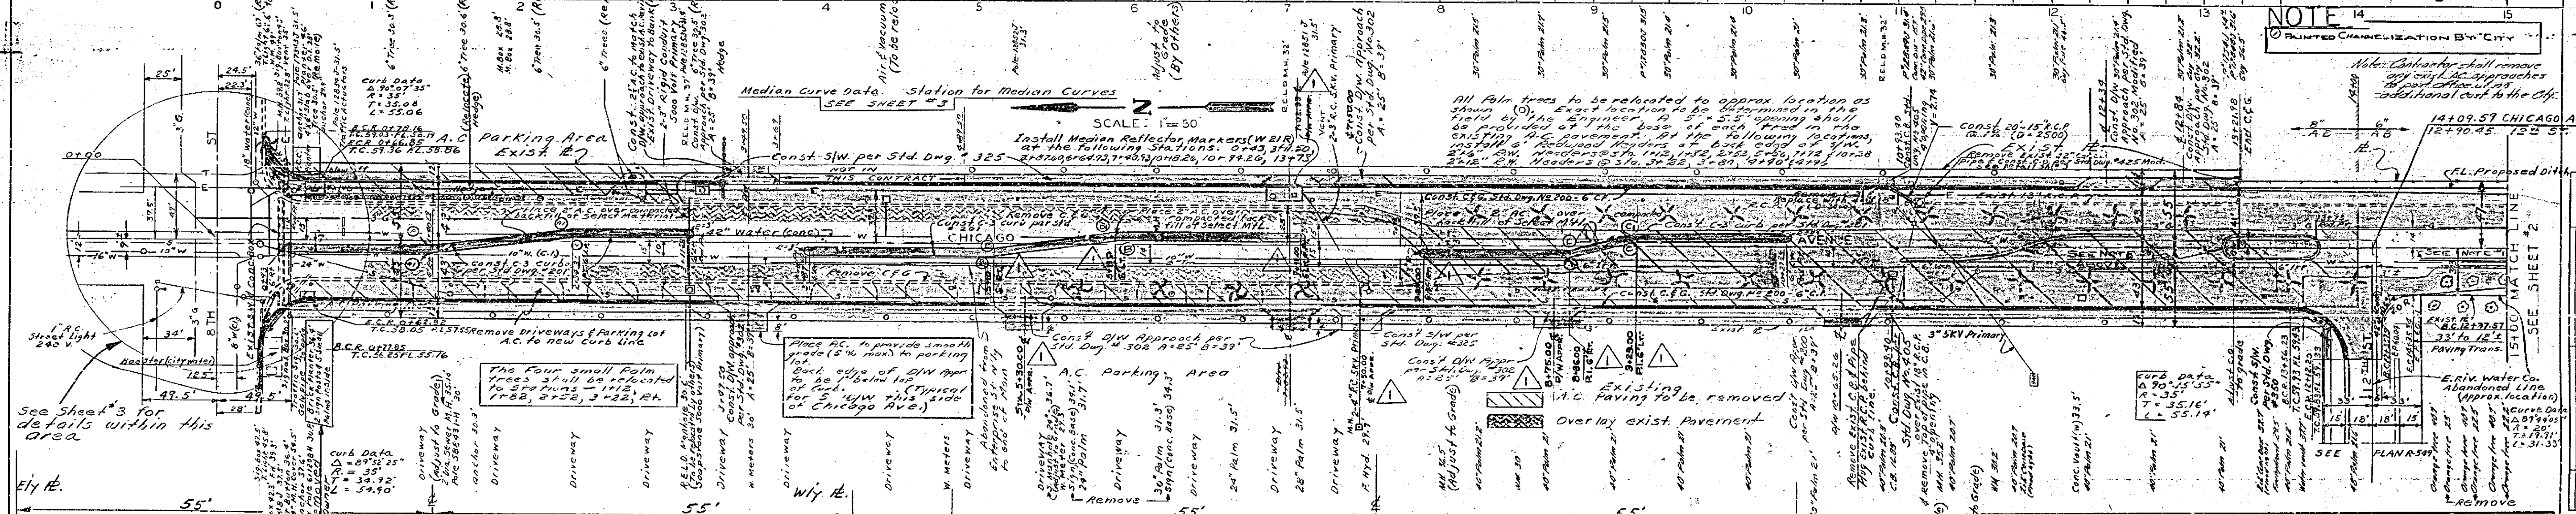


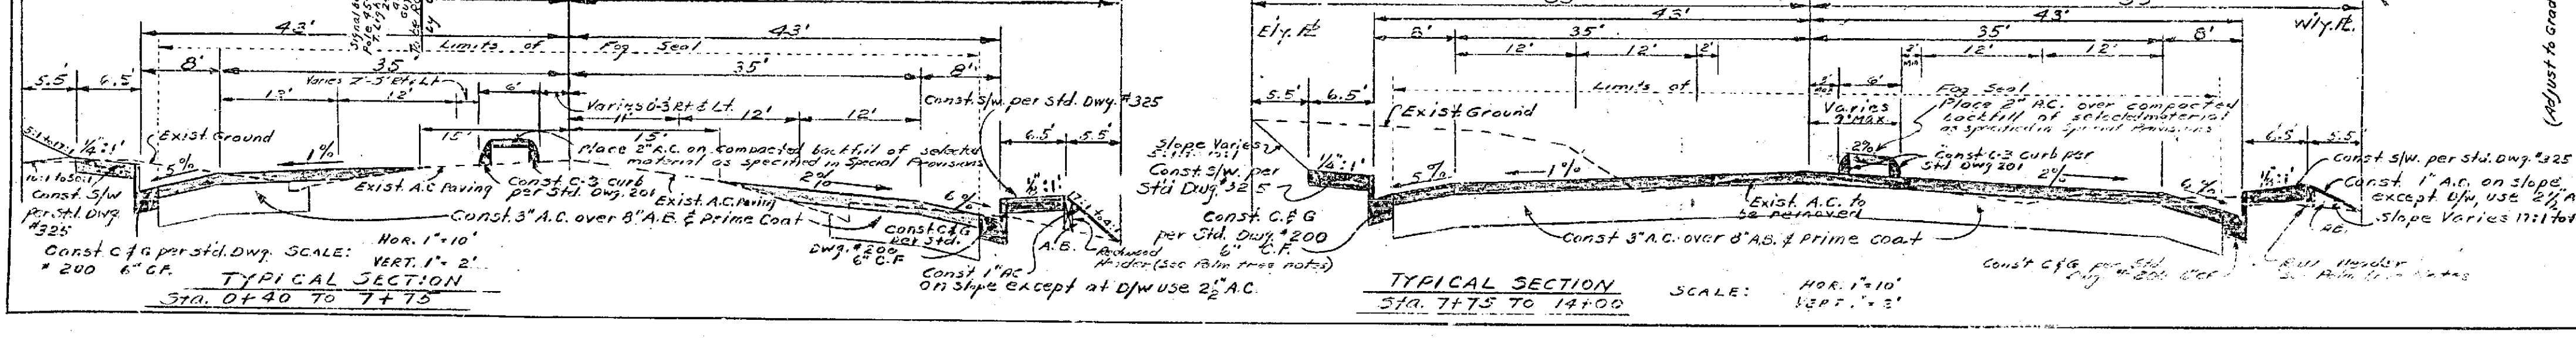

| REVISIONS   |              |                           | CITY OF RIVERSIDE, CALIFORNIA<br>DEPARTMENT OF PUBLIC WORKS |      |
|-------------|--------------|---------------------------|---|------|
| MARK        | DATE         | DESCRIPTION               | MAJOR CITY STREET PROJ. NO. 114                             |      |
| DESIGNED BY | SUBMITTED BY | APPROVED BY               | PROJ. NO.   | 3041 |
| DRAWN BY    | PARK DEPT.   | TRAFFIC DIV.              | R-536   |      |
| CHECKED BY  | DATE         | 10-15-67                  | SHEET 1 OF 3  |      |

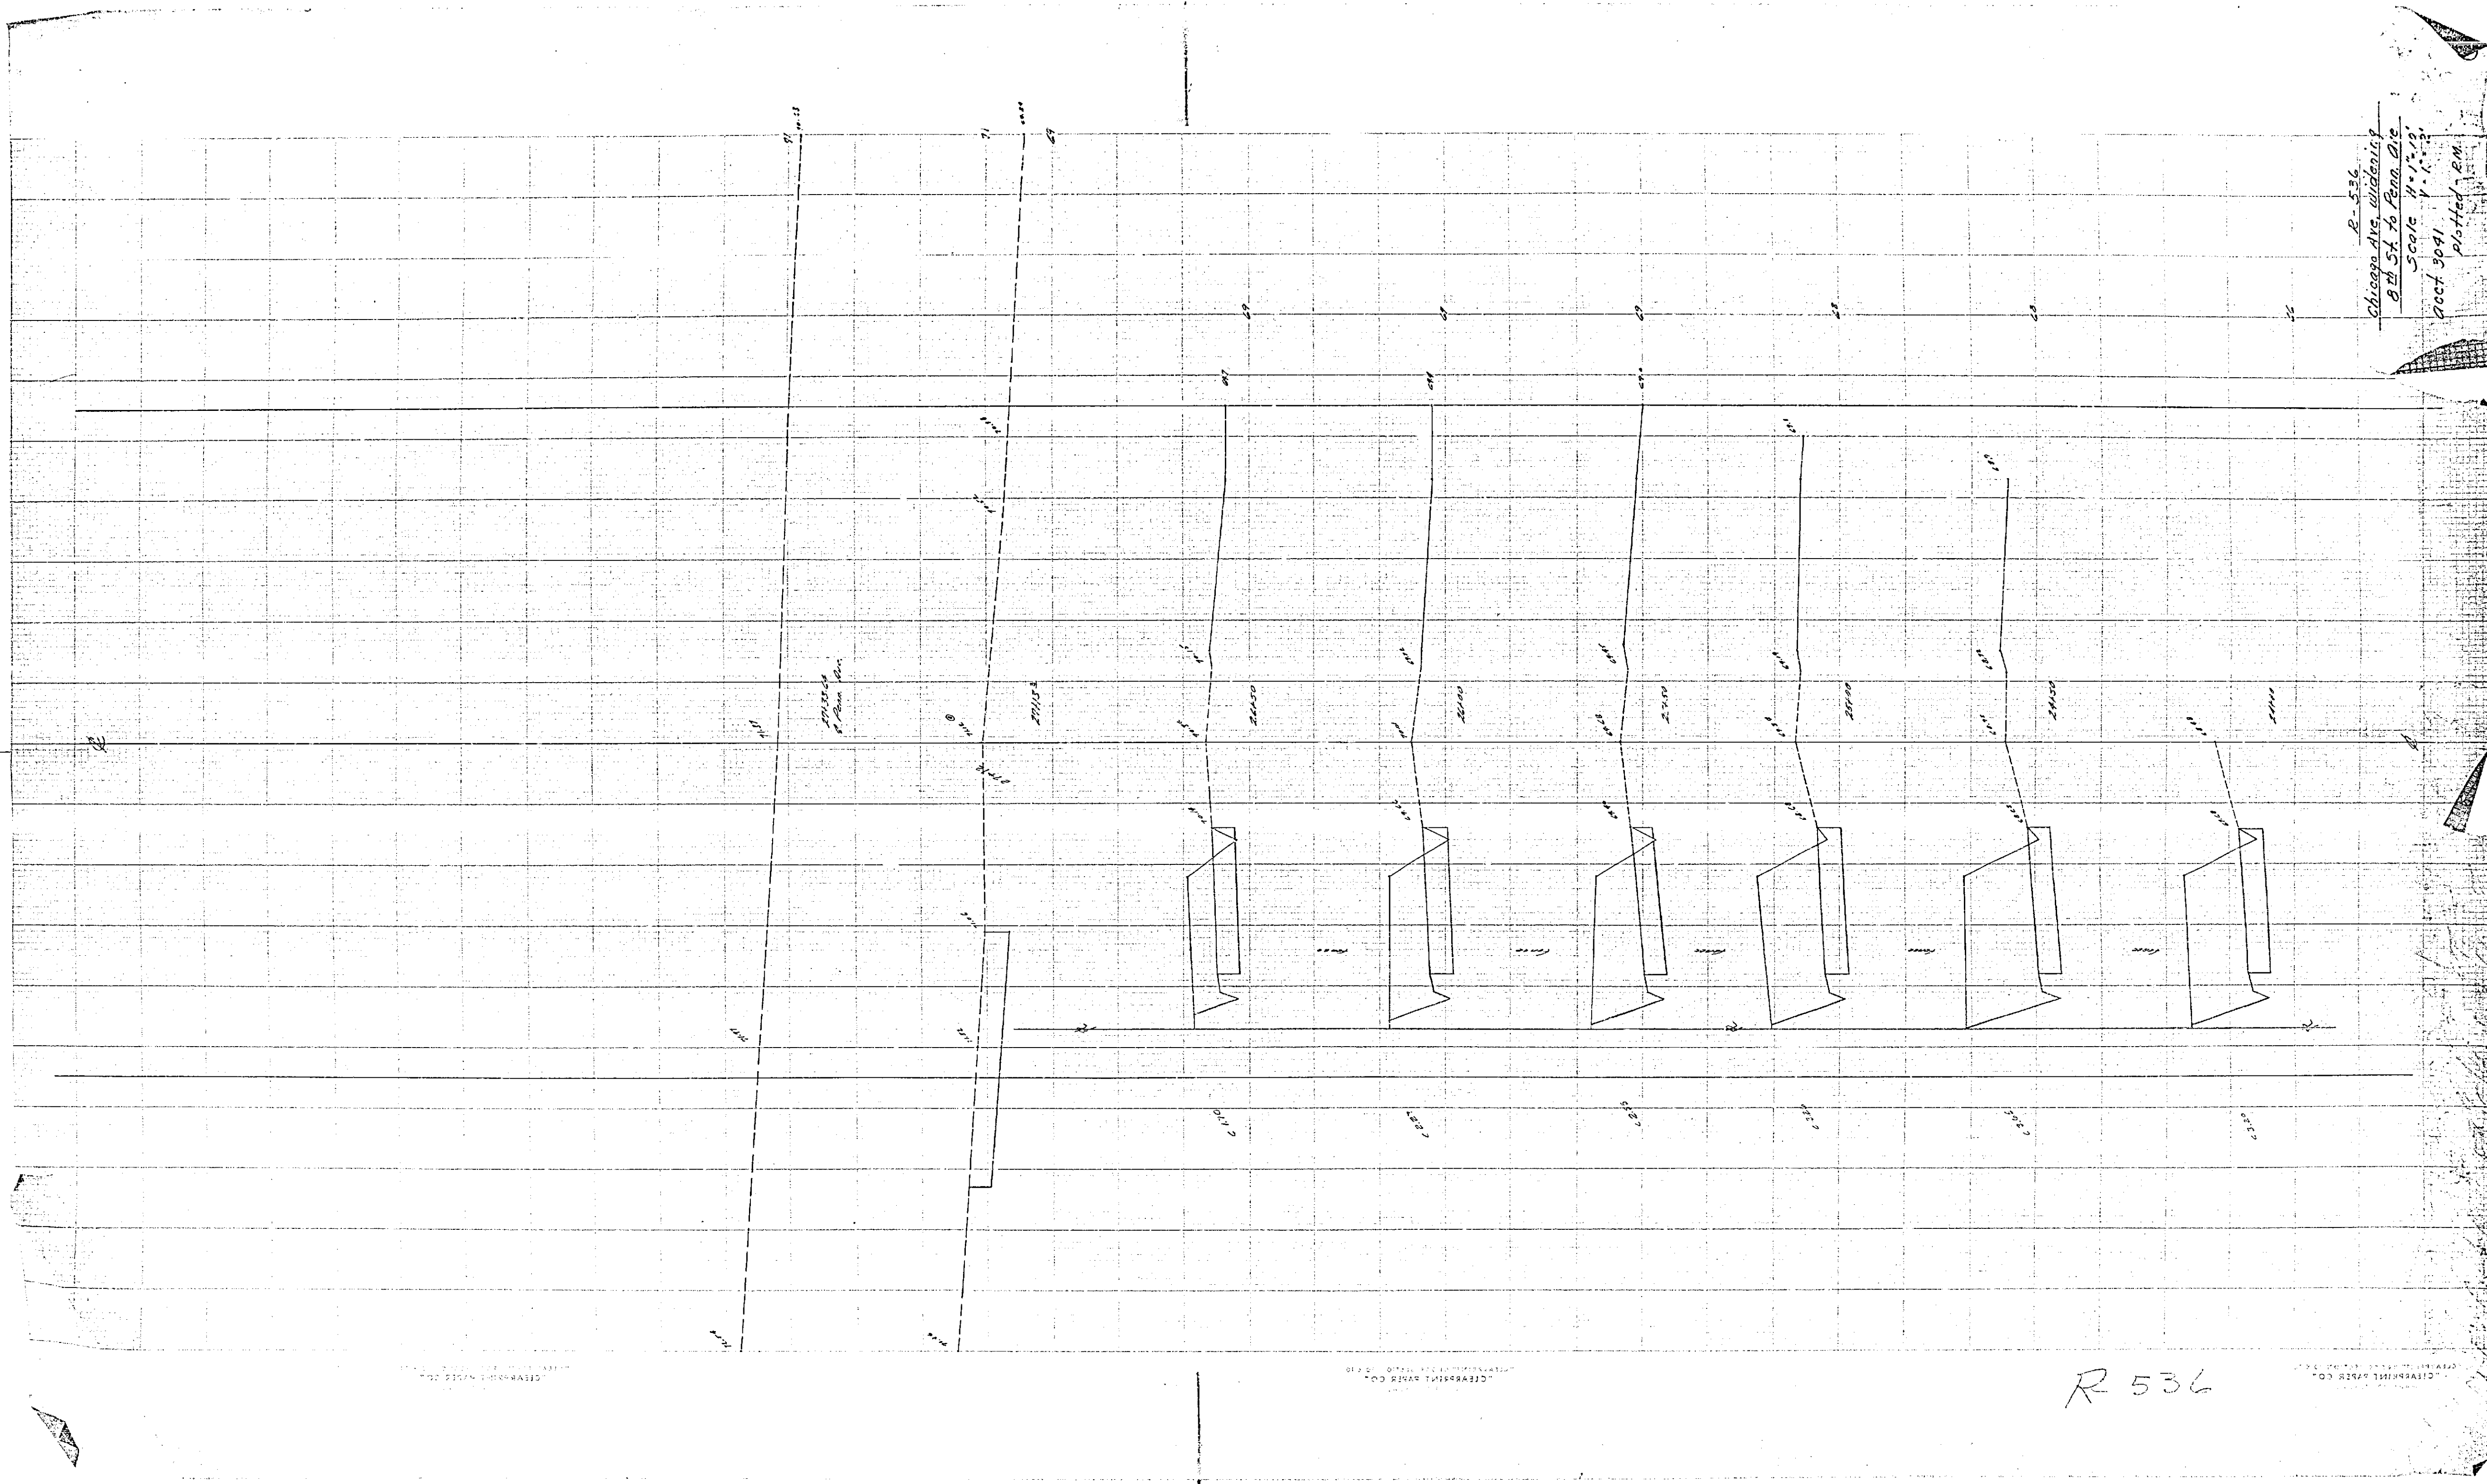


R-536  
Chicago Ave. Widening  
Plotted, P.M.

R 536




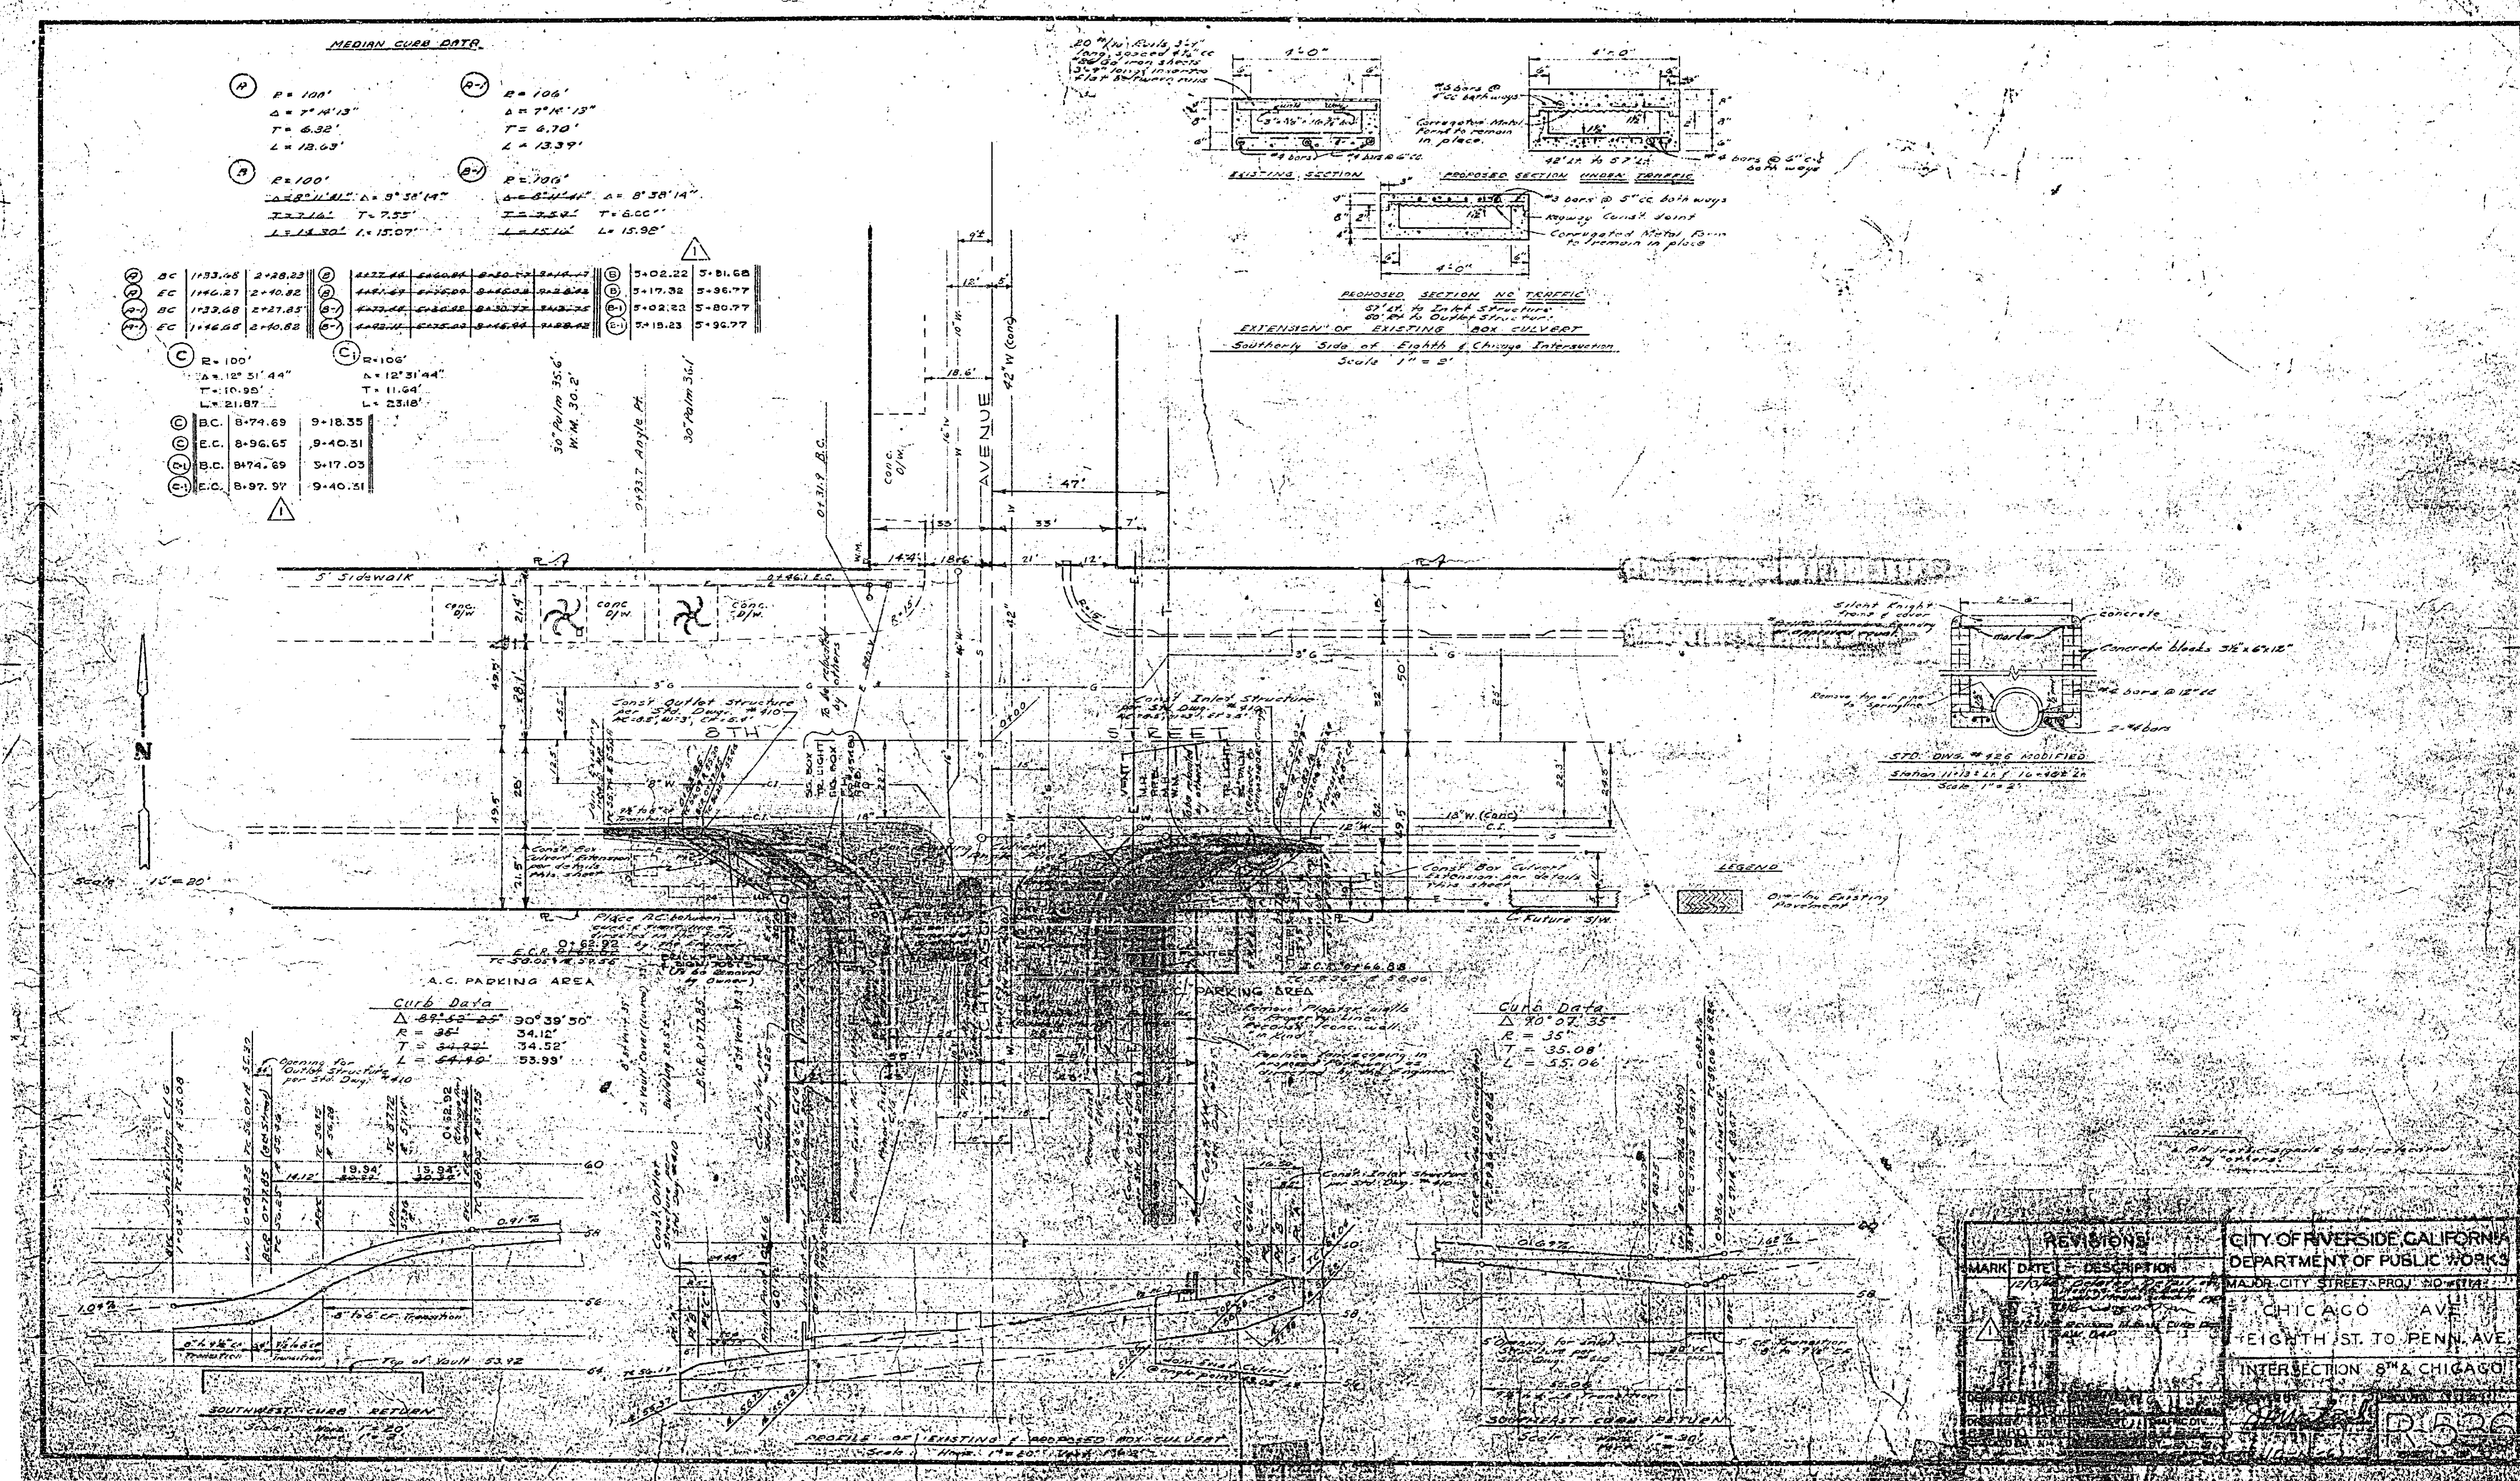

**MEDIAN CURB DATA**

|                |                |
|----------------|----------------|
| (H) R=100'     | (RV) R=106'    |
| Δ = 7° 14' 13" | Δ = 7° 14' 13" |
| T = 6.32'      | T = 6.70'      |
| L = 12.63'     | L = 13.39'     |



  

|                |                |
|----------------|----------------|
| (B) R=100'     | (BV) R=100'    |
| Δ = 9° 38' 14" | Δ = 9° 38' 14" |
| T = 7.55'      | T = 6.00'      |
| L = 15.30'     | L = 15.98'     |


|                 |                 |
|-----------------|-----------------|
| (C) R=100'      | (C) R=106'      |
| Δ = 12° 31' 44" | Δ = 12° 31' 44" |
| T = 16.95'      | T = 11.54'      |
| L = 21.87'      | L = 23.18'      |

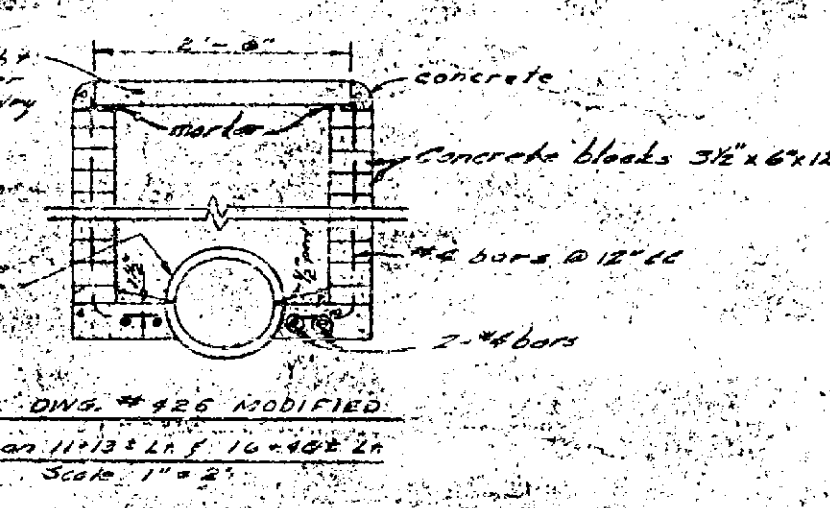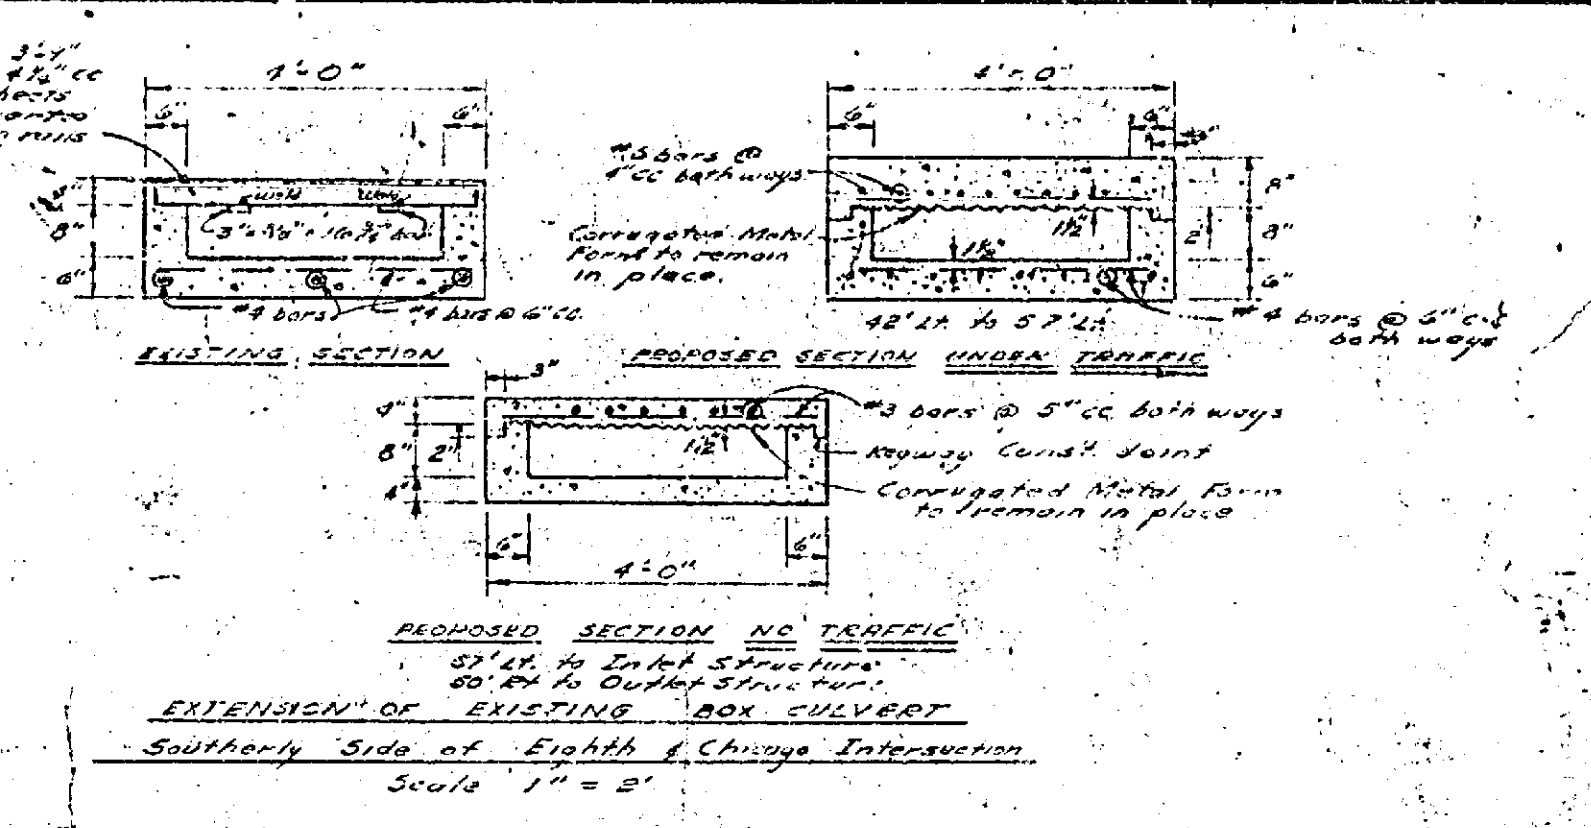

**Curb Data**


|                 |             |
|-----------------|-------------|
| Δ = 32° 52' 25" | 30° 39' 50" |
| R = 38'         | 34.12'      |
| T = 24.22'      | 34.52'      |
| L = 44.49'      | 33.99'      |

**Curb Data**

|                 |
|-----------------|
| Δ = 30° 07' 35" |
| R = 35'         |
| T = 35.08'      |
| L = 55.06'      |


|                  |        |   |
|------------------|--------|---|
| <b>REVISIONS</b> |        | <b>CITY OF RIVERSIDE CALIFORNIA</b><br>DEPARTMENT OF PUBLIC WORKS<br>MAJOR CITY STREET PROJ. NO. 7112<br><b>CHICAGO AVE</b><br>EIGHTH ST. TO PENN. AVE.<br>INTERSECTION 8TH & CHICAGO |
| MARK             | DATE   |   |
| 1                | 1/1/50 | R. B. 26<br>1/1/50  |
| 2                | 1/1/50 |   |

PLATE 1 - PLAN PROFILE & R. STANDARDS  

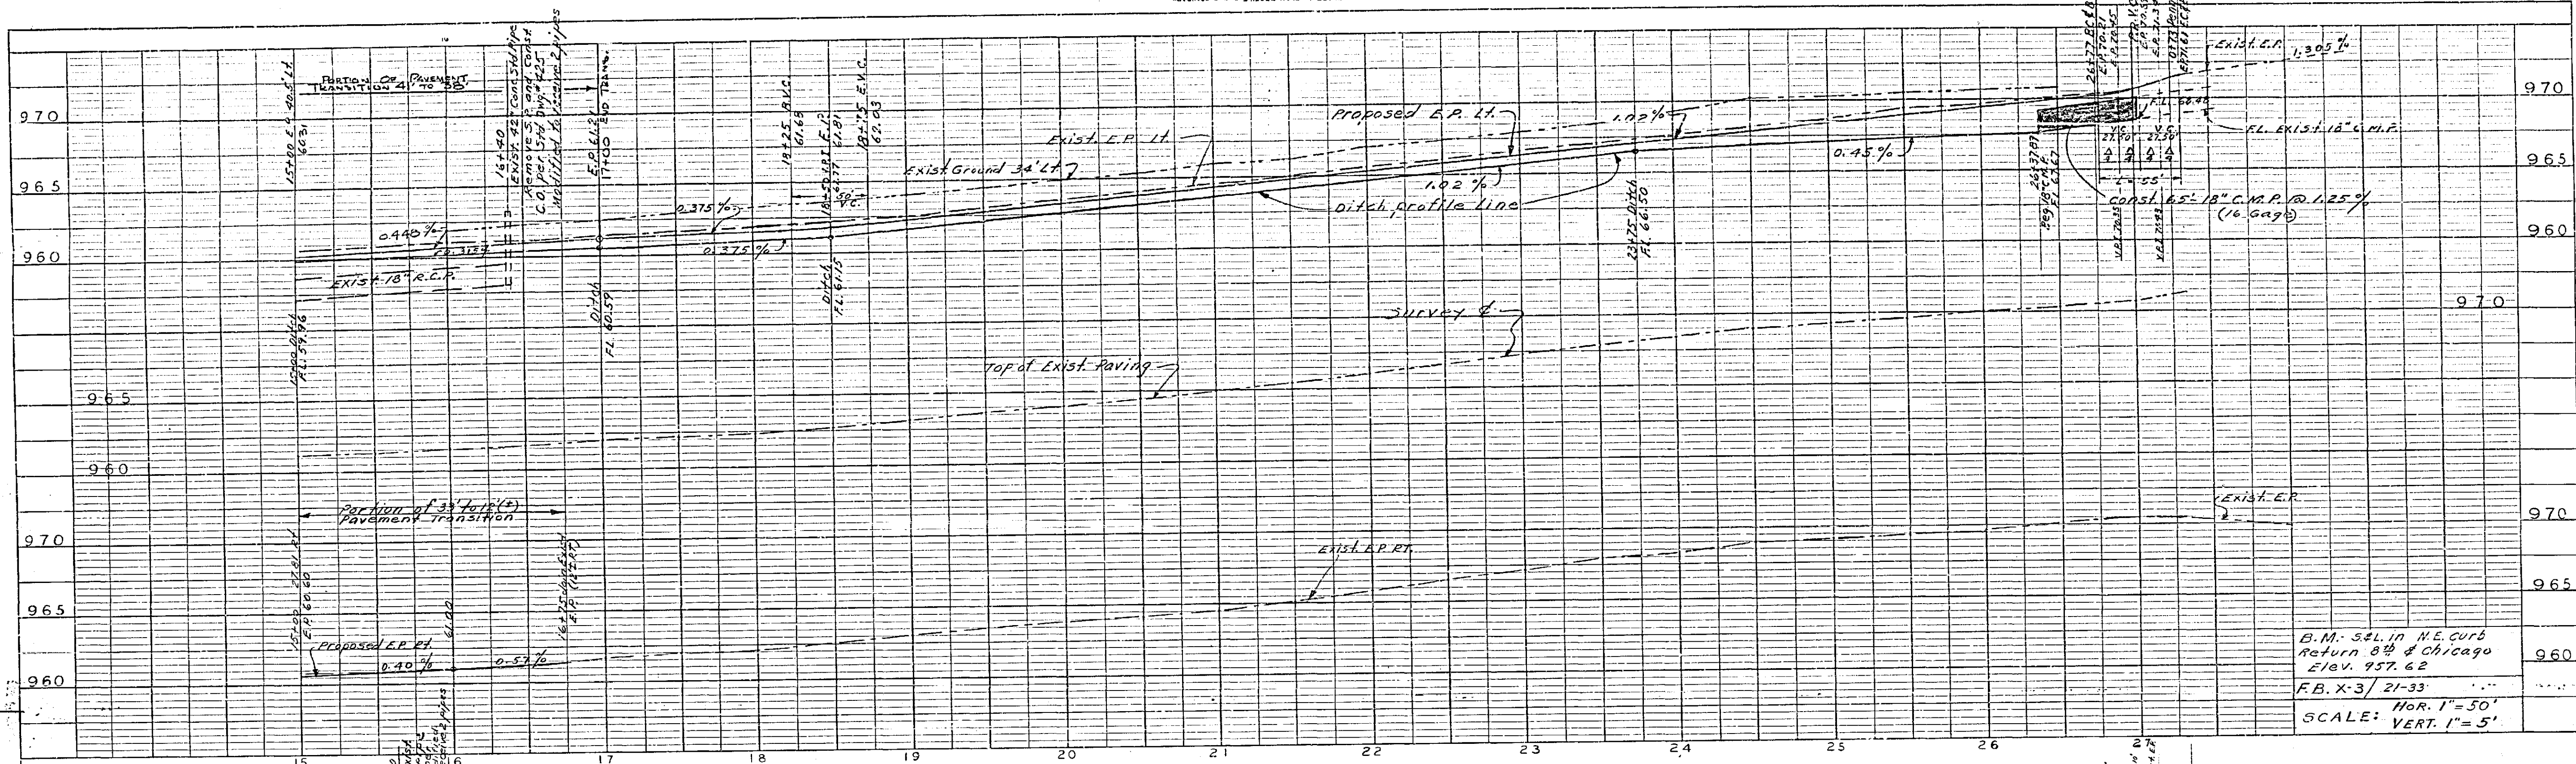


B.M. 541 in N.E. CURB  
Return 8th & Chicago  
Elev. 957.62  
F.B. X-3/21-33  
Hor. 1"=50'  
SCALE: VERT. 1"=5'

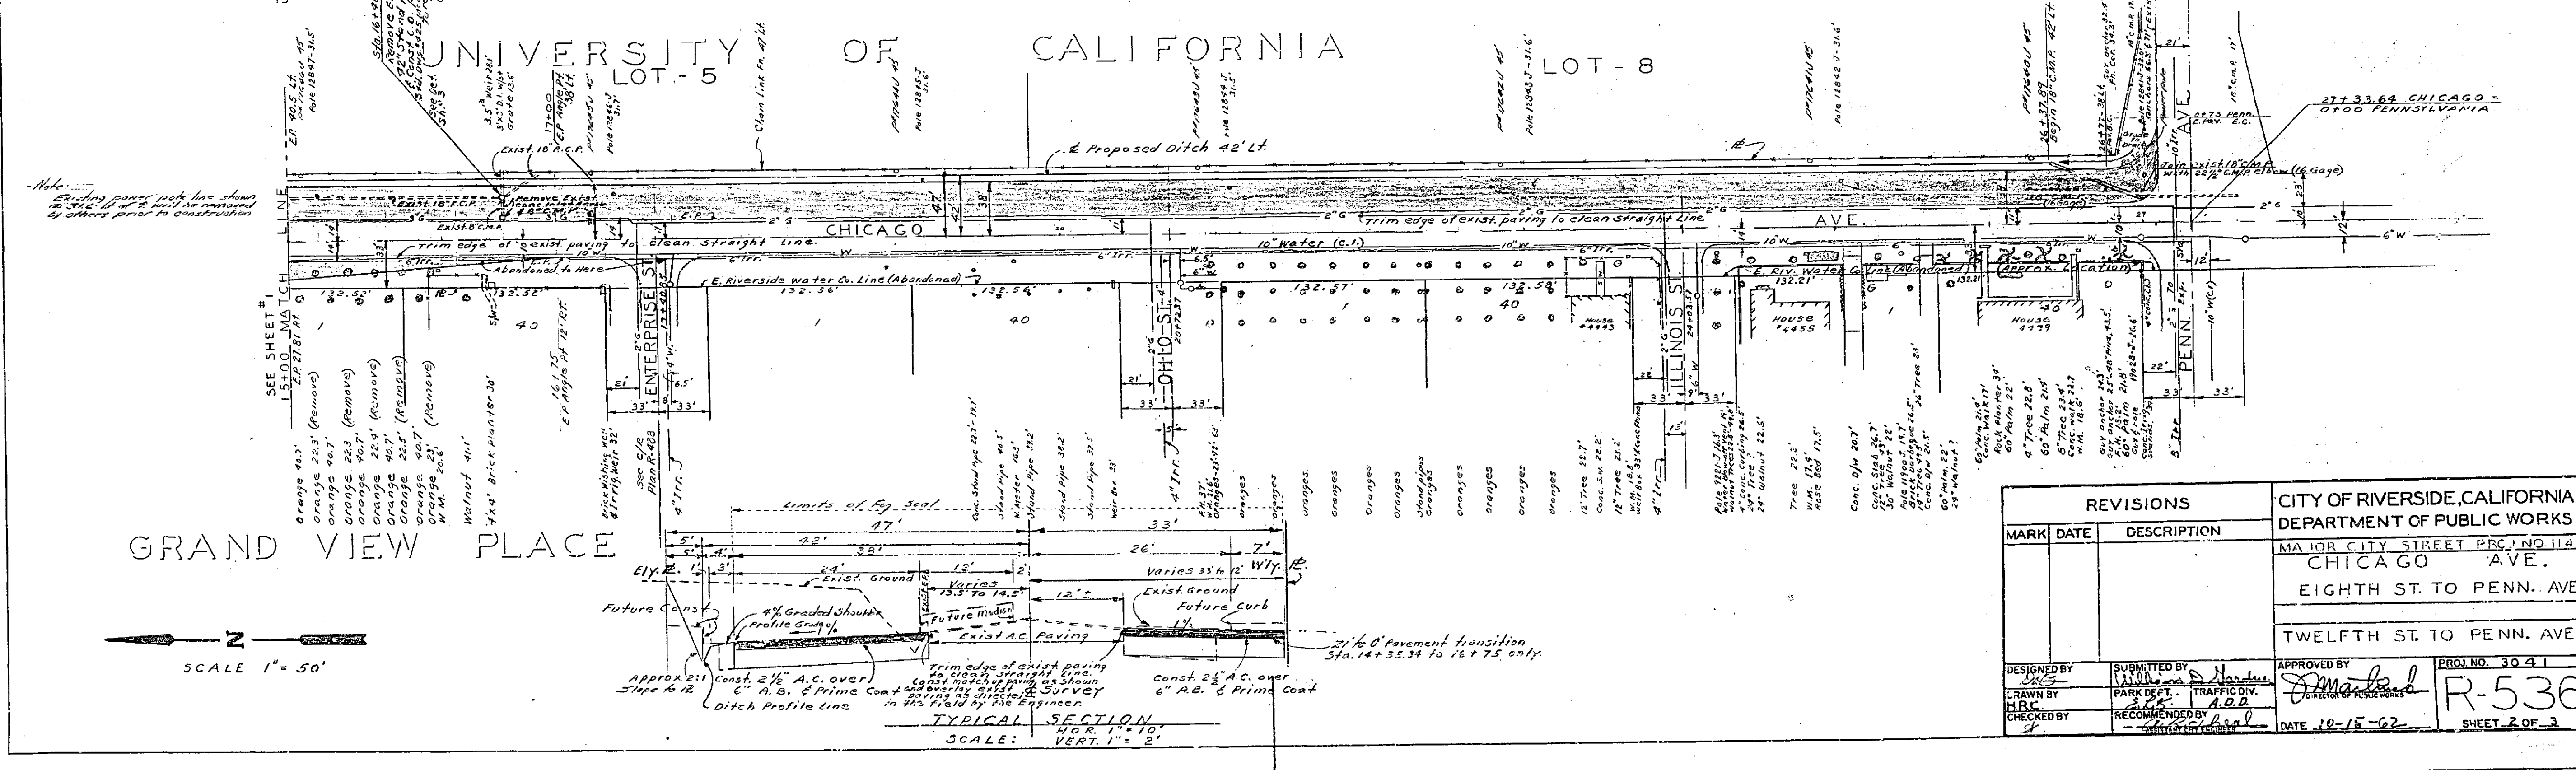

GRAND VIEW PLACE

SCALE 1"=50'

TYPICAL SECTION  

| REVISIONS   |                           |             | CITY OF RIVERSIDE, CALIFORNIA<br>DEPARTMENT OF PUBLIC WORKS  |              |
|-------------|---------------------------|-------------|--|--------------|
| MARK        | DATE                      | DESCRIPTION |  |              |
|             |                           |             | MAJOR CITY STREET PROJ. NO. 114<br>CHICAGO AVE.<br>EIGHTH ST. TO PENN. AVE.<br>TWELFTH ST. TO PENN. AVE. |              |
| DESIGNED BY | SUBMITTED BY              | APPROVED BY | PROJ. NO.  | 3041         |
| DRAWN BY    | PARK DEPT. - TRAFFIC DIV. | DATE        | R-536  | SHEET 2 OF 3 |
| CHECKED BY  | RECOMMENDED BY            | DATE        | 10-15-62   |              |

