

PROPERTY OF COUNTY OF RIVERSIDE Office of the Road Commissioner




PROPERTY OF COUNTY OF RIVERSIDE Office of the Road Commissioner

SIERRA FOOT HILLS TRACT No 1		
STREET GRADES		
REYNARD FOX AVENUE		
C.V. BROWN, JR.	AND	GORDON STEWART
CIVIL ENGINEERS		
DATE	SCALE	FILE NO.
APPROVED	1" = 40'	

R-555 L11-73-3
713 F

EUGENE DORTCHEN CO.

EUGENE DORTCHEN CO.

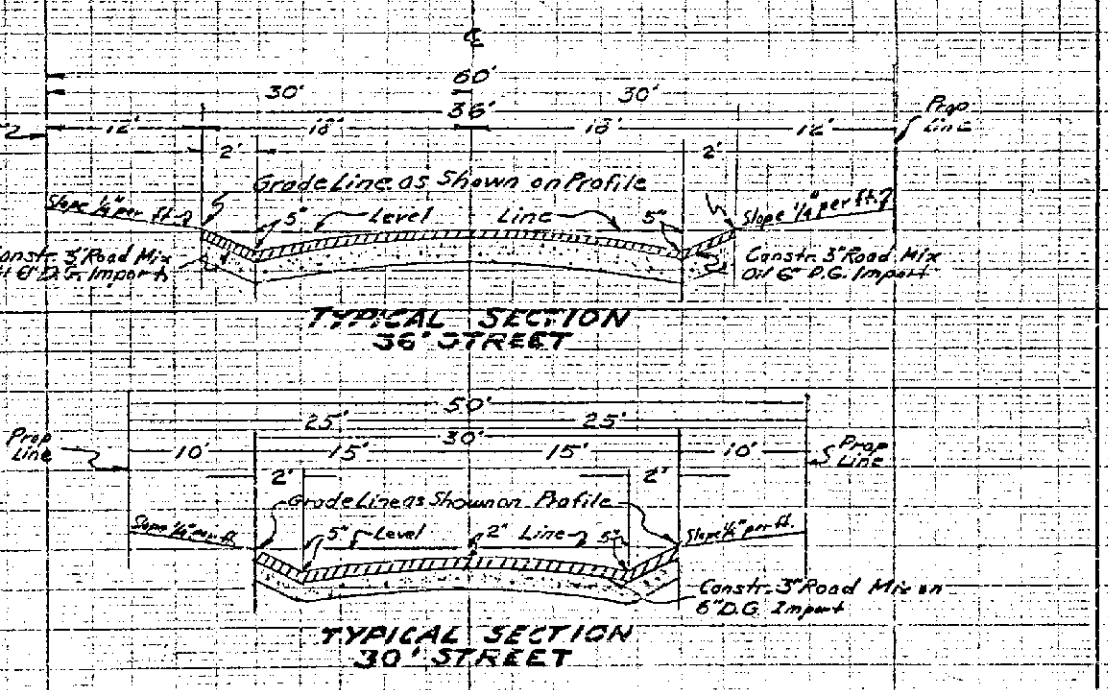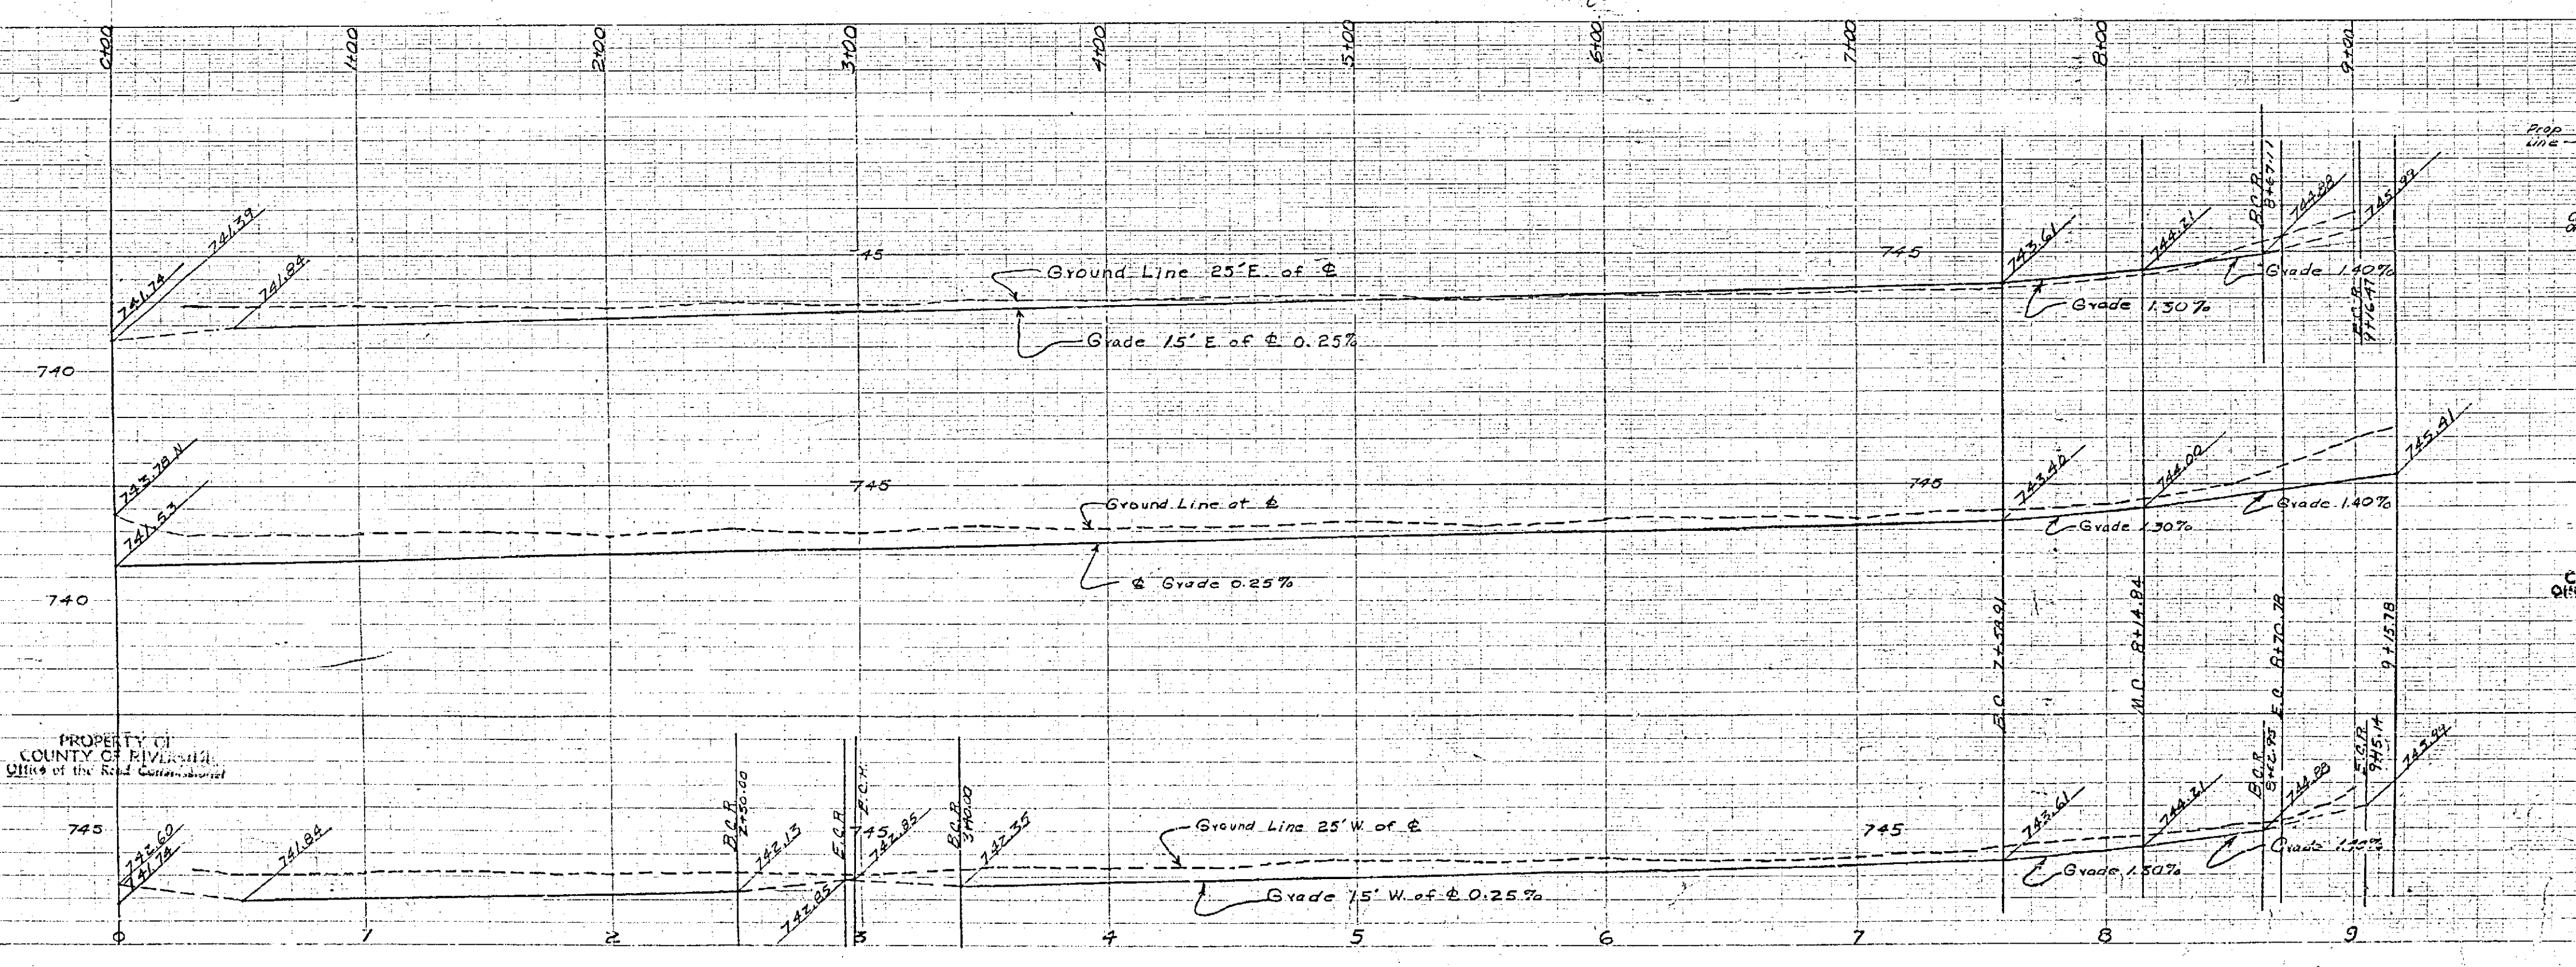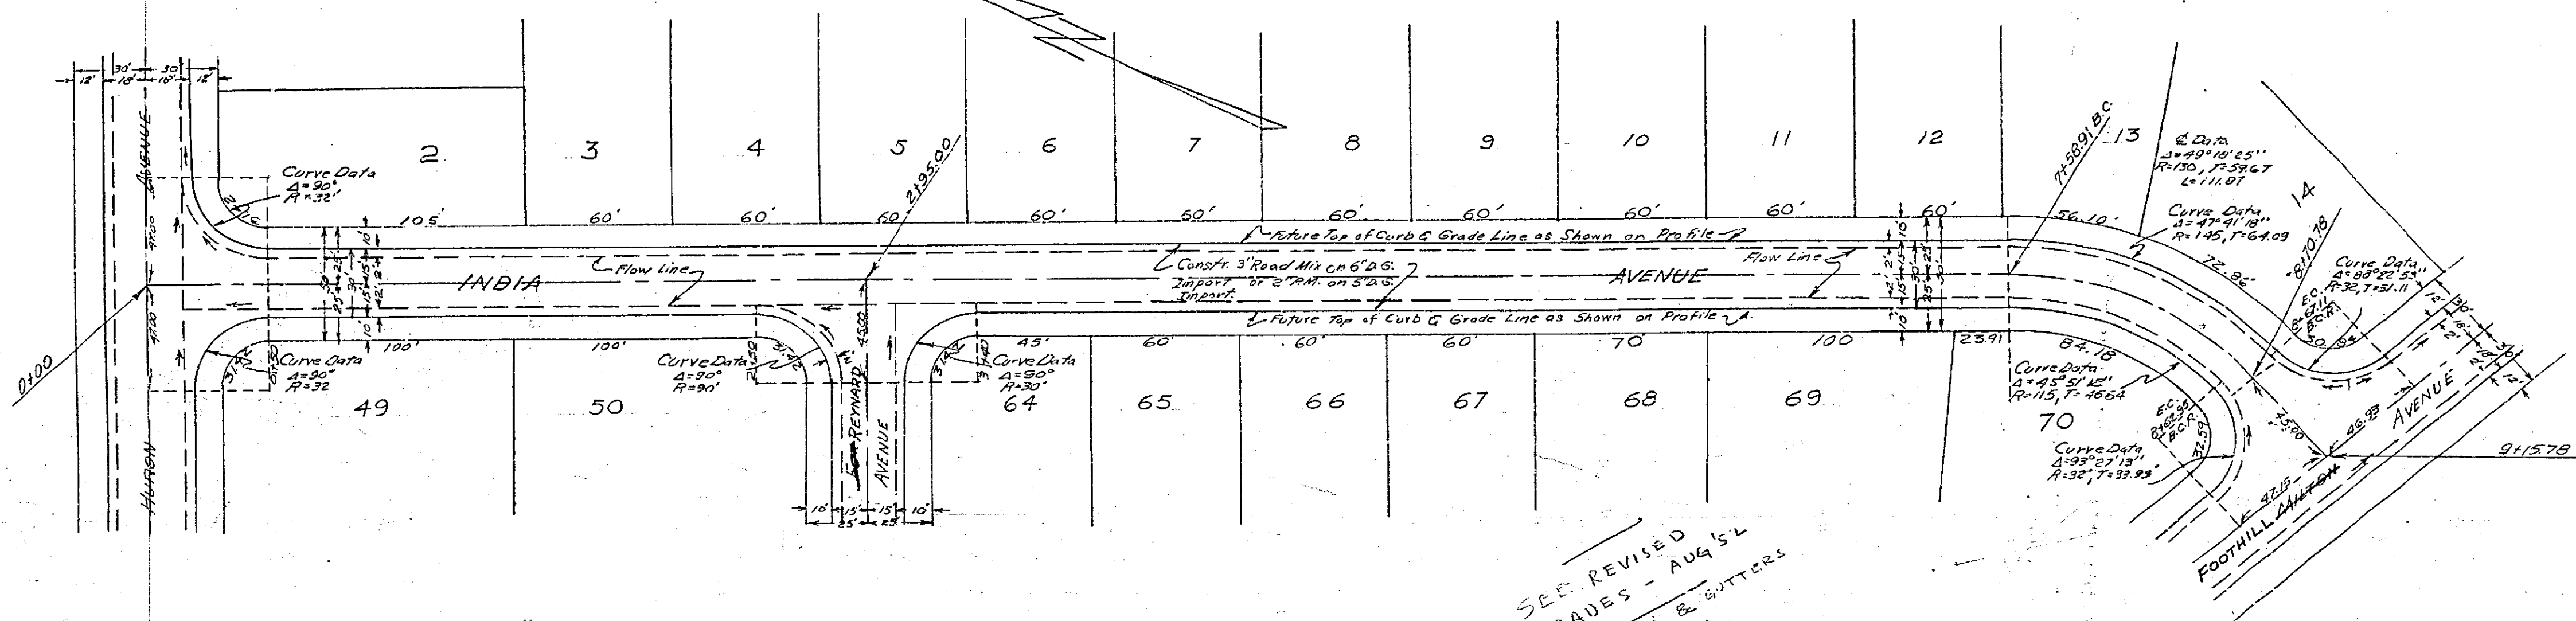

PROPERTY OF COUNTY OF RIVERSIDE, Office of the Road Commissioner

PROPERTY OF COUNTY OF RIVERSIDE, Office of the Road Commissioner

July 27, 1951 Approved *G.T. Worthy* Deputy COUNTY SURVEYOR

SIERRA FOOT HILLS TRACT No. 1
STREET GRADES
INDIA AVENUE

G.V. BROWN, JR. AND GORDON STEWART
CIVIL ENGINEERS

DATE _____ SCALE 1"=40' FILE R-555

APPROVED 713 F

E-A


PRINTED IN U.S.A.

PRINTED IN U.S.A.

PRINTED IN U.S.A.

L111-68-1

PRINTED IN U.S.A.

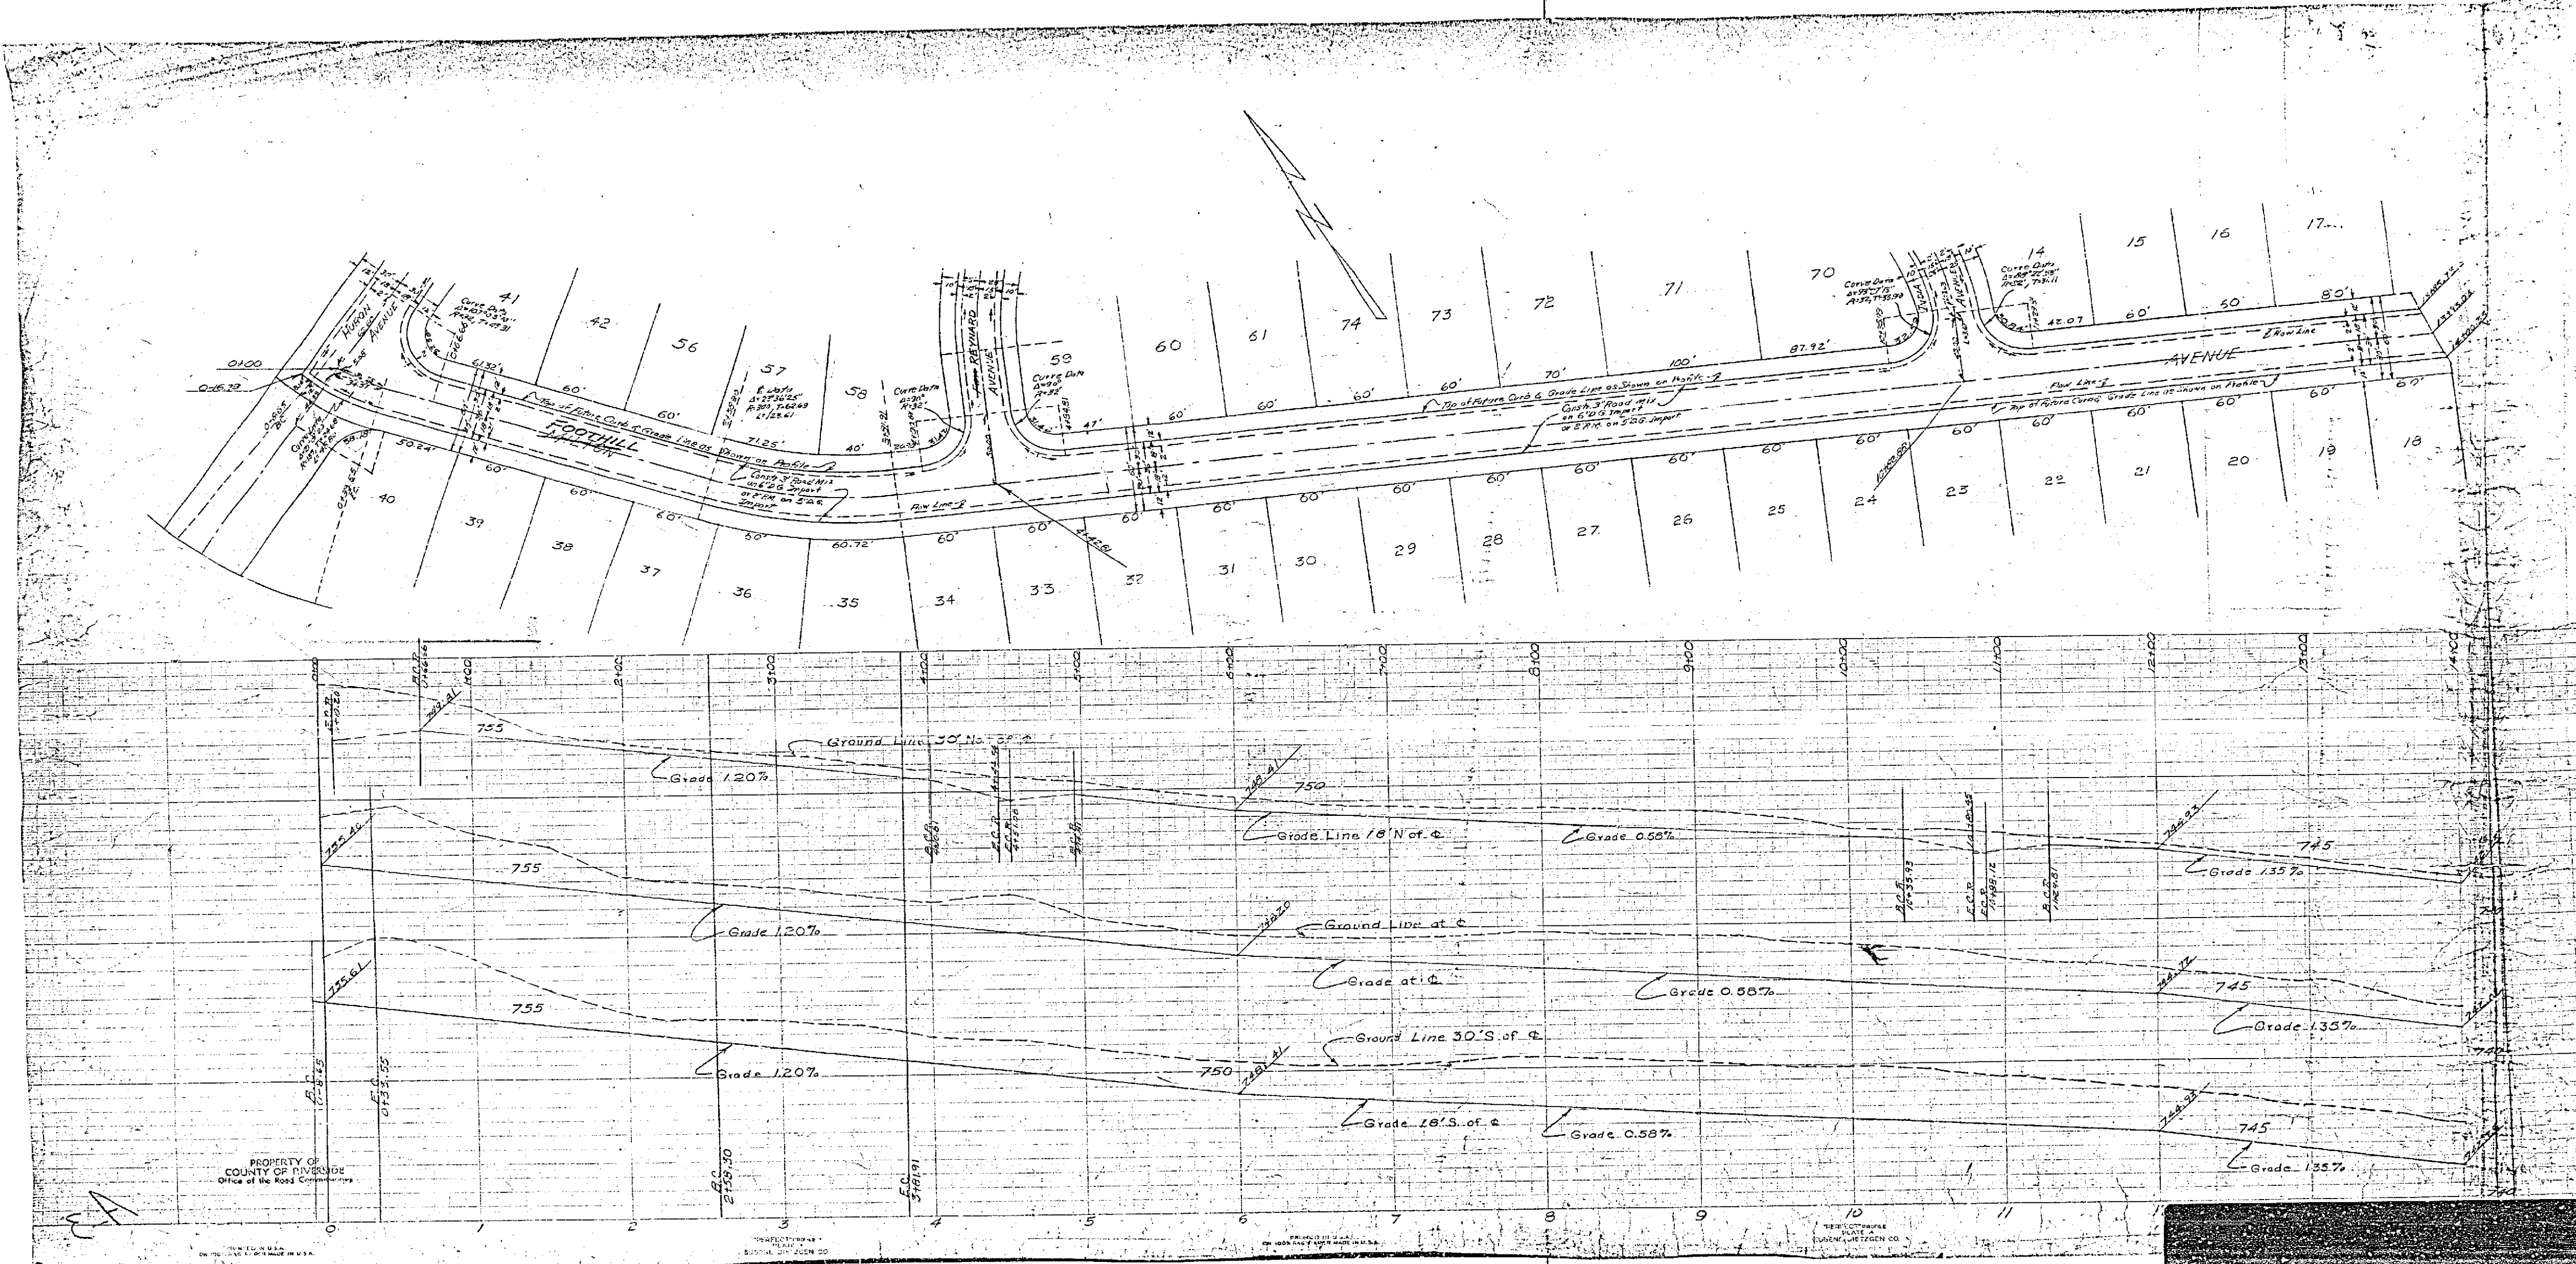


PROPERTY OF
COUNTY OF RIVERSIDE
Office of the Road Commissioner

PROPERTY OF
COUNTY OF RIVERSIDE
Office of the Road Commissioner

SIERRA FOOT-HILLS TRACT - No. 1			
STREET GRADES			
FOOTHILL MILTON AVENUE			
C. V. BROWN JR.		AND GORDON STEWART	
CIVIL ENGINEERS			
DATE	APPROVED	SCALE	FILE NO.
		1"=40'	

R-555 713-F

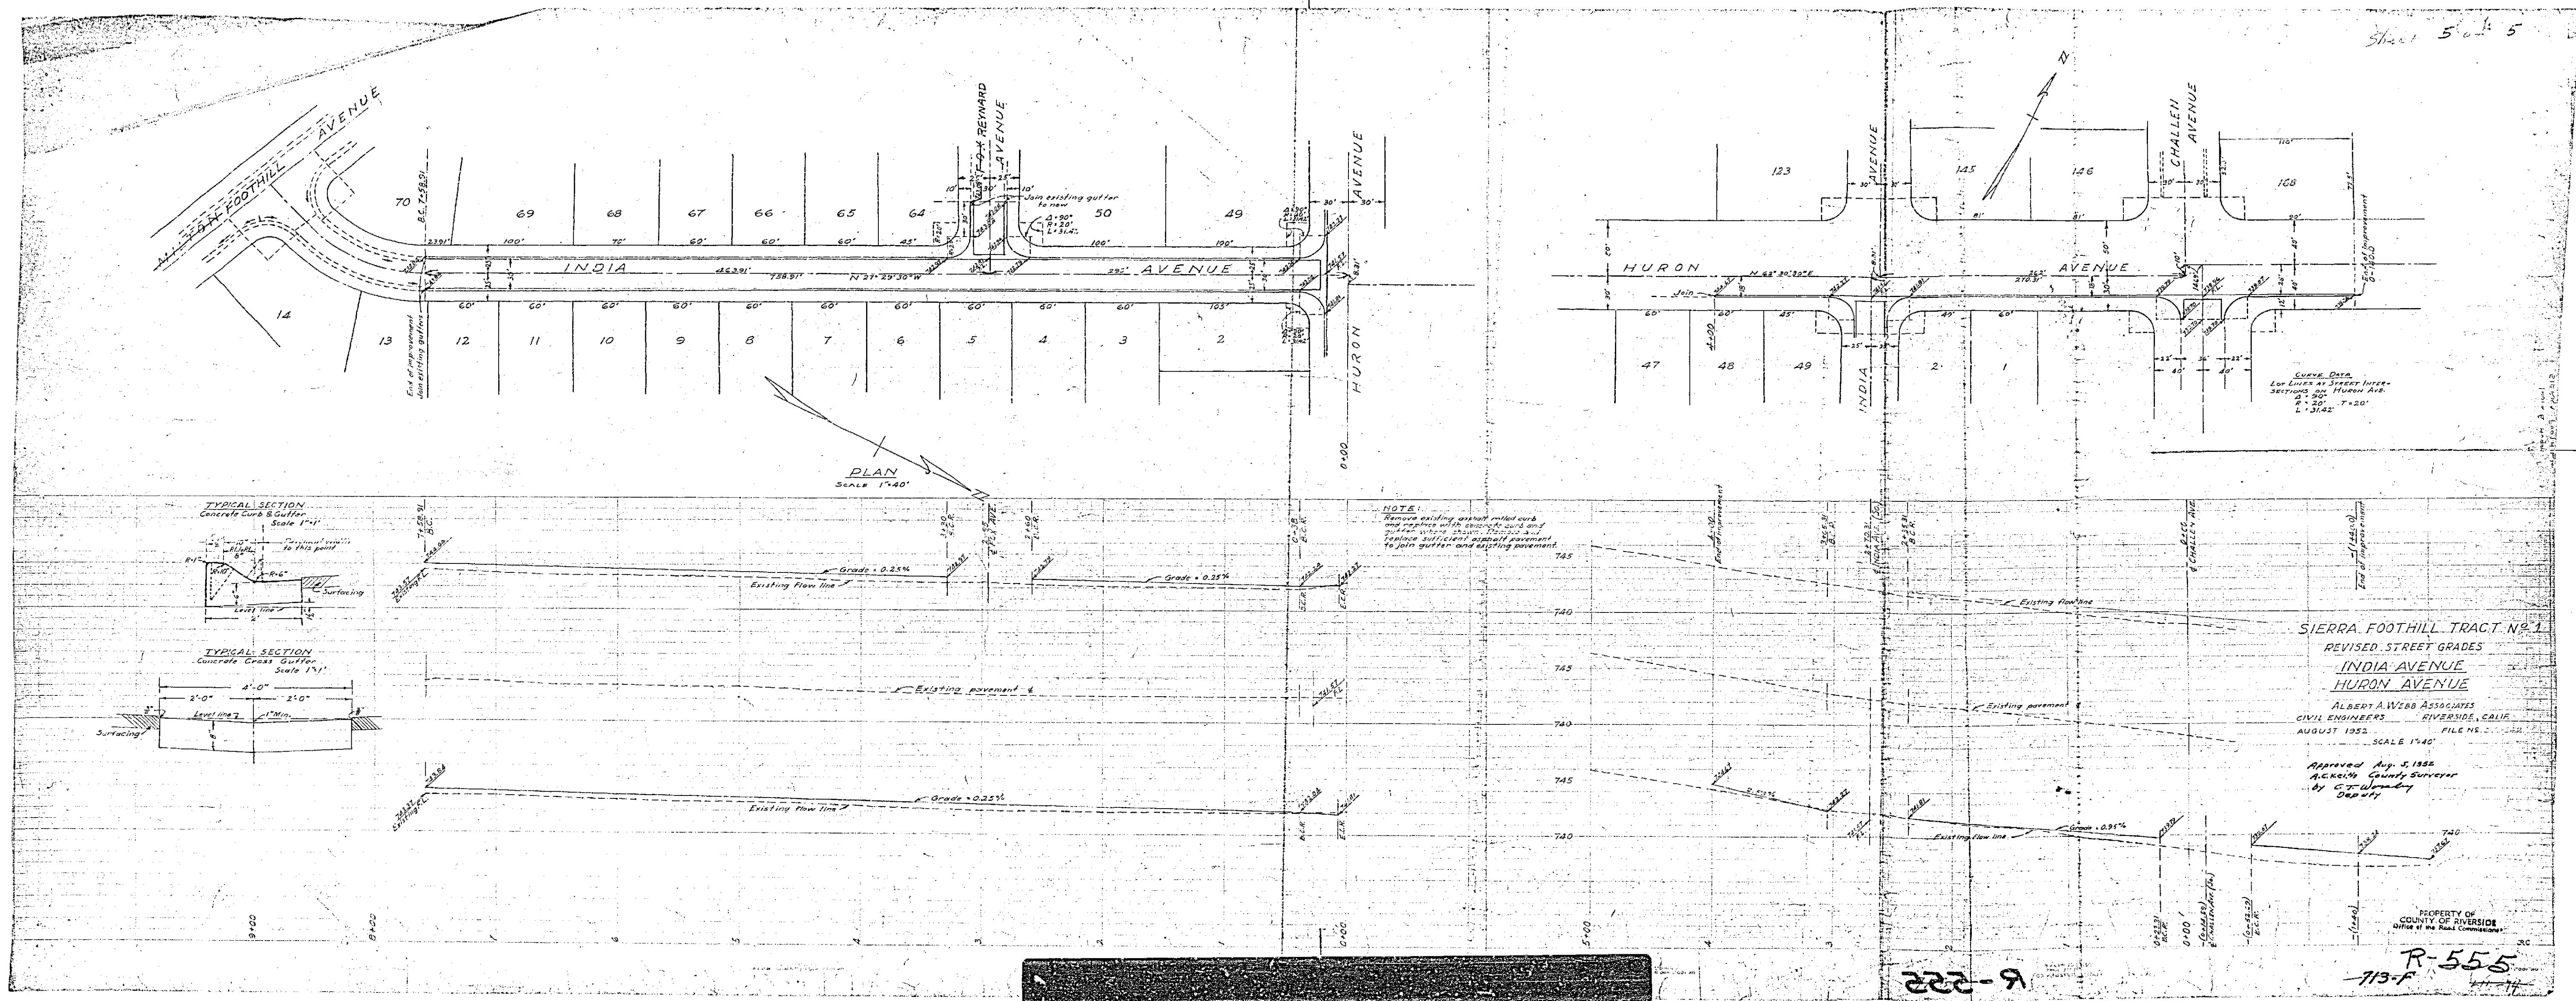

SIERRA FOOTHILL TRACT NO. 1
 REVISED STREET GRADES
 INDIA AVENUE
 HURON AVENUE
 CIVIL ENGINEERS RIVERSIDE, CALIF.
 SCALE 1"=40'
 Deputy

PROPERTY OF
 COUNTY OF RIVERSIDE
 R-555
 713-F


