


STREET NAME SIGN SCHEDULE		
A	COVER STREET	4700
	WIEHE AVENUE	6100

- NOTES**
1. Construction shall be in accordance with Standards and Specifications No. 400 of the City of Riverside Department of Public Works.
  2. Subdivider has the responsibility of clearing the Right of Way in accordance with the provisions of laws which affect each utility including irrigation lines and appurtenances, and at no extra cost to the City of Riverside.
  3. If the Subdivider desires to reduce requirement on import base material addition, soil tests may be taken at the Subdivider's expense after streets are prepared to rough grade. Subdivider will contact inspection division, City of Riverside before making test. The City of Riverside will make test of base material in place before paving can be installed. Results of this test must indicate that the base material is satisfactory to the inspection division.
  4. Prime Coat and Paint Binder required.

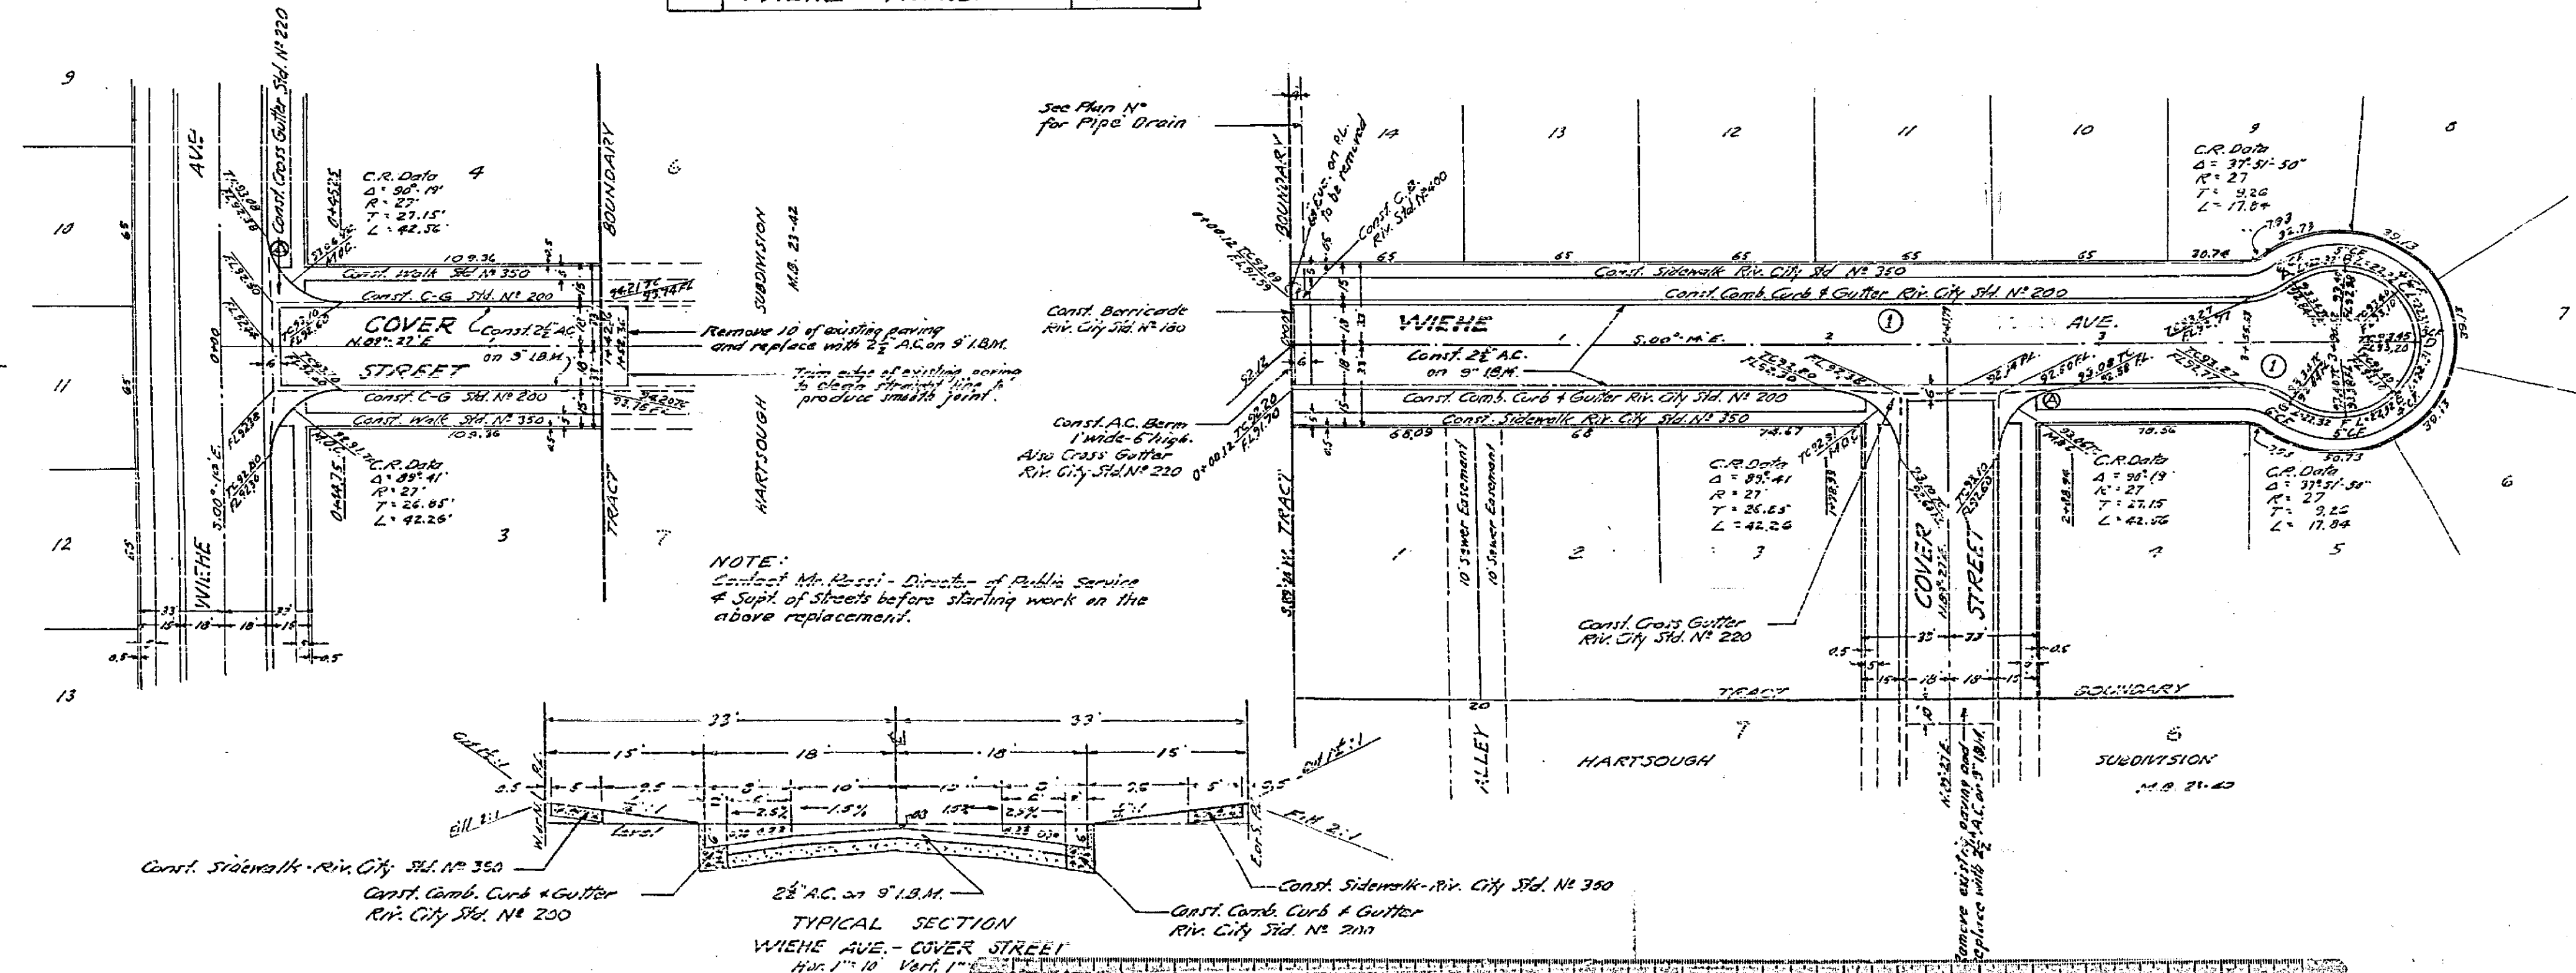

Curve Data  
 $\Delta = 235^\circ 43' 40''$   
 $R = 30'$   
 $L = 113.20'$

Variable CF - "A to G"  
 See Profile

Bench Mark: S.S.L. in South Curb, 15' City of Elly Property, Line of Palm Ave. at Intersection of Orange St. Elev. = 819.58		<b>J. F. DAVIDSON-CIVIL ENGINEER</b> R.E. NO. 862 RIVERSIDE, CALIFORNIA APPROVED BY: <i>J. F. Davidson</i> DATE 3/2/62	
<b>REVISIONS</b>		<b>CITY OF RIVERSIDE, CALIFORNIA</b> <b>DEPARTMENT OF PUBLIC WORKS</b>	
MARK DATE ① 7-6-62	DESCRIPTION CHANGE P.C. & C.L. ON PLAN AND PROFILE TO AGREE WITH FIELD CONNECTION	<b>STREET PLAN &amp; PROFILE</b> <b>WIEHE AVE. - COVER ST.</b> <b>TRACT No 2316</b> HORIZ. SCALE 1" = 40' VERT. SCALE 1" = 4'	
DESIGNED BY DRAWN BY RECOMMENDED BY	CHECKED BY T. J. J. 1-1-62	APPROVED BY <i>ad</i>	NO. <b>R-595</b> DATE 5-9-62 SHEET 1 OF 1 18.600 2178