
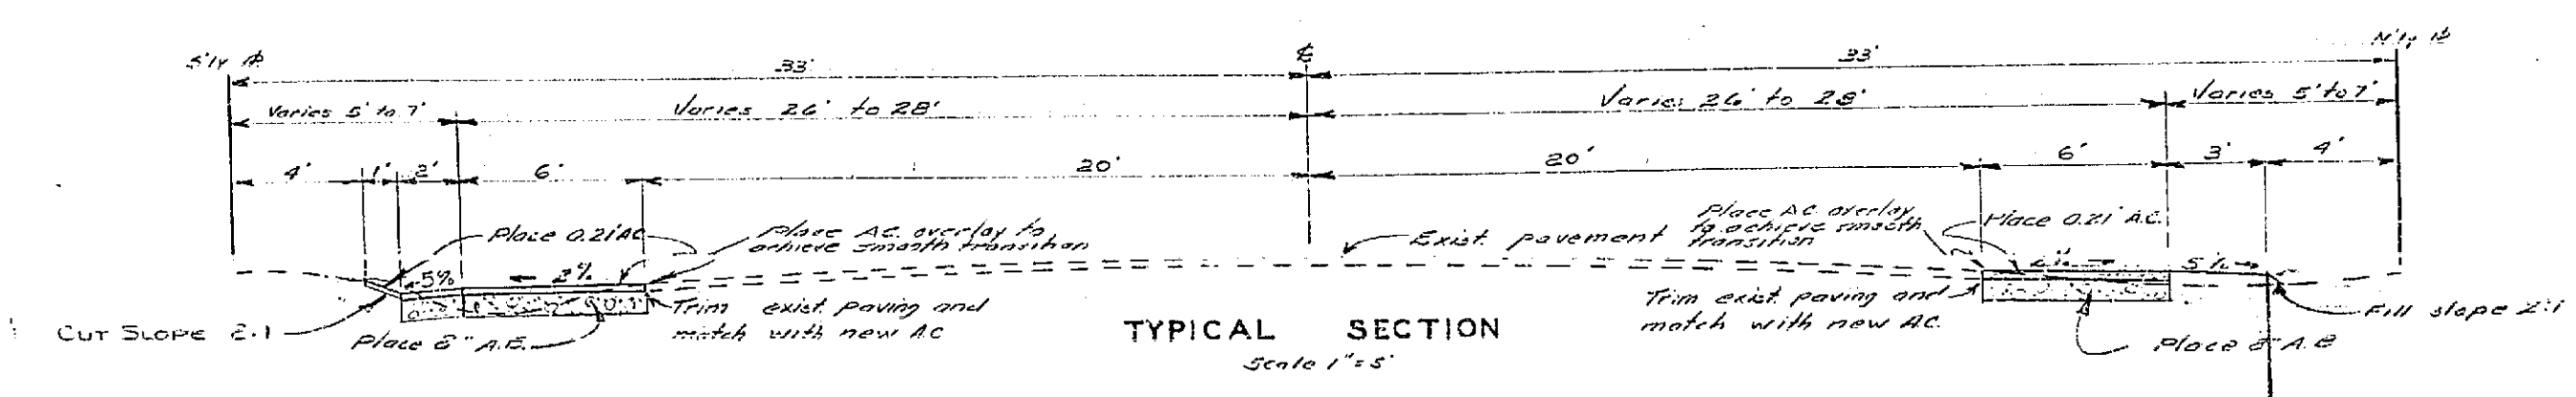


B.M. ELEV. 970.229 - S&L IN COR.  
CONC. WALL N.W. COR. CHICAGO  
& PENN. AVE.  
F.B. P-4/1-11  
SCALE HOR. 1"=50'  
VERT. 1"=5'

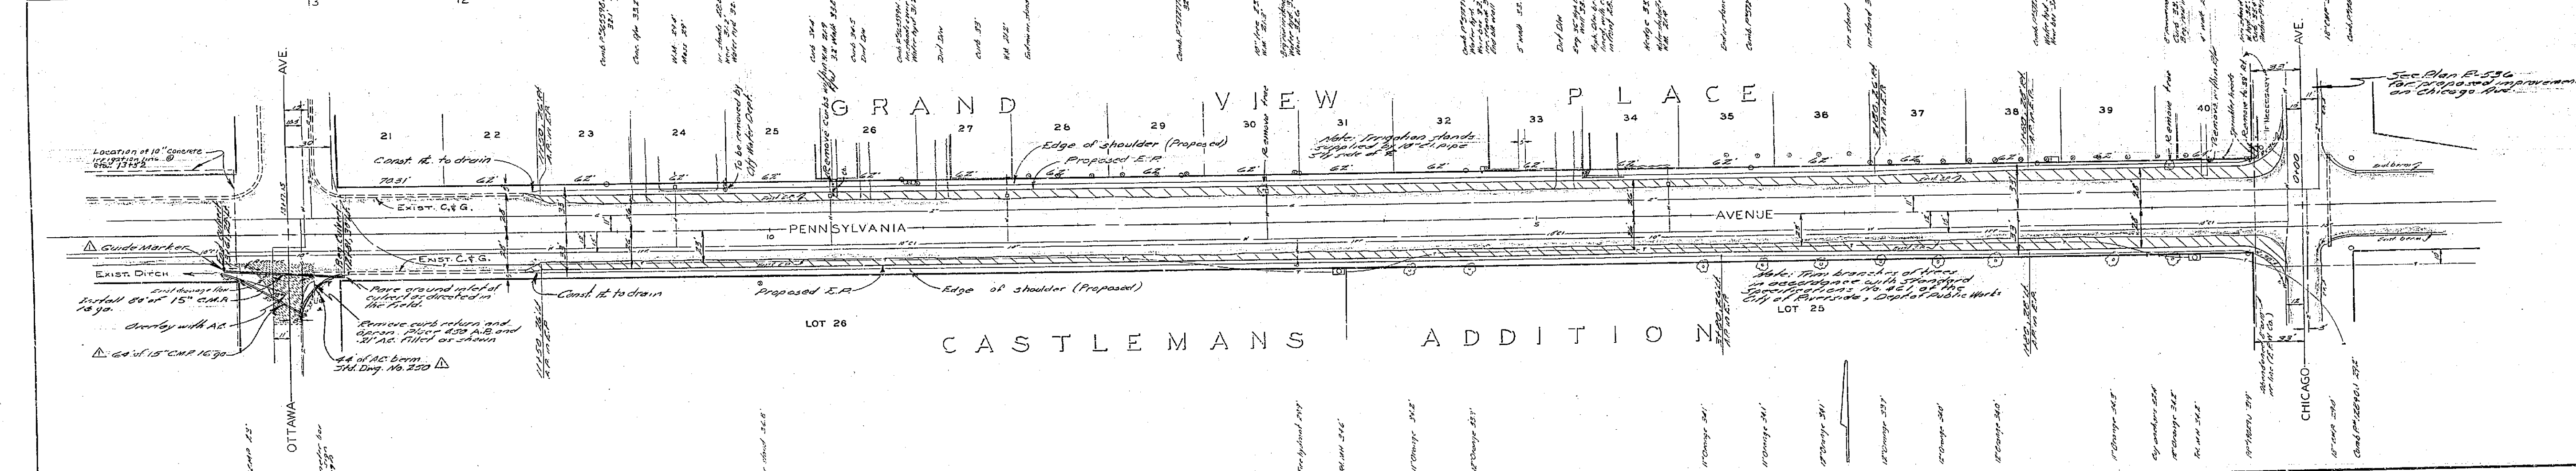

NOTE:  
1. WATER METERS AND BOXES TO BE RELOCATED BY WATER DEPT., CITY OF RIVERSIDE.  
2. RELOCATE ROAD SIGNS AND MAIL BOXES AS DIRECTED BY ENGINEER.

SCALE 1"=50'

REVISIONS			CITY OF RIVERSIDE, CALIFORNIA DEPARTMENT OF PUBLIC WORKS	
MARK	DATE	DESCRIPTION		
Δ	11/27/63	Added 15" CURB Change Order No. 2	PENNSYLVANIA AVENUE WIDENING CHICAGO AVE. TO OTTAWA AVE.	
DESIGNED BY	SUBMITTED BY	APPROVED BY	PROJ. NO.	3052
DRAWN BY	PARK DEPT.	TRAFFIC DIV.	R-659	
CHECKED BY	RECOMMENDED BY	DATE	5-20-63	SHEET 1 OF 1

PROFILE	DATE

PLAN	DATE