
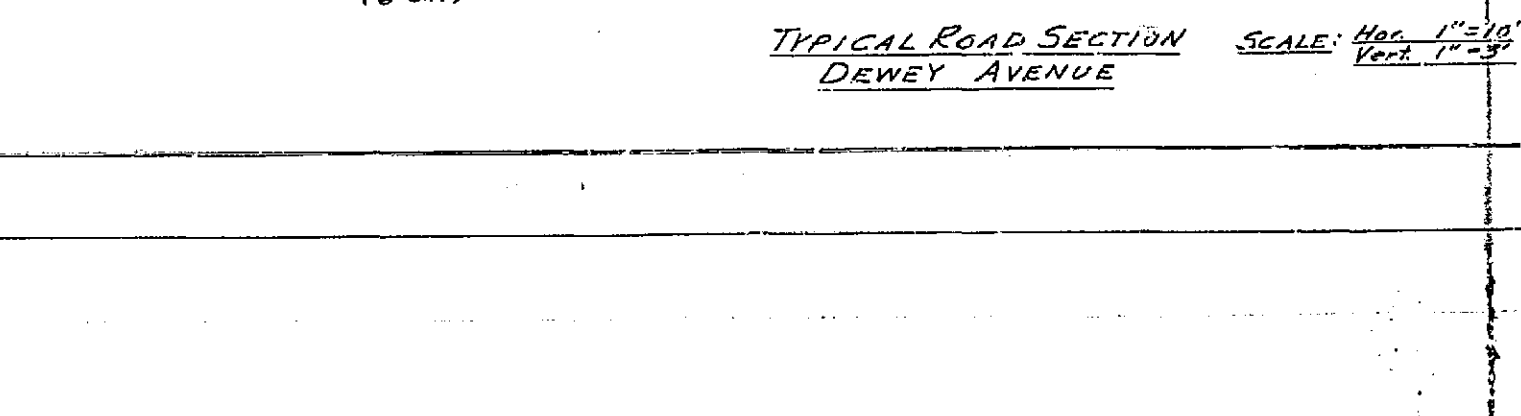
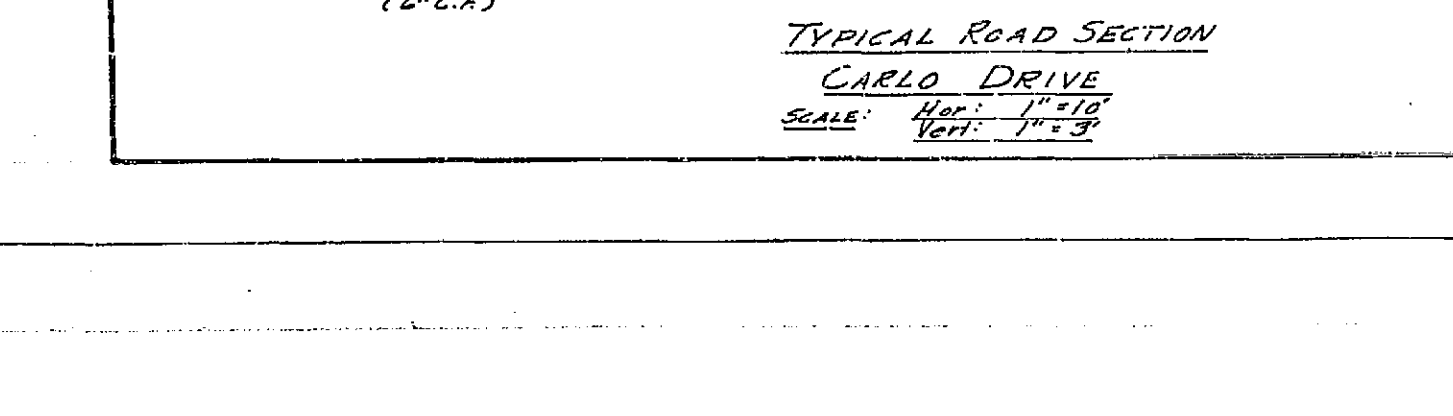


- GENERAL NOTES**
- ALL WORK SHALL CONFORM TO SPECIFICATIONS NO. 461 AND APPLICABLE STANDARD DRAWINGS OF THE CITY OF RIVERSIDE.
 - THE CITY OF RIVERSIDE WILL TAKE A SOIL TEST TO DETERMINE THE REQUIREMENT ON BASE MATERIAL AFTER THE STREETS HAVE BEEN PREPARED TO ROUGH GRADE.
 - TRIM EDGE OF EXISTING PAVING TO CLEAN, STRAIGHT LINE. CONSTRUCT MATCH-UP PAVING AS SHOWN, AND OVERLAY EXISTING PAVING AS DIRECTED IN THE FIELD TO PRODUCE A SMOOTH CROWN SECTION.
 - IT SHALL BE THE RESPONSIBILITY OF THE CONTRACTOR TO CLEAR THE RIGHT-OF-WAY IN ACCORDANCE WITH PROVISION OF THE LAW AS IT APPLIES TO EACH UTILITY INCLUDING IRRIGATION LINES AND APPURTENANCES AND AT NO COST TO THE CITY.
 - CONSTRUCTION IN THE VICINITY OF THE IRRIGATION DIVISION, CITY OF RIVERSIDE, PIPELINE SHALL BE DONE TO MEET THE REQUIREMENTS OF THE IRRIGATION DIVISION AND THE DEPARTMENT OF PUBLIC WORKS OF THE CITY. IT SHALL BE UNDERSTOOD THAT THE IRRIGATION DIVISION SHALL HAVE THE OPPORTUNITY OF TESTING THE LINE AFTER GRADING AND INSTALLATION OF BASE COURSE AND PRIOR TO THE LAYING OF ANY A.C. THE COST OF REPAIRS TO THE PIPELINE CAUSED BY DAMAGE DURING CONSTRUCTION SHALL BE BORNE BY THE CONTRACTOR.
 - PRIME COAT AND PAINT BINDER ARE REQUIRED.

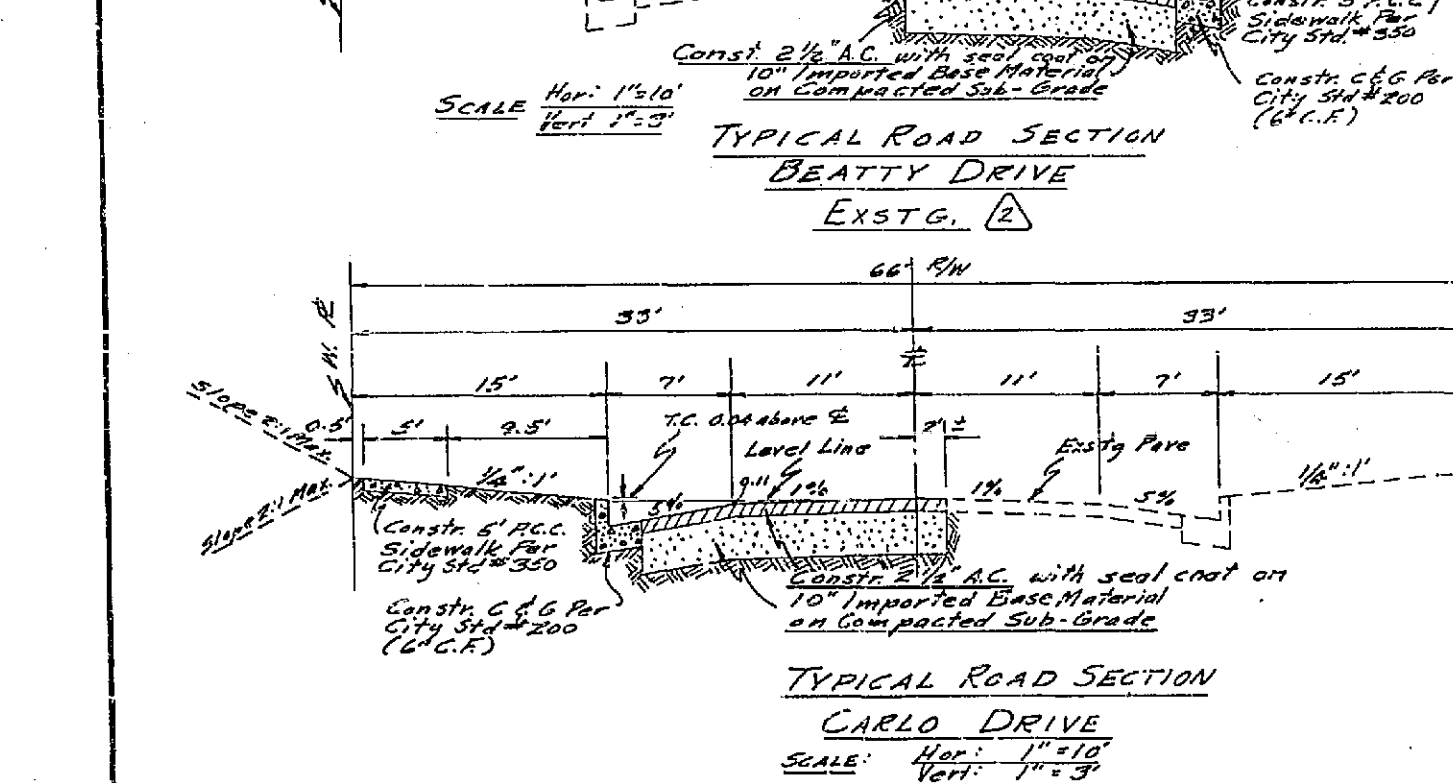

PARK & RECREATION DEPT
APPROVED: [Signature] DATE: 5-11-63
IRRIGATION DIVISION
APPROVED: [Signature] DATE: 5-11-63

HUGH M. GALLAHER
CIVIL ENGINEER
RIVERSIDE, CALIFORNIA
APPROVED BY: [Signature] DATE: 5/11/63

REVISIONS

MARK	DATE	DESCRIPTION
1	6/10/64	Change from 10' to 12' depth of concrete
2	6/10/64	Change from 10' to 12' depth of concrete

CITY OF RIVERSIDE CALIFORNIA
DEPARTMENT OF PUBLIC WORKS

STREET PLAN & PROFILE
CARLO DRIVE
DEWEY AVE. & BEATTY DR.
TRACT 3054

DESIGNED BY: [Signature] CHECKED BY: [Signature] APPROVED BY: [Signature]
DRAWN BY: [Signature] RECOMMENDED BY: [Signature] ASSISTANT CITY ENGINEER
DATE: 5-10-63

R-665
SHEET 1 OF 1

Res 72-10