



SCALE  
 1" = 50' HOR.  
 1" = 5' VERT.

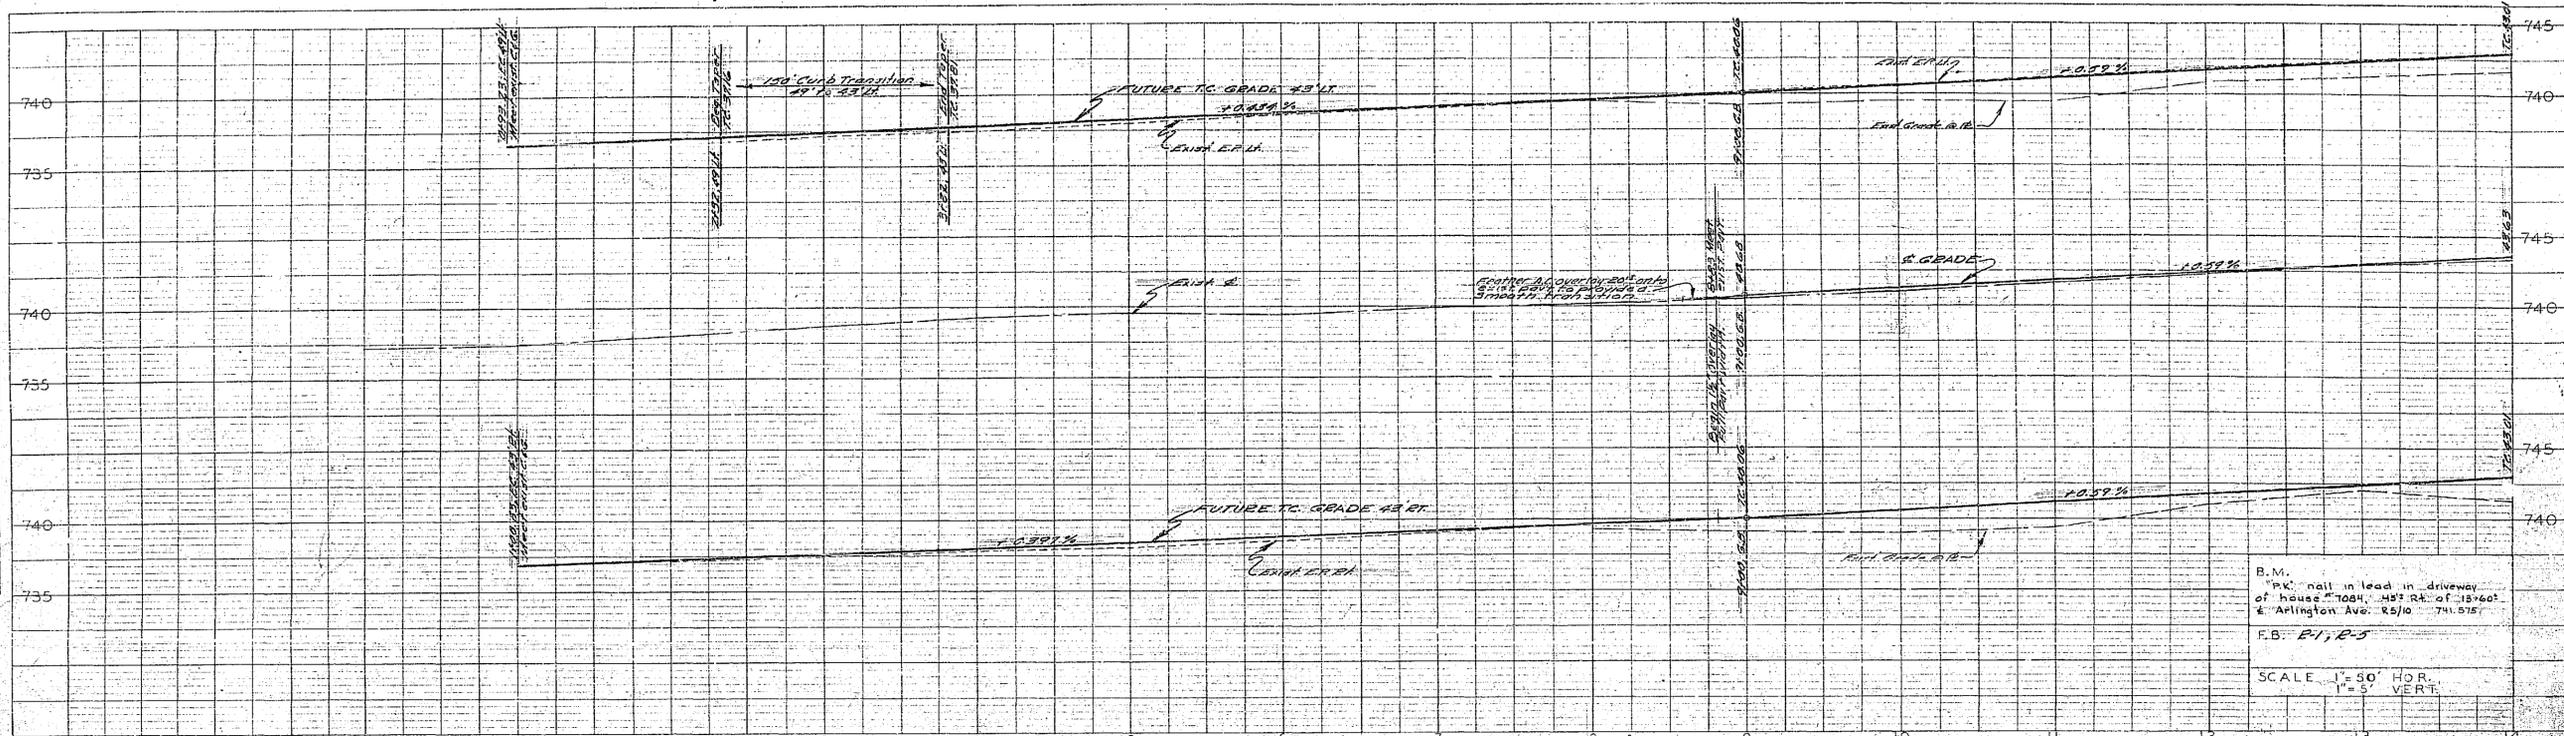

B.M. "PK" nail in lead in driveway of house 1084, 453' Rt. of 15+60.1  
 at Arlington Ave. R.S./O 741.575'  
 F.B. R-1, R-5  
 SCALE 1" = 50' HOR.  
 1" = 5' VERT.

SCALE N 1" = 50'

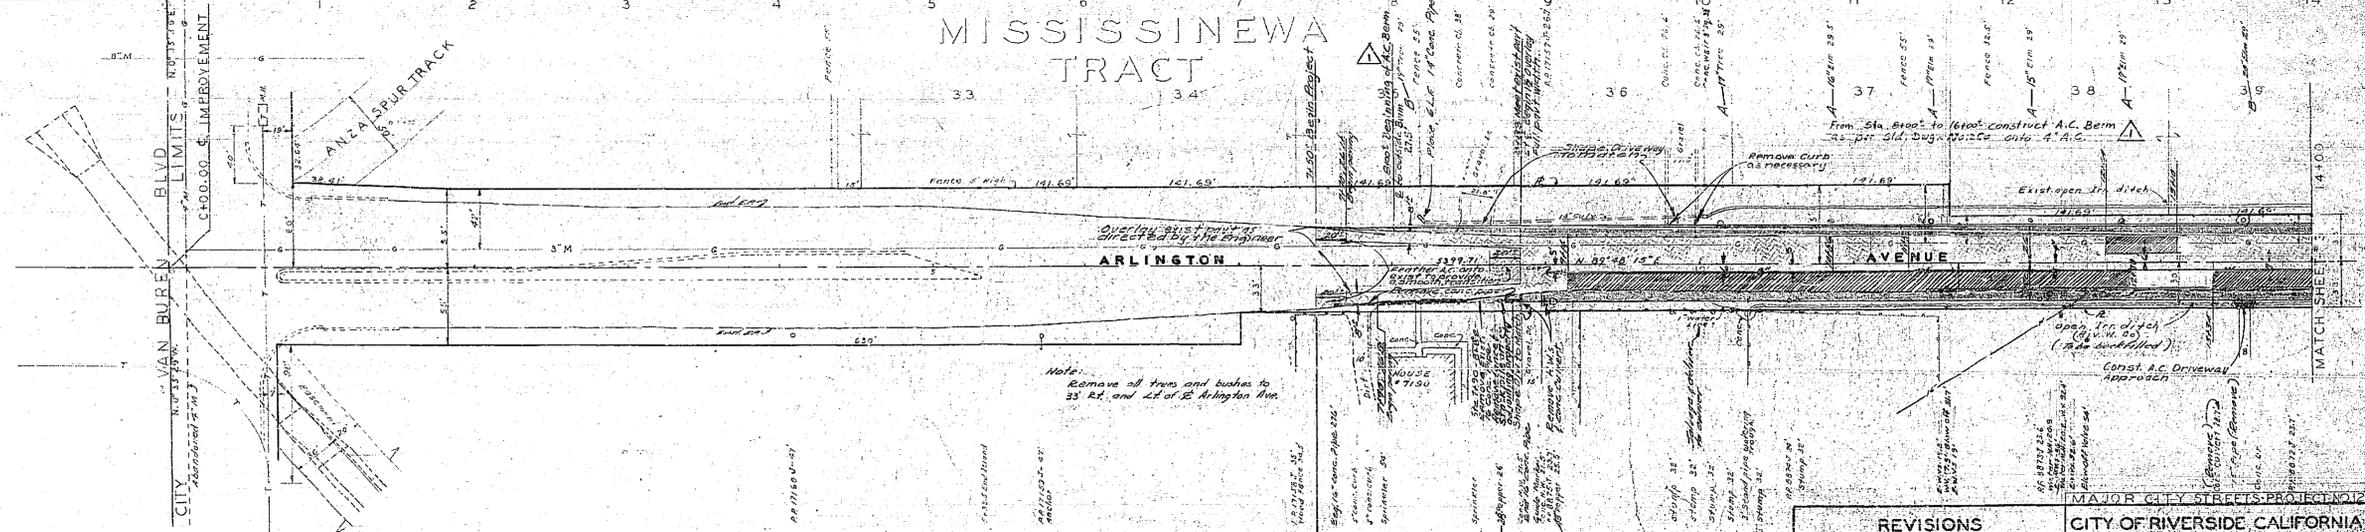

RIVERSIDE LAND AND IRRIGATING CO. BLOCK-1

Indicates portions of existing pavement to be removed and replaced.  
 Indicates new paving to be placed within street widening.  
 Indicates exist. pavement to be overlaid.

REVISIONS			CITY OF RIVERSIDE CALIFORNIA DEPARTMENT OF PUBLIC WORKS
MARK	DATE	DESCRIPTION	

DESIGNED BY: H.C.  
 DRAWN BY: H.C.  
 CHECKED BY: [Signature]  
 APPROVED BY: [Signature]  
 DIRECTOR OF PUBLIC WORKS  
 ASSISTANT CITY ENGINEER: DATE 12-5-63  
 ACCT. NO. 3005  
**R-707**  
 SHEET 2 OF 2








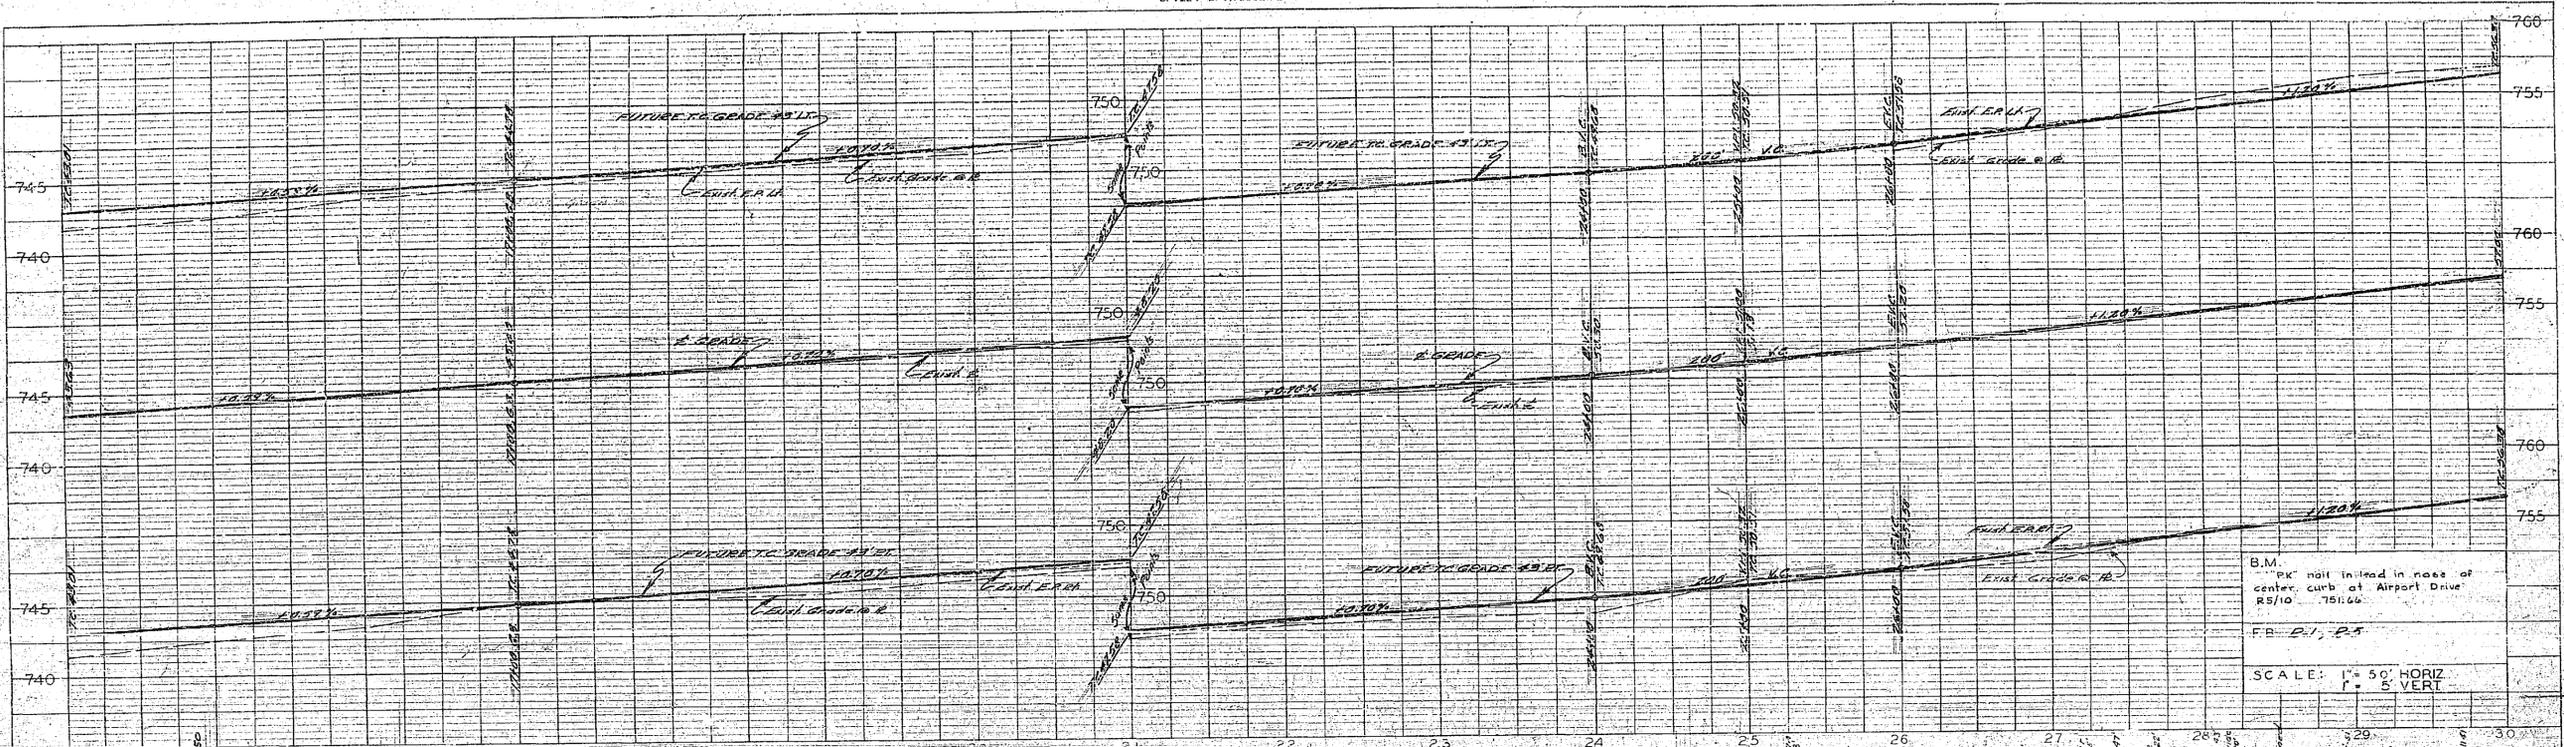

B.M. "PK" nail in head in nose of center curb at Airport Drive  
 RS/10 - 751.66  
 F.R. P.I. - P.5  
 SCALE: 1" = 50' HORIZ  
 1" = 5' VERT

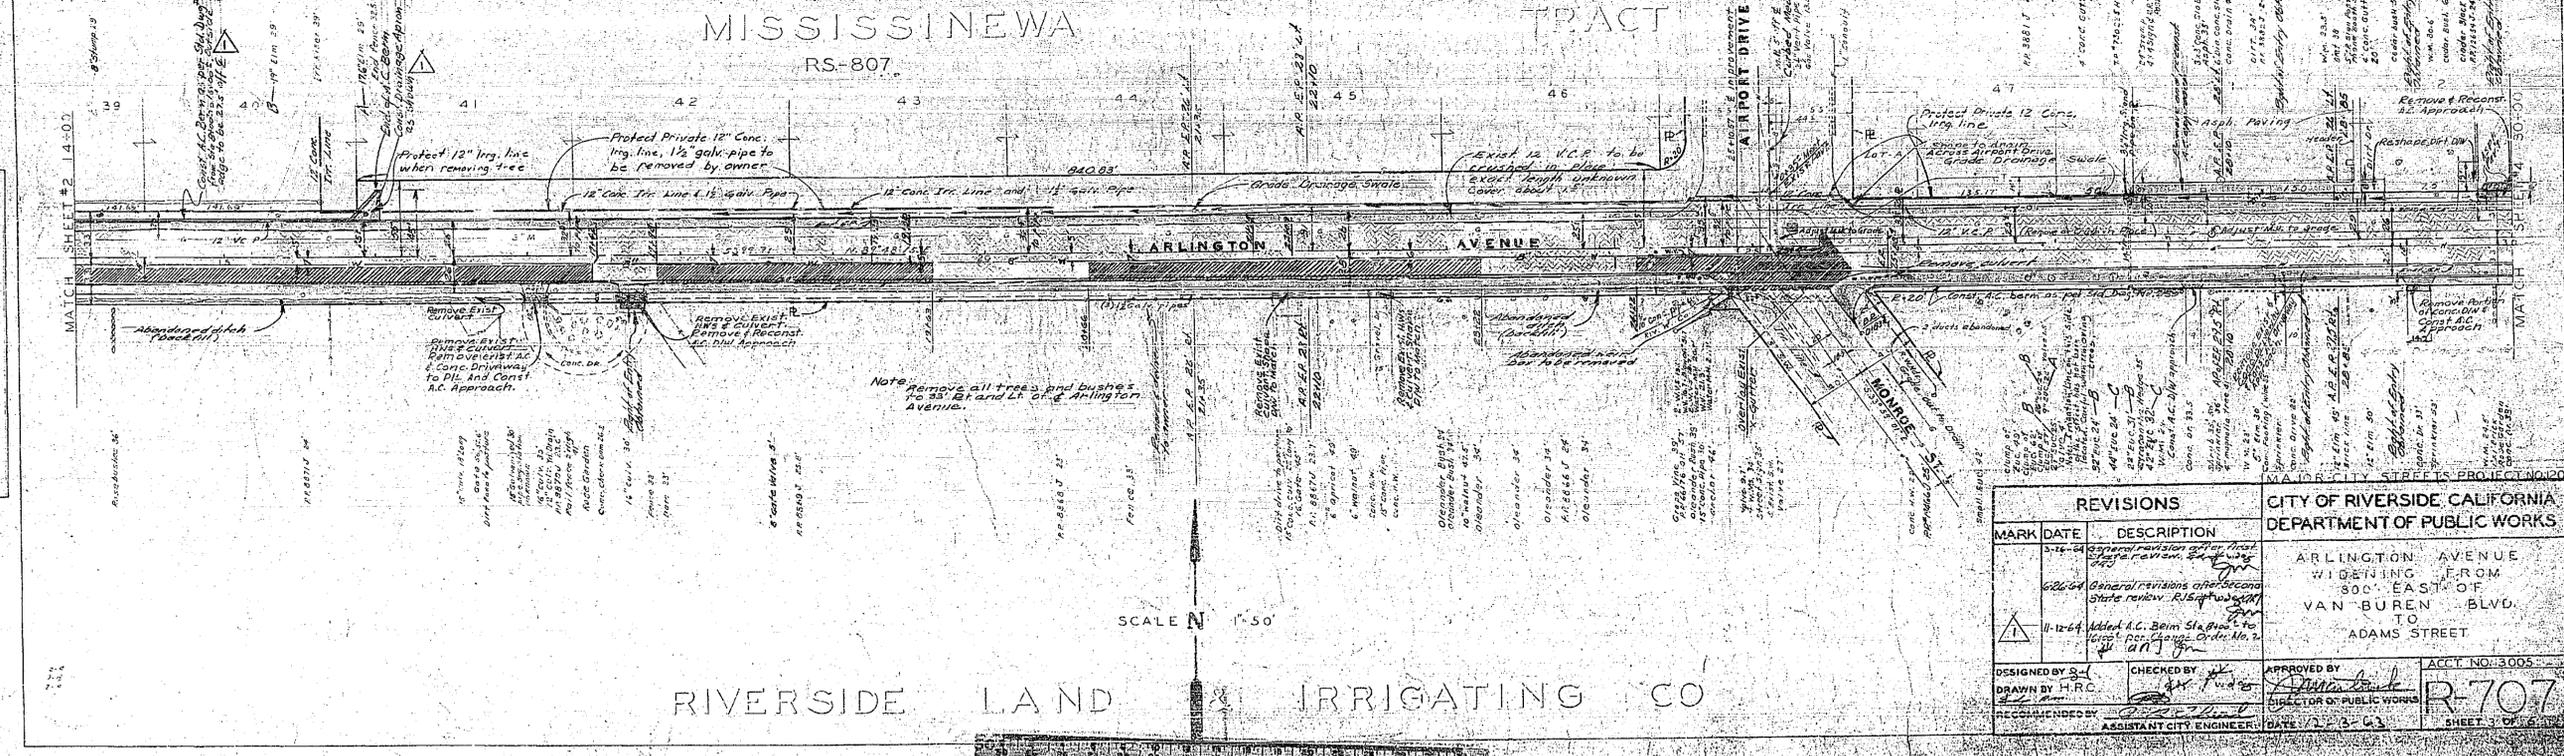

REVISIONS		CITY OF RIVERSIDE, CALIFORNIA DEPARTMENT OF PUBLIC WORKS
MARK	DATE	
1	11-12-64	ARLINGTON AVENUE WIDENING FROM 500' EAST OF VAN BUREN BLVD. TO ADAMS STREET
2	11-12-64	


DESIGNED BY H.R.C. CHECKED BY [Signature] APPROVED BY [Signature] ACCT. NO. 3005  
 RECOMMENDED BY [Signature] ASSISTANT CITY ENGINEER DATE 12-2-64 SHEET 3 OF 6

RIVERSIDE LAND & IRRIGATING CO




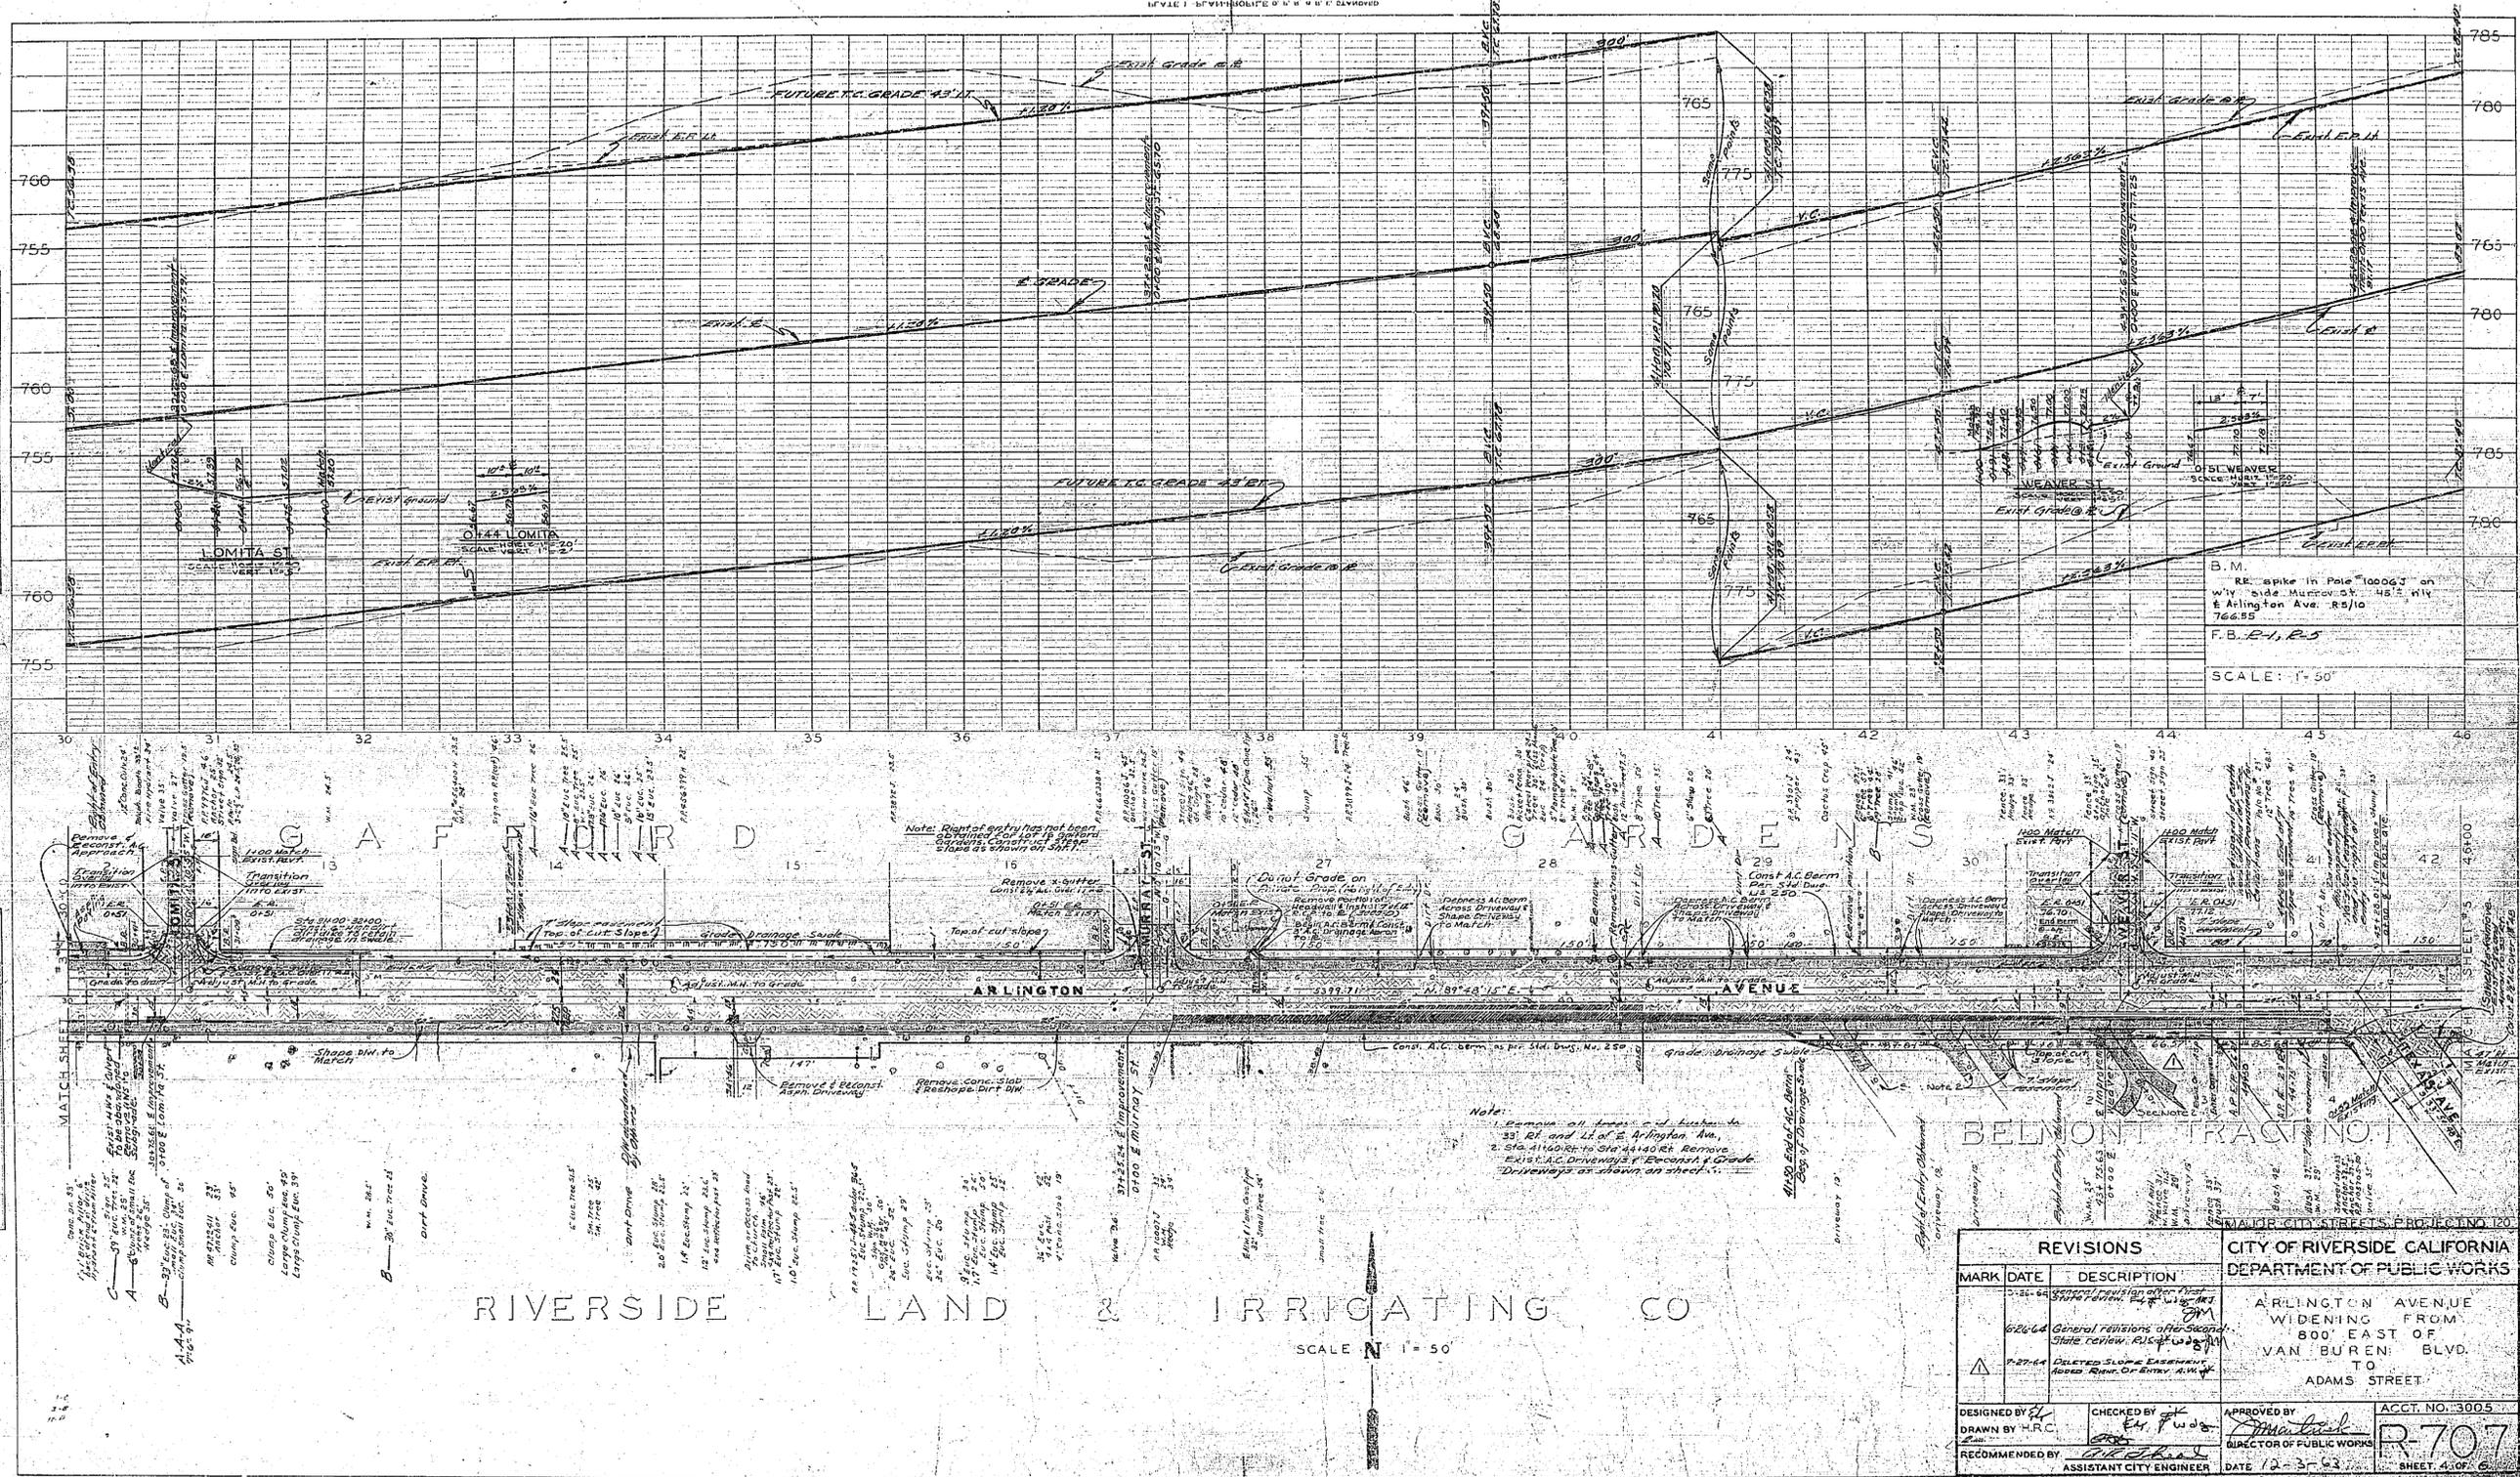RIVERSIDE LAND & IRRIGATING CO

SCALE 1" = 50'

REVISIONS		CITY OF RIVERSIDE CALIFORNIA DEPARTMENT OF PUBLIC WORKS
MARK	DATE	
		ARLINGTON AVENUE WIDENING FROM 800' EAST OF VAN BUREN BLVD. TO ADAMS STREET



DESIGNED BY H.R.C.	CHECKED BY E.A. P.W.	APPROVED BY M. J. ...	ACCT. NO. 3005
RECOMMENDED BY 	ASSISTANT CITY ENGINEER	DIRECTOR OF PUBLIC WORKS	R-707

**PROJECT**

ARLINGTON AVENUE  
 WIDENING FROM  
 800' EAST OF  
 VAN BUREN BLVD  
 TO  
 ADAMS STREET

**REVISIONS**

MARK DATE DESCRIPTION

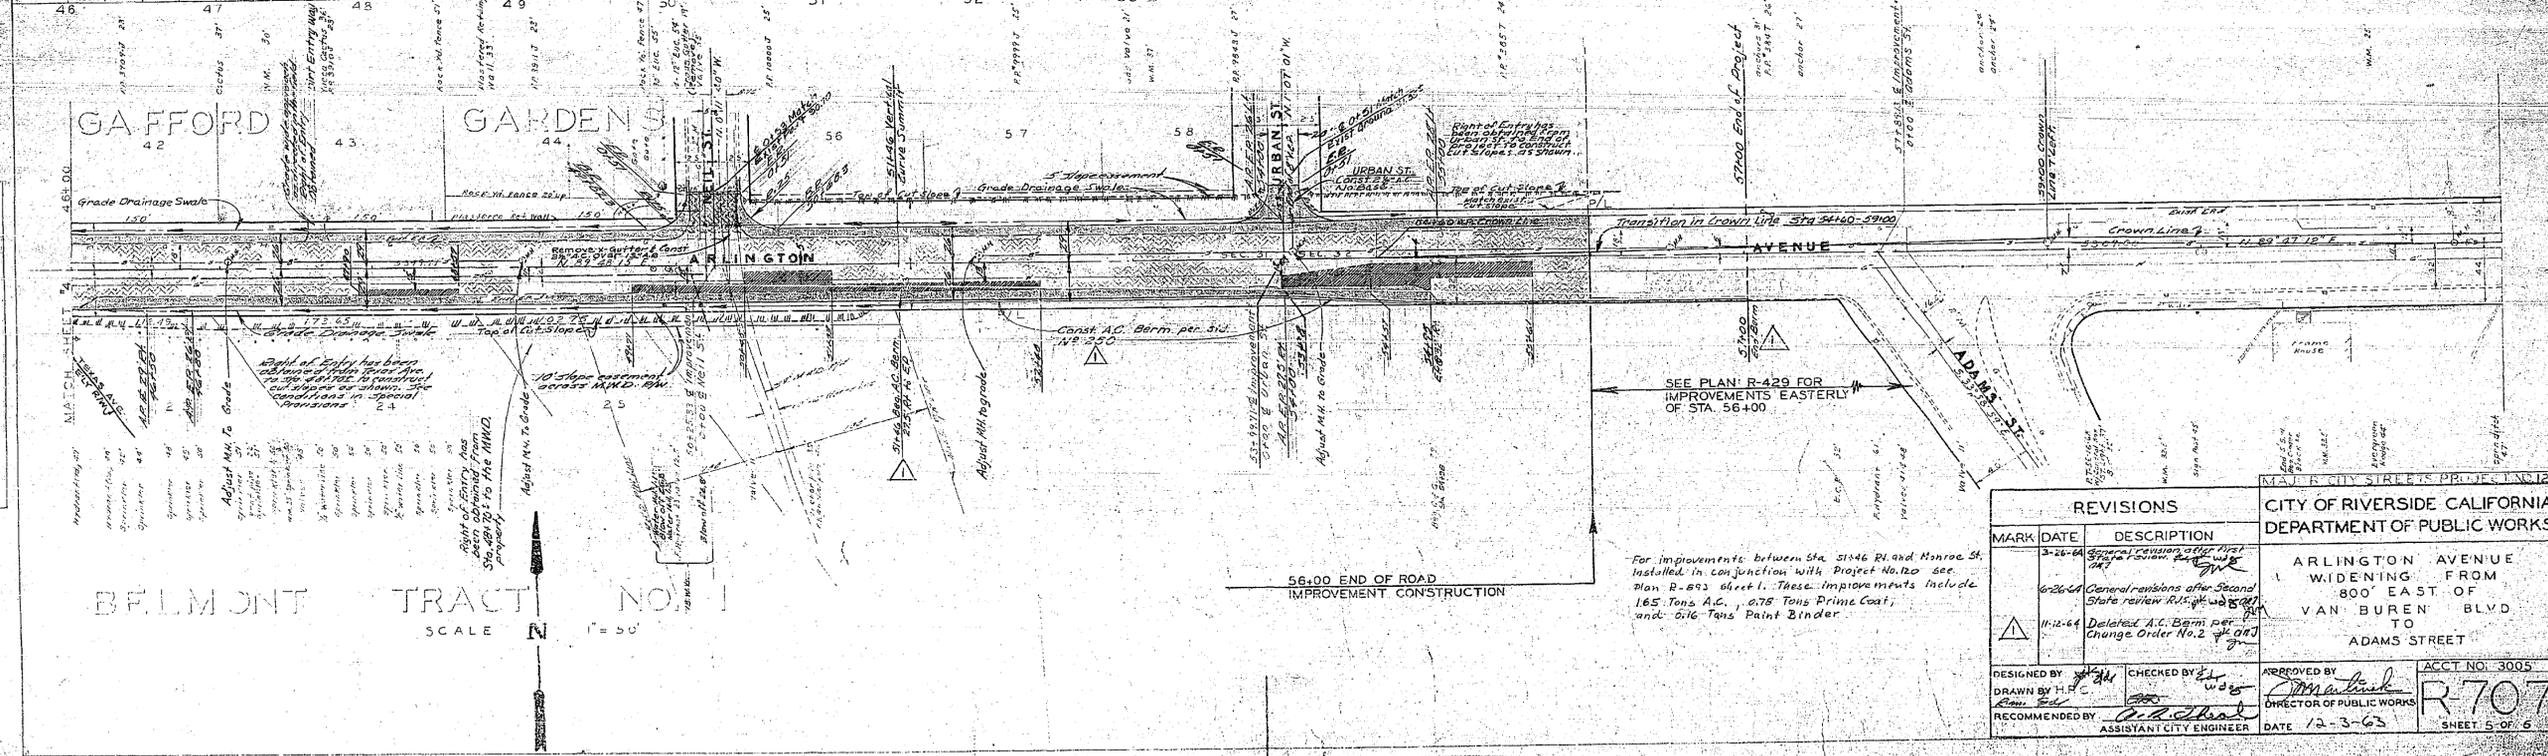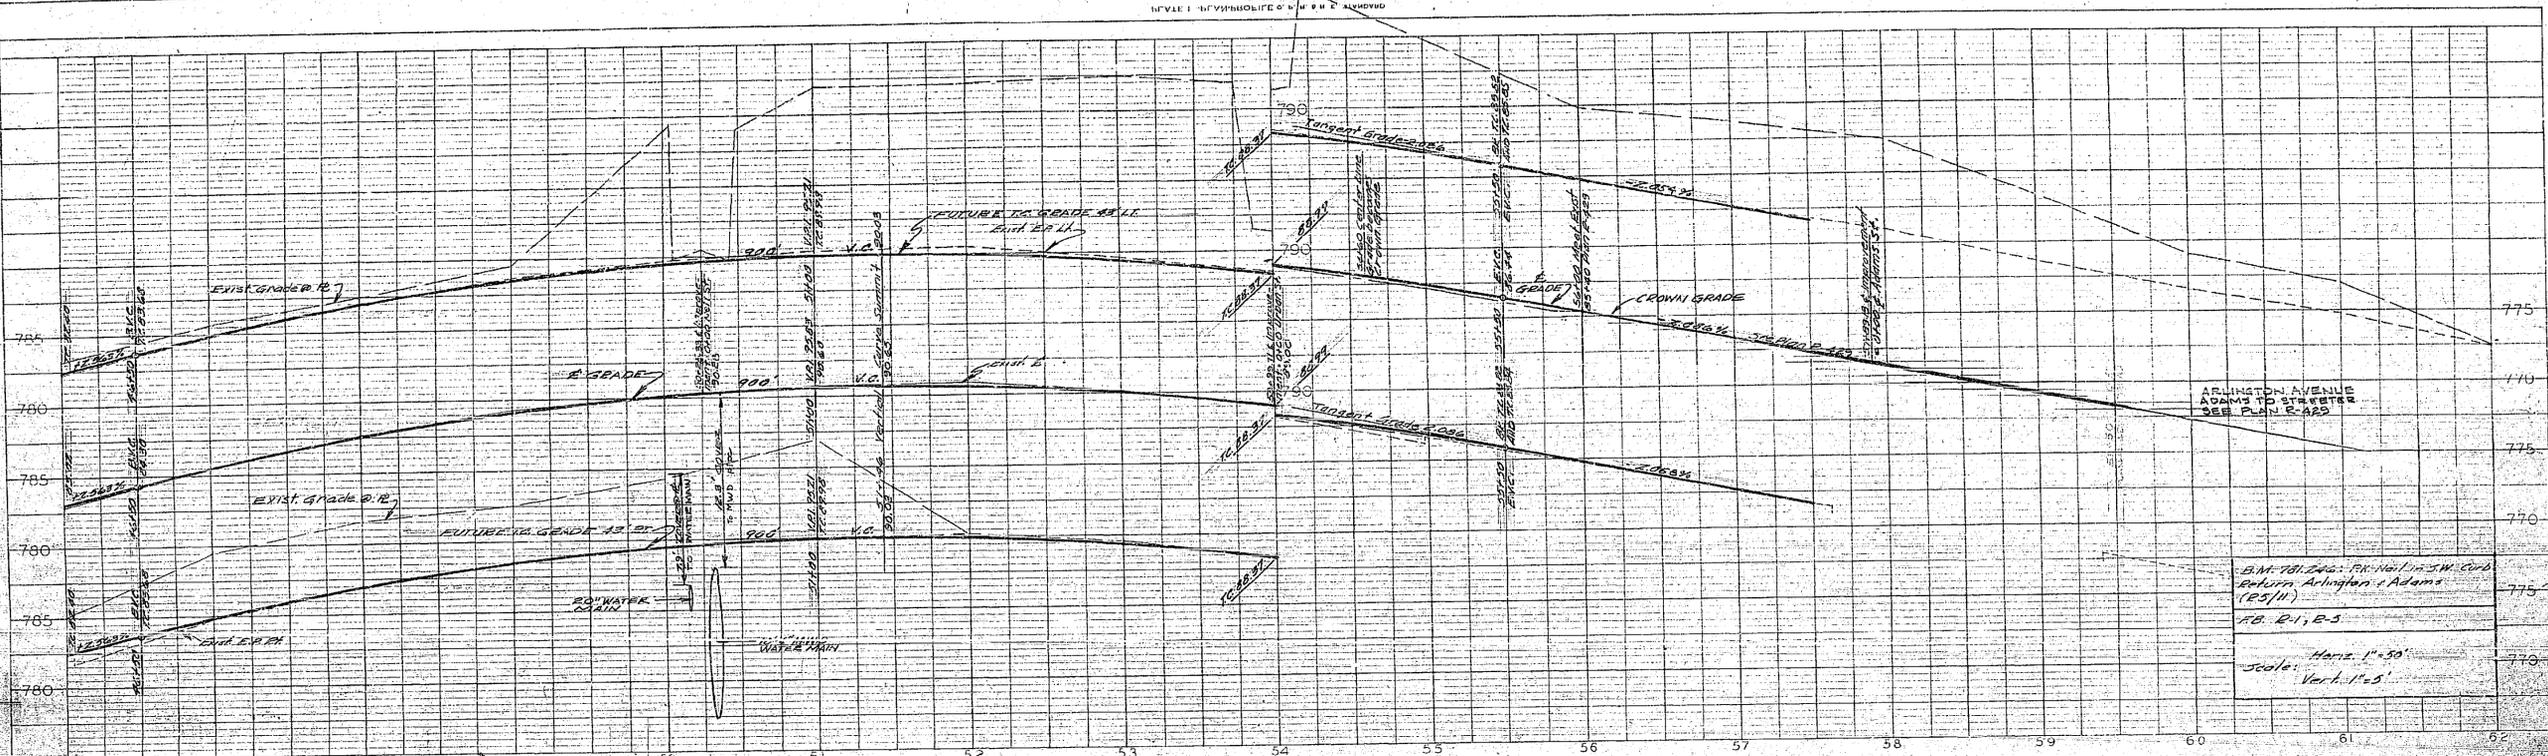

**REVISIONS**

MARK	DATE	DESCRIPTION
3-25-64		General revision after first State Review.
6-26-64		General revisions after second State review. Right of Way Change Order No. 2.
11-12-64		Deleted A.C. Berm per Change Order No. 2.

**CITY OF RIVERSIDE CALIFORNIA  
 DEPARTMENT OF PUBLIC WORKS**

ARLINGTON AVENUE  
 WIDENING FROM  
 800' EAST OF  
 VAN BUREN BLVD  
 TO  
 ADAMS STREET

DESIGNED BY: [Signature]  
 DRAWN BY: H.F.C.  
 RECOMMENDED BY: [Signature] ASSISTANT CITY ENGINEER

CHECKED BY: [Signature]  
 APPROVED BY: [Signature] DIRECTOR OF PUBLIC WORKS

DATE: 12-3-63

ACCT. NO. 3005  
**R707**  








