



REVISIONS			CITY OF RIVERSIDE, CALIFORNIA DEPARTMENT OF PUBLIC WORKS	
MARK	DATE	DESCRIPTION		
			CHICAGO AVENUE BET. EIGHTH & THIRD	
			TYPICAL CROSS SECTIONS	
DESIGNED BY	SUBMITTED BY	APPROVED BY	PROJ. NO.	3006
DRAWN BY	PARK DEPT.	DATE	R-743	
CHECKED BY	RECOMMENDED BY	DATE	7-13-64	
			SHEET 4 OF 4	

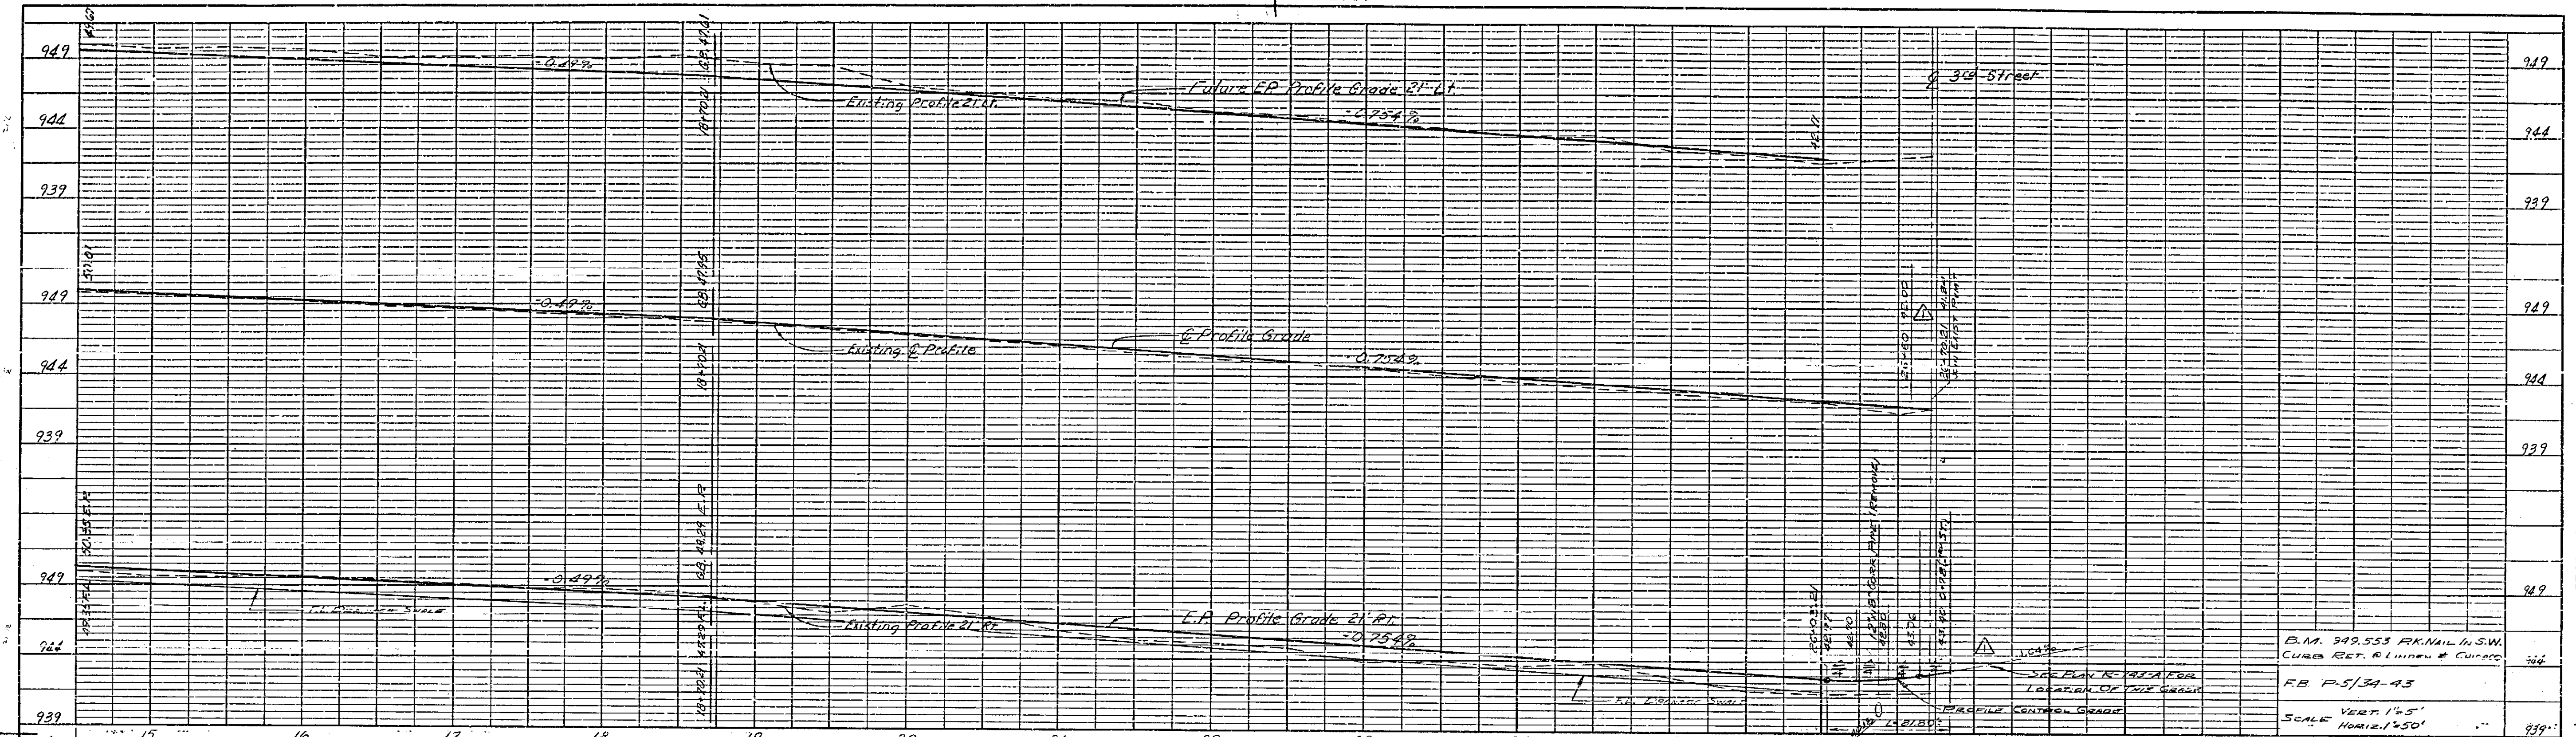







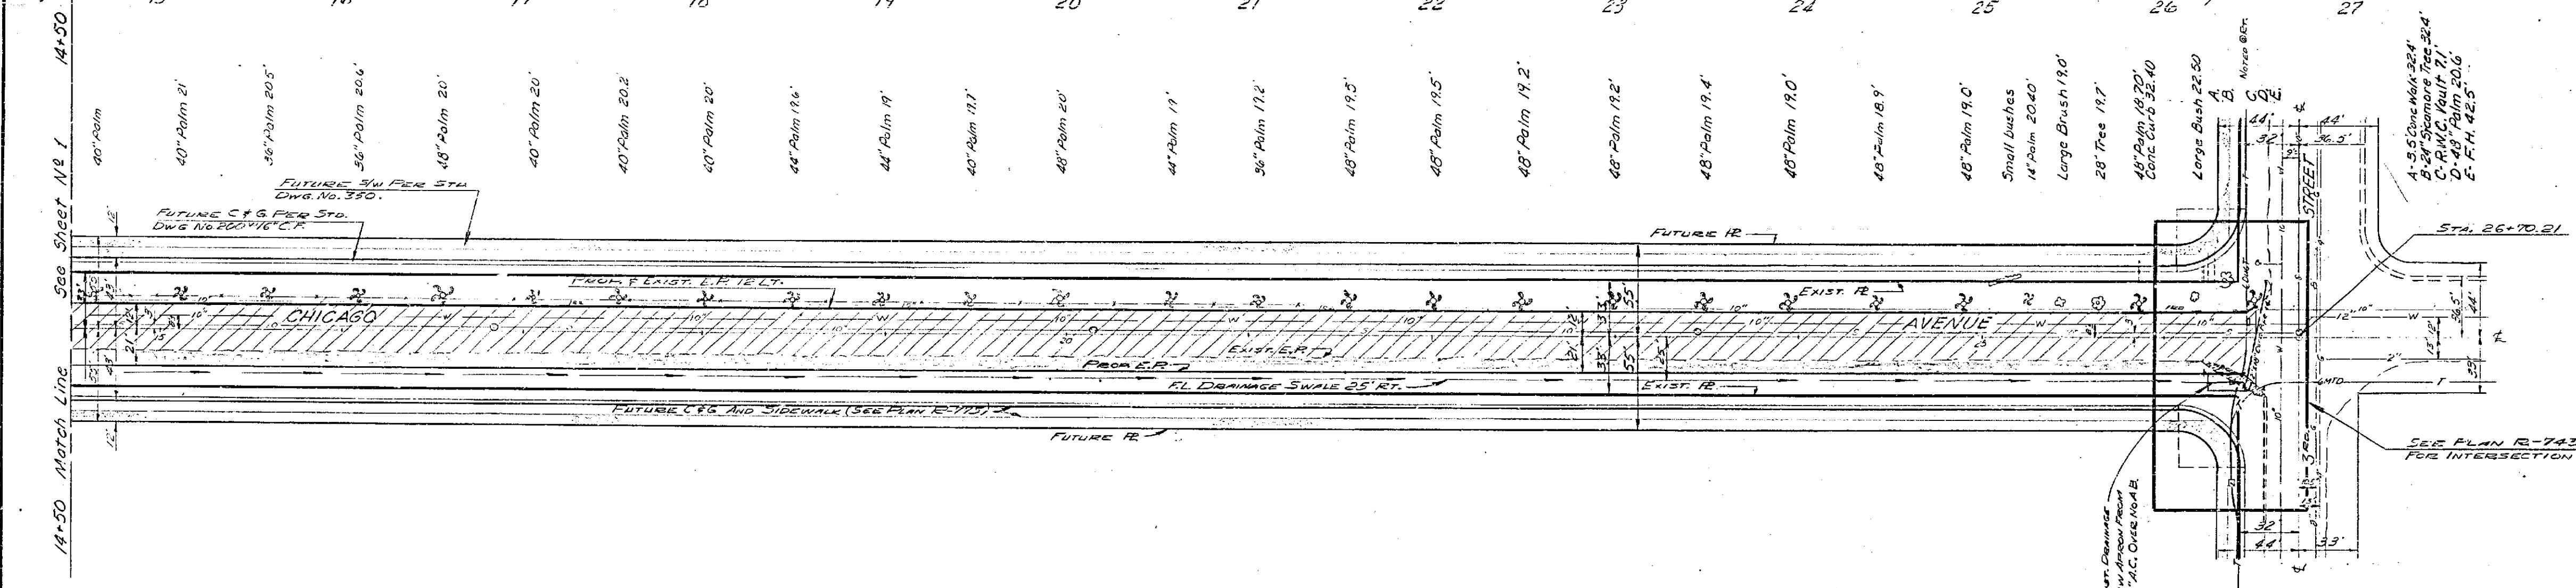


SCALE 1" = 50'

NOTE:
 FOR SIGNING LEGEND SEE SHEET 1

REVISIONS			CITY OF RIVERSIDE, CALIFORNIA DEPARTMENT OF PUBLIC WORKS	
MARK	DATE	DESCRIPTION		
△	7-30-64	REVISED 12% AGENDUM NO. 1 AM. 087 JRM		
			CHICAGO AVENUE BET. EIGHTH & THIRD LINDEN TO THIRD	
DESIGNED BY	SUBMITTED BY	APPROVED BY	PROJ. NO.	
DRAWN BY	PARK DEPT.	TRAFFIC DIV.	R-743	
CHECKED BY	RECOMMENDED BY	DATE	7-13-64	SHEET 2 OF 2

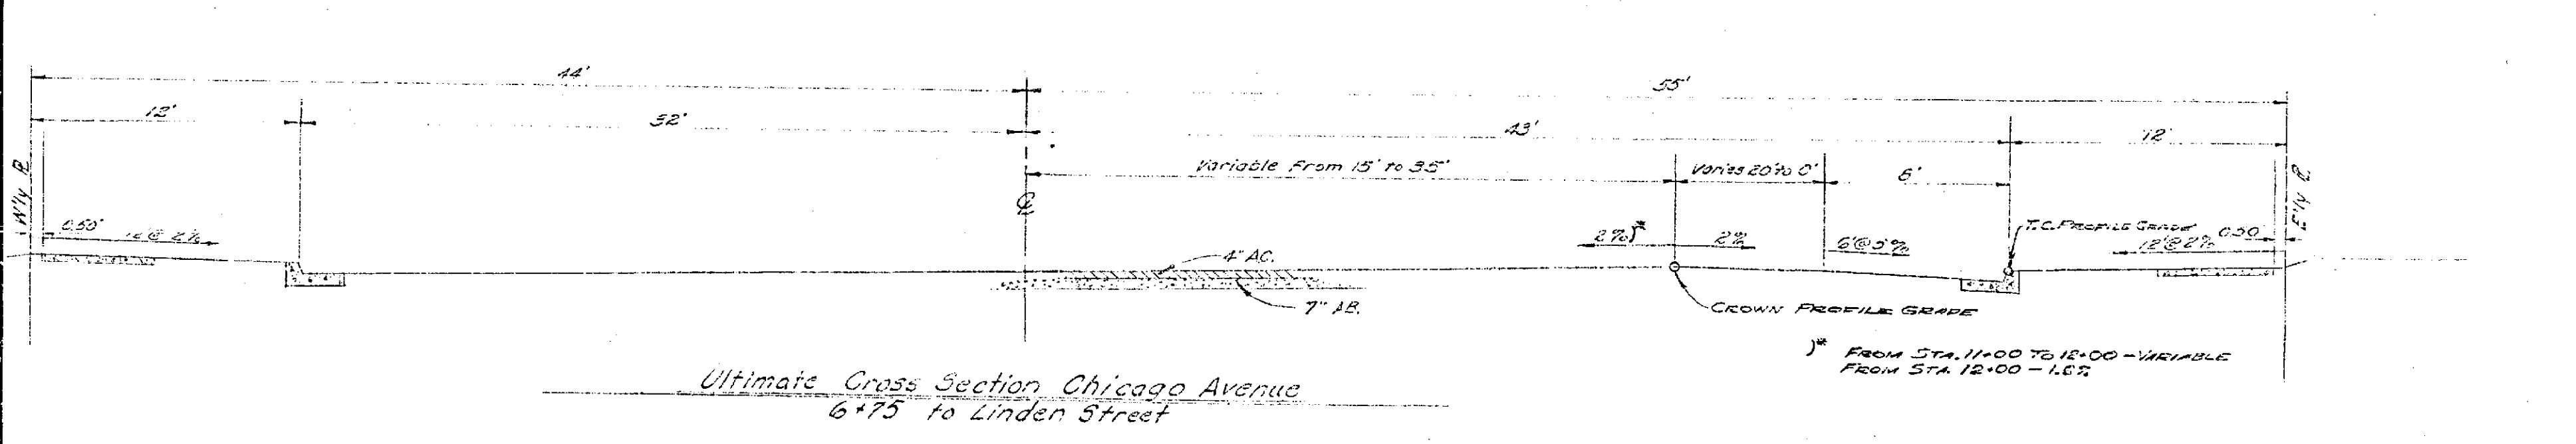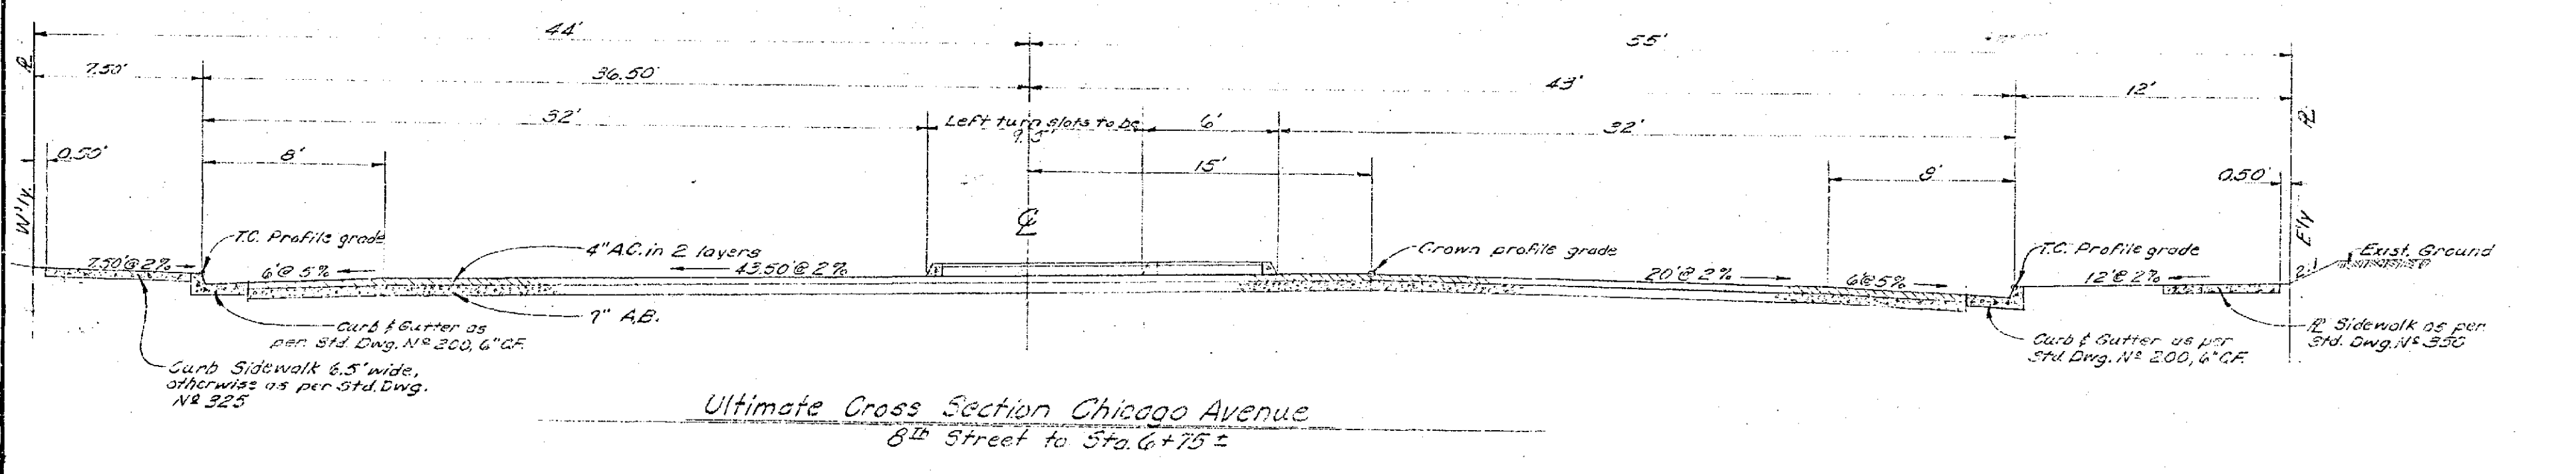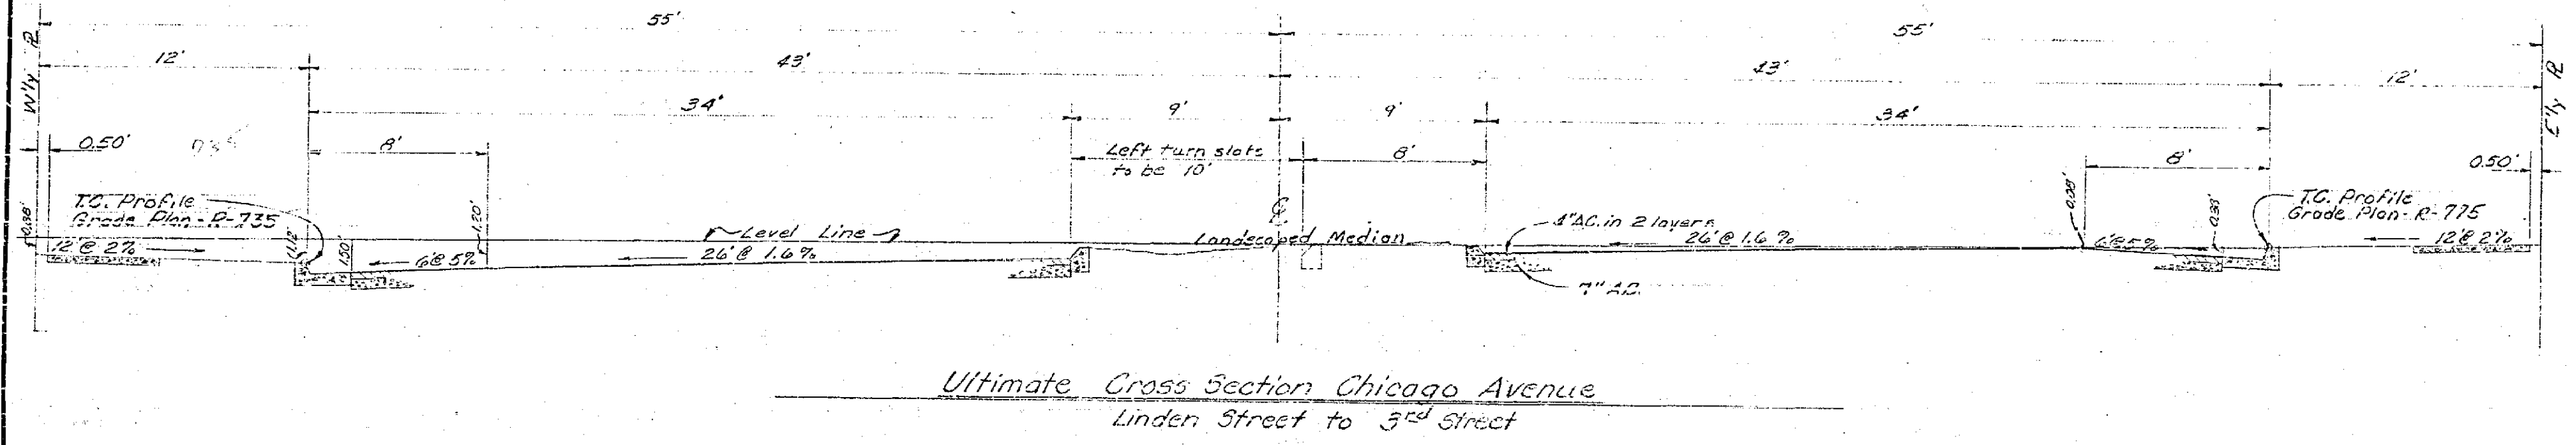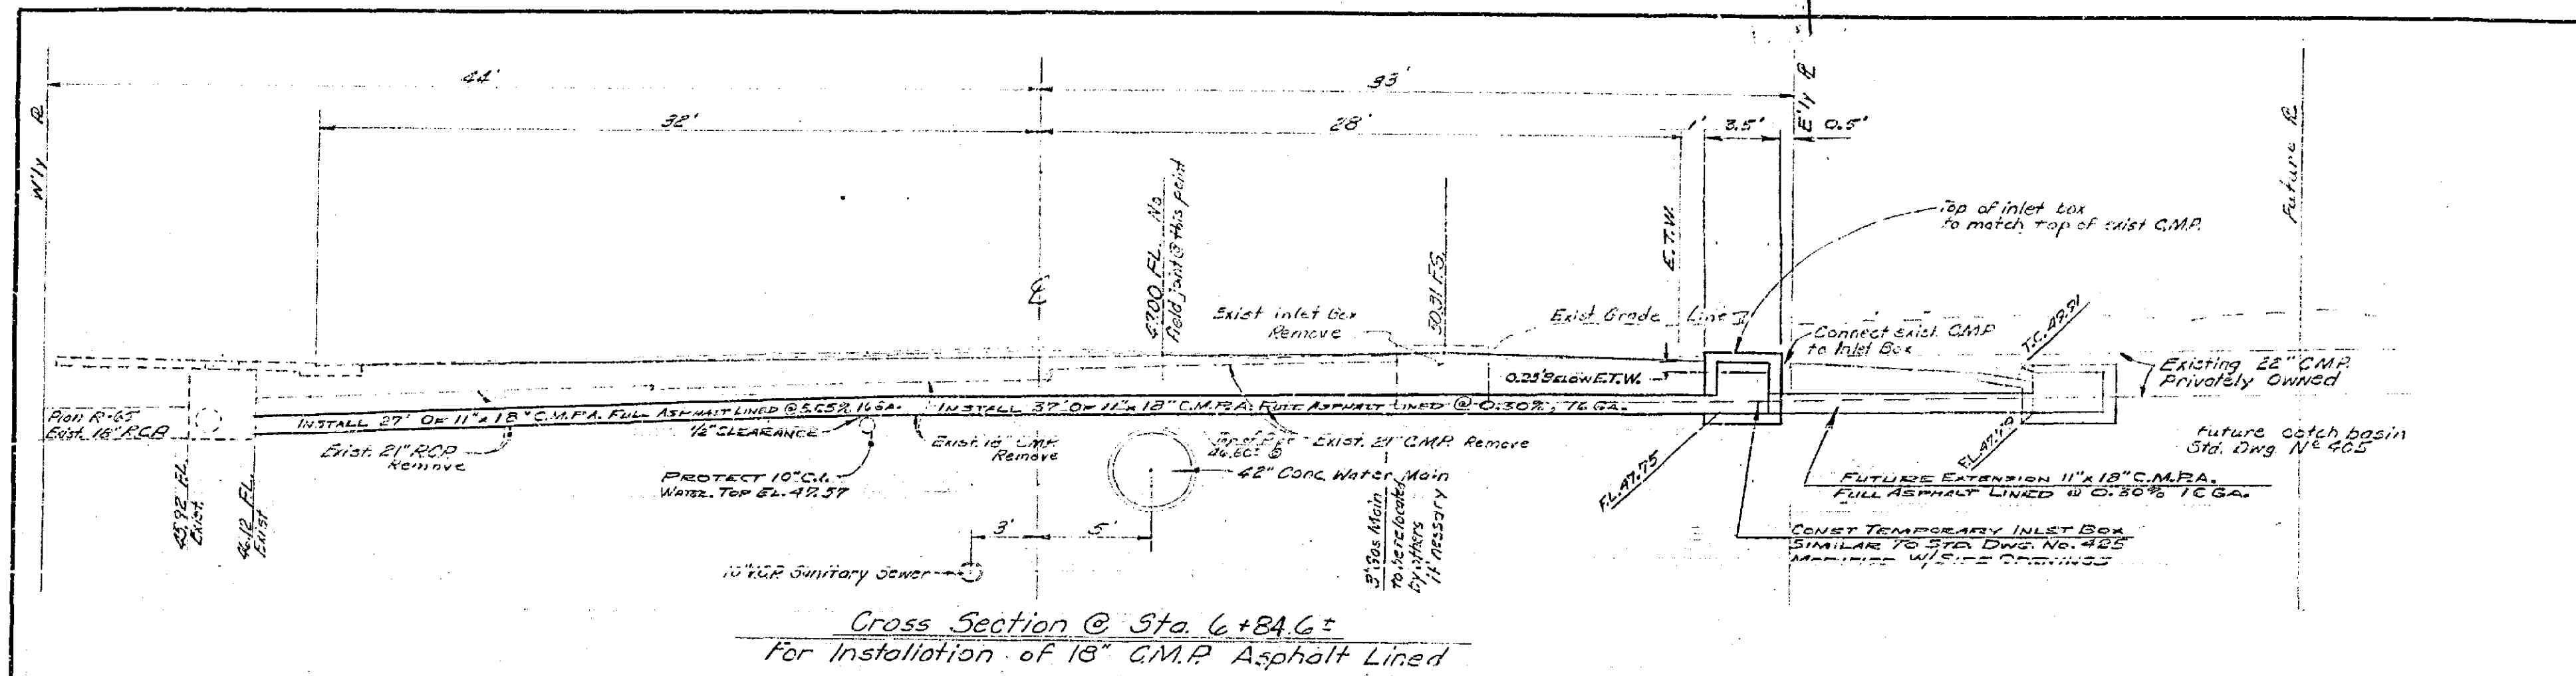


REVISIONS			CITY OF RIVERSIDE, CALIFORNIA DEPARTMENT OF PUBLIC WORKS	
MARK	DATE	DESCRIPTION		
			CHICAGO AVENUE BET. EIGHTH & THIRD TYPICAL CROSS SECTIONS	
DESIGNED BY	QUANTITY BY	APPROVED BY	PROJ. NO. 3006	
DRAWN BY	PARK DEPT.	TRAFFIC DIV.	R-743	
CHECKED BY	RECOMMENDED BY	DATE	SHEET 3 OF 4	

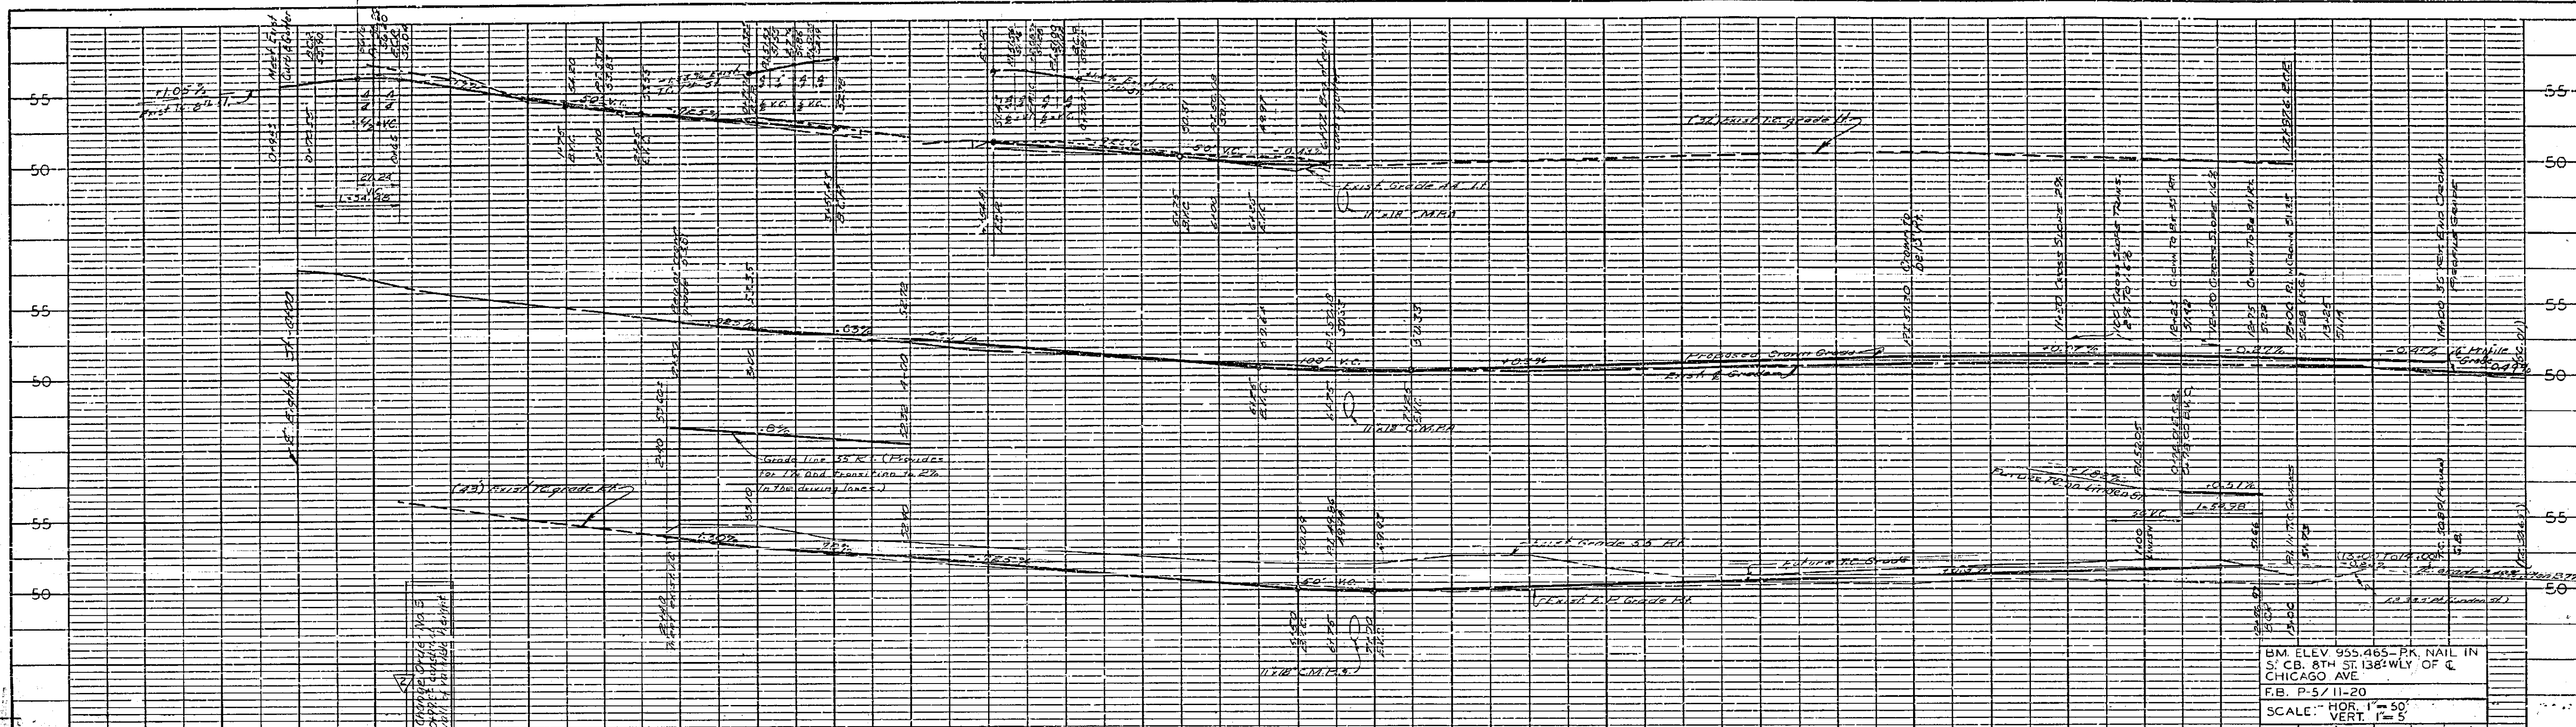

NO.	DATE	DESCRIPTION
1		AS SHOWN
2		AS SHOWN
BM. ELEV. 955.465 P.M. NAIL IN
 S. CB. 8TH ST. 138' W. LY. OF C.
 CHICAGO AVE.
 F.B. P-5/11-20
 SCALE: HOR. 1"=50'
 VERT. 1"=5'

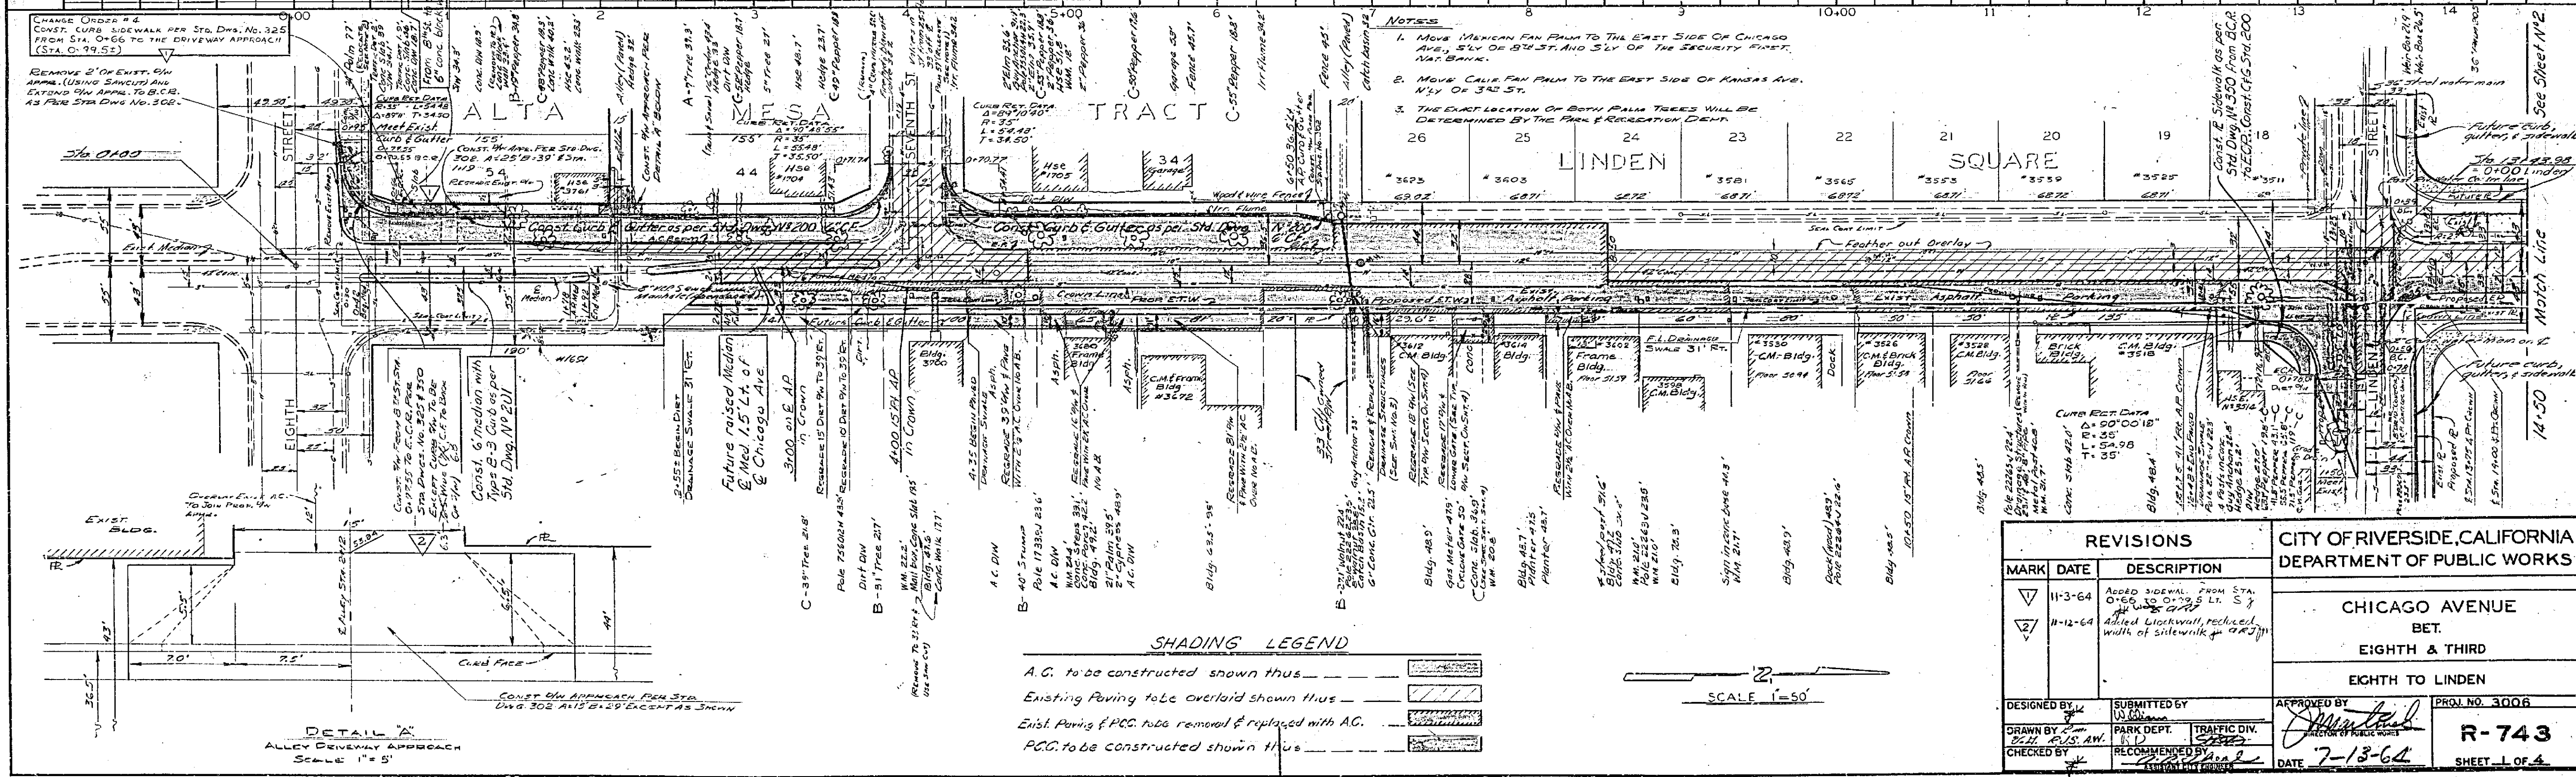

- NOTES
1. MOVE MEXICAN FAN PALM TO THE EAST SIDE OF CHICAGO AVE. SLY. DE 8TH ST. AND SLY. OF THE SECURITY FINET, NAT. BANK.
 2. MOVE CALIF. FAN PALM TO THE EAST SIDE OF KANSAS AVE. NLY. OF 343 ST.

CHANGE CROSS # 4
 CONST. CURB SIDEWALK PER STD. DWS. NO. 325
 FROM STA. 0+00 TO THE DRIVEWAY APPROACH
 (STA. 0+99.52)


DETAIL A
 ALLEY DRIVEWAY APPROACH
 SCALE 1"=5'


SHADING LEGEND

A.G. to be constructed shown thus

Existing paving to be overlaid shown thus

Exist. Paving & P.C.C. to be removed & replaced with A.G.

P.C.C. to be constructed shown thus

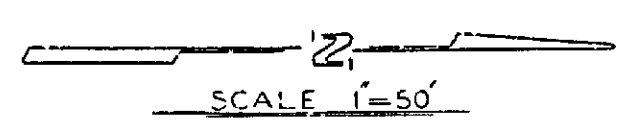

REVISIONS			CITY OF RIVERSIDE, CALIFORNIA DEPARTMENT OF PUBLIC WORKS
MARK	DATE	DESCRIPTION	
DESIGNED BY	U.S.	SUBMITTED BY	APPROVED BY
DRAWN BY	W.M.	PARK DEPT.	TRAFFIC DIV.
CHECKED BY	W.M.	RECOMMENDED BY	DATE 7-13-64
			PROJ. NO. 3006
			R-743
			SHEET 1 OF 4