



**PLAN**  
 DRAWN BY: [ ]  
 CHECKED BY: [ ]  
 DATE: [ ]  
 NOTE BOOK: [ ]  
 ALIGNMENT CHECKED: [ ]  
 RT. OF WAY CHECKED: [ ]


**PROFILE**  
 DRAWN BY: [ ]  
 CHECKED BY: [ ]  
 DATE: [ ]  
 NOTE BOOK: [ ]  
 ALIGNMENT CHECKED: [ ]  
 RT. OF WAY CHECKED: [ ]

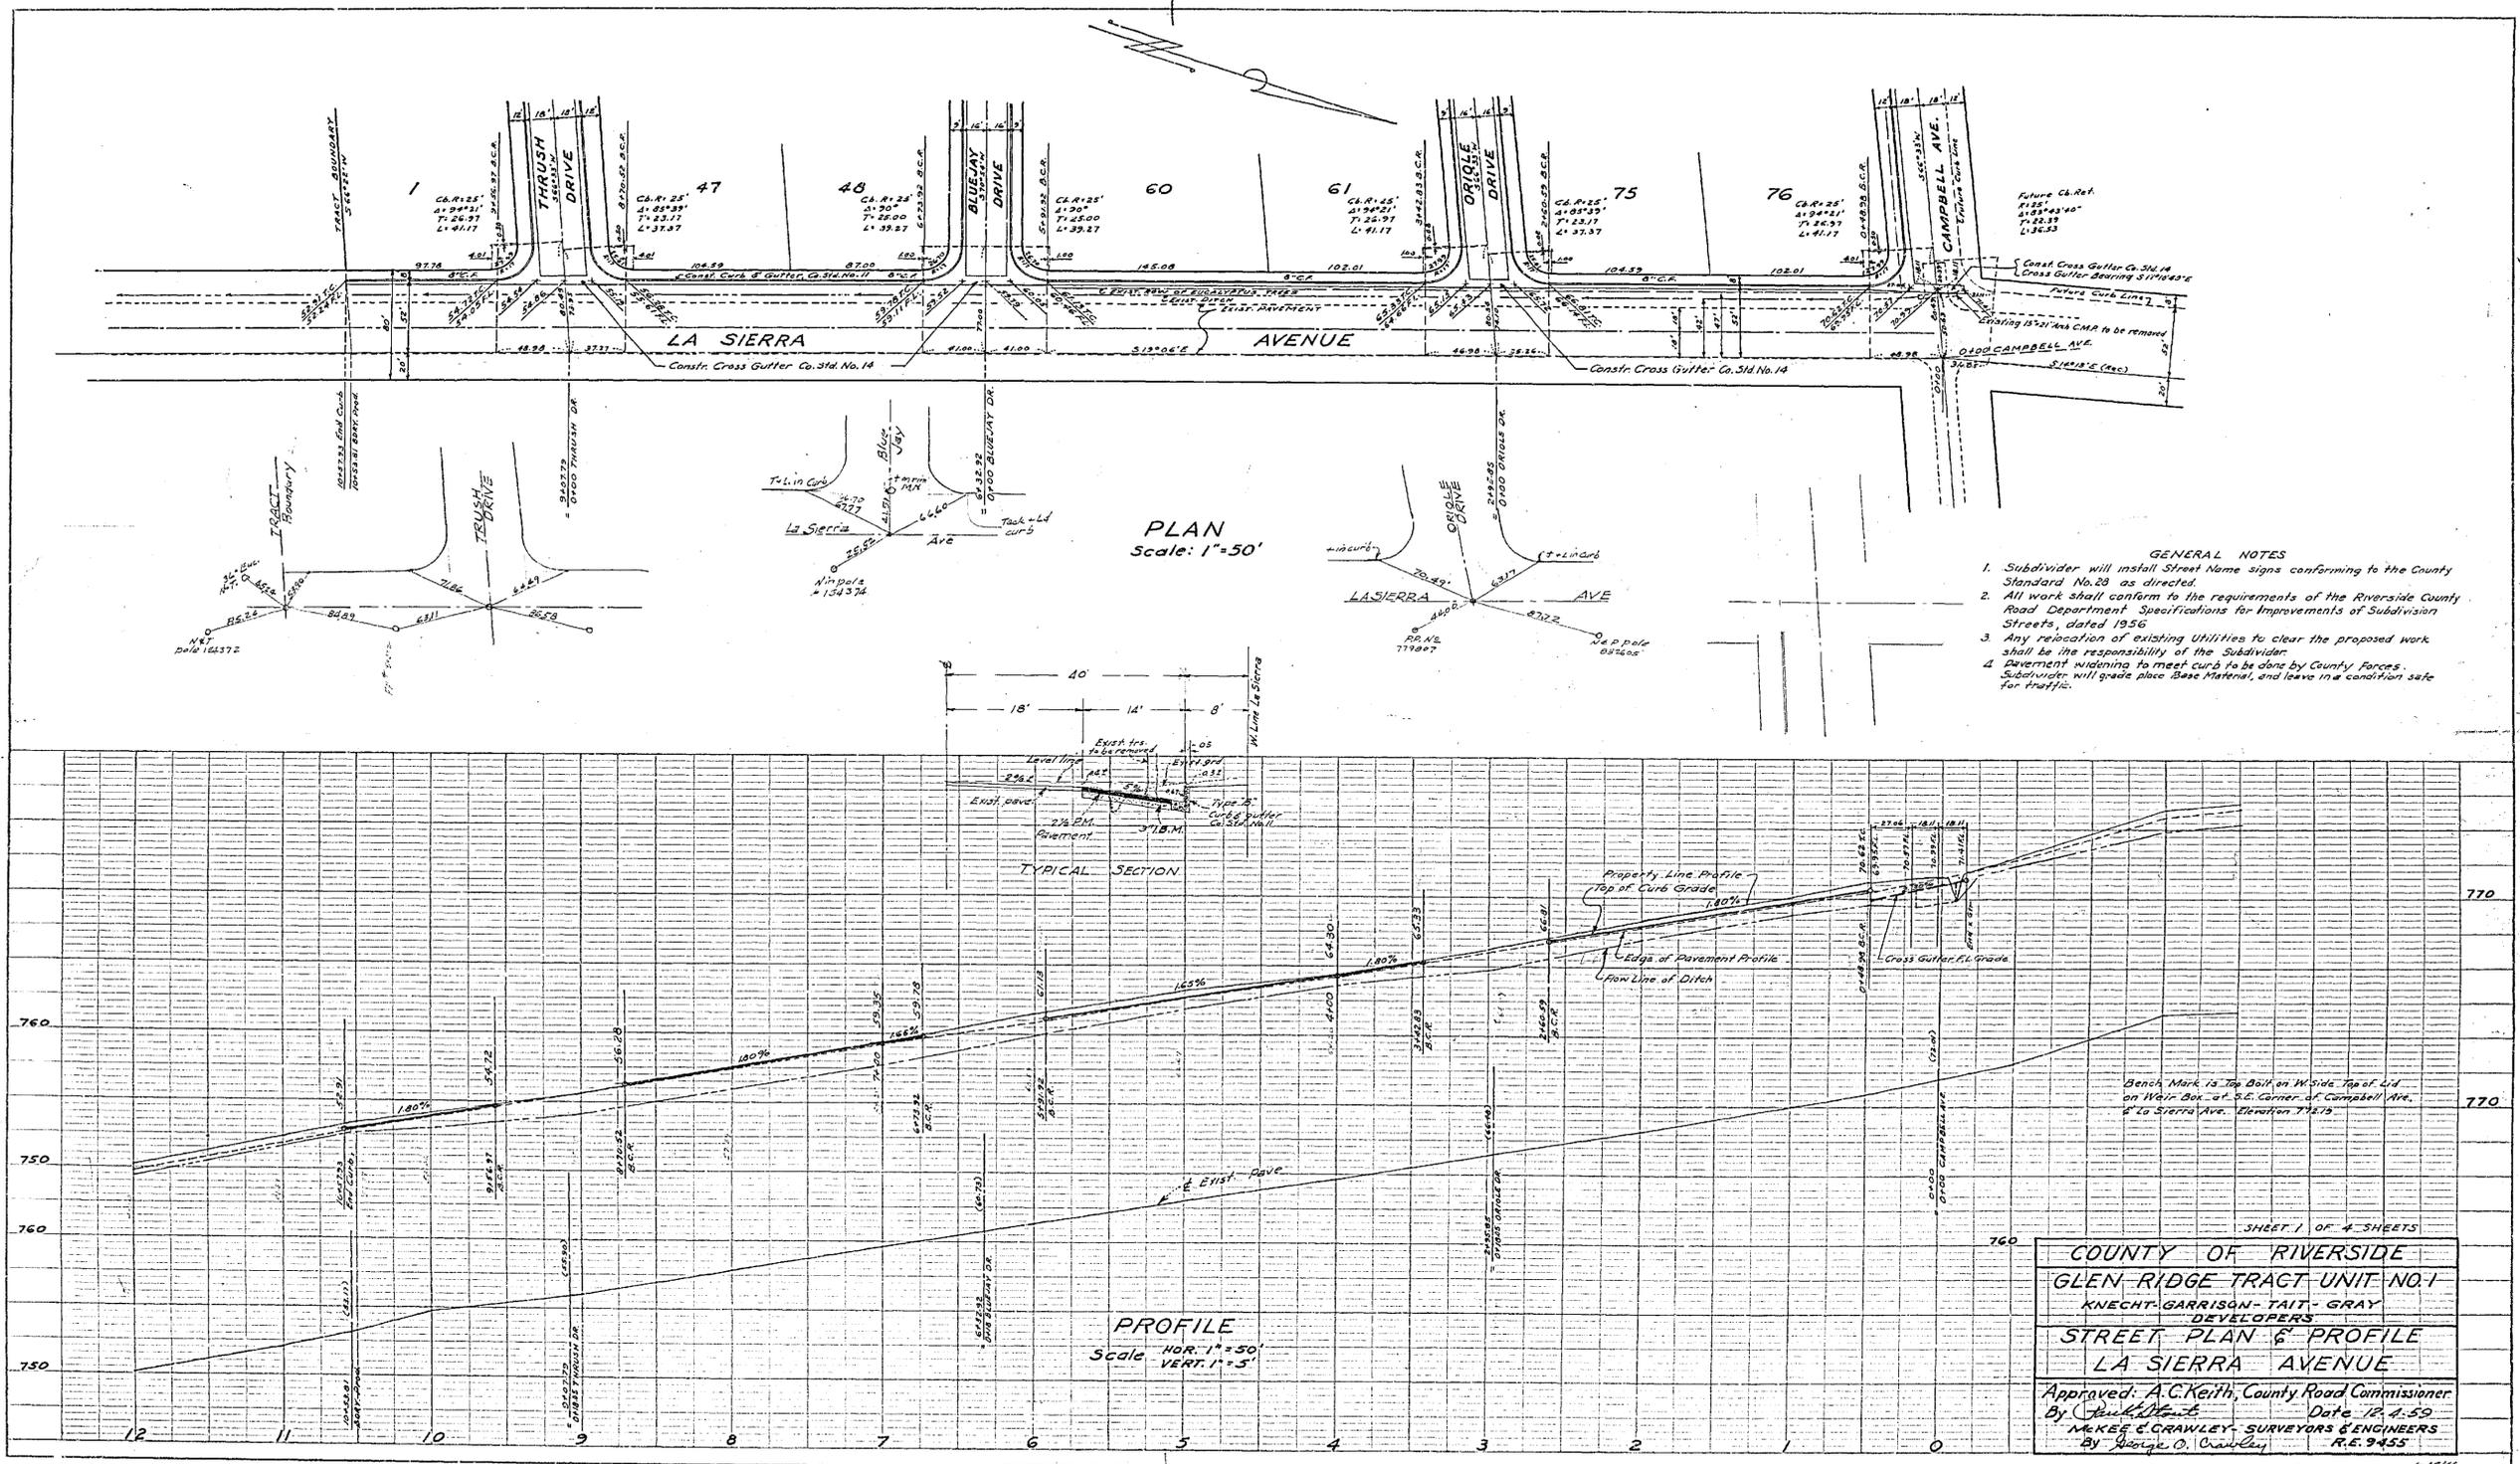

PLAN	DATE
REVISED	
NOTED	
BY	
DATE	

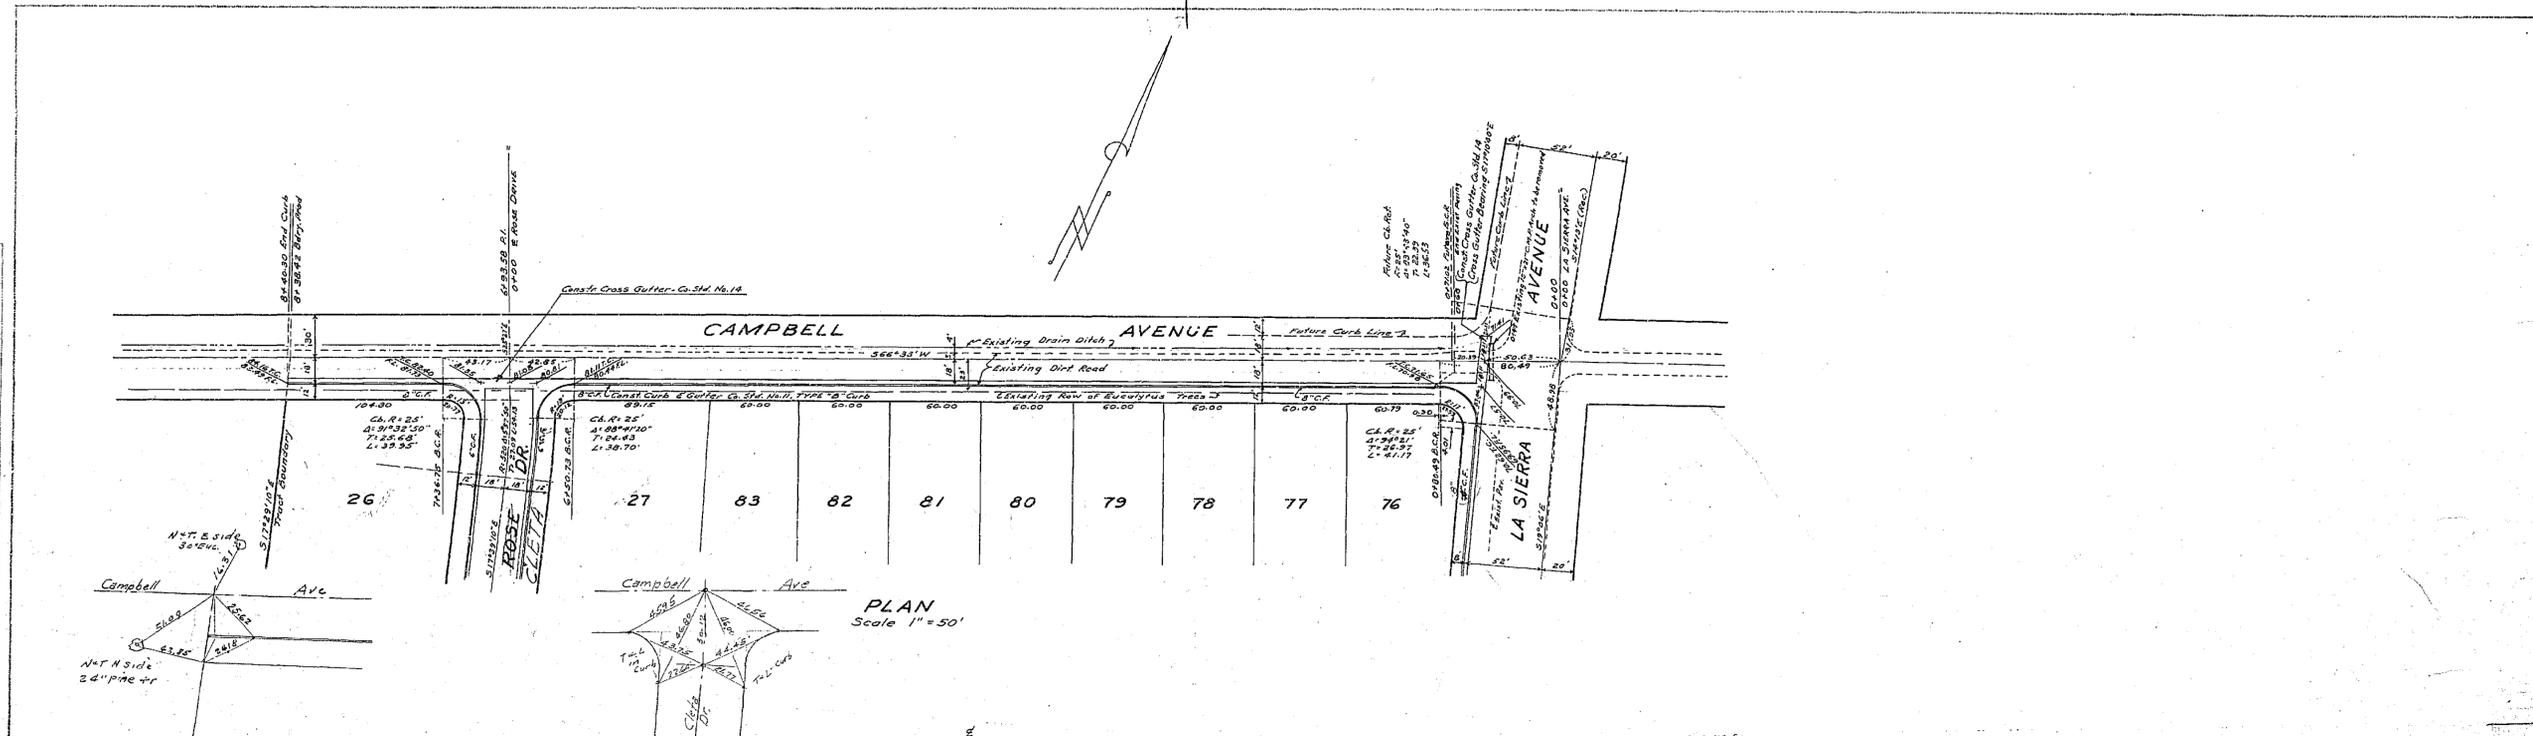

PROFILE	DATE
REVISED	
NOTED	
BY	
DATE	

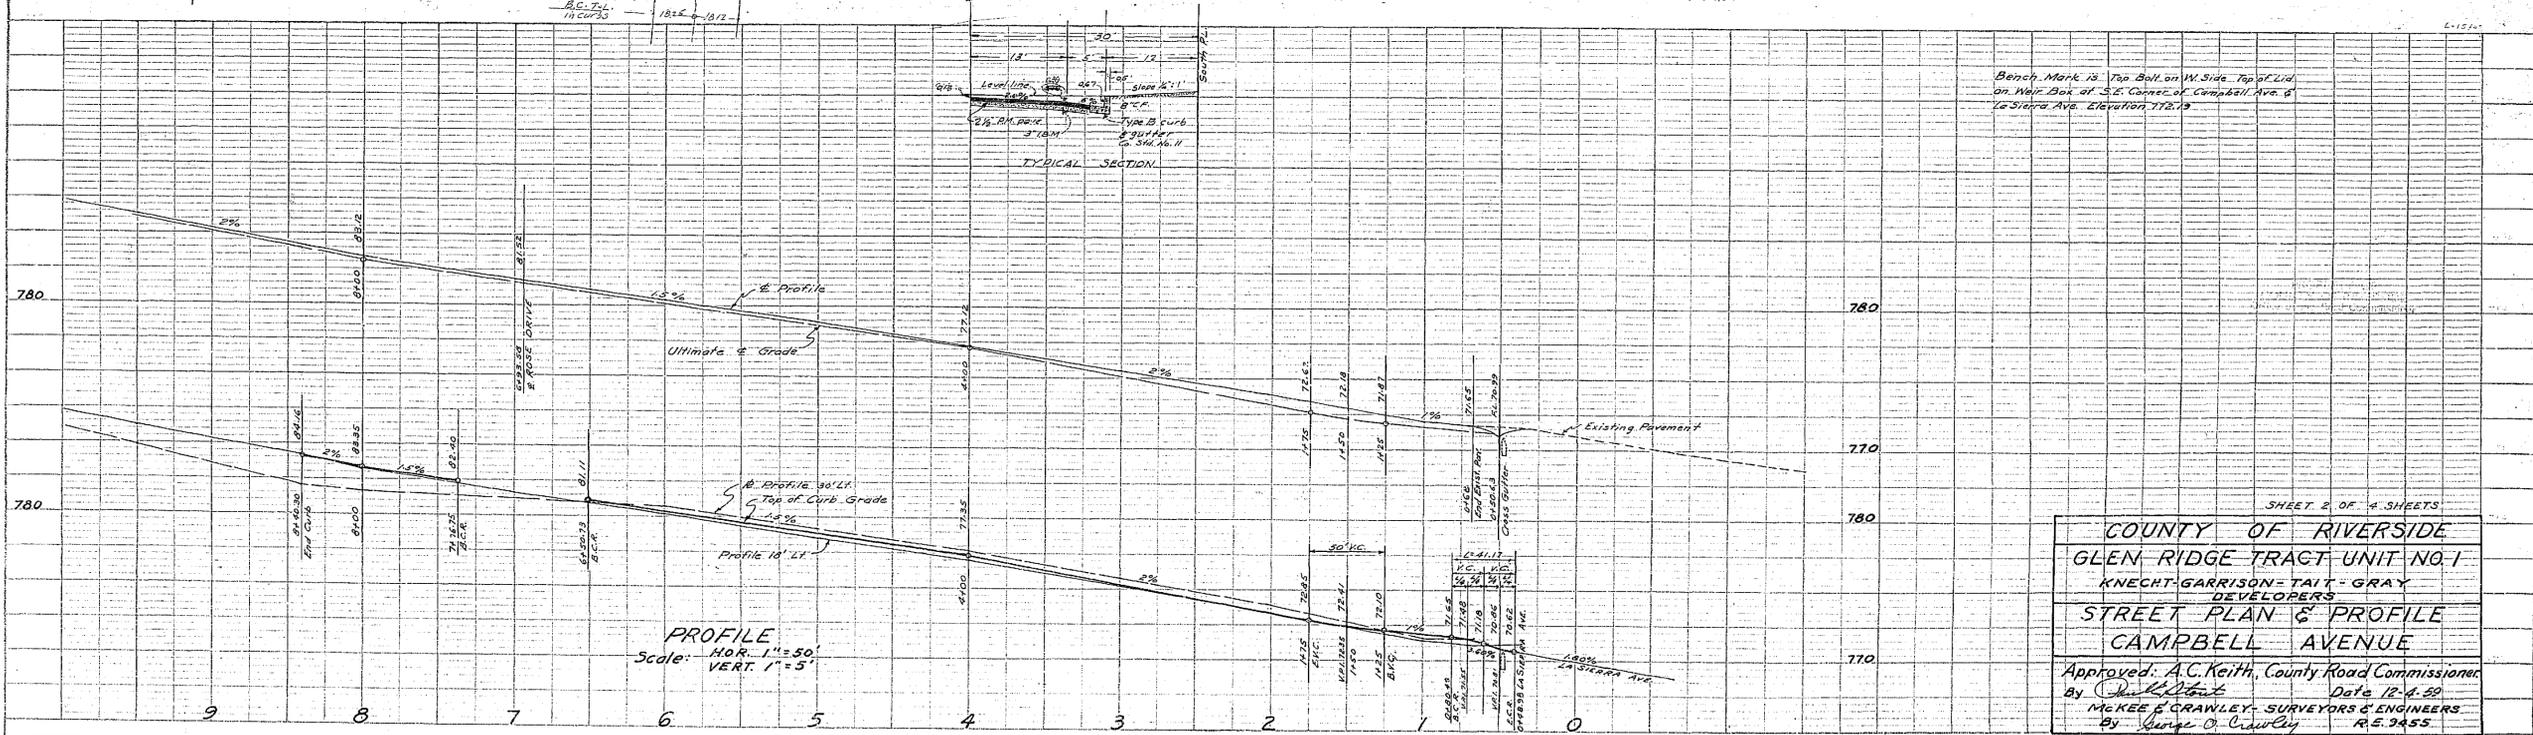


SHEET 2 OF 4 SHEETS

**COUNTY OF RIVERSIDE**  
**GLEN RIDGE TRACT UNIT NO. 1**  
 KNECHT-GARRISON-TAIT-GRAY  
 DEVELOPERS  
**STREET PLAN & PROFILE**  
**CAMPBELL AVENUE**


Approved: A.C. Keith, County Road Commissioner  
 By *[Signature]* Date 12-4-59  
 MCKEE & CRAWLEY, SURVEYORS & ENGINEERS  
 By *[Signature]* R.E. 2455

R-801

PLAN  
 CHECKED BY: [Signature]  
 DATE: [Date]  
 NOTE BOOK ALPHABET CHECKED  
 NO. OF PLAN SHEETS: [Number]

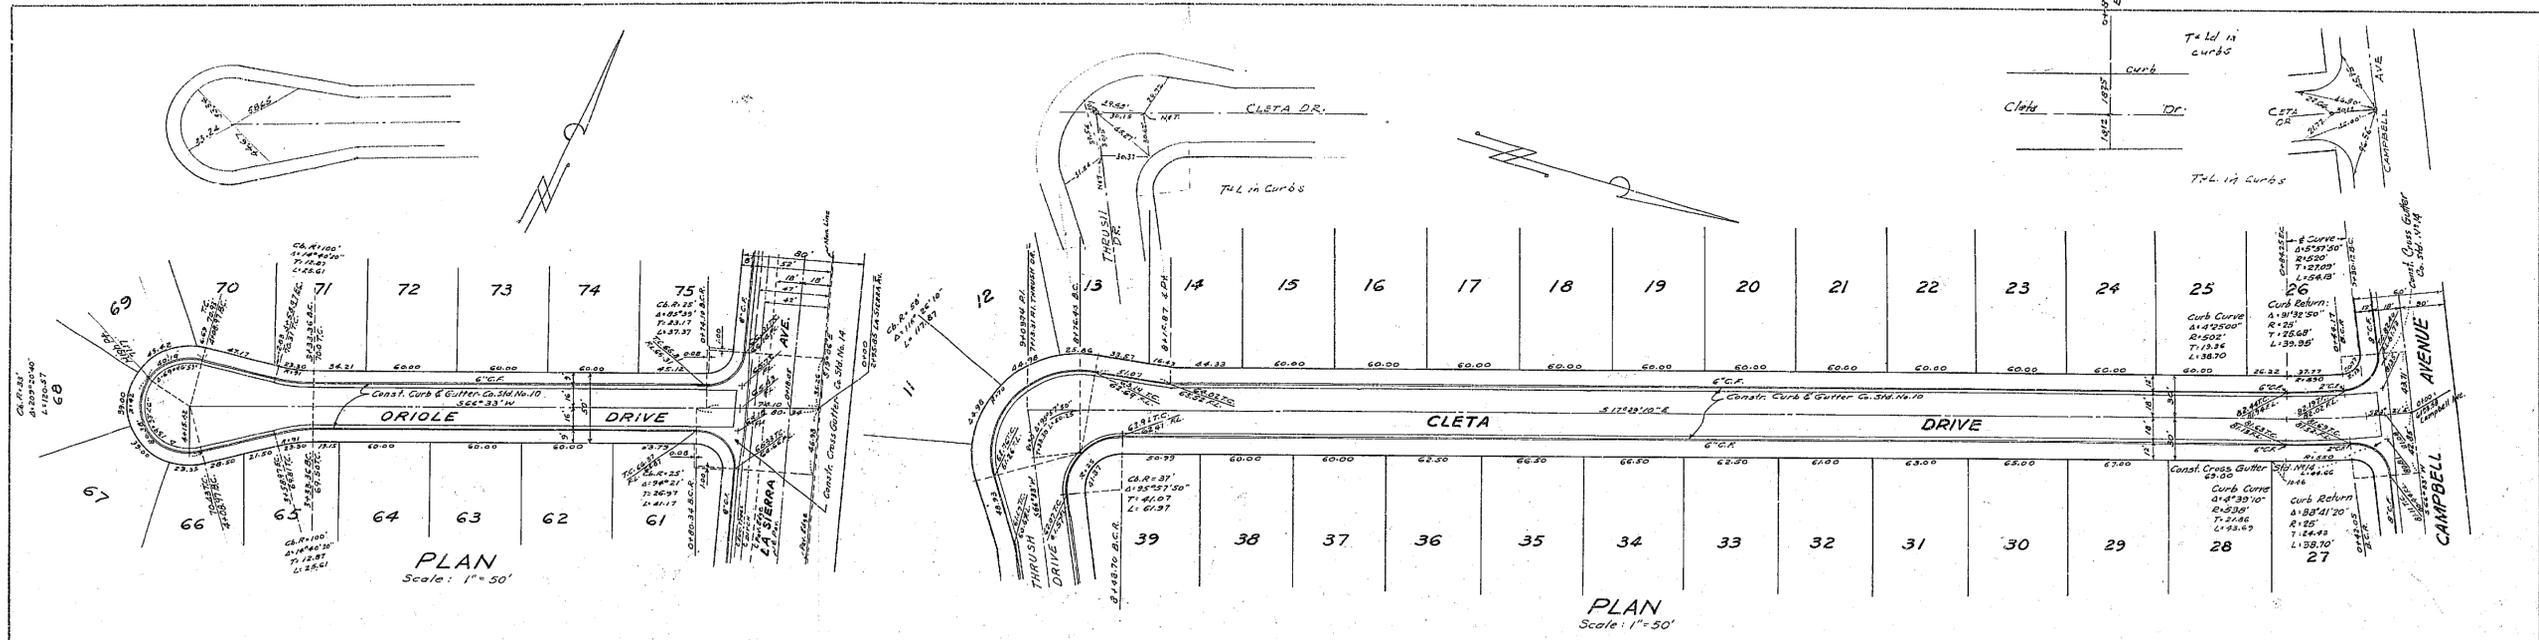

PROFILE  
 CHECKED BY: [Signature]  
 DATE: [Date]  
 NOTE BOOK ALPHABET CHECKED  
 NO. OF PROFILE SHEETS: [Number]

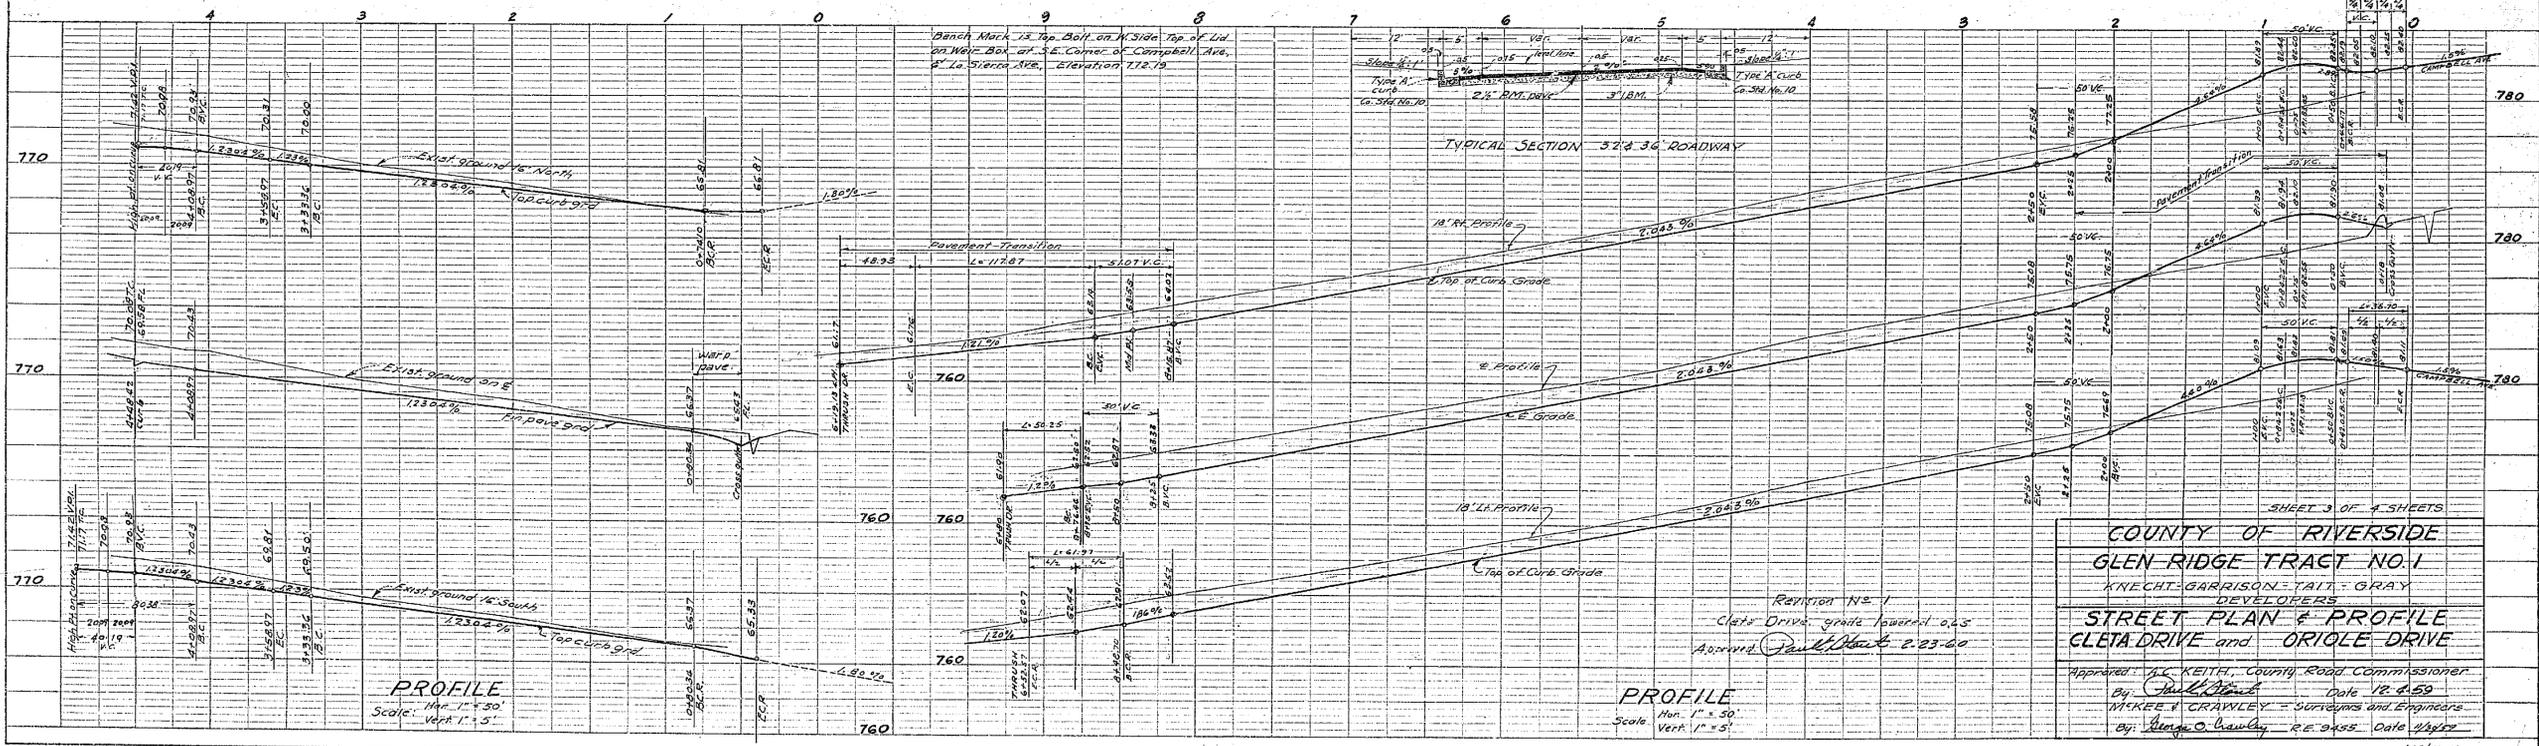

SHEET 3 OF 4 SHEETS

**COUNTY OF RIVERSIDE**  
**GLEN RIDGE TRACT NO. 1**  
 KNECHT, GARRISON, TAIT, GRAY  
 DEVELOPERS

**STREET PLAN & PROFILE**  
**CLETA DRIVE and ORIOLE DRIVE**

Approved: J.C. KEITH, County Road Commissioner  
 Date: 12-1-59  
 By: W.K.E. & CRAWLEY - Surveyors and Engineers  
 Date: 12-1-59

