
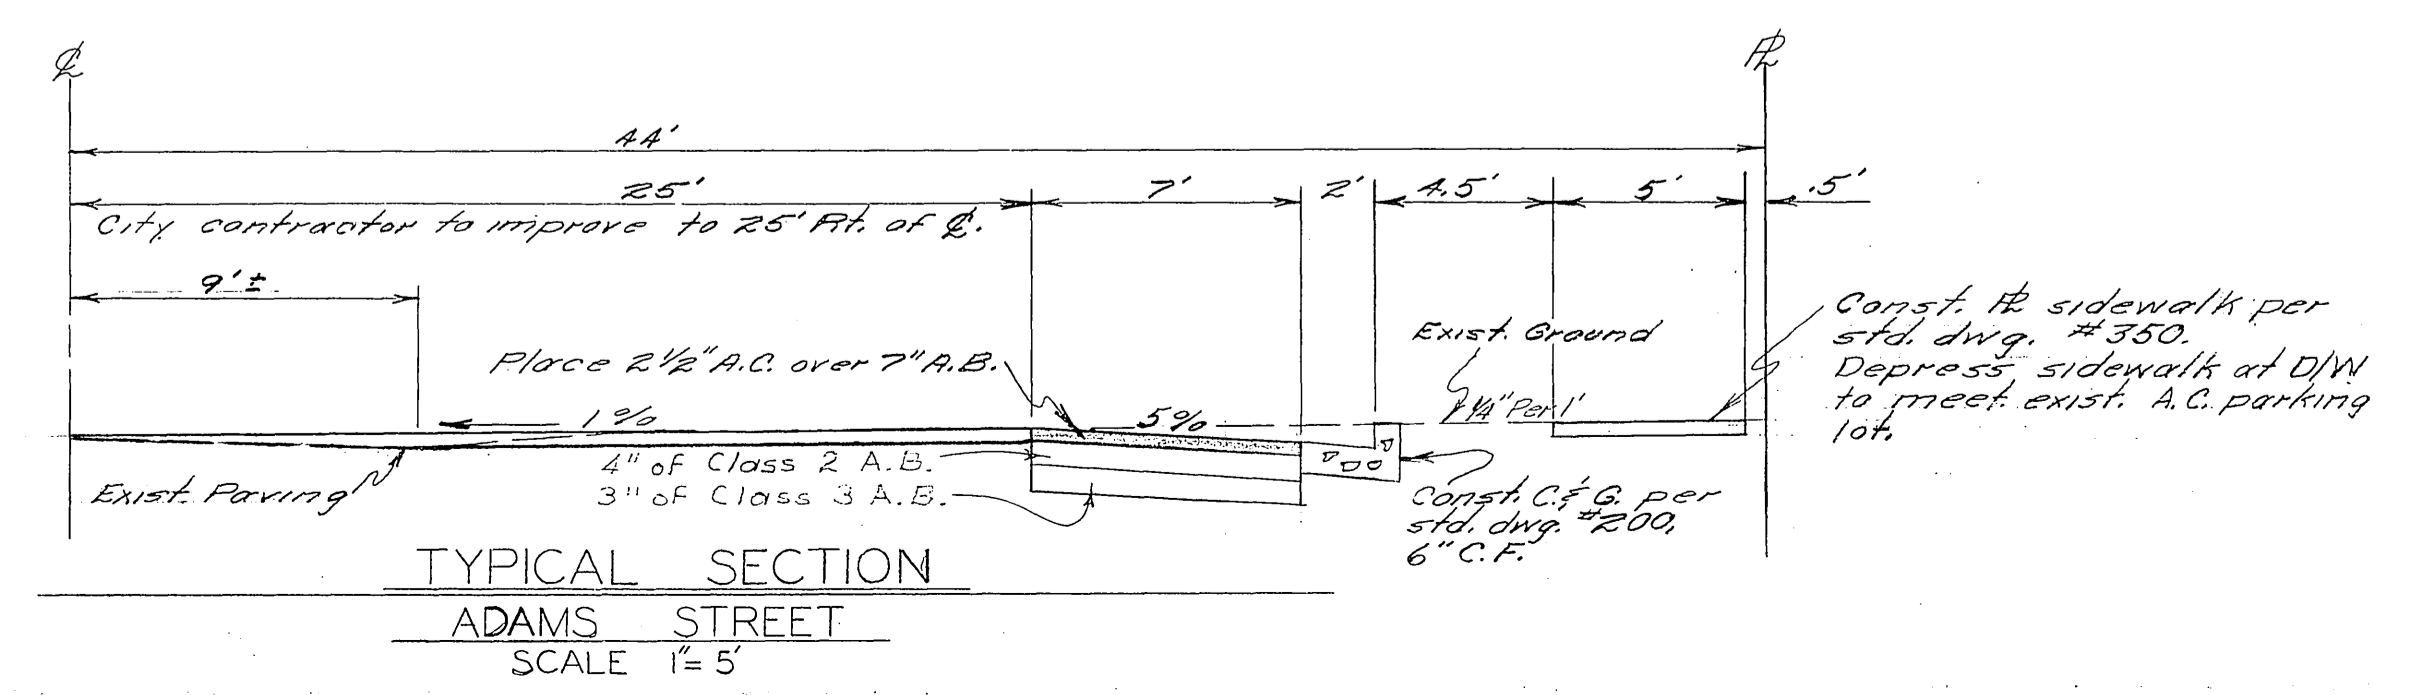
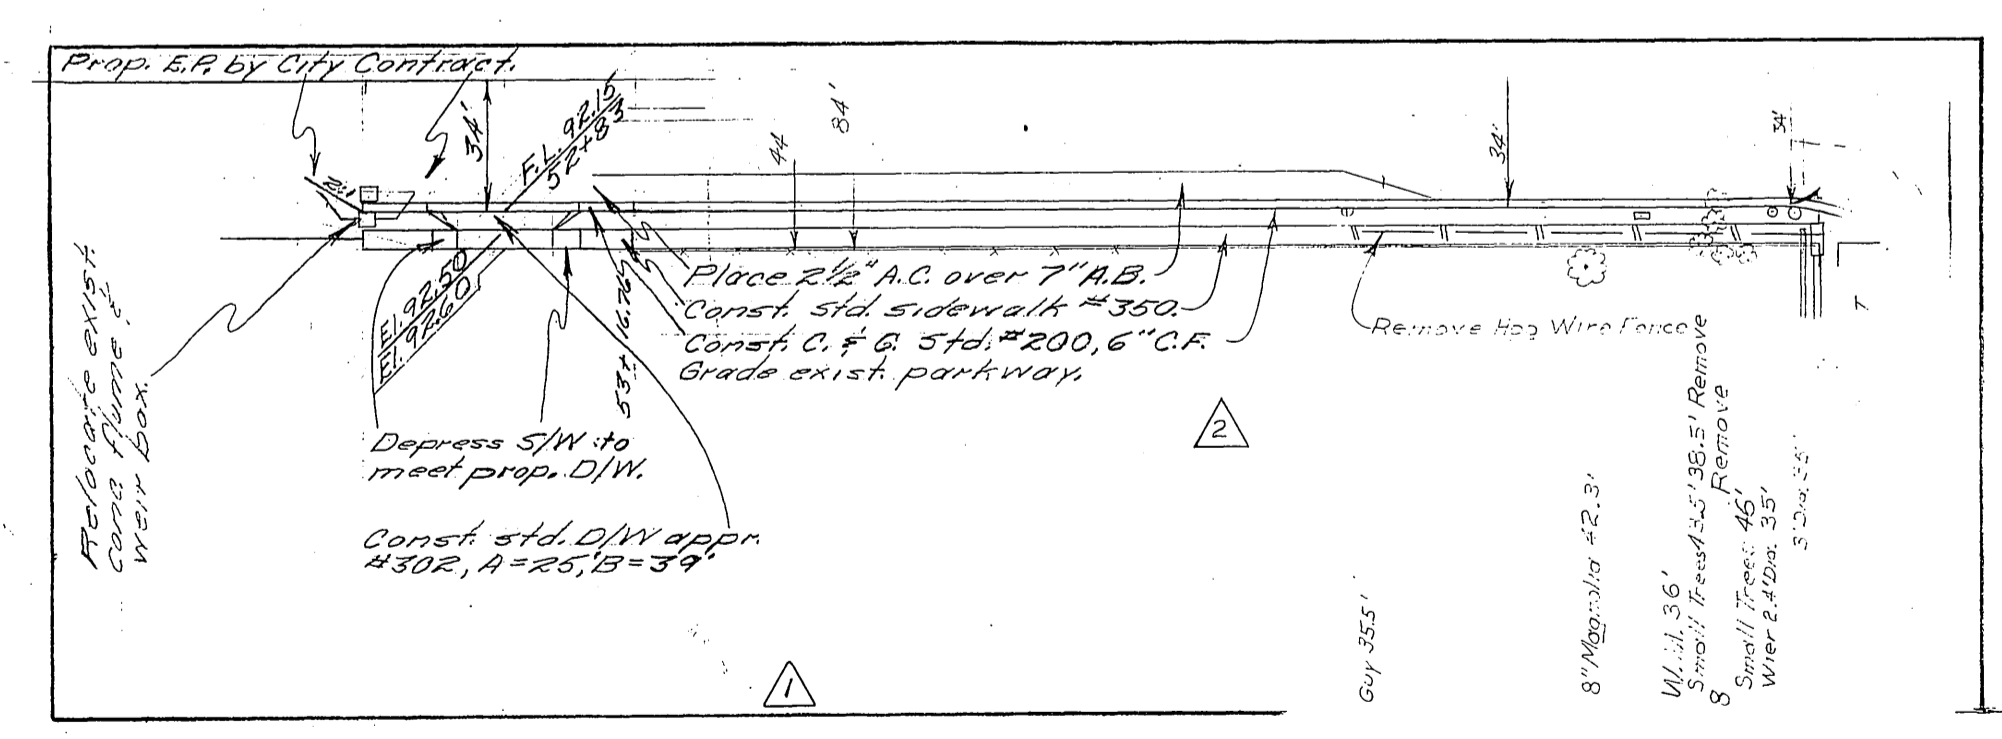


Estimate of Quantities \triangle

Curb and Gutter	370 L.F.
Aggregate Base Class I	48 tons
Aggregate Base Class II	18 cu.
Asphalt Concrete	30 tons
Subgrade	1925 sq. ft.
Driveway Approach	253 sq. ft.
Manhole Frame	1
Relocate Weir Box	L.S.

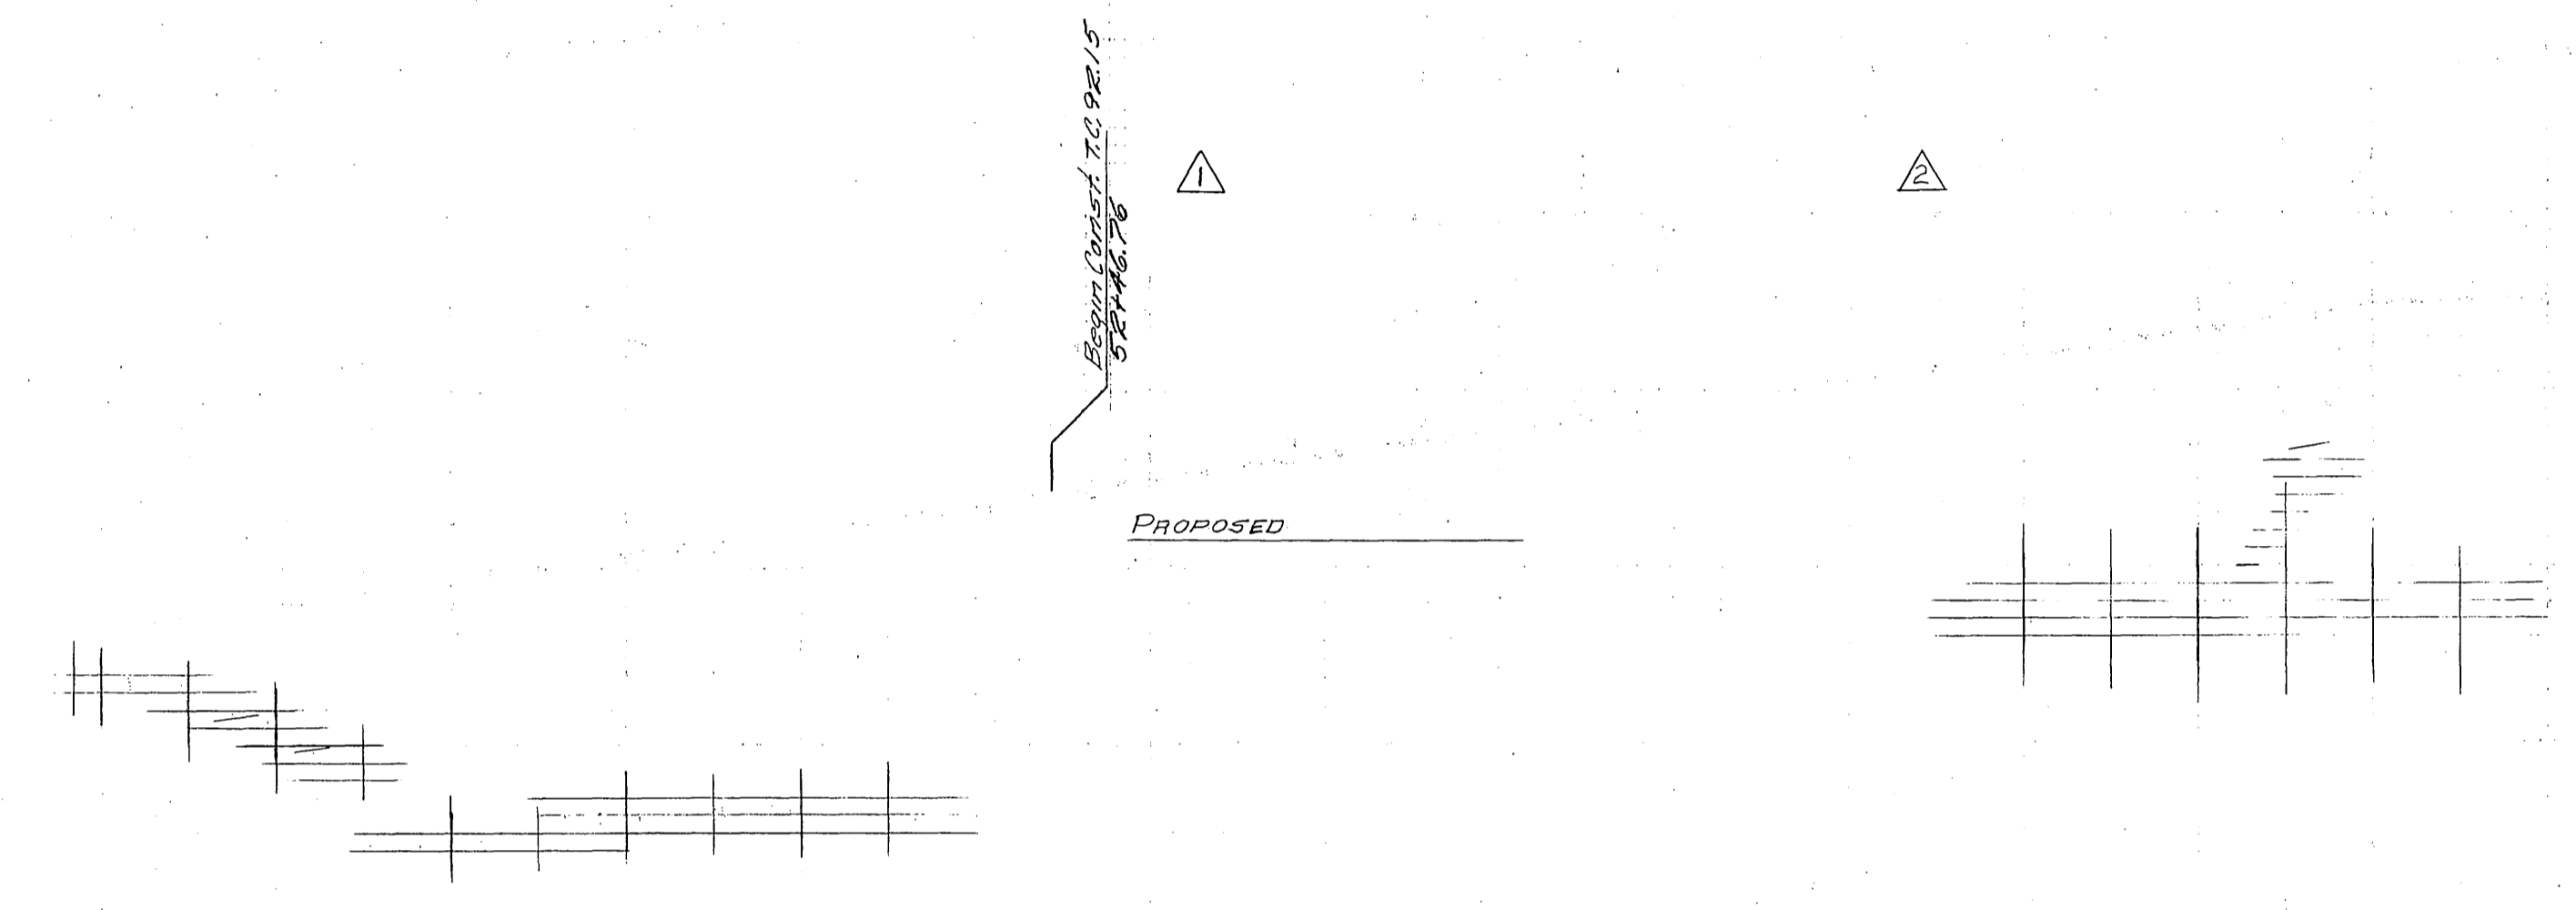

- Legend
- Place 2 1/2" A.C. over 7" A.B.
 - Concrete Construction
 - A.C. to be constructed by City contractor.

\triangle 6-8-64 Modified from Plans P-752 for R/S 35/73 and R/S 35/73
 \triangle Modified to include C.F.G. S.W. and Paving from Sta. 53+6.76 to Sta. 56+50 Same per C.S.R. OK J.D.M.

INDEXED 3.M.

BETWEEN
MAGNOLIA AVE. & COLEMAN ST.

878