



BENCH MARK Elev. 776.587 **FB 555/30**
Spike & Lead in West curb of Streeter Ave. 40' North of Sierra St. West.

GENERAL NOTES:

- It shall be the responsibility of the contractor to clear the right of way in accordance with the provisions of law as it affects each utility including irrigation lines and appurtenances and at no cost to the City.
- Construction shall be in accordance with the City of Riverside, Department of Public Works, Specifications No. 461 and Standard Drawings.
- Prime Coat, seal coat, and paint binder are required.
- Grading will require a permit under Ordinance 3093 for a cut or fill exceeding 100 cubic yards, or a fill over one foot in depth.
- NOTICE TO CONTRACTOR:** The existence and location of any underground utility pipes or structures shown on these plans are obtained by a search of the available records. To the best of our knowledge, there are no existing utilities except as shown on these plans. The Contractor is required to take due precautionary measures to protect the utility lines shown and any other lines not of record or not shown on these plans.
- Trim edge of existing pavement, where new paving joins existing pavement, to a clean straight line. Construct match-up paving as shown and overlay paving as directed in the field to produce a smooth crown section.

At time of future work in this area intersection is to be investigated for removing hump in pavement.

Existing catch basin to be remodeled to junction M.M. (Future)

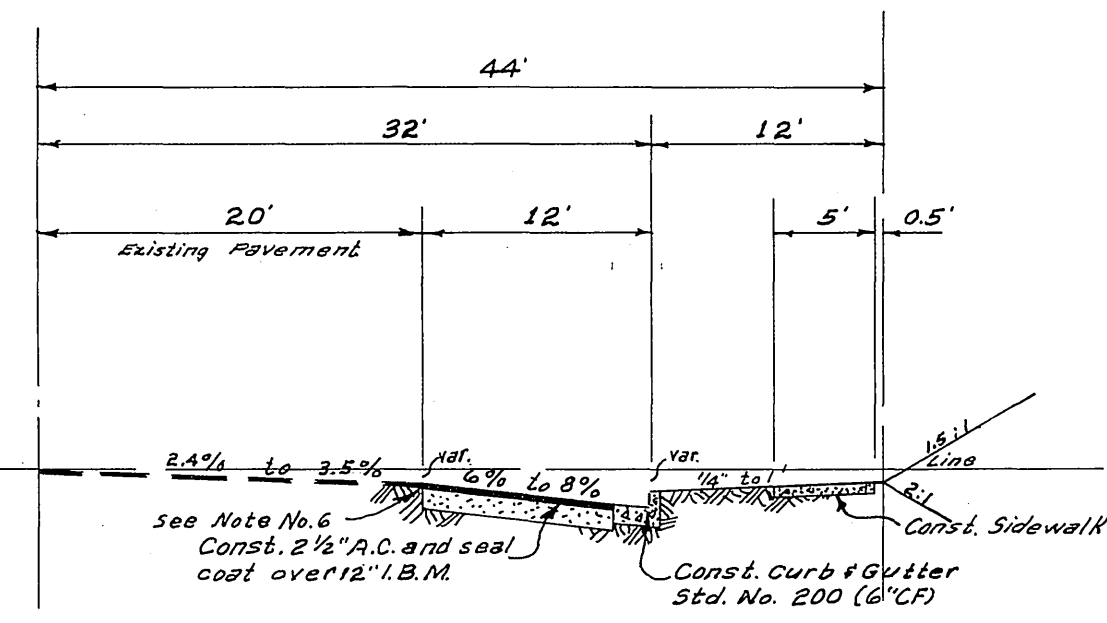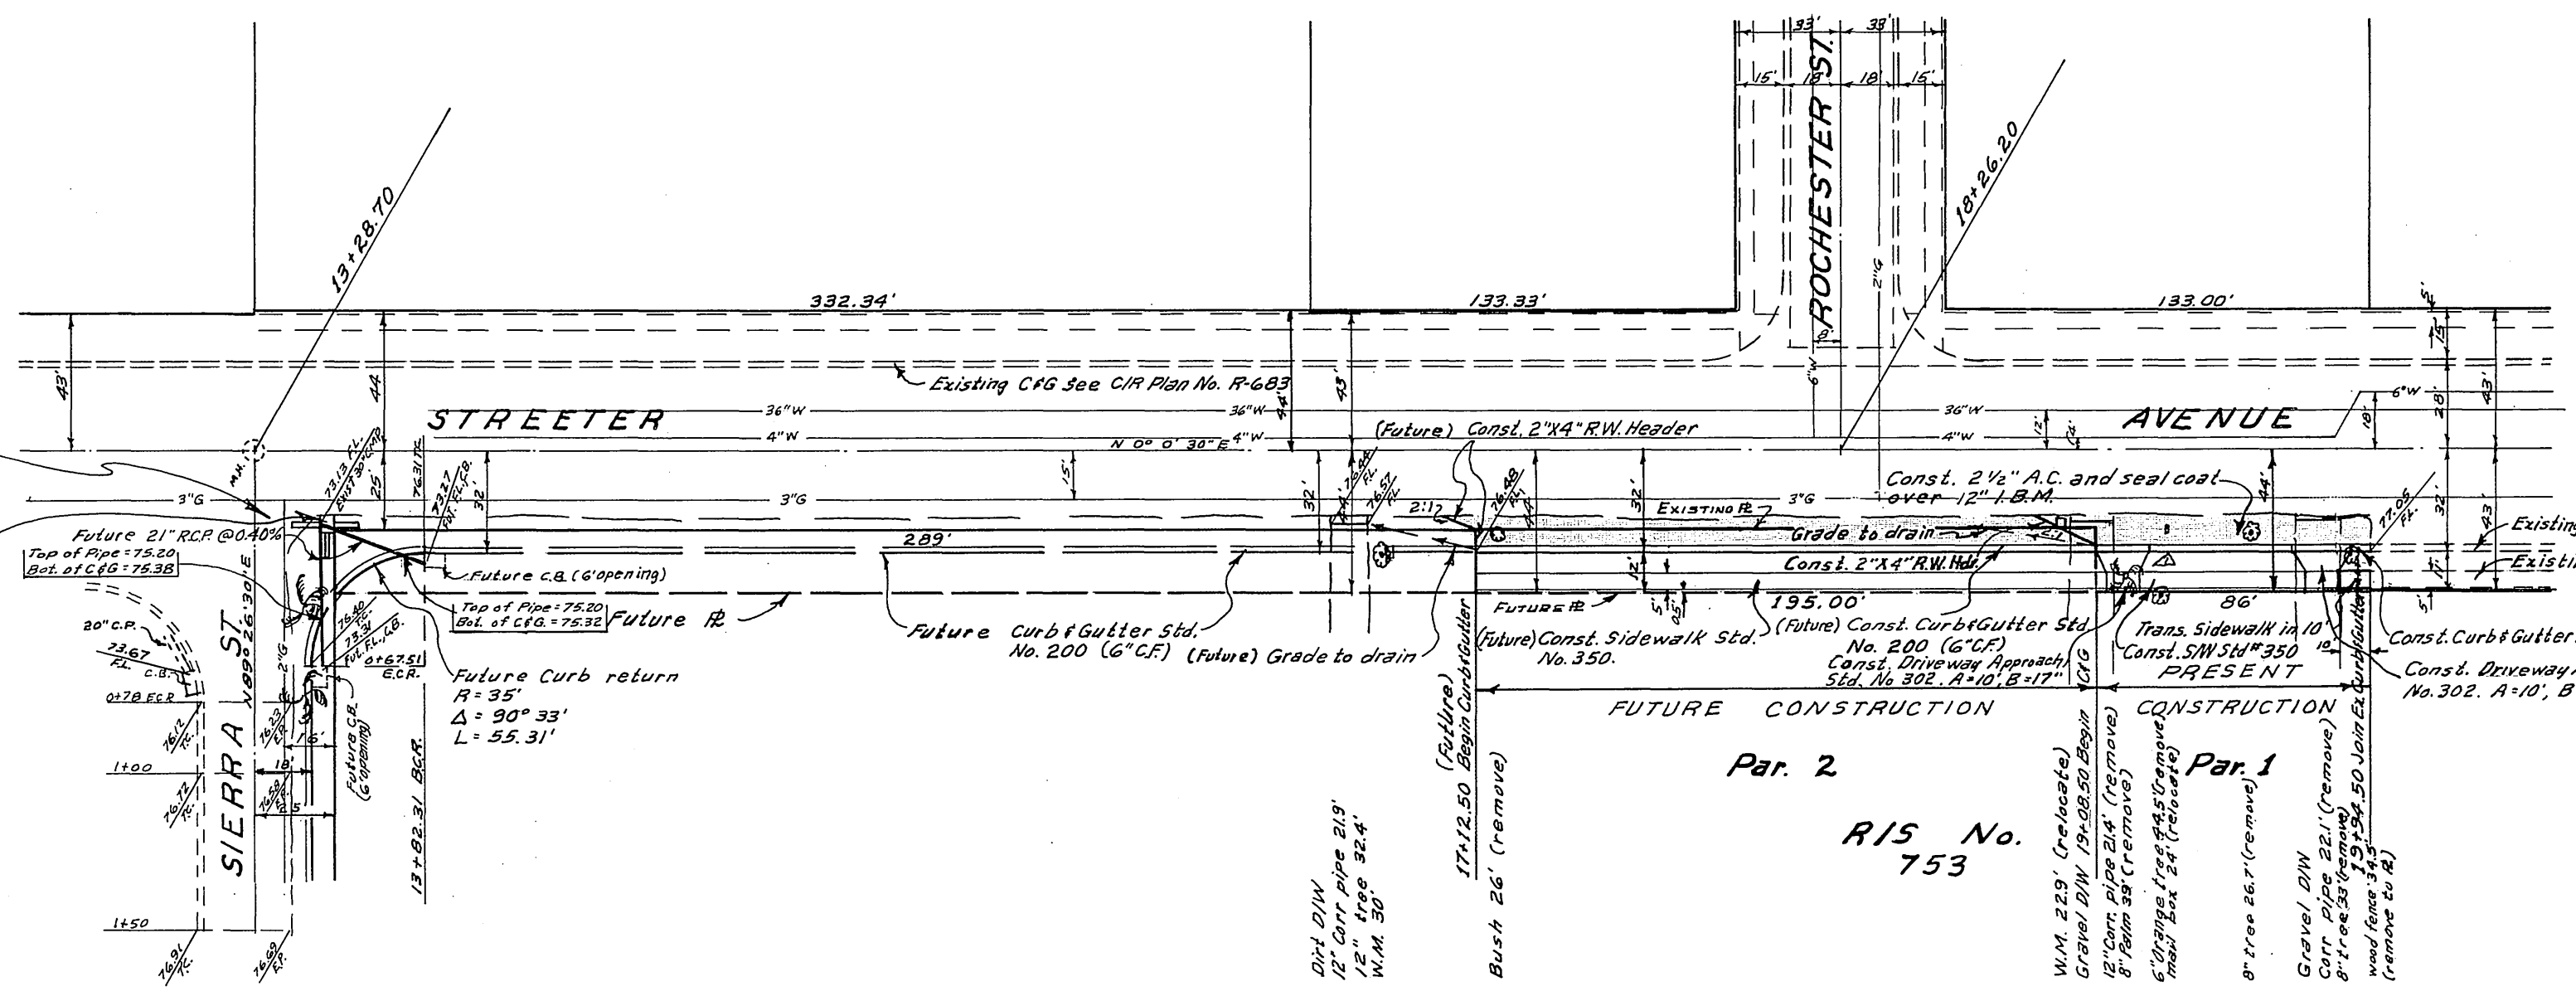

TYPICAL SECTION
STREETER AVENUE
No scale

PARCEL No. 2
QUANTITY ESTIMATE

Curb & Gutter Standard No. 200 (6" C.F.)	195	L.F.
Sidewalk Standard No. 350 (5')	975	S.F.
2 1/2" A.C. and seal coat	1,600	S.F.
2" x 4" Redwood Header	15	L.F.
Imported Base Material	59	CY.

PARCEL No. 1
QUANTITY ESTIMATE

Curb and Gutter Standard No. 200 (6" C.F.)	52	L.F. Δ
Sidewalk Standard No. 350 (5')	430	S.F.
2 1/2" A.C. and seal coat	900	S.F.
2" x 4" Redwood Header	21	L.F.
Driveway Approach Std. No. 302	310	S.F. Δ
Imported Base Material	33	CY.

APPROVED *Rommie E. Davenport*
Park Superintendent
Date 7-27-64

INDEXED D.M.
ALBERT A. WEBB ASSOCIATES
CIVIL ENGINEERS
RIVERSIDE *Albert A. Webb* CALIFORNIA
RE 1976 8/8/64

REVISIONS

MARK	DATE	DESCRIPTION
Δ	12-31-60	Added D.W. Approach & Revised Curbs, etc. (see attached sheet)

CITY OF RIVERSIDE CALIFORNIA
DEPARTMENT OF PUBLIC WORKS
STREET PLAN & PROFILE
STREETER AVENUE
BETWEEN
SIERRA ST AND CENTRAL AVE.
RIS No. 753

DESIGNED BY: *W.D.S.*
DRAWN BY: *W.D.S.*
RECOMMENDED BY: *A.M. Chisholm*

CHECKED BY: *AWK*
DESIGNED BY: *W.D.S.*
DATE: 9-23-64
SHEET 1 OF 1