TRANSIT AND SWING TIES
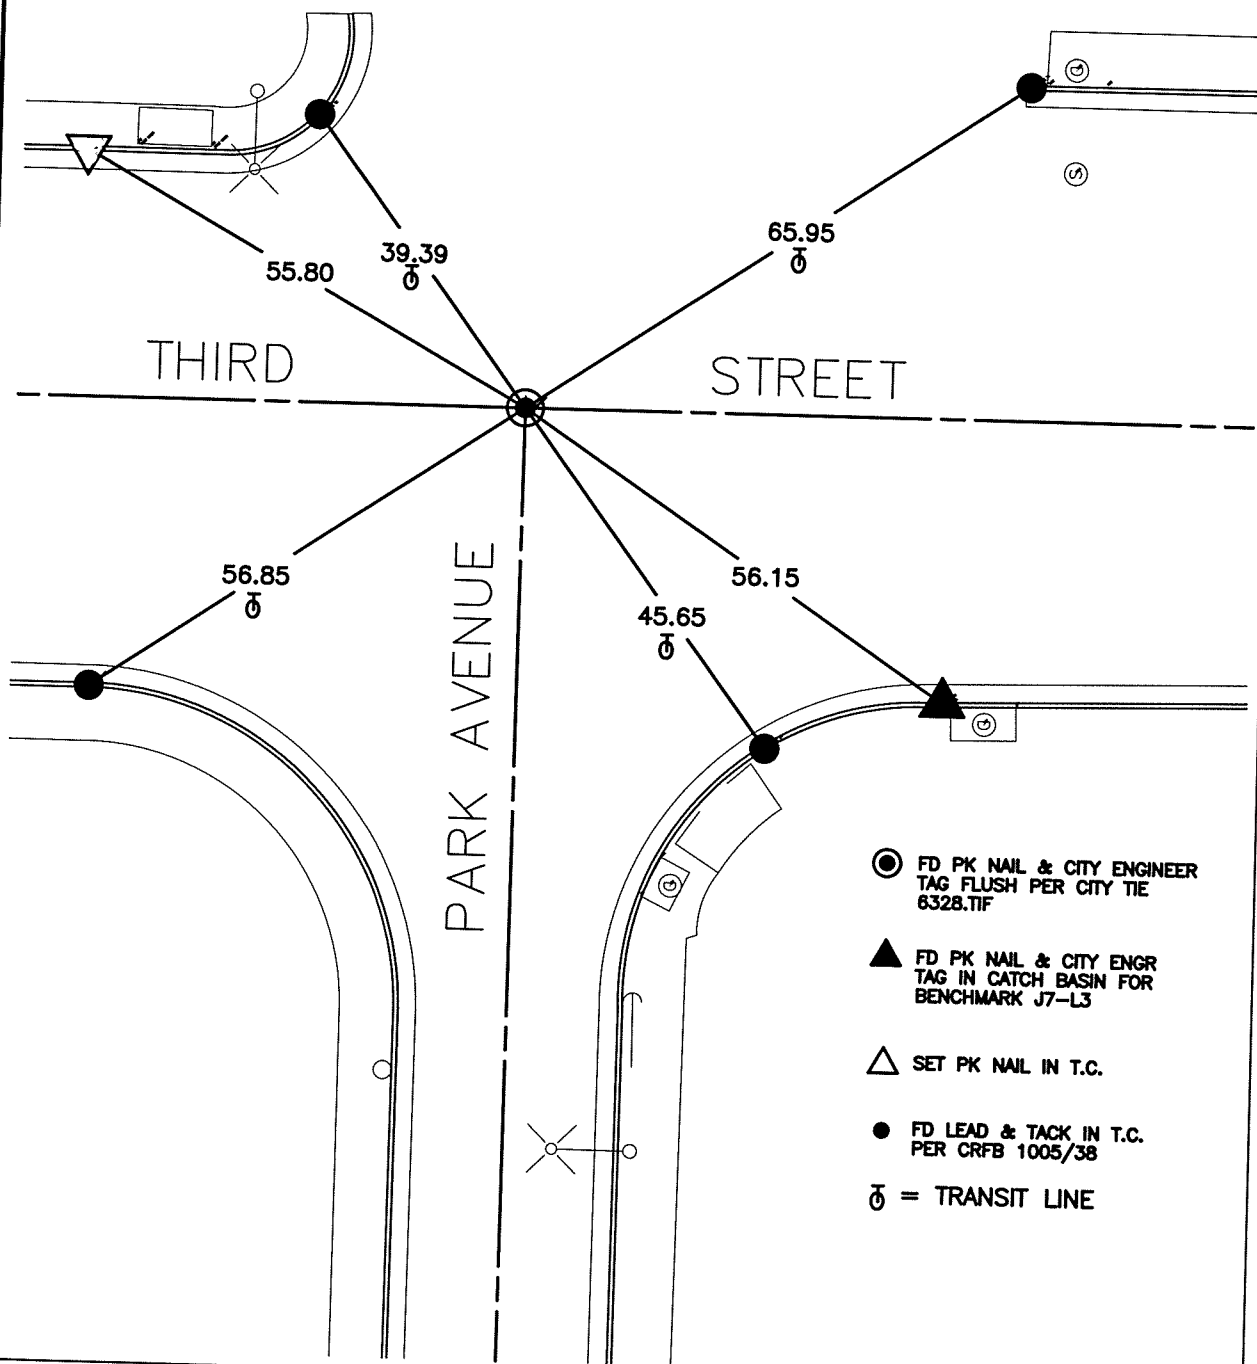
REF: 6328.TIF
CRFB 1005/38
CRFB 703/51

14075.TIF

STREET: THIRD STREET

OFFICIAL USE ONLY

X-STREET: PARK AVENUE

65.95

39.39

55.80

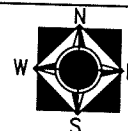THIRD   STREET

56.85

56.15

45.65

PARK AVENUE

◎ FD PK NAIL & CITY ENGINEER
TAG FLUSH PER CITY TIE
6328.TIF

▲ FD PK NAIL & CITY ENGR
TAG IN CATCH BASIN FOR
BENCHMARK J7-L3

△ SET PK NAIL IN T.C.

● FD LEAD & TACK IN T.C.
PER CRFB 1005/38

ᗢ = TRANSIT LINE

SCALE: 1"=20'	OFFICIAL TIE PLAT	
DATE: 7/06/12	CITY OF RIVERSIDE	N W E S
DRAWN BY: CURT		
F.B.:	THESE TIES ARE FOR THE PURPOSE OF PERPETUATING THE FOUND MONUMENTATION. NO CLAIM IS MADE AS THE RELATIONSHIP OF THE POINTS OR LINES SHOWN HEREON TO TRUE BOUNDARY LOCATIONS	
SEC. 24 T.2S.,R.5W		SHEET 1 OF 1