



PH E DAGE M

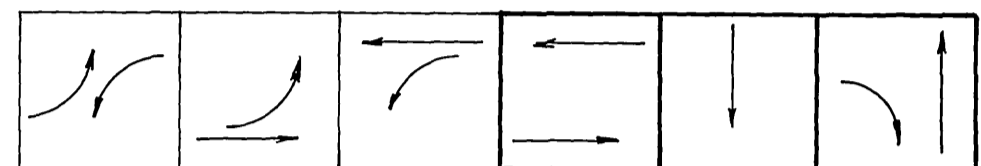


ON RE

CTO												
VEHICLE #	#/L	T/W	3	3	3	3	0					
7 (future)												
8 (future)												
PEDESTRIAN			2	2	2	2	2	2	2	2	2	2
7												
8												
PED PUSHBTR			1	1	1	1	1	1	1	1	1	1
7												
8												
SPACES			3	3	3	3	3	3	3	3	3	3

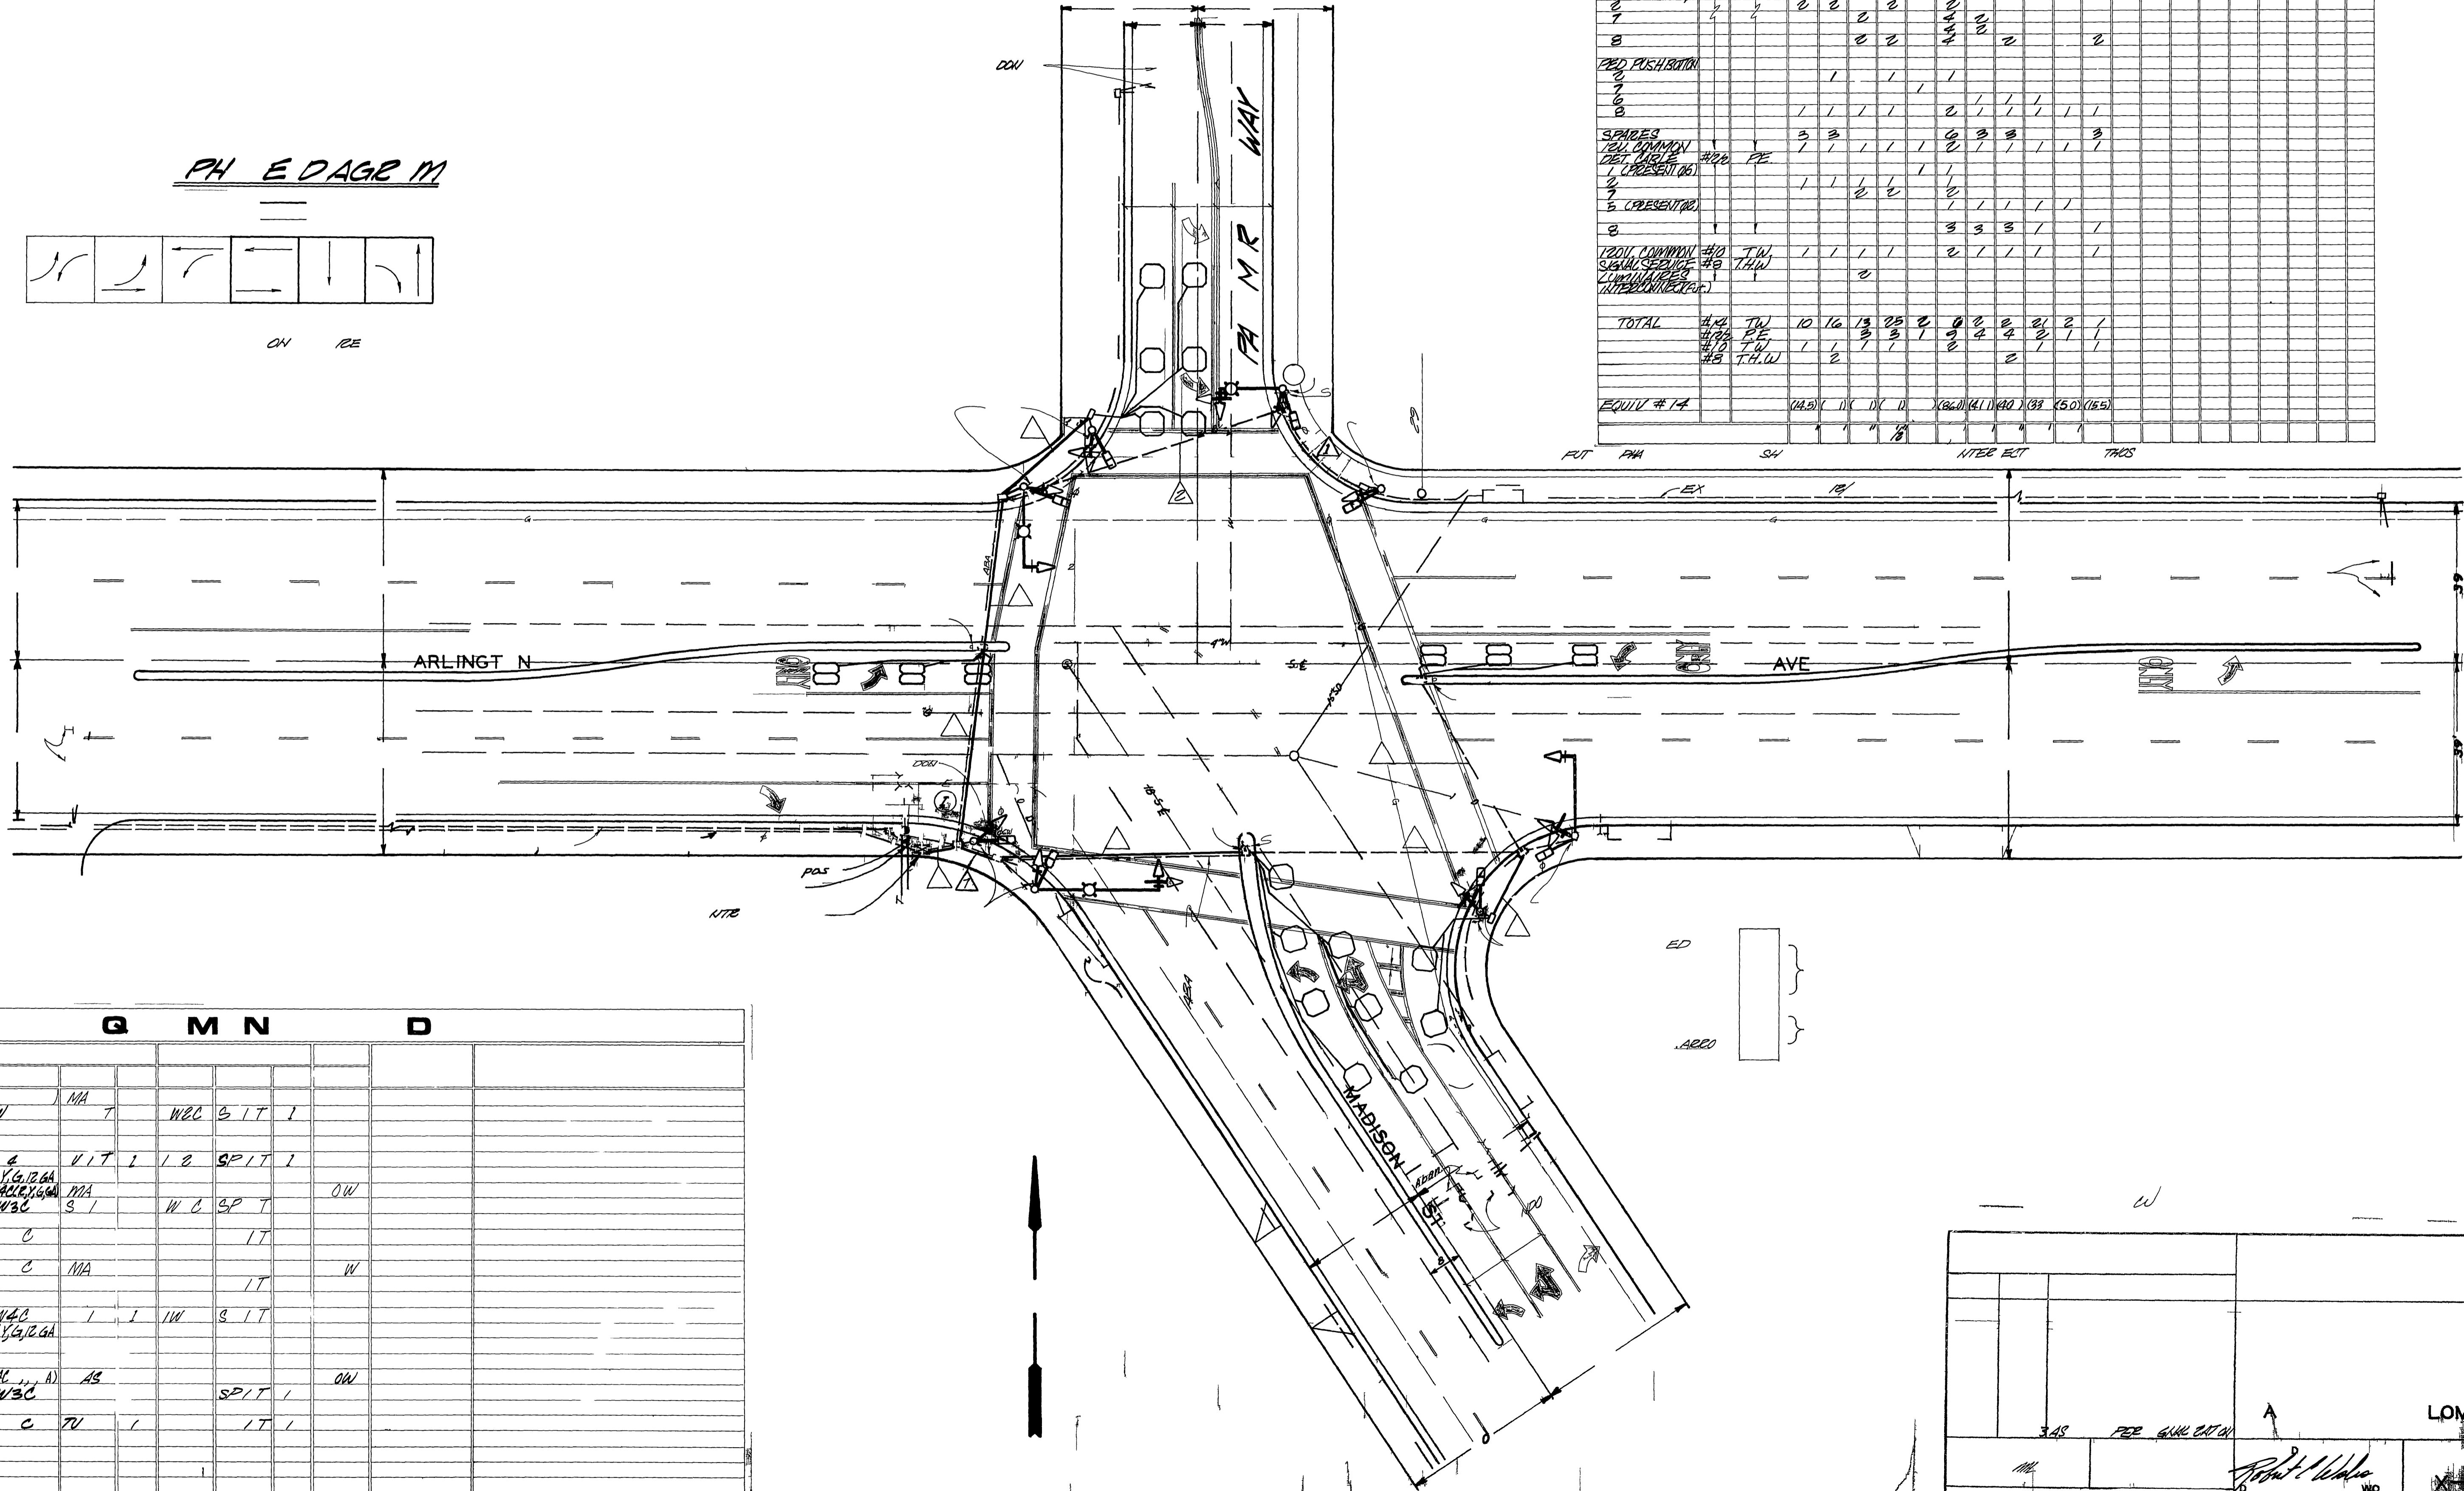

G M N D									
A	B/O G/B	I	MA						
	W/LA/B SA	W	T	W/C	S	I	T	I	
B	1A(10)	1	VIT	I	I	S	P	I	I
	1/1 G/12 GA								
	70	W/C	1/1 G/12 GA	MA					OW
	W/LA/SA	W/C	S	I	W	C	S	P	T
	1A(1)	C							IT
	Y	II	C	MA					IT
									W
F	1A(1)	W/C	I	I	W	S	I	T	
	PED/PT	1/1 G/12 GA							
	1A(1)	W/C	A	AS					OW
	5/4/30 SA	W/C							S
									P
I	1A(1)	C	TU	I					IT

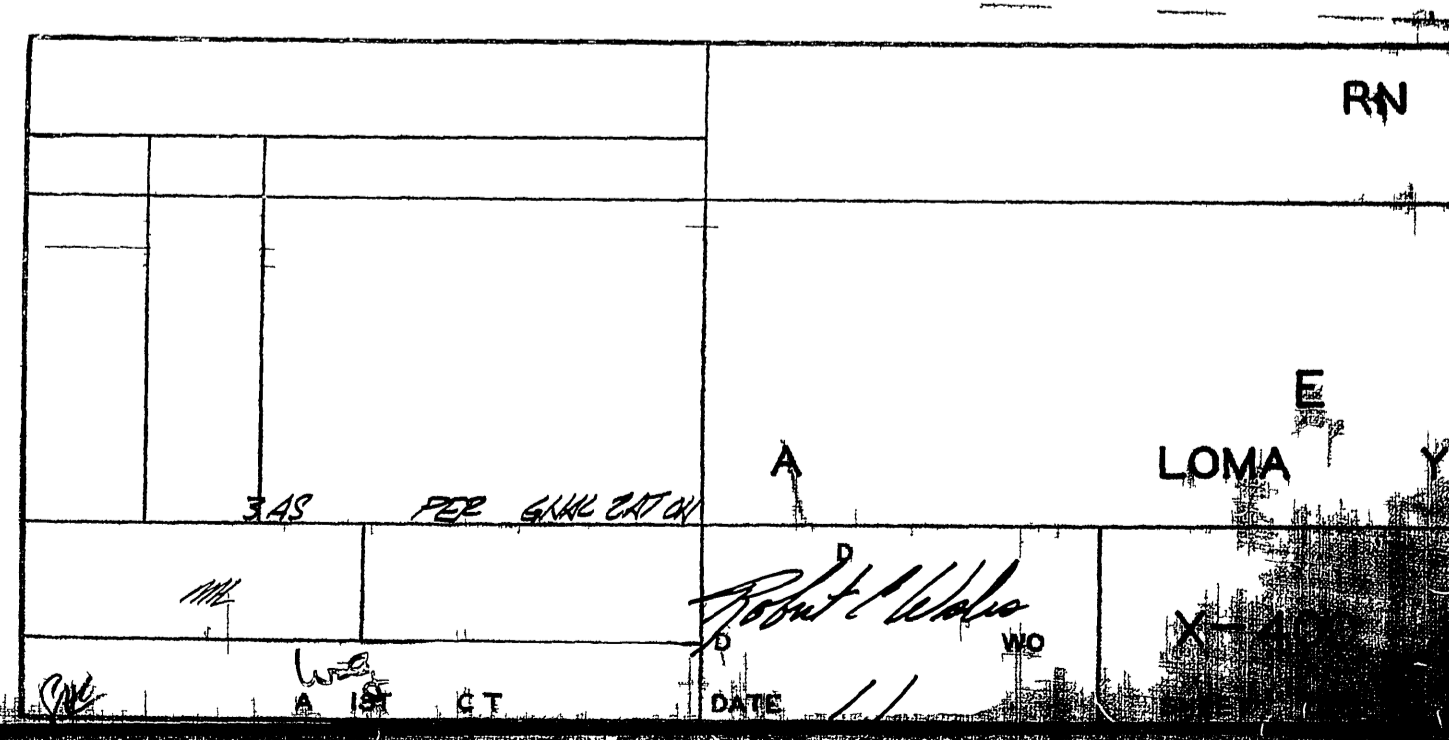

DATE

# CONDUCTOR SCHEDULE


CONTROL FUNCTION	CONDUCTORS: SIZE INSULATION	CONDUIT RUN																				
		1	2	3	4	5	6	7	8	9	10	11										
VEHICLE Ø'S	#14 TW																					
1 (FUTURE)																						
2																						
7																						
5 (FUTURE)																						
6																						
8																						
PEDESTRIAN Ø'S																						
2																						
7																						
6																						
8																						
PED/PUSH BUTTON																						
2																						
7																						
6																						
8																						
SPARES																						
12V COMMON																						
DET. CABLE	#12/2 PE																					
1 (PRESENT ØØ)																						
2																						
7																						
5 (PRESENT ØØ)																						
6																						
8																						
120V COMMON																						
SIGNAL SERVICE	#10 TW																					
LUMINAIRES	#8 THW																					
INTERCONNECT (FUT.)																						
TOTALS	#14 TW	10	10	13	25	2	56	23	21	21	2	11										
	#12/2 PE	1	1	3	3	1	9	4	4	2	1	1										
	#10 TW	1	1	1	1	1	2	1	1	1	1	1										
EQUIV #14		(19.5)	(25.1)	(28.1)	(40.1)	(5.0)	(84.0)	(41.1)	(40.1)	(33.1)	(5.0)	(15.5)										
CONDUIT SIZE		1 1/2"	2"	2"	2 1/2"	2"	3"	2"	2 1/2"	2 1/2"	2"	2"	2"									

## TRAFFIC SIGNAL NOTES

- TRAFFIC SIGNAL WORK SHALL BE PERFORMED IN ACCORDANCE WITH THE MOST CURRENT PROVISIONS OF SECTION 86 OF THE STANDARD SPECIFICATIONS, THE STANDARD PLANS, BOTH PUBLISHED BY THE STATE OF CALIFORNIA DEPARTMENT OF TRANSPORTATION (CALTRANS), THE CONSTRUCTION PLAN(S), AND AS DIRECTED BY THE CITY TRAFFIC ENGINEER.
- THIS TRAFFIC SIGNAL WORK REQUIRES A "STREET OPENING" PERMIT OBTAINED AT THE PUBLIC WORKS COUNTER ON THE THIRD FLOOR OF CITY HALL.
- CONTACT TRAFFIC SIGNAL MAINTENANCE AT (714) 782-5748, 48 HOURS IN ADVANCE TO SCHEDULE INSPECTION OF THE WORK PERFORMED. INSPECTION FEE FOR TRAFFIC SIGNAL MODIFICATIONS WILL BE AT THE RATE OF \$29.35 PER HOUR.
- ALL EQUIPMENT AND LOOP LOCATIONS SHALL BE APPROVED BY THE TRAFFIC ENGINEER OR HIS DESIGNATED REPRESENTATIVE PRIOR TO INSTALLATION BY THE CONTRACTOR.
- DETECTOR LOOPS SHALL BE INSTALLED IN THE PRESENCE OF THE CITY TRAFFIC ENGINEER'S REPRESENTATIVE. ALL LOOPS SHALL BE 6' X 6'. SLOTS FOR THE DETECTOR LOOPS SHALL BE CUT TO A DEPTH THAT WILL PROVIDE FOR A 1" COVER OVER THE CONDUCTORS.
- DETECTOR LOOP LEAD-IN CABLE SHALL BE TYPE B.
- CONDUIT SHALL BE RIGID METALLIC CONDUIT. INTERMEDIATE METALLIC CONDUIT IS NOT ALLOWED.
- PIPE MID-TENONS FOR MAST ARM MOUNTING (ENDS) SHALL BE PERPENDICULAR TO THE ARM.
- CONDUCTORS FOR EACH DETECTOR LOOP SHALL BE TYPE 1; LEAD-IN CABLE SHALL BE TYPE B.

## CONSTRUCTION NOTES

- RR** REMOVE AND REUSE EQUIPMENT. EXISTING SIGNAL FOUNDATION BASE TO BE COMPLETELY REMOVED.
- S** INSTALL NEW #5 PULLBOX.
- D** INSTALL NEW DETECTOR LOOPS.
- CC** CONNECT NEW AND EXIST. CONDUIT. REMOVE EXIST. CONDUCTORS AND INSTALL NEW CONDUCTORS. NO SPLICING ALLOWED. CONTRACTOR TO INSTALL NEW CONDUCTORS FROM EXIST. CONTROLLER AND "P" CABINET TO SIGNAL POLE ON N.E. COR. OF PALOMAR AND ARLINGTON. REF. CONDUIT RUN  $\Delta$ - $\Delta$ .
- RN** REMOVE EXISTING SIGNAL EQUIPMENT, POLE AND FOUNDATION (FOUNDATION BASE TO BE COMPLETELY REMOVED). INSTALL NEW POLE, 24'-4"-80, 15' LA, 35' SA, NEW SIGNAL EQUIPMENT AND RELOCATE EXISTING LUMINAIRE.
- AB** ABANDON IN PLACE AND REMOVE CONDUCTORS.
- $\Delta$  INDICATES CONDUCTOR RUN. REFER TO CONDUCTOR SCHEDULE FOR SIZE, TYPE AND NUMBER OF REQUIRED CONDUCTORS. NEW CONDUCTORS SHALL BE PULLED FROM THE CONTROLLER. NO SPLICING ALLOWED.
- $\Delta$  INDICATES CONDUIT SIZE
- R** REMOVE EXIST. PAVEMENT MARKINGS BY WET SANDBLASTING.
- S1** PROP. CROSSWALK STRIPING - 12" WIDE, WHITE
- S2** PROP. LEFT TURN ARROW - WHITE

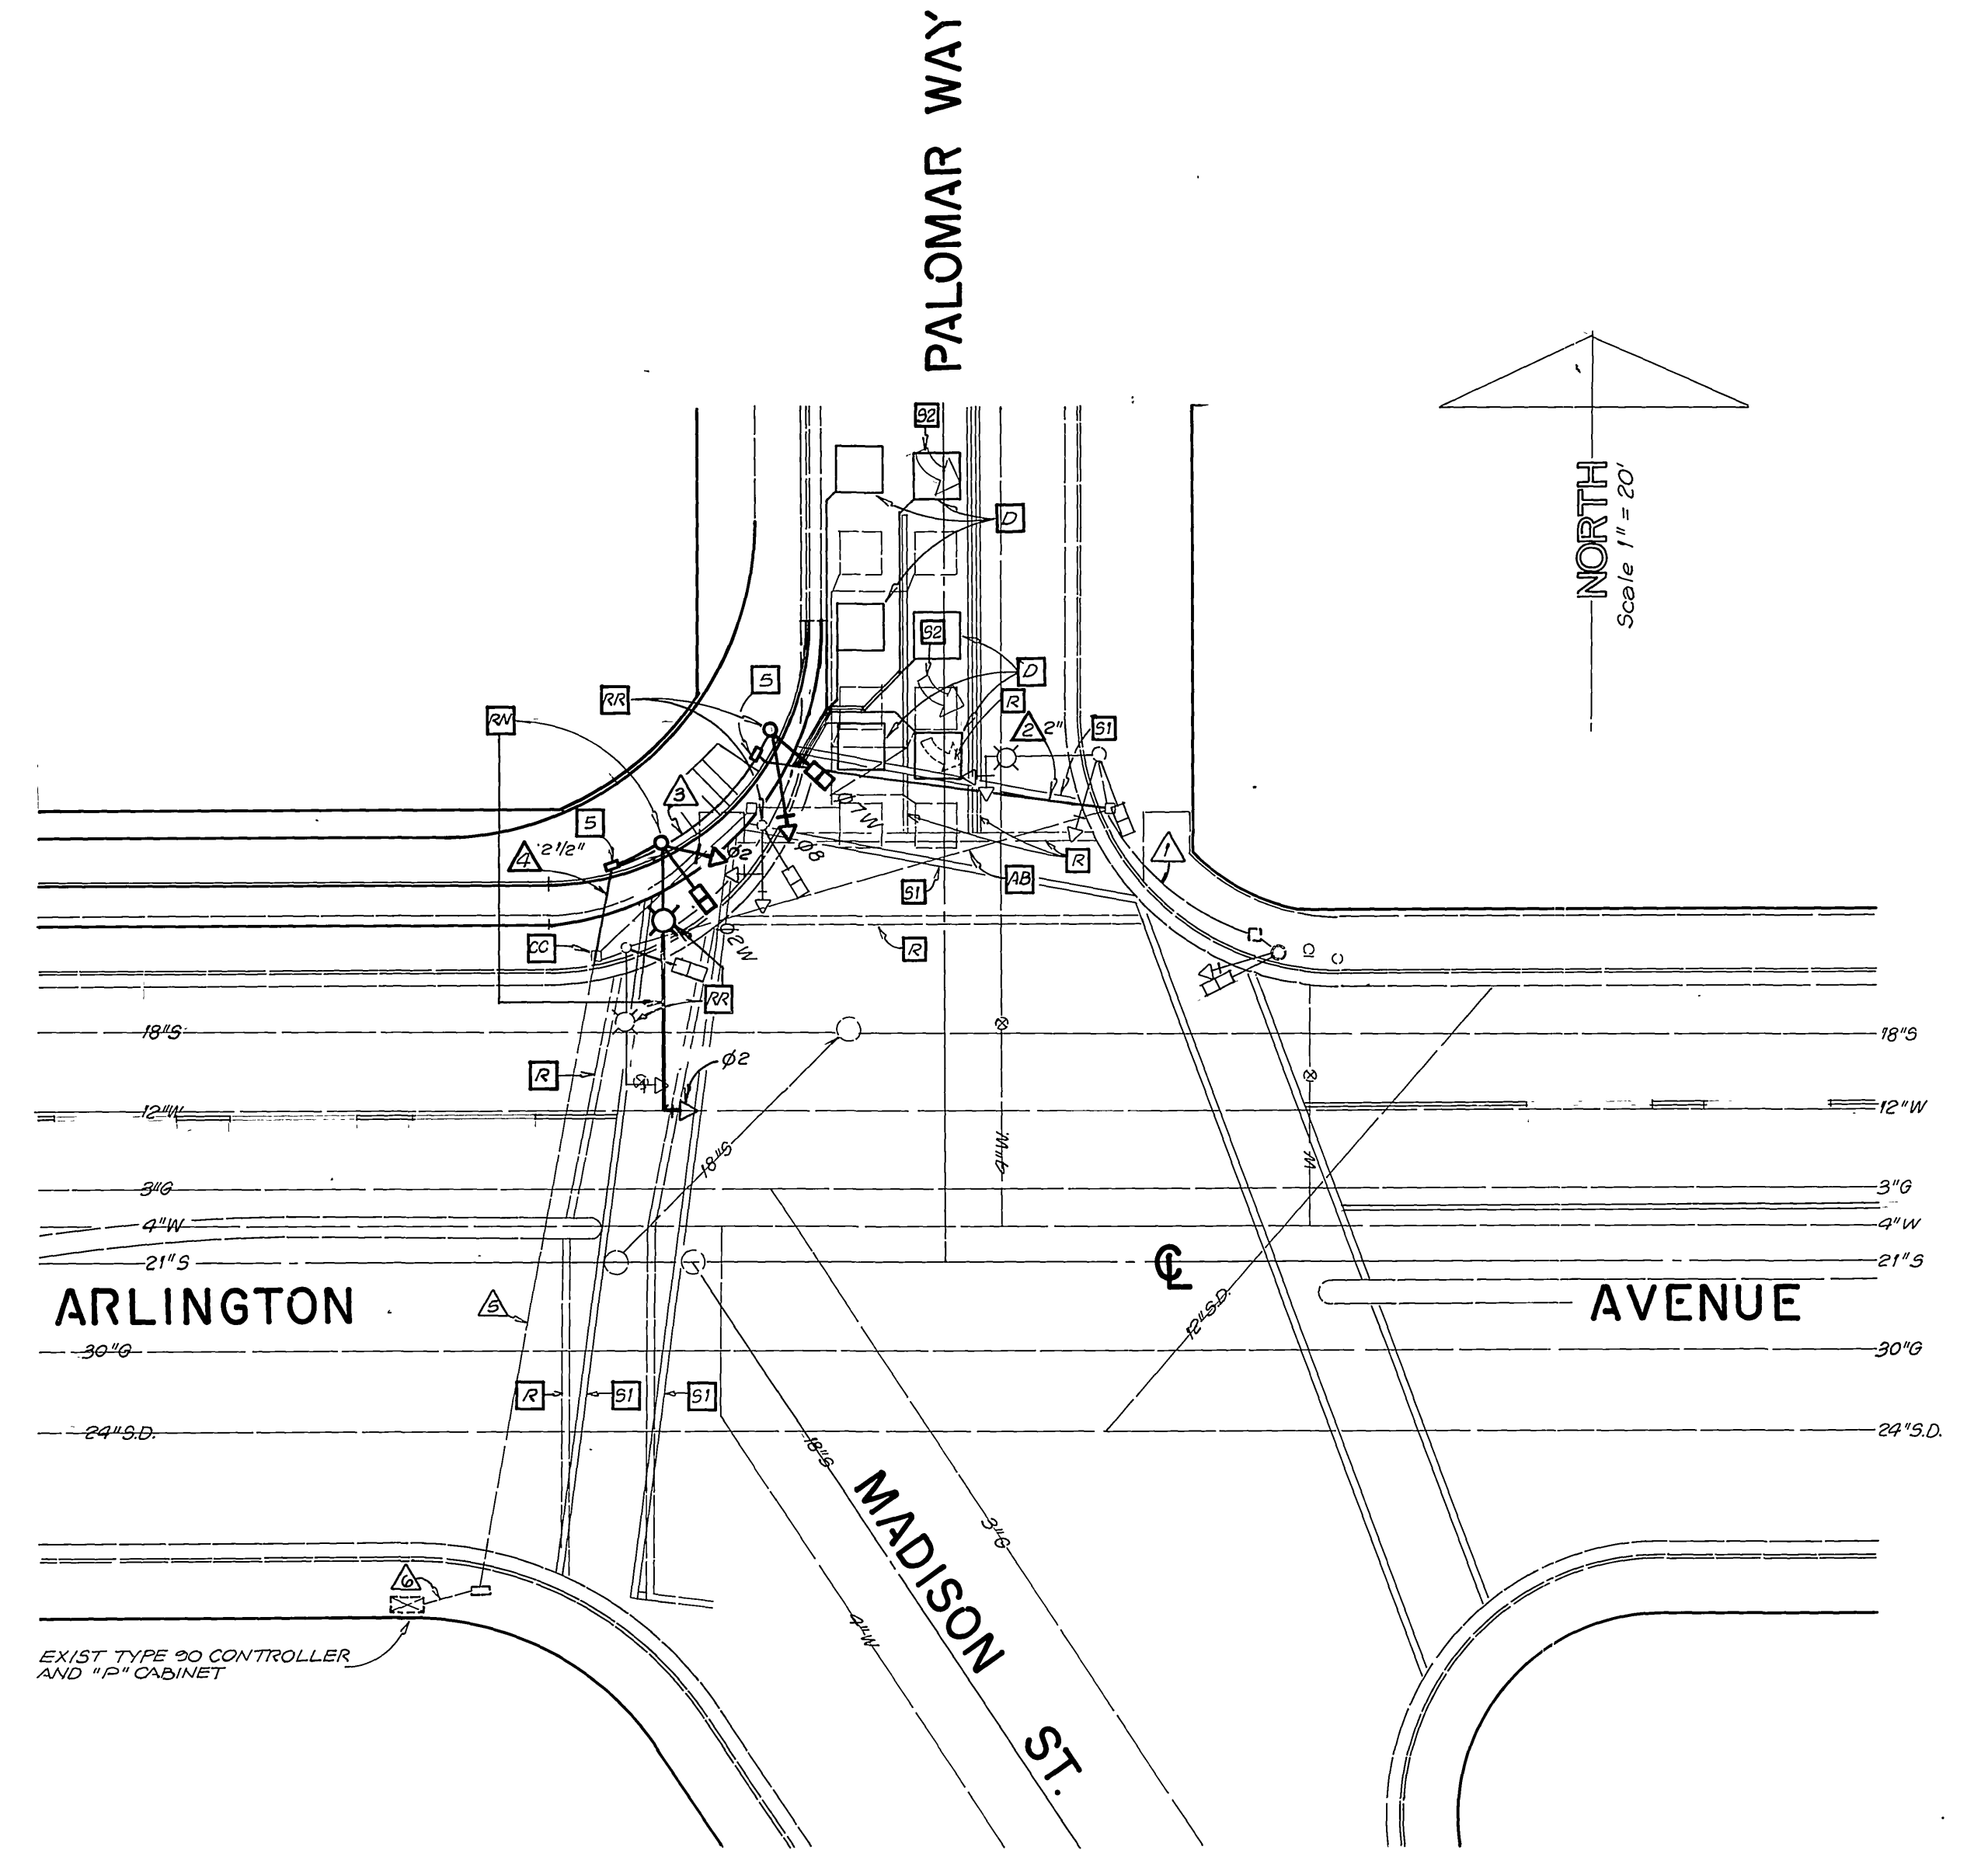

**JUNBEELER**  
LAND SURVEYING AND MAPPING  
6104 RIVERSIDE AVENUE SUITE B  
RIVERSIDE, CA. 92506  
(714) 982-2216

PLANS PREPARED UNDER THE SUPERVISION OF:  
*Mark O. Mosby*  
R.E.E. 782642 DATE 7/27/90

MARK DESIGNED BY *WLL* REVISIONS DRAWN BY *EB* APPR. DATE CHECKED BY *WLL*

**CITY OF RIVERSIDE**  
PUBLIC WORKS DEPARTMENT

APPROVED BY  
PRINCIPAL ENGINEER  
TRAFFIC DIVISION  
CHIEF P.W. ENGINEER

DATE 2/28/91  
DATE 2/28/91  
DATE 2/28/91

**ARLINGTON AVE. / PALOMAR WAY**  
TRAFFIC SIGNAL RELOCATION

APPROVED BY  
*Ray Beal*  
PUBLIC WORKS DIRECTOR  
DATE 3/1/91

ACCOUNT NO.  
(X-400A)  
R-3164  
SHEET 2 OF 2  
89-338-01


HORIZ. SCALE: 1" = 20' VERT. SCALE: 1" = NONE

INDEXED 3-8-91

BARCELONA WAY

CORONADO WAY

DETECTOR SCHEDULE			
CHANNELS	LOOP DESIGNATION	NUMBER OF LOOPS	FEATURES
1	111U	3	
2	212U	2	
3	212L	1	
4	213U	4	
5	315U	3	
6	315L	3	
7	416U	3	
8	416L	3	
9	5J1U	3	
10	6J2U	2	
11	6J2L	4	
12	319L	4	



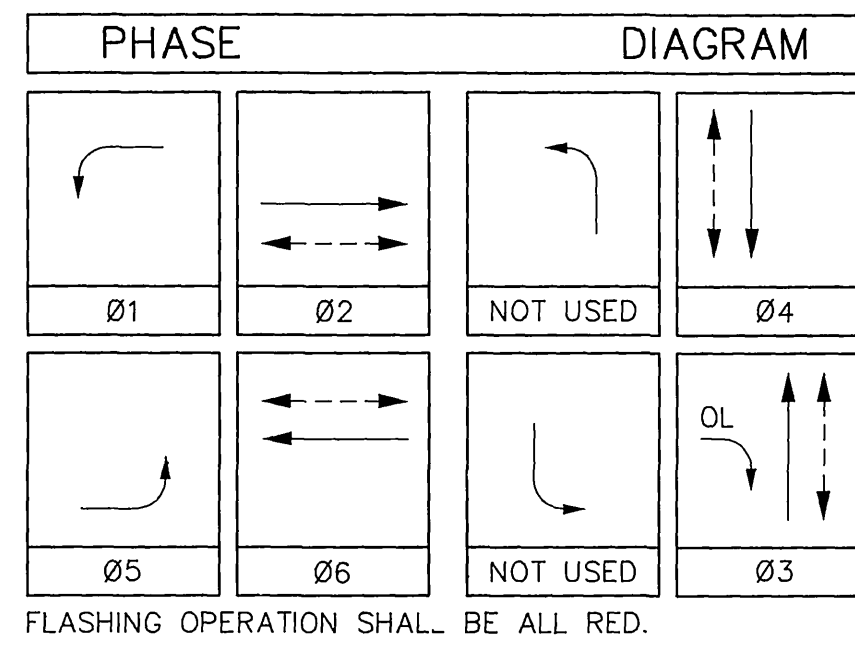


CONSTRUCTION NOTES

1.) RELOCATE STREET NAME SIGNS TO NEW POLES AS REQUIRED.

GENERAL NOTES


- DETECTOR LOOPS SHALL BE INSTALLED IN THE PRESENCE OF THE TRAFFIC ENGINEER OR HIS REPRESENTATIVE.
- ALL SIGNING, STRIPING AND PAVEMENT MARKING REQUIREMENTS SHALL BE COMPLETED AT LEAST ONE DAY PRIOR TO TURN-ON.
- TYPICAL DETECTOR LOOP SPACING: 10' AND 15'.
- PAVEMENT DELINEATION SHOWN HEREON IS FOR REFERENCE ONLY. CITY FORCES SHALL PERFORM ALL PERMANENT PAINTING (INSTALLATION AND REMOVALS) WORK.

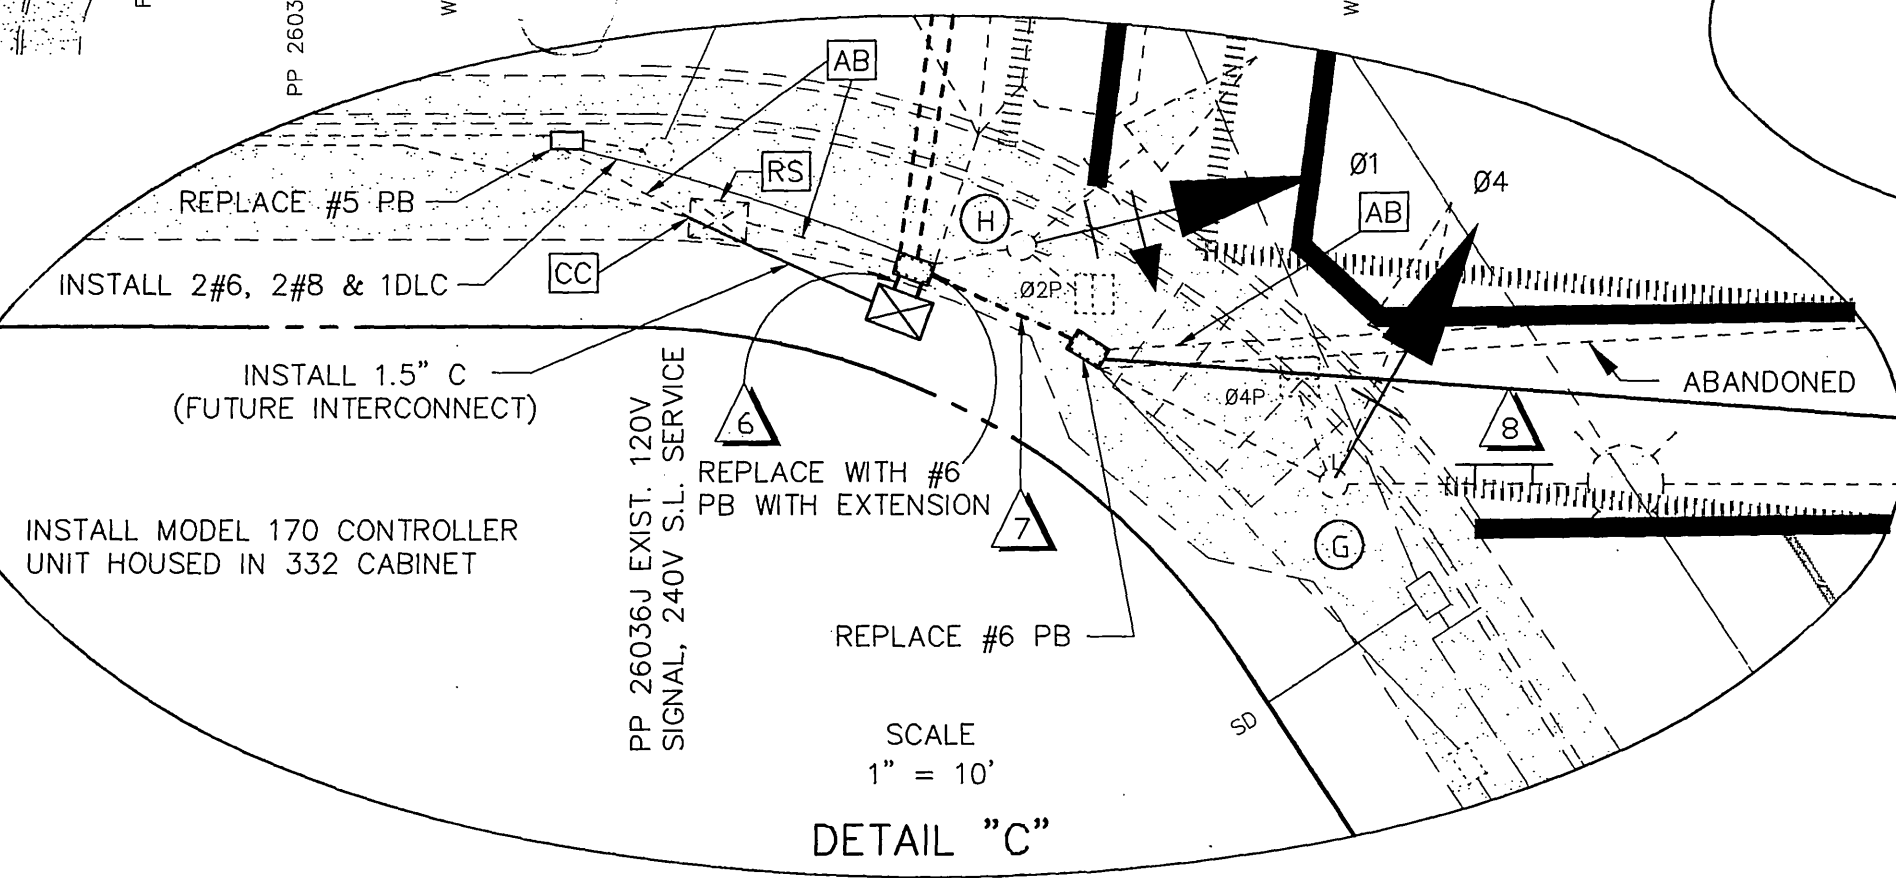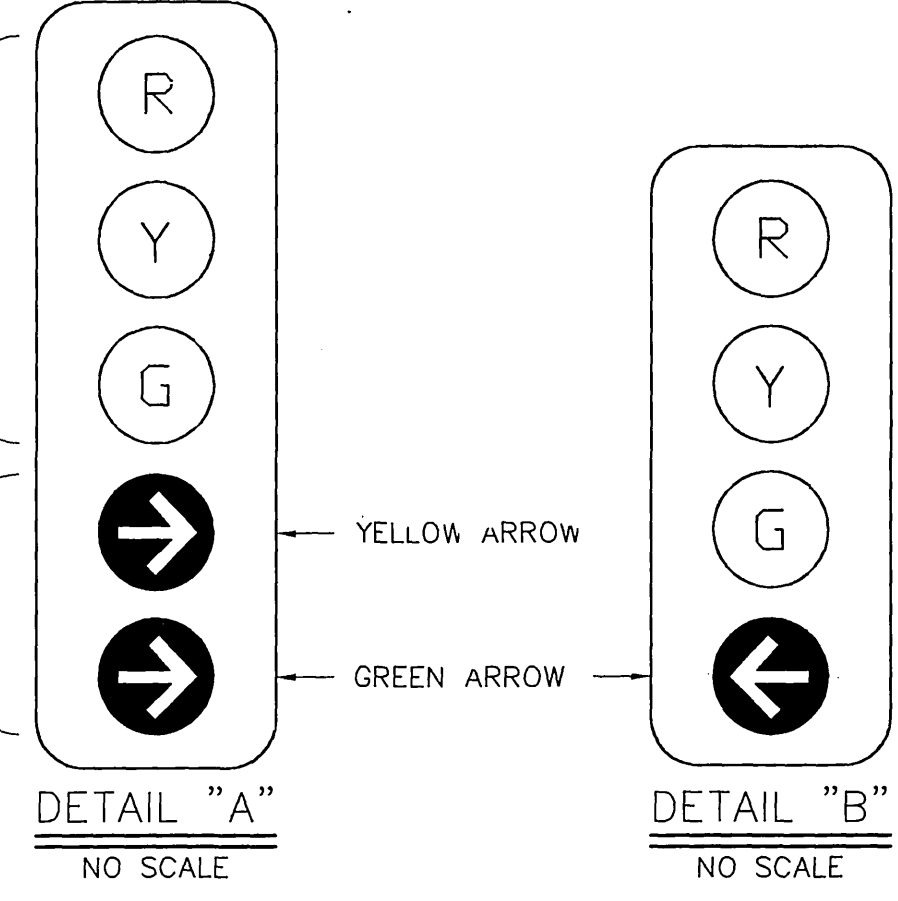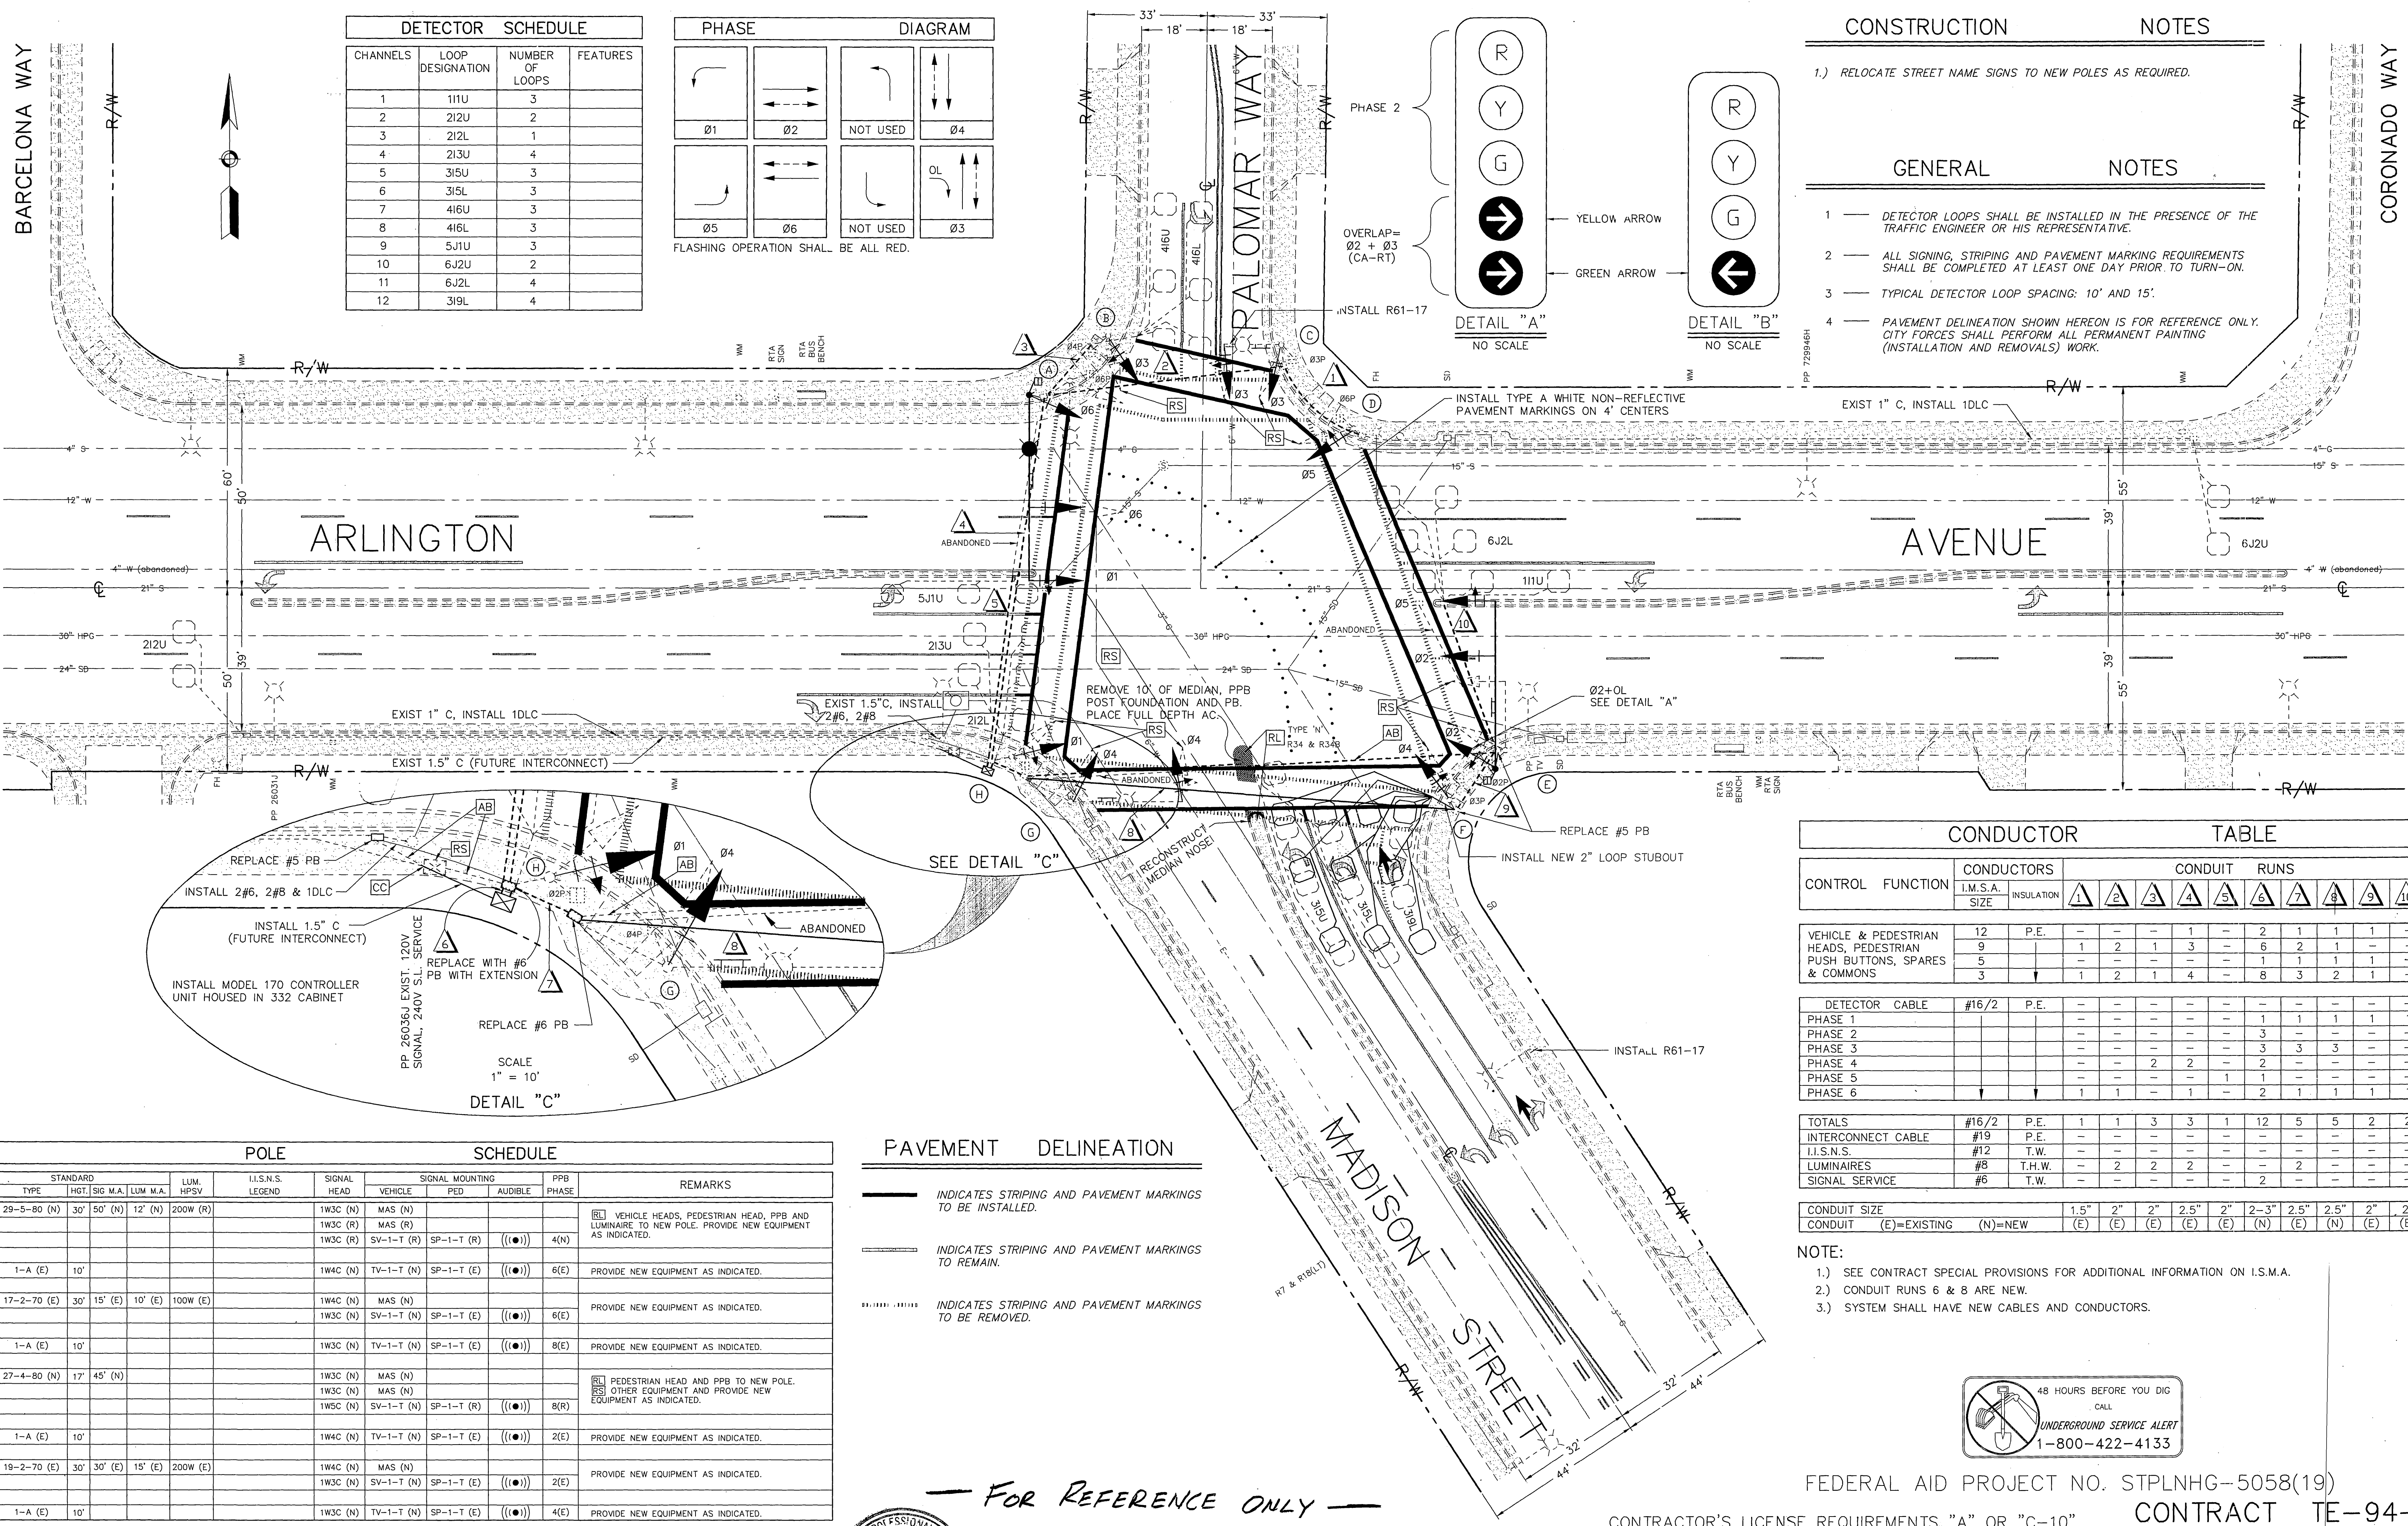

CONDUCTOR TABLE

CONTROL FUNCTION	CONDUCTORS	CONDUIT RUNS																		
		I.M.S.A. SIZE	INSULATION	1	2	3	4	5	6	7	8	9	10							
VEHICLE & PEDESTRIAN HEADS, PEDESTRIAN PUSH BUTTONS, SPARES & COMMONS	12 9 5 3	P.E.	-	-	-	1	-	2	1	1	1	-	-	-	-	-	-	-	-	-
DETECTOR CABLE	#16/2	P.E.	-	-	-	-	-	-	1	1	1	1	1	-	-	-	-	-	-	-
PHASE 1			-	-	-	-	-	-	-	3	-	-	-	-	-	-	-	-	-	-
PHASE 2			-	-	-	-	-	-	-	-	3	3	3	-	-	-	-	-	-	-
PHASE 3			-	-	-	-	-	-	-	-	-	-	-	-	-	-	-	-	-	-
PHASE 4			-	-	-	2	2	-	-	-	-	-	-	-	-	-	-	-	-	-
PHASE 5			-	-	-	-	-	-	1	1	-	-	-	-	-	-	-	-	-	-
PHASE 6			-	-	-	1	1	-	-	1	-	2	1	1	1	1	1	1	1	1
TOTALS	#16/2	P.E.	1	1	3	3	1	12	5	5	2	2	2	2	2	2	2	2	2	2
INTERCONNECT CABLE	#19	P.E.	-	-	-	-	-	-	-	-	-	-	-	-	-	-	-	-	-	-
I.L.S.N.S.	#12	T.W.	-	-	-	-	-	-	-	-	-	-	-	-	-	-	-	-	-	-
LUMINAIRES	#8	T.H.W.	-	2	2	2	-	-	-	2	-	-	-	-	-	-	-	-	-	-
SIGNAL SERVICE	#6	T.W.	-	-	-	-	-	-	-	-	-	-	-	-	-	-	-	-	-	-
CONDUIT SIZE			1.5"	2"	2"	2.5"	2"	2-3"	2.5"	2"	2"	2"	2"	2"	2"	2"	2"	2"	2"	2"
CONDUIT (E)=EXISTING (N)=NEW			(E)	(E)	(E)	(E)	(E)	(N)	(E)	(N)	(E)	(N)	(E)	(N)	(E)	(E)	(E)	(E)	(E)	(E)

NOTE:  
 1.) SEE CONTRACT SPECIAL PROVISIONS FOR ADDITIONAL INFORMATION ON I.S.M.A.  
 2.) CONDUIT RUNS 6 & 8 ARE NEW.  
 3.) SYSTEM SHALL HAVE NEW CABLES AND CONDUCTORS.

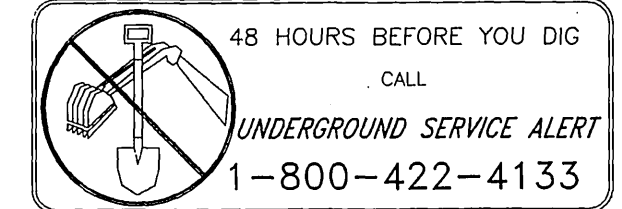

FEDERAL AID PROJECT NO. STPLNHG-5058(19)  
 CONTRACTOR'S LICENSE REQUIREMENTS "A" OR "C-10" CONTRACT TE-94-3

POLE SCHEDULE

No.	STANDARD TYPE	HGT.	SIG. M.A.	LUM. M.A.	LUM. HPSV	I.L.S.N.S. LEGEND	SIGNAL HEAD	SIGNAL MOUNTING			PPB PHASE	REMARKS
								VEHICLE	PED	AUDIBLE		
Ⓐ	29-5-80 (N)	30'	50' (N)	12' (N)	200W (R)		1W3C (N)	MAS (N)				VEHICLE HEADS, PEDESTRIAN HEAD, PPB AND LUMINAIRE TO NEW POLE. PROVIDE NEW EQUIPMENT AS INDICATED.
							1W3C (R)	MAS (R)				
							1W3C (R)	SV-1-T (R)	SP-1-T (R)	(10)	4(N)	
Ⓑ	1-A (E)	10'					1W4C (N)	TV-1-T (N)	SP-1-T (E)	(10)	6(E)	PROVIDE NEW EQUIPMENT AS INDICATED.
Ⓒ	17-2-70 (E)	30'	15' (E)	10' (E)	100W (E)		1W4C (N)	MAS (N)				PROVIDE NEW EQUIPMENT AS INDICATED.
							1W3C (N)	SV-1-T (N)	SP-1-T (E)	(10)	6(E)	
Ⓓ	1-A (E)	10'					1W3C (N)	TV-1-T (N)	SP-1-T (E)	(10)	8(E)	PROVIDE NEW EQUIPMENT AS INDICATED.
Ⓔ	27-4-80 (N)	17'	45' (N)				1W3C (N)	MAS (N)				PEDESTRIAN HEAD AND PPB TO NEW POLE.
							1W3C (N)	MAS (N)				OTHER EQUIPMENT AND PROVIDE NEW EQUIPMENT AS INDICATED.
							1W5C (N)	SV-1-T (N)	SP-1-T (R)	(10)	8(R)	
Ⓕ	1-A (E)	10'					1W4C (N)	TV-1-T (N)	SP-1-T (E)	(10)	2(E)	PROVIDE NEW EQUIPMENT AS INDICATED.
Ⓖ	19-2-70 (E)	30'	30' (E)	15' (E)	200W (E)		1W4C (N)	MAS (N)				PROVIDE NEW EQUIPMENT AS INDICATED.
							1W3C (N)	SV-1-T (N)	SP-1-T (E)	(10)	2(E)	
Ⓗ	1-A (E)	10'					1W3C (N)	TV-1-T (N)	SP-1-T (E)	(10)	4(E)	PROVIDE NEW EQUIPMENT AS INDICATED.

(E)=EXISTING (N)=NEW (R)=RELOCATED


- NOTE:  
 1. NEW VEHICULAR HEADS SHALL HAVE 12" LENSES.  
 2. PEDESTRIAN PUSH BUTTONS SHALL BE INSTALLED ON THE POLE IN THE QUADRANT NEAREST THE CROSSWALK SERVING THE PHASE.  
 3. ((10)) - INDICATES AUDITORY PEDESTRIAN SIGNAL TO BE INSTALLED (SEE SPECIAL PROVISIONS).  
 4. EXISTING POLES NOT DESIGNATED TO BE REUSED SHALL BE REMOVED AND SALVAGED.  
 5. SEE DETAIL "B" FOR SIGNAL HEADS DESIGNATED AS 1W4C.

PAVEMENT DELINEATION

- INDICATES STRIPING AND PAVEMENT MARKINGS TO BE INSTALLED.
- INDICATES STRIPING AND PAVEMENT MARKINGS TO REMAIN.
- INDICATES STRIPING AND PAVEMENT MARKINGS TO BE REMOVED.



ENGINEER IN RESPONSIBLE CHARGE  
 Richard D. McGrath  
 RICHARD D. McGRATH  
 R.C.E. No. 31952 expires 12/31/96  
 DATE July 7, 1999

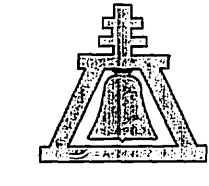

MARK	REVISIONS	DATE

CITY OF RIVERSIDE, CALIFORNIA  
 DEPARTMENT OF PUBLIC WORKS  
 APPROVED BY: [Signature]  
 DATE: 7/7/99  
 DESIGNED BY: [Signature] DRAWN BY: [Signature] CHECKED BY: [Signature]

TRAFFIC SIGNALS MODIFICATION  
 ARLINGTON AVENUE AND MADISON STREET  
 HORIZ. SCALE: 1" = 20'

ACCT. NO. 430-941600-440125-35058  
 SHEET X-400 OF 1  
 FILE NO.