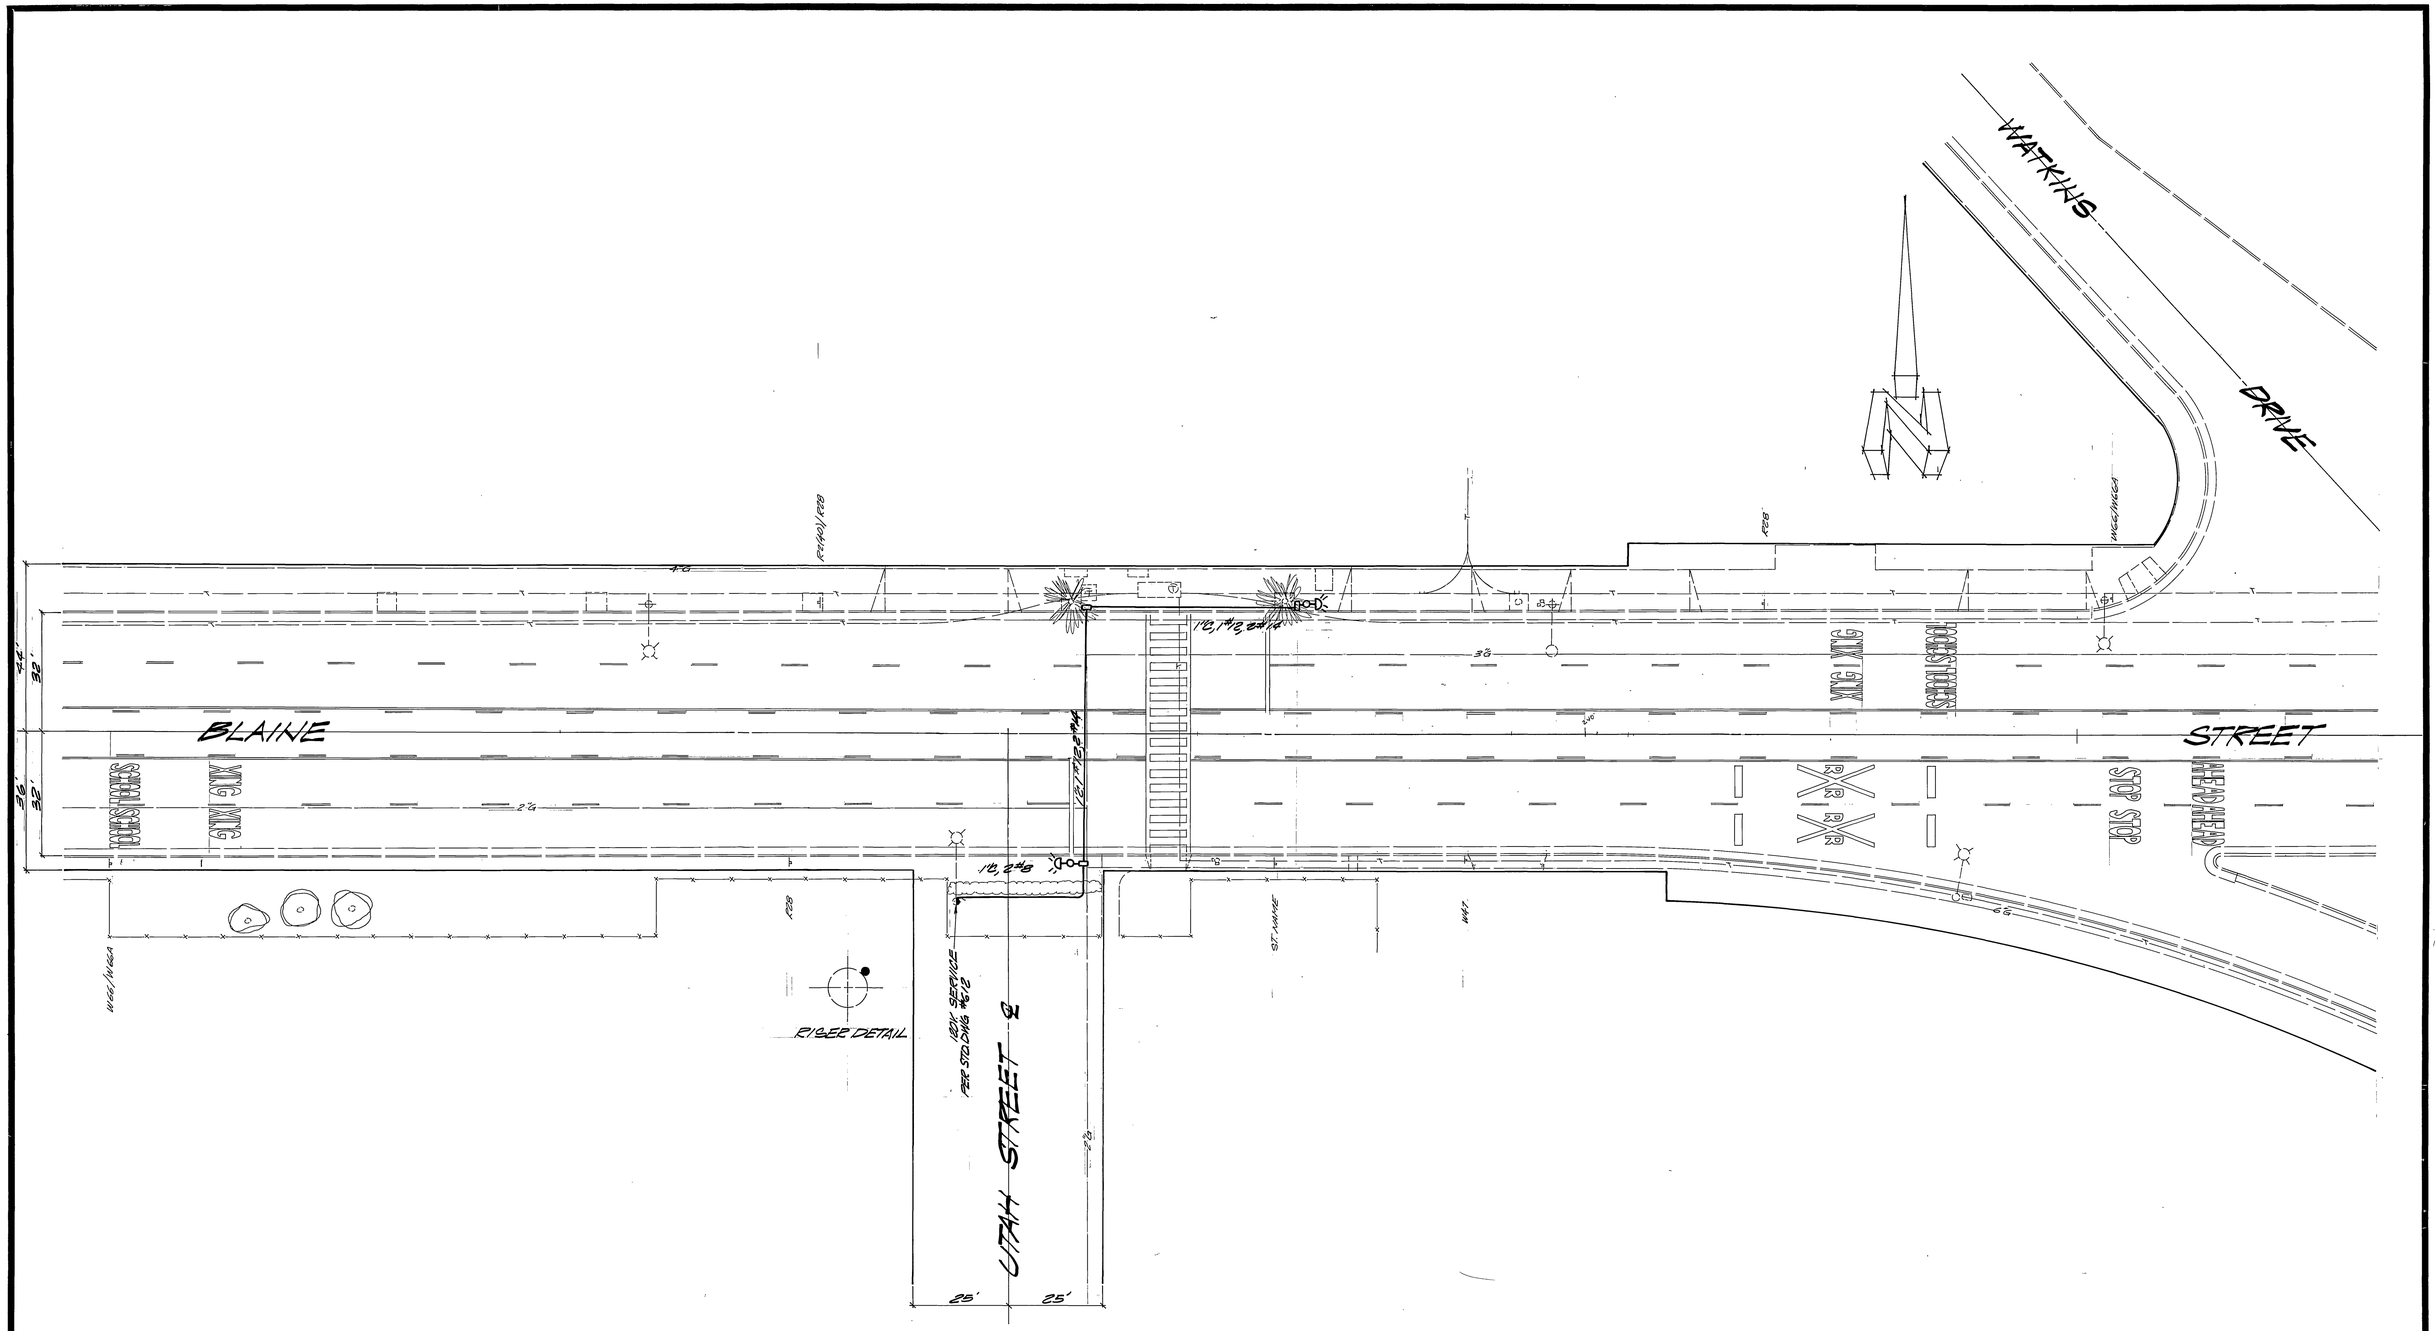

REF. DWG'S R-1542, R-1201, R-498, S-258

MARK	REVISIONS	APPR.	DATE
	AS-BUILT PER BEACON INSTALLATION		

DESIGNED BY [signature] DRAWN BY [signature] CHECKED BY [signature]

CITY OF RIVERSIDE
PUBLIC WORKS DEPARTMENT

APPROVED	BY	DATE
PRINCIPAL ENGINEER	[signature]	8/5/81
PARK DEPARTMENT		
TRAFFIC DIVISION	J	8/3/81
CHIEF P. W. ENGINEER	[signature]	8-6
Public Utilities	[signature]	8-4-81

APPROVED BY [signature]
PUBLIC WORKS DIRECTOR
DATE 8/4/81

FLASHING BEACON

BLAINE STREET @ UTAH STREET

HORIZ. SCALE: 1" = 20' VERT. SCALE: 1" =

ACCOUNT NO. 30-576390-09

X-469

SHEET ____ OF ____