


| CONDUCTOR SCHEDULE        |             |                 |      |     |     |     |     |     |     |     |
|---------------------------|-------------|-----------------|------|-----|-----|-----|-----|-----|-----|-----|
| A.W.G. SIZE OR CABLE SIZE | PHASE NO.   | POLE OR CIRCUIT | RUNS |     |     |     |     |     |     |     |
|                           |             |                 | 1    | 2   | 3   | 4   | 5   | 6   | 7   | 8   |
| 12<br>3                   | 2.5<br>2P   | POLE (A)        |      |     |     |     |     |     | 1   | 1   |
|                           | 2           | POLE (B)        |      |     |     |     |     |     | 1   | 1   |
|                           | 8P          | POLE (C)        |      |     |     |     |     |     | 1   | 1   |
|                           | 4P          | POLE (D)        |      |     |     | 1   | 1   | 1   | 1   | 1   |
|                           | 2.5<br>2P   | POLE (E)        |      |     |     | 1   | 1   | 1   | 1   | 1   |
|                           | 8P          | POLE (F)        |      |     |     | 1   | 1   | 1   | 1   | 1   |
|                           | 4P          | POLE (G)        |      |     |     | 1   | 1   | 1   | 1   | 1   |
|                           | 2.5<br>2P   | POLE (H)        |      |     |     | 1   | 1   | 1   | 1   | 1   |
|                           | 8P          | POLE (I)        |      |     |     | 1   | 1   | 1   | 1   | 1   |
| TOTAL CABLES 12C/3C       |             |                 | 1    | 2   | 3   | 4   | 5   | 6   | 3   | 2   |
| #12                       | I.I.S.N.S.  |                 |      | 2   | 2   | 2   | 2   |     | 2   | 2   |
| #8                        | LUMINAIRES  |                 |      | 2   | 2   | 2   | 2   |     | 2   | 2   |
| TYPE B                    | #1 DETECTOR |                 |      |     |     |     |     | 2   | 2   | 2   |
|                           | #2 DETECTOR |                 |      |     | 3   | 3   | 3   |     |     |     |
|                           | #4 DETECTOR |                 | 2    | 2   | 2   | 2   | 2   |     |     |     |
|                           | #5 DETECTOR |                 |      |     | 2   | 2   | 2   |     |     |     |
|                           | #6 DETECTOR |                 |      |     |     |     |     | 4   | 4   | 4   |
|                           | #8 DETECTOR |                 |      |     |     |     | 2   |     |     |     |
| TOTAL DLC                 |             |                 | 2    | 2   | 7   | 7   | 9   | 15  | 6   | 6   |
| EVP CABLE                 |             |                 |      |     |     |     |     | 2   | 2   | 2   |
| CONDUIT SIZE (IN.)        |             |                 | (E)  | (E) | (E) | (E) | (E) | (E) | (X) | (N) |
|                           |             |                 | 2    | 3   | 3   | 3   | 3   | 2-3 | 3   | 3   |

NOTES: 1. (N)=NEW (E)=EXISTING (X)=EXTEND  
2. ALL CONDUCTORS, DLC'S AND CABLES SHALL BE NEW.

**PHASE DIAGRAM**

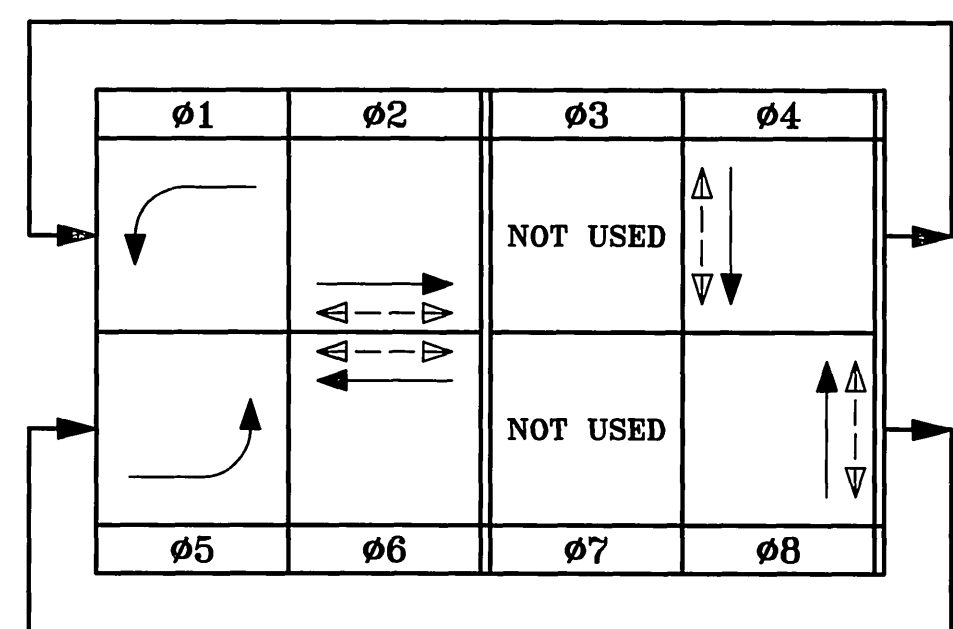


**POLE AND EQUIPMENT SCHEDULE**

| POLE NO. | DESCRIPTION | POLE HEIGHT | SIGNAL MAST ARM | LUMINAIRE MAST ARM | PLACEMENT DIMENSIONS |     | SIGNAL MOUNTING |                  |                 | PED PUSH BUTTONS |       | HPSV LUMINAIRE | I.I.S.N.S. LEGEND |
|----------|-------------|-------------|-----------------|--------------------|----------------------|-----|-----------------|------------------|-----------------|------------------|-------|----------------|-------------------|
|          |             |             |                 |                    | "A"                  | "B" | POLE VEHICLE    | MAST ARM VEHICLE | POLE PEDESTRIAN | Ø                | ARROW |                |                   |
| (A)      | 26-4-80     | 30'         | 40'             | 15'                | 3'                   | 8'  | SV-1-T          | 2-MAS            | SP-1-T          |                  |       | 200 W          | Dauchy            |
| (B)      | * P.P.B.    | 3'10"       |                 |                    | 3'                   | 8'  |                 |                  | TP-1-T          |                  | W     |                |                   |
| (C)      | 1-A         | 7'          |                 |                    | 3'                   | 8'  |                 |                  | TP-1-T          |                  | N     |                |                   |
| (D)      | 17-3-80     | 30'         | 20'             | 15'                | 15'                  | 9'  | SV-1-T          | 1-MAS            | SP-1-T          |                  | N     | 200 W          | Van Buren         |
| (E)      | 1-A         | 10'         |                 |                    | 3'                   | 8'  | TV-2-T          |                  | SP-1-T          |                  | E     |                |                   |
| (F)      | 26-4-80     | 30'         | 45'             | 15'                | 3'                   | 13' | SV-1-T          | 2-MAS            | SP-1-T          |                  | E     | 200 W          | Dauchy            |
| (G)      | 1-A         | 7'          |                 |                    | 3'                   | 8'  |                 |                  | TP-1-T          |                  | S     |                |                   |
| (H)      | 17-3-80     | 30'         | 20'             | 15'                | 3'                   | 16' | SV-1-T          | 1-MAS            |                 |                  | S     | 200 W          | Van Buren         |
| (I)      | 1-A         | 10'         |                 |                    | 3'                   | 16' | *TV-2-T         |                  | *SP-1-T         |                  | W     |                |                   |

\* = NEW EQUIPMENT  
● = RELOCATED EQUIPMENT

**DAUCHY AVENUE**


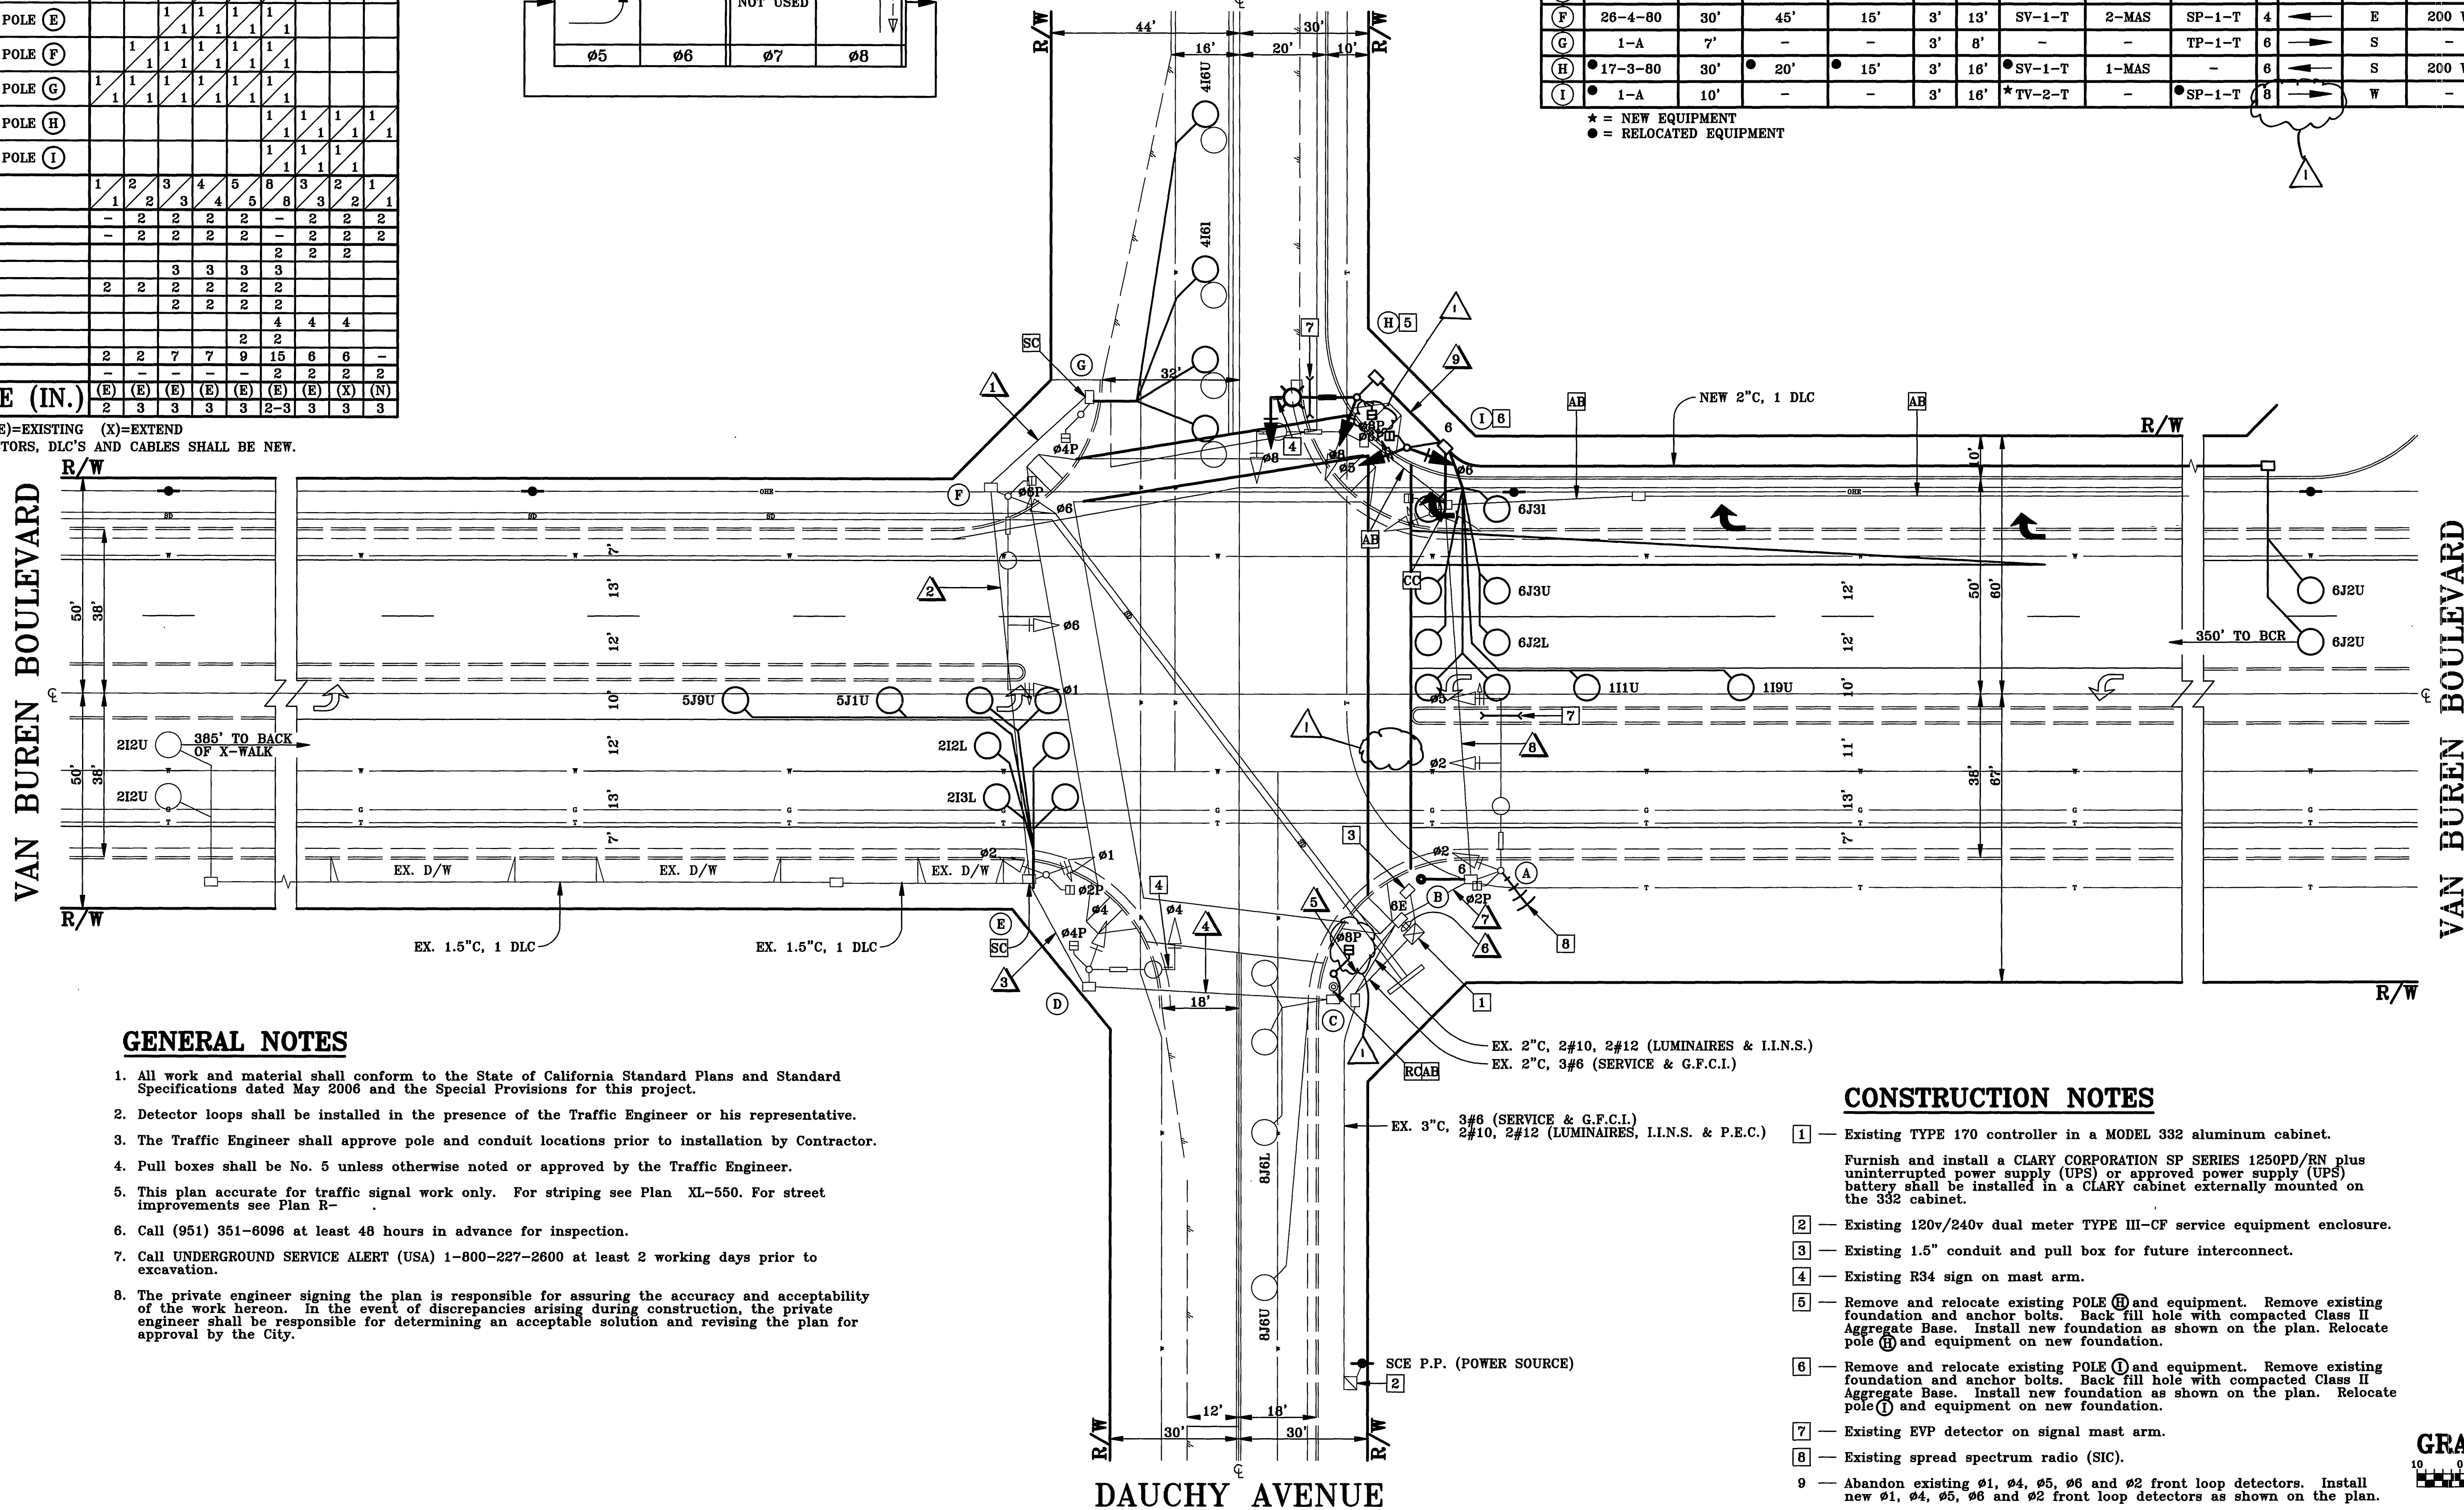


**GENERAL NOTES**

- All work and material shall conform to the State of California Standard Plans and Standard Specifications dated May 2006 and the Special Provisions for this project.
- Detector loops shall be installed in the presence of the Traffic Engineer or his representative.
- The Traffic Engineer shall approve pole and conduit locations prior to installation by Contractor.
- Pull boxes shall be No. 5 unless otherwise noted or approved by the Traffic Engineer.
- This plan accurate for traffic signal work only. For striping see Plan XL-550. For street improvements see Plan R-
- Call (951) 351-6096 at least 48 hours in advance for inspection.
- Call UNDERGROUND SERVICE ALERT (USA) 1-800-227-2600 at least 2 working days prior to excavation.
- The private engineer signing the plan is responsible for assuring the accuracy and acceptability of the work hereon. In the event of discrepancies arising during construction, the private engineer shall be responsible for determining an acceptable solution and revising the plan for approval by the City.

**CONSTRUCTION NOTES**

- Existing TYPE 170 controller in a MODEL 332 aluminum cabinet. Furnish and install a CLARY CORPORATION SP SERIES 1250PD/RN plus uninterruptible power supply (UPS) or approved power supply (UPS) battery shall be installed in a CLARY cabinet externally mounted on the 332 cabinet.
- Existing 120v/240v dual meter TYPE III-CF service equipment enclosure.
- Existing 1.5" conduit and pull box for future interconnect.
- Existing R34 sign on mast arm.
- Remove and relocate existing POLE (I) and equipment. Remove existing foundation and anchor bolts. Back fill hole with compacted Class II Aggregate Base. Install new foundation as shown on the plan. Relocate pole (I) and equipment on new foundation.
- Existing EVP detector on signal mast arm.
- Existing spread spectrum radio (SIC).
- Abandon existing ø1, ø4, ø5, ø6 and ø2 front loop detectors. Install new ø1, ø4, ø5, ø6 and ø2 front loop detectors as shown on the plan.

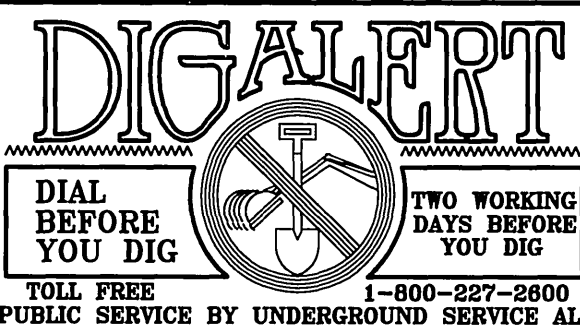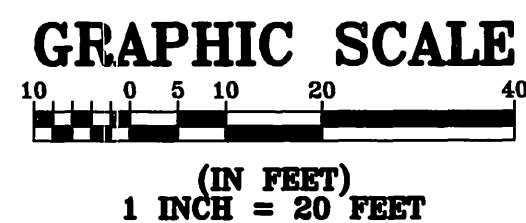

**PRIVATE ENGINEERING NOTE**

CONSTRUCTION CONTRACTOR AGREES THAT IN ACCORDANCE WITH GENERALLY ACCEPTED CONSTRUCTION PRACTICES, CONSTRUCTION CONTRACTOR WILL BE REQUIRED TO ASSUME SOLE AND COMPLETE RESPONSIBILITY FOR JOB SITE CONDITIONS DURING THE COURSE OF CONSTRUCTION OF THE PROJECT, INCLUDING SAFETY OF ALL PERSONS AND PROPERTY. THAT THIS REQUIREMENT SHALL BE MADE TO APPLY CONTINUOUSLY AND NOT BE LIMITED TO NORMAL WORKING HOURS, AND CONSTRUCTION CONTRACTOR SHALL AGREE TO DEFEND, INDEMNIFY AND HOLD DESIGN PROFESSIONAL HARMLESS FROM ANY AND ALL LIABILITY, REAL OR ALLEGED, IN CONNECTION WITH THE PERFORMANCE OF WORK ON THIS PROJECT, EXCEPTING LIABILITY ARISING FROM THE SOLE NEGLIGENCE OF DESIGN PROFESSIONAL.



ENGINEER IN RESPONSIBLE CHARGE:  
*Lawrence S. Eisenhart*  
LAWRENCE S. EISENHART RCE NO. 13493  
EXPIRATION DATE: 3-31-09

**LAWRENCE S. EISENHART**  
CONSULTING ENGINEER  
2070 Locust Court  
San Bernardino, California 92404  
Tel: (909) 864-5406 Fax: (909) 864-5047

SCALE: 1"=20'  
DATE: 05/07/07

|  |         |
|--|---------|
| REVISIONS  | DATE    |
| REMOVE EASTLY CROSSWALK LEG  | 5/14/07 |
| RESUBMIT INDICATIONS AND REGISTERED PUSH BUTTONS ASSOCIATED WITH IT. | 5/14/07 |
| MARK   | DATE    |
| DESIGNED BY: L.S.E. DRAWN BY: L.S.E. CHECKED BY:                     |         |

|  |                    |         |                    |
|--|--------------------|---------|--------------------|
| CITY OF RIVERSIDE<br>PUBLIC WORKS DEPARTMENT |                    |         |                    |
| APPROVED BY:                                 | BY:                | DATE:   | APPROVED BY:       |
| PRINCIPLE ENGR.                              | <i>[Signature]</i> | 5-8-07  | <i>[Signature]</i> |
| TRAFFIC DIVISION                             | <i>[Signature]</i> | 5-18-07 | CITY ENGINEER      |
| ENGR. MANAGER                                | <i>[Signature]</i> | 6-14-07 |                    |
| SIG. MAINTENANCE                             | <i>[Signature]</i> | 5/21/07 |                    |
| DATE:  | 6/5/07             |         |                    |

TRAFFIC SIGNAL MODIFICATION PLAN  
**VAN BUREN BOULEVARD & DAUCHY AVENUE**

SCALE: 1"=20'

PROJECT NO: X-517  
SHEET 1 OF 1  
FILE NAME: 517.DWG

File: 07-05.dwg