


Revised per Plan R-2309
4/10/81 D. Ray

Van Buren Blvd

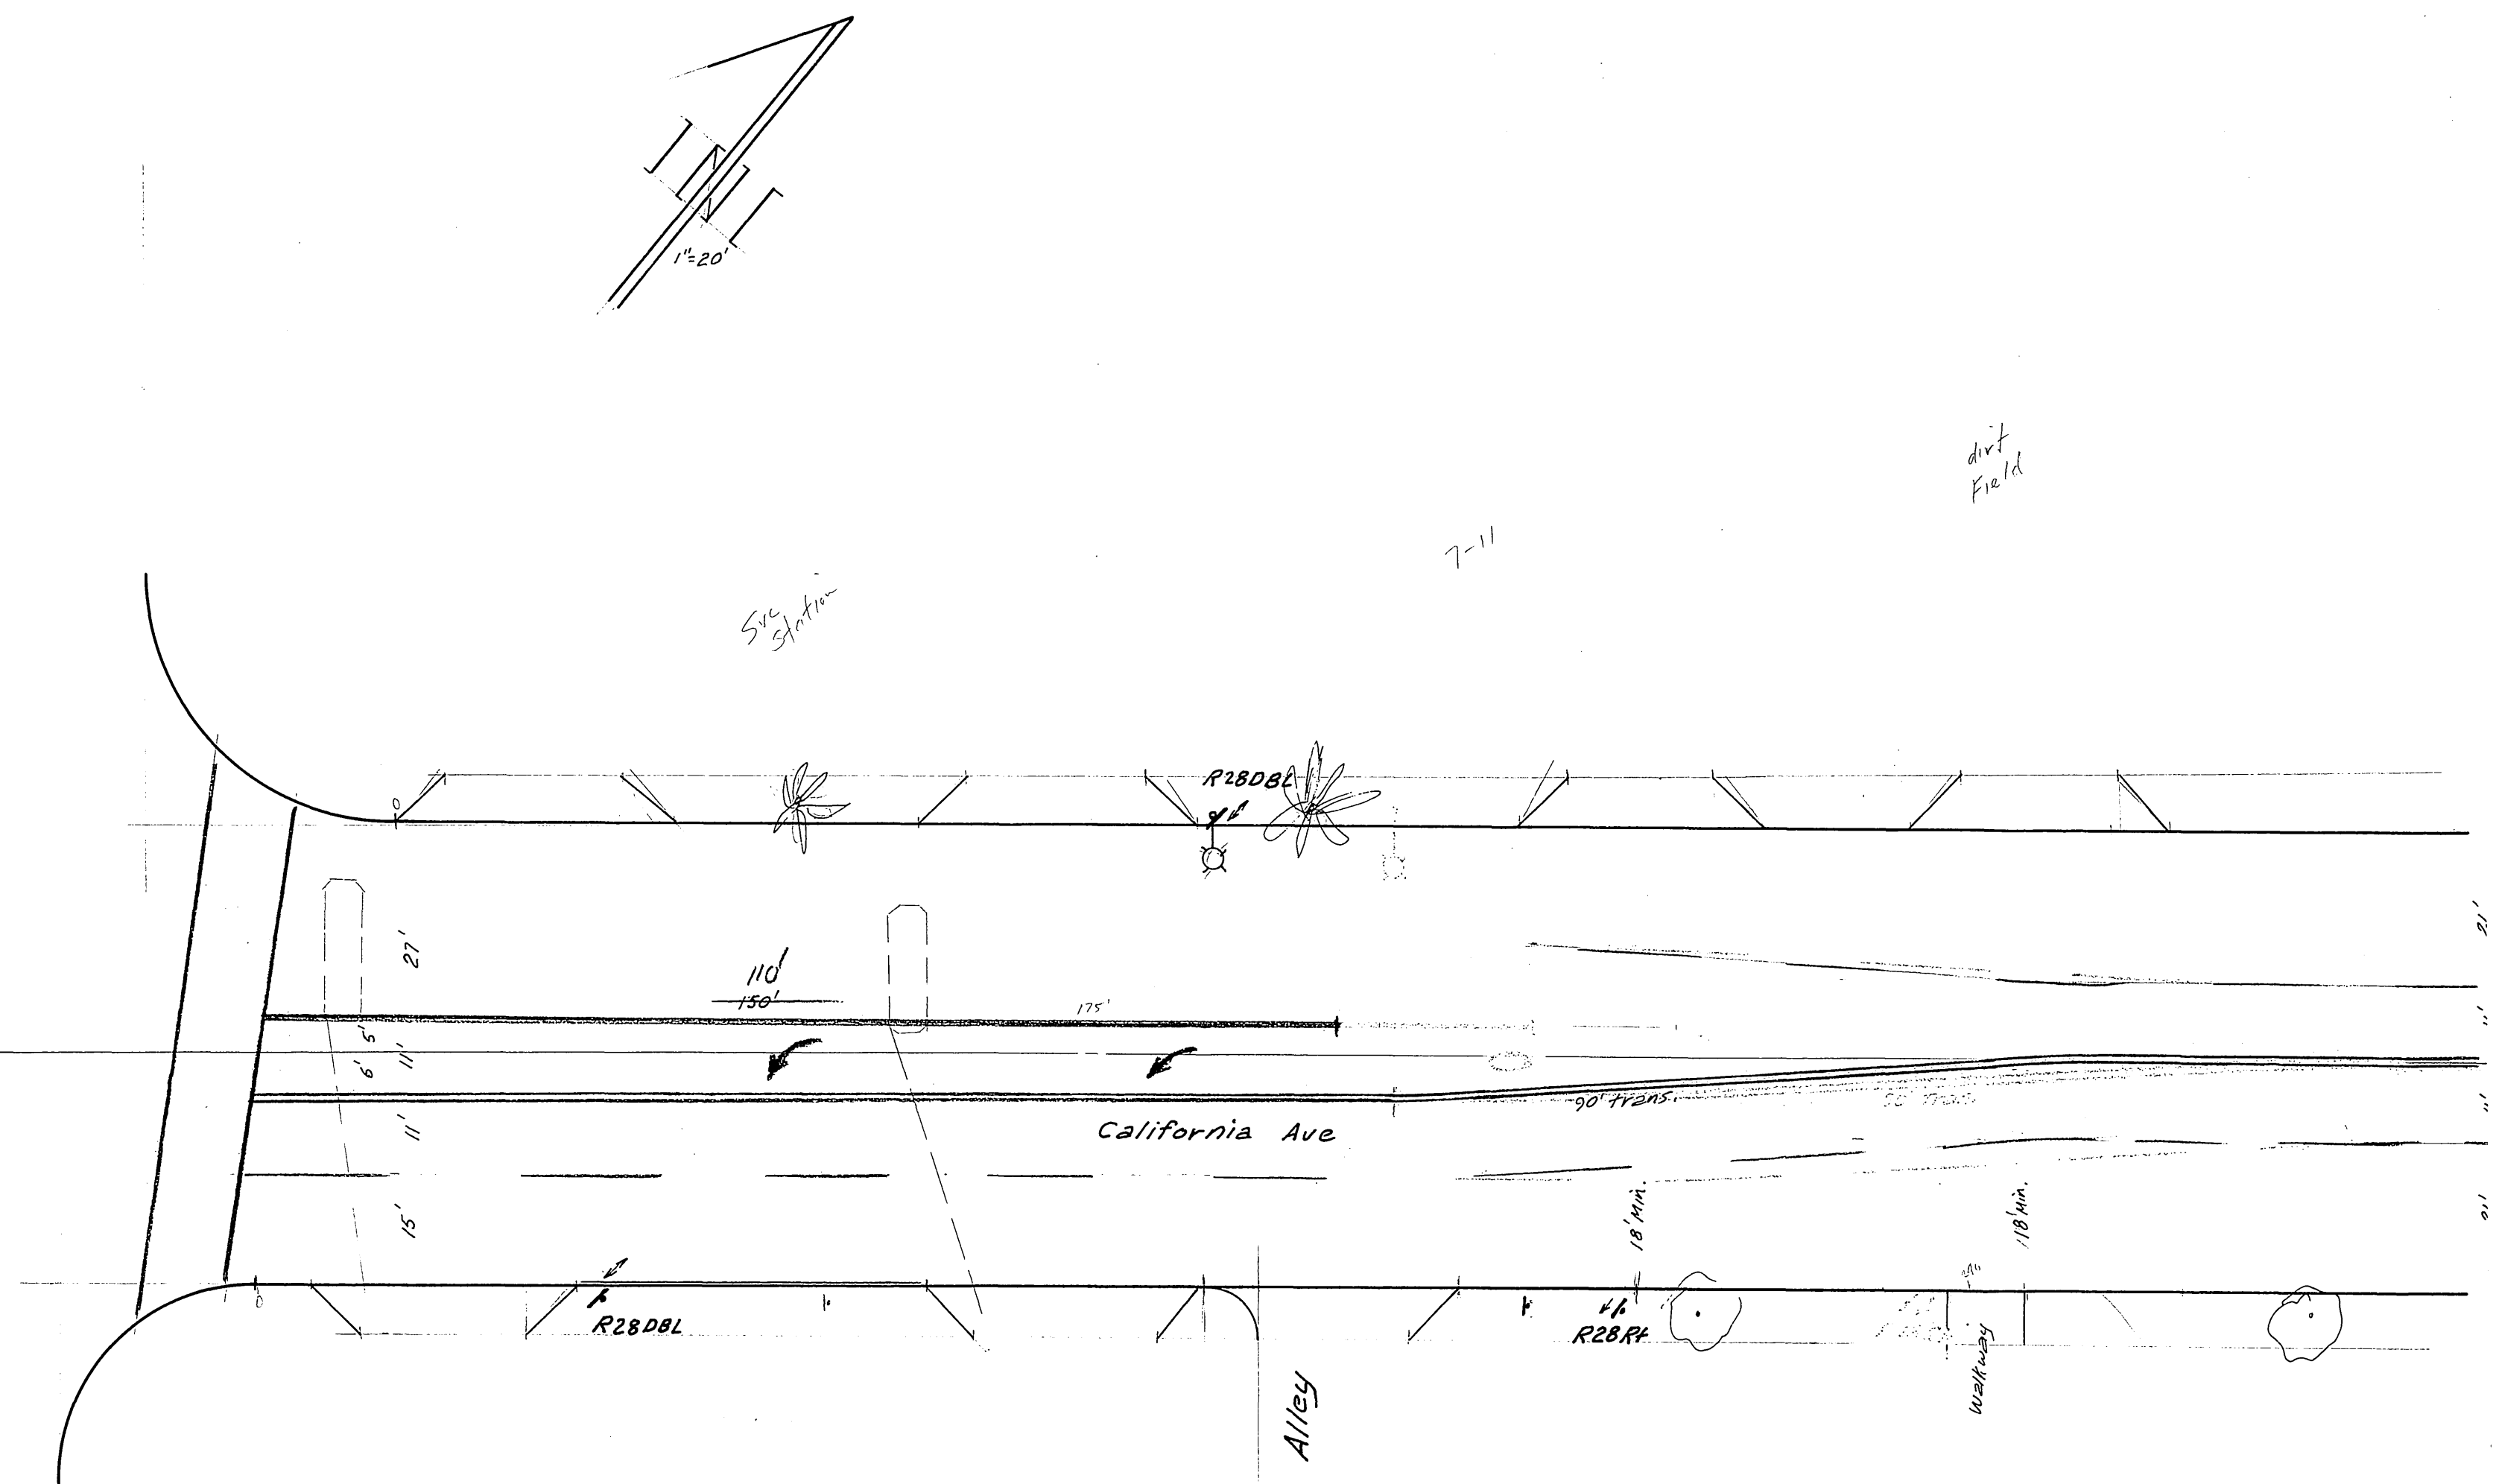

14' 11" 11' 11' 11' 11' 11'

Lane Painted
prior to issuance
of drawing

CALIFORNIA AVE
Left Lane Extension
at Van Buren Blvd
11/20/80 D. Ray
XL-109