
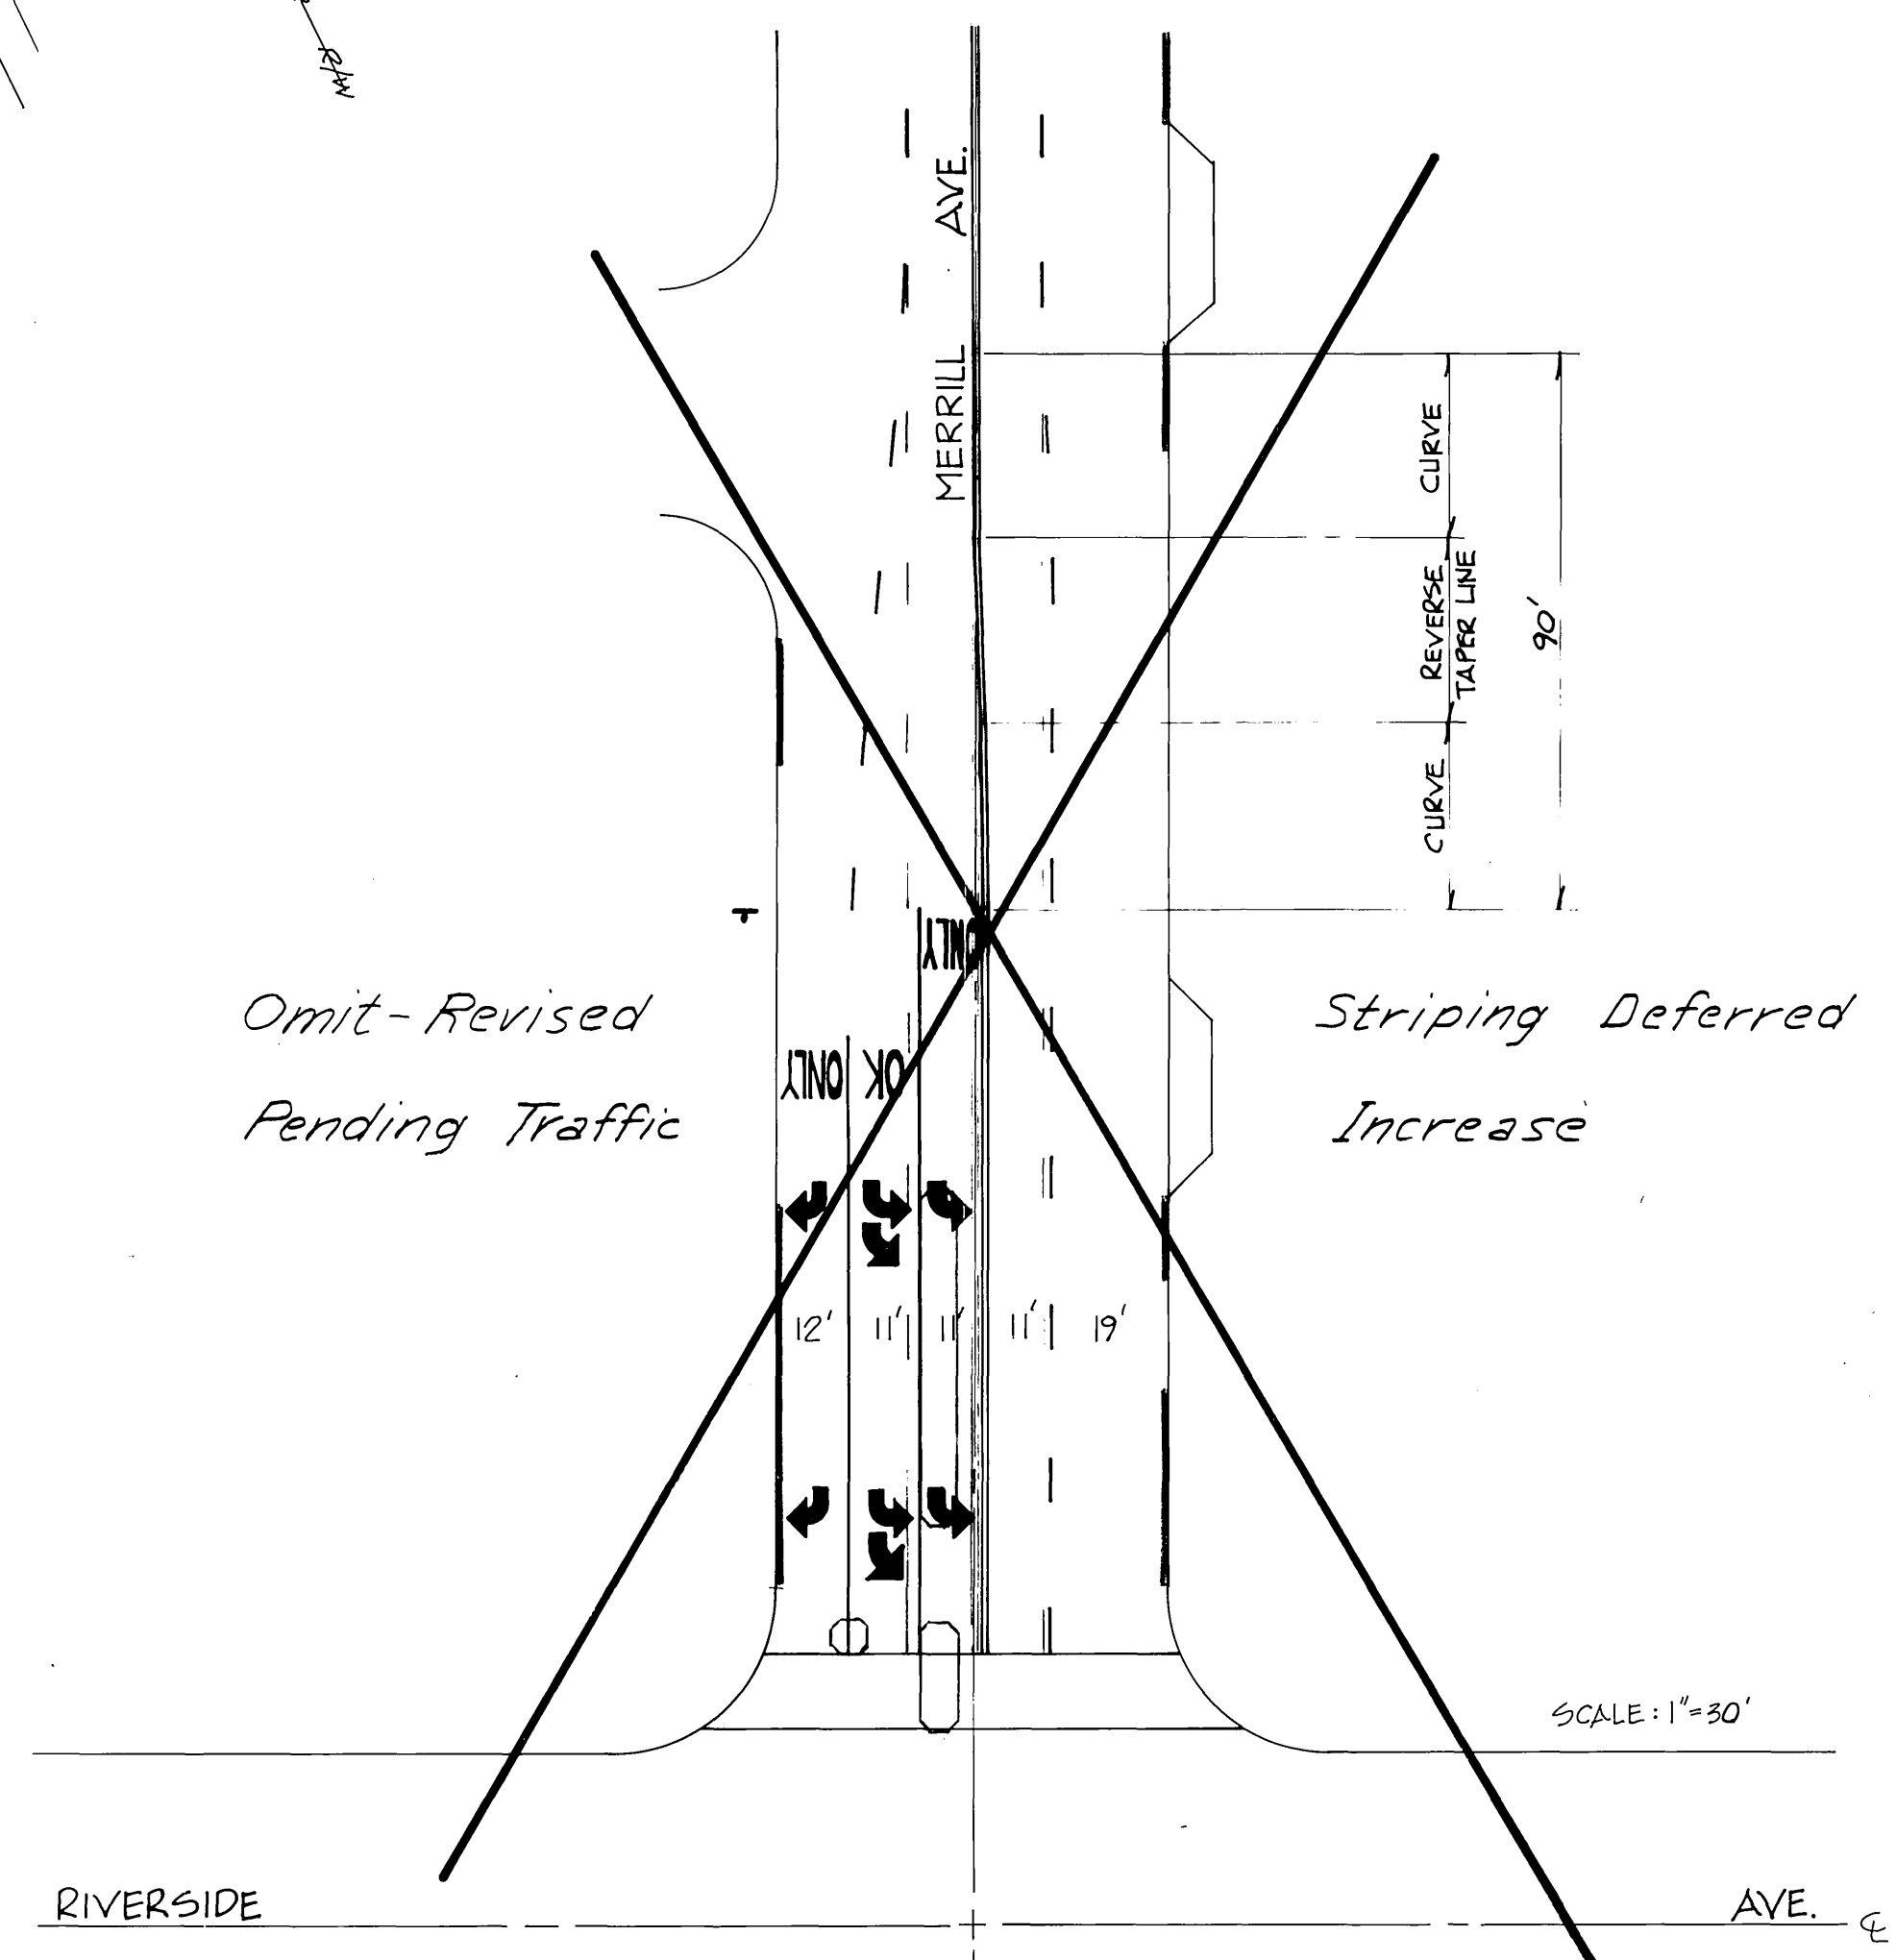
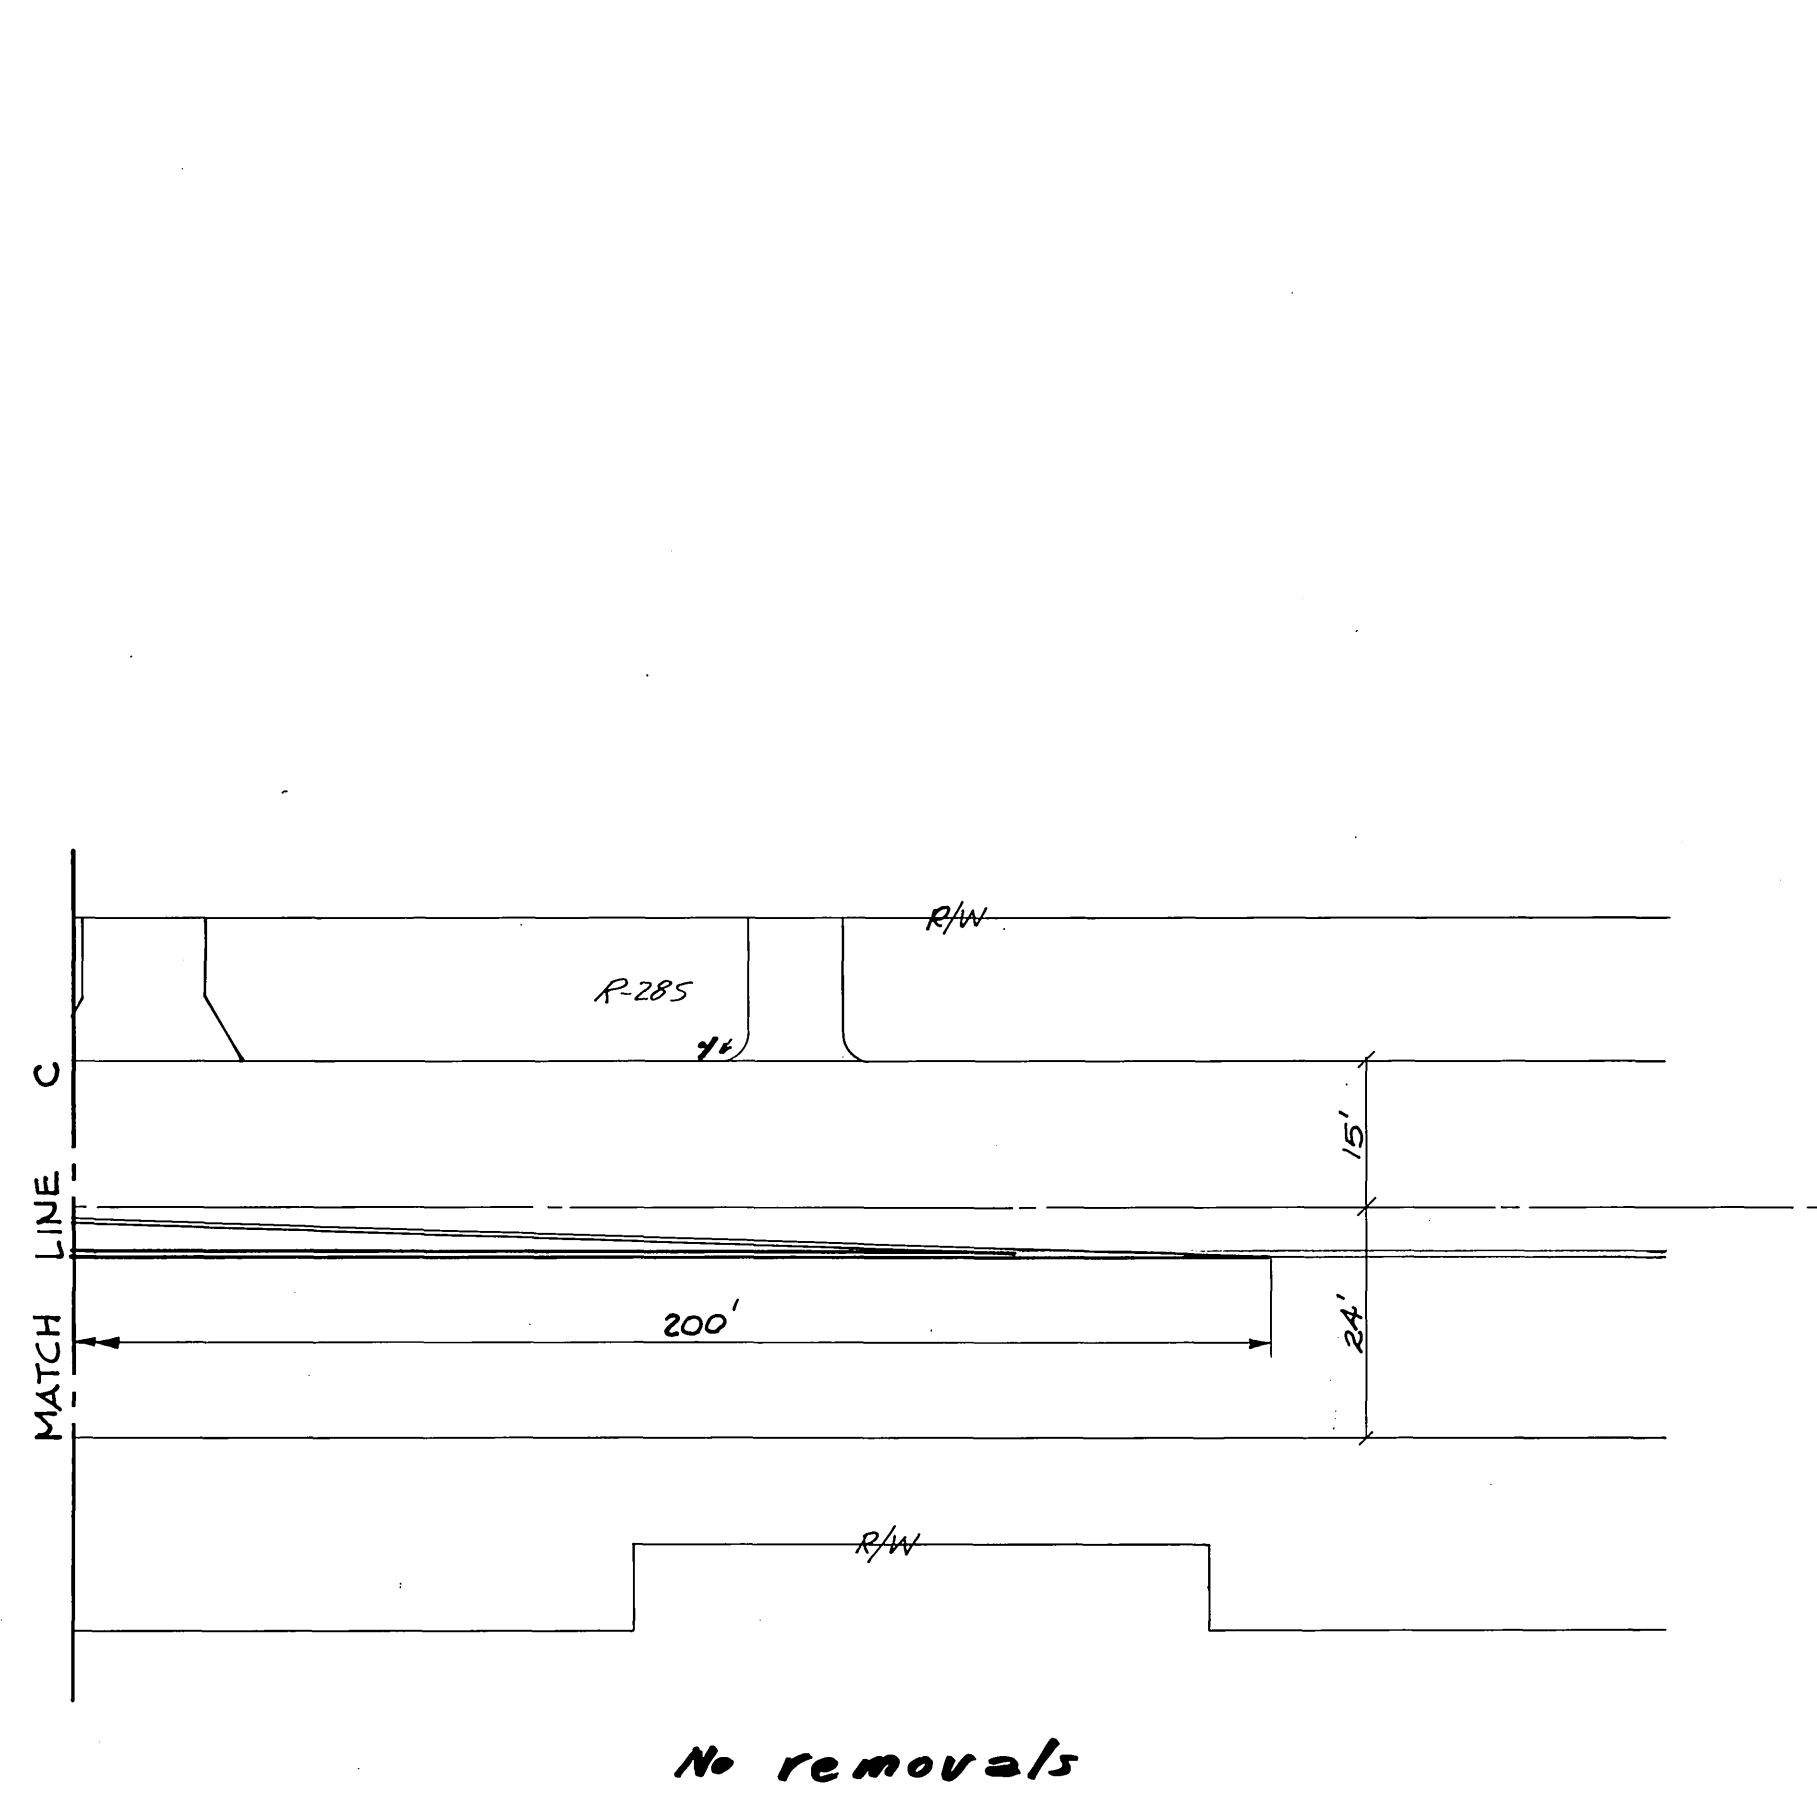


Sandblasting

<b>CITY OF RIVERSIDE</b> <b>PUBLIC WORKS DEPARTMENT</b>				ACCOUNT NO.	
				RIVERSIDE AVENUE STRIPING PLAN CENTRAL TO ELIZABETH	
APPROVED	BY	DATE	APPROVED BY	XL-113A	
PRINCIPAL ENGINEER			PUBLIC WORKS DIRECTOR		
MARK	REVISIONS	APPR. DATE	DATE	SHEET 1 OF 2	
DESIGNED BY	DRAWN BY	CHECKED BY		HORIZ. SCALE: 1" = 20' VERT. SCALE: 1" =	

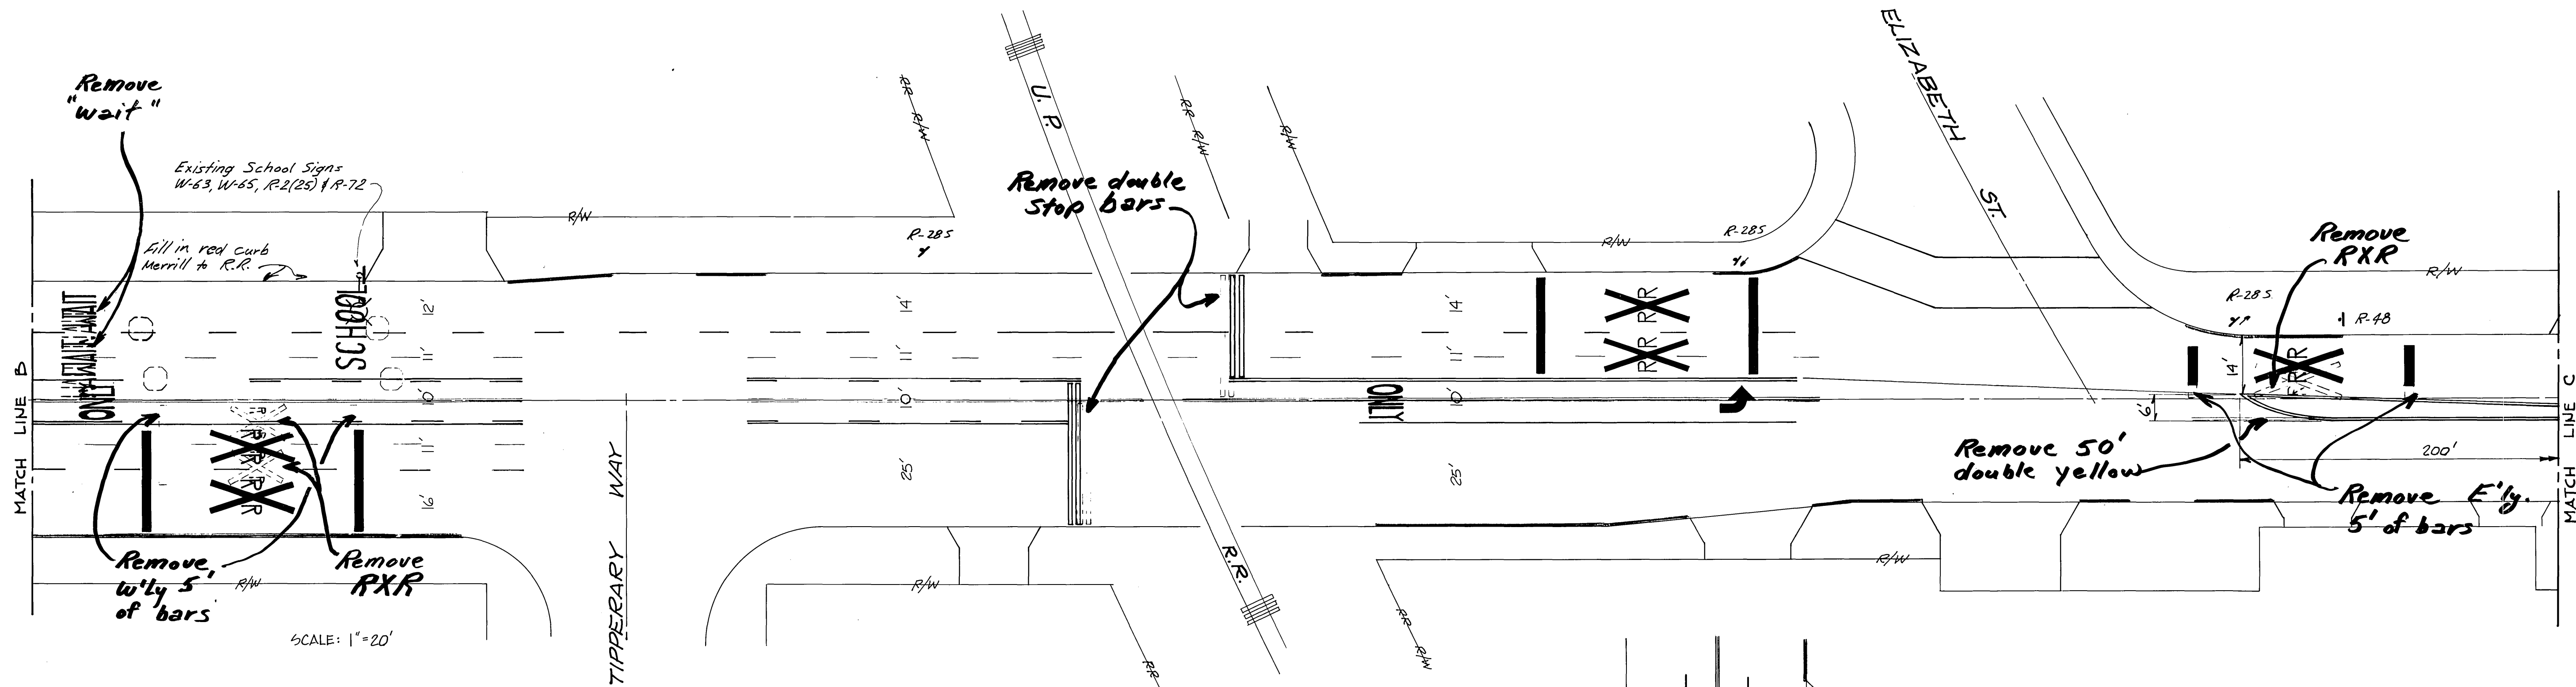

<b>CITY OF RIVERSIDE</b> <b>PUBLIC WORKS DEPARTMENT</b>				<b>RIVERSIDE AVENUE</b> <b>STRIPING PLAN</b> <b>CENTRAL TO ELIZABETH</b>		ACCOUNT NO. <b>XL-113A</b>
APPROVED BY _____ PRINCIPAL ENGINEER		BY _____ DATE _____		APPROVED BY _____ PUBLIC WORKS DIRECTOR		
REVISIONS _____ APPR. DATE _____		DESIGNED BY _____ DRAWN BY _____ CHECKED BY _____		DATE _____		
HORIZ. SCALE: 1" = _____				VERT. SCALE: 1" = _____		