Relocate L.L. (1)

Add Left turn arrows (1)

Remove arrow pointing into Indiana right turn barrel. (1)

60' 60' 12'

Convert Left turn Lane to two-way turn Lane Completed (1)

R/R sign

Repaint R/R. 2 Lanes

Identical Points

Indiana Ave

RR

Repaint R/R markings 81' w/o McMahone
R/R Sign 93' w/o McMahone Completed (1)
('69 '7)

"A" Sign Assembly

Install R/R, 2 Lanes Completed (1)

"B" Sign Assemblies

32' 6'

"B" Sign Assemblies

Install R/R, 2 Lanes

"A" Sign Assembly

Yellow pavement crosshatching 10' o.c. at 45° to street. Stripes 12" wide, reflective

A.T. & S.F.

Arlington Ave

Maude St.

1" = 20'

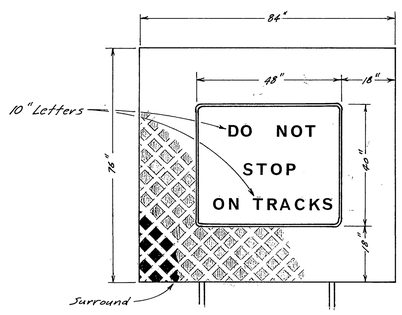

Sign Assembly "A"

48" x 40" black on reflective white sign with 18" black on reflective yellow surround. Use signs from Van Buren Blvd or if new use 4" black squares with 2" yellow stripes at 45°. Total size 86" x 76".

Signs not to block any portion of warning Lights (1)

Sign Assemblies "B" are also 48" x 40" but do not include the Surround. Mount 3" above median pavement surface.

Arlington Avenue
R/R Xing
Safety Project
4/26/82 D. Ray
Approved: RLS 4/4/82
Revised per field Meeting 11/15/82 RLS 1/10/83
(1) Revised per Caltrans Comment 2/9/83 RLS 2/8
(2) " " AT & SF. " RLS 3/8/83

XL-115