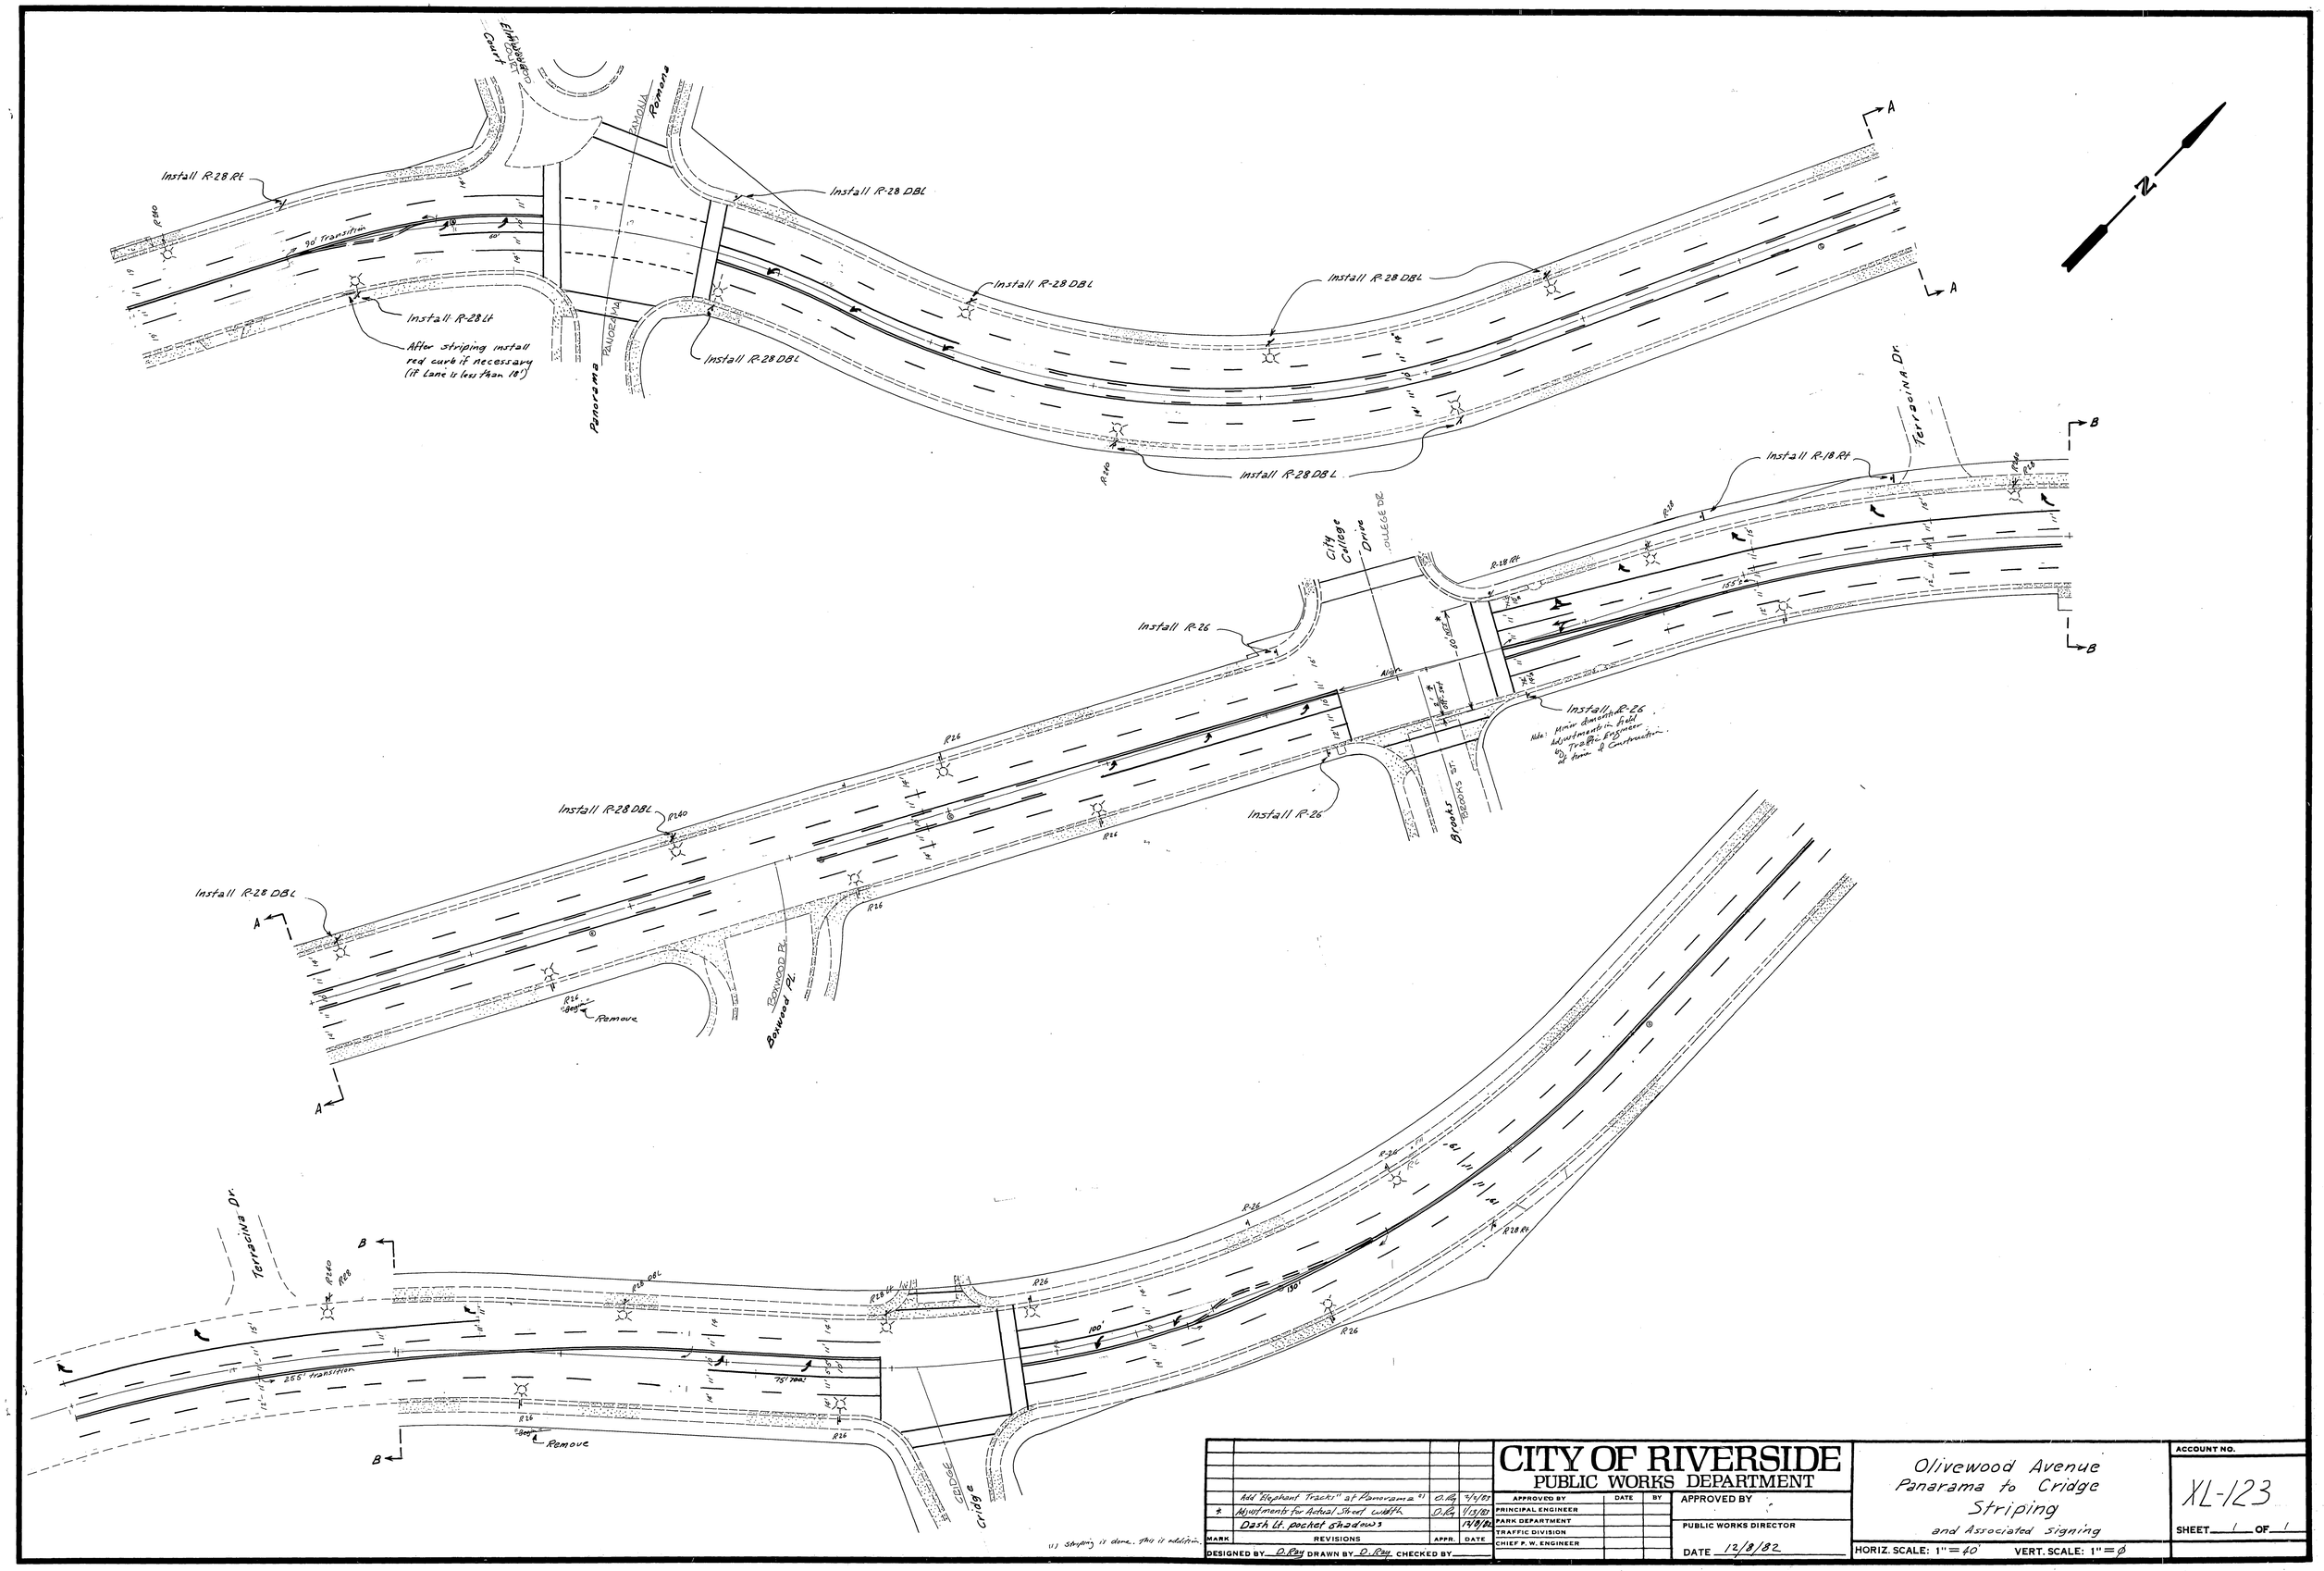

MARK	REVISIONS	APPR.	DATE
	Add "Elephant Tracks" at Panorama (1)	D.Ray	2/2/83
*	Adjustments for Actual Street width	D.Ray	1/13/83
	Dash Lt. pocket shadows		12/8/82

DESIGNED BY D.Ray DRAWN BY D.Ray CHECKED BY

(1) Striping is done. This is addition.

CITY OF RIVERSIDE
PUBLIC WORKS DEPARTMENT

APPROVED BY	DATE	BY
PRINCIPAL ENGINEER		
PARK DEPARTMENT		
TRAFFIC DIVISION		
CHIEF P. W. ENGINEER		

APPROVED BY

PUBLIC WORKS DIRECTOR

DATE 12/8/82

Olivewood Avenue
Panarama to Cridge
Striping
and Associated signing

HORIZ. SCALE: 1" = 40' VERT. SCALE: 1" = ∅

ACCOUNT NO.

XL-123

SHEET 1 OF 1