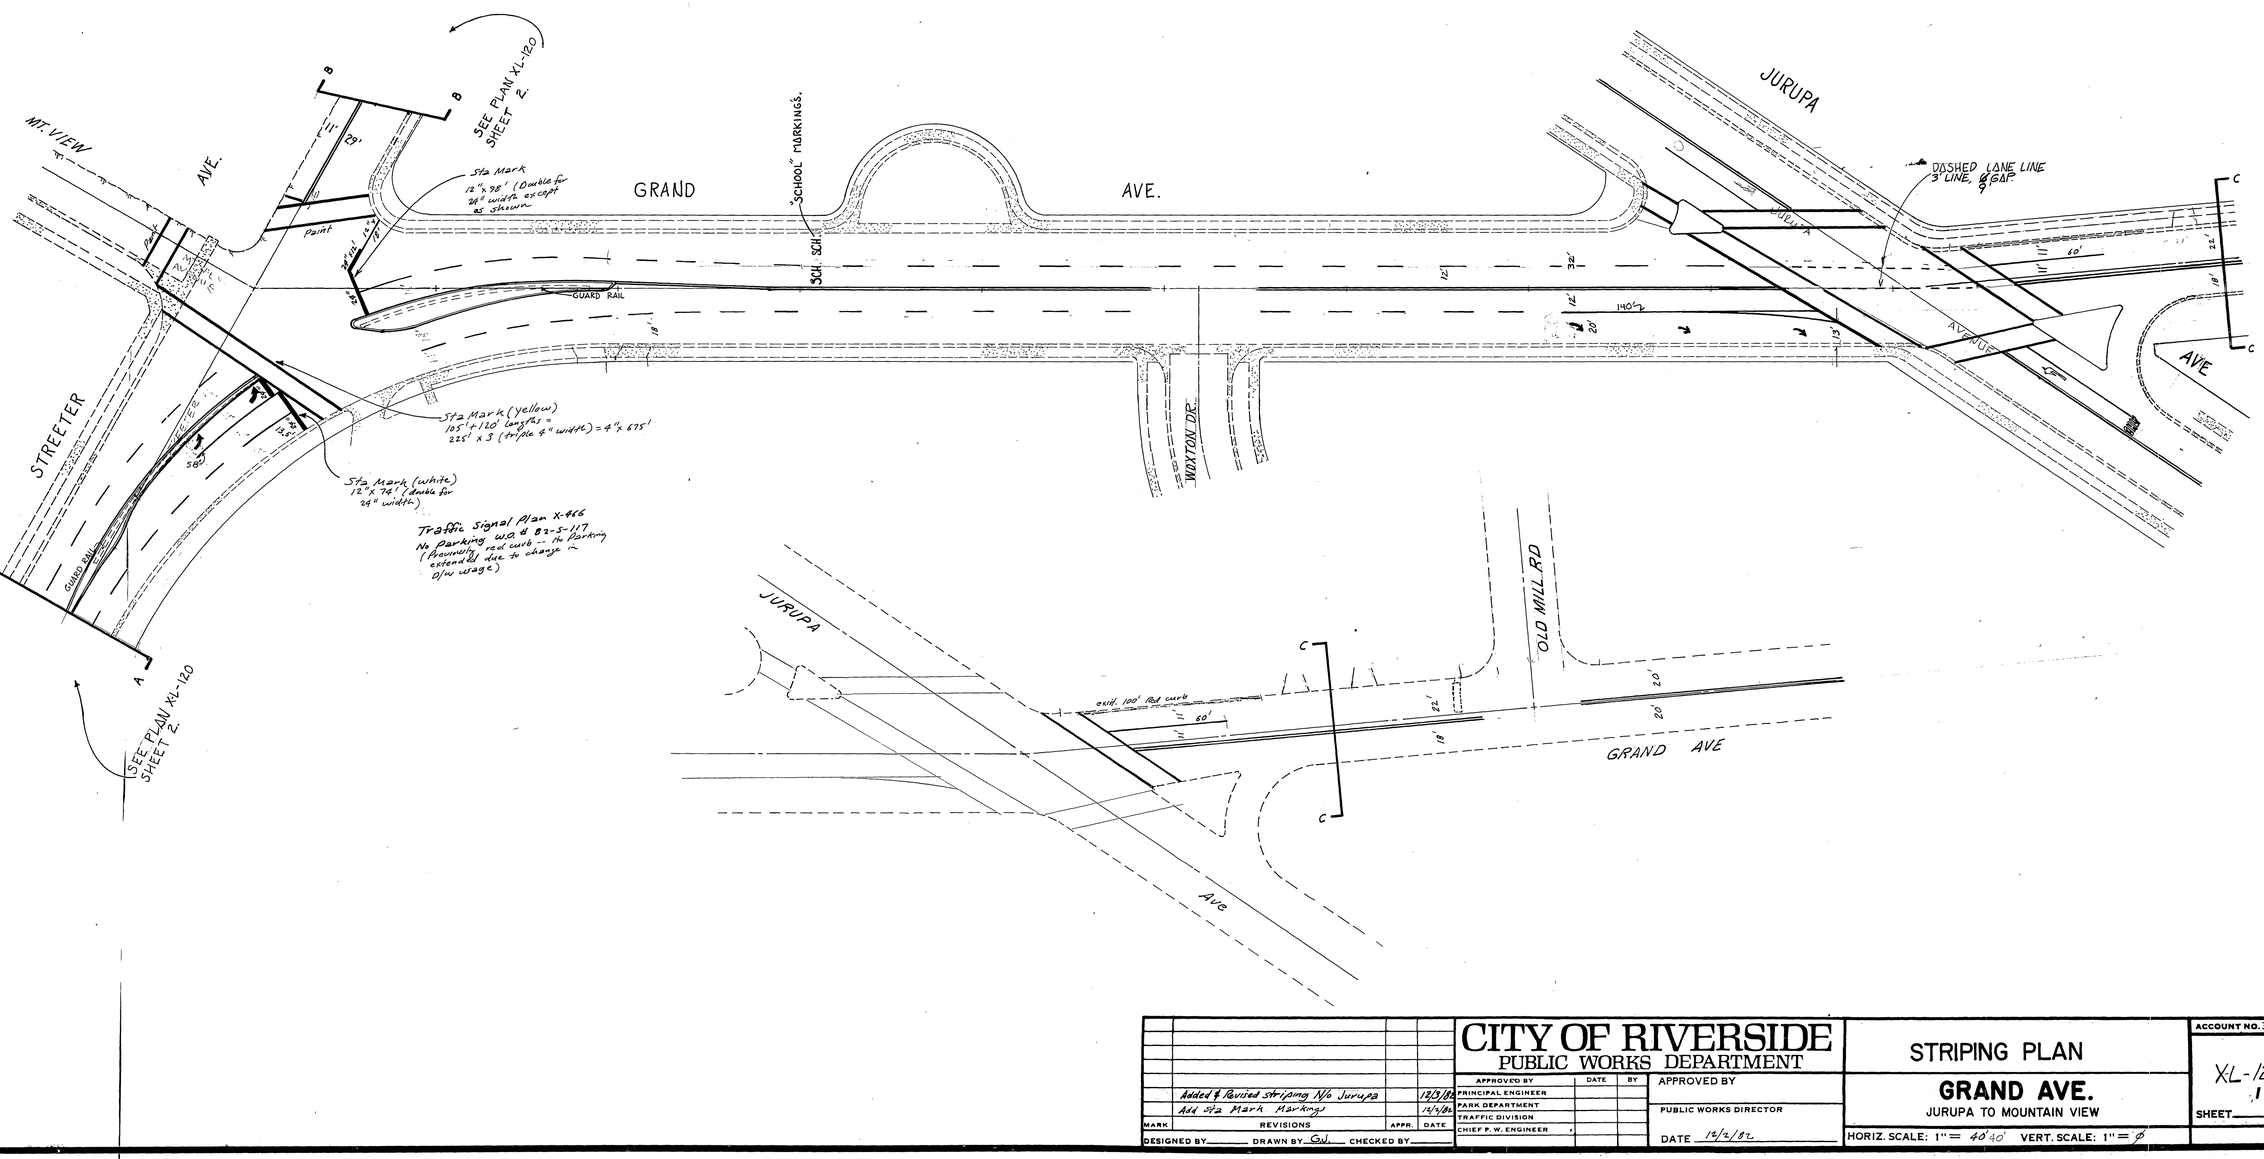

MARK	REVISIONS	APPR.	DATE
	Added & Revised Striping N/o Jurupa		12/1/82
	Add Sta Mark Markings		12/2/82

DESIGNED BY _____ DRAWN BY GJ. CHECKED BY _____

CITY OF RIVERSIDE
PUBLIC WORKS DEPARTMENT

APPROVED BY	DATE	BY
PRINCIPAL ENGINEER		
PARK DEPARTMENT		
TRAFFIC DIVISION		
CHIEF P.W. ENGINEER		

APPROVED BY

PUBLIC WORKS DIRECTOR

DATE 12/2/82

STRIPING PLAN

GRAND AVE.

JURUPA TO MOUNTAIN VIEW

HORIZ. SCALE: 1" = 40' VERT. SCALE: 1" = ∅

ACCOUNT NO. 30-575-377-09

XL-124

SHEET 1 OF 1

Sta Mark 2 of 5