

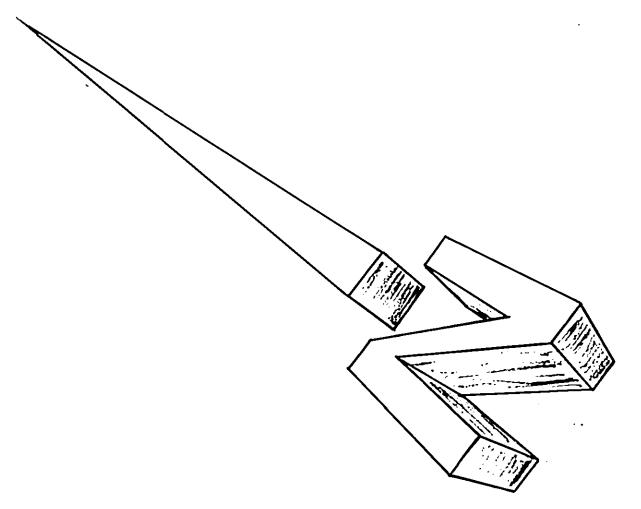


CITY OF RIVERSIDE PUBLIC WORKS DEPARTMENT		VAN BUREN BLVD. STRIPING		ACCOUNT NO. XL-125
APPROVED BY <i>D. Ray</i> 2/6/82 PRINCIPAL ENGINEER	BY <i>D. Ray</i> 1/24/82 PARK DEPARTMENT	DATE 2/6/82	APPROVED BY PUBLIC WORKS DIRECTOR	SHEET 1 OF 4
MARK REVISIONS	APPR. DATE REVISIONS	DATE 12/28/82	HORIZ. SCALE: 1" = 40' VERT. SCALE: 1" =	
DESIGNED BY <i>D. Ray</i> DRAWN BY <i>G.J.</i> CHECKED BY <i>D. Ray</i>				


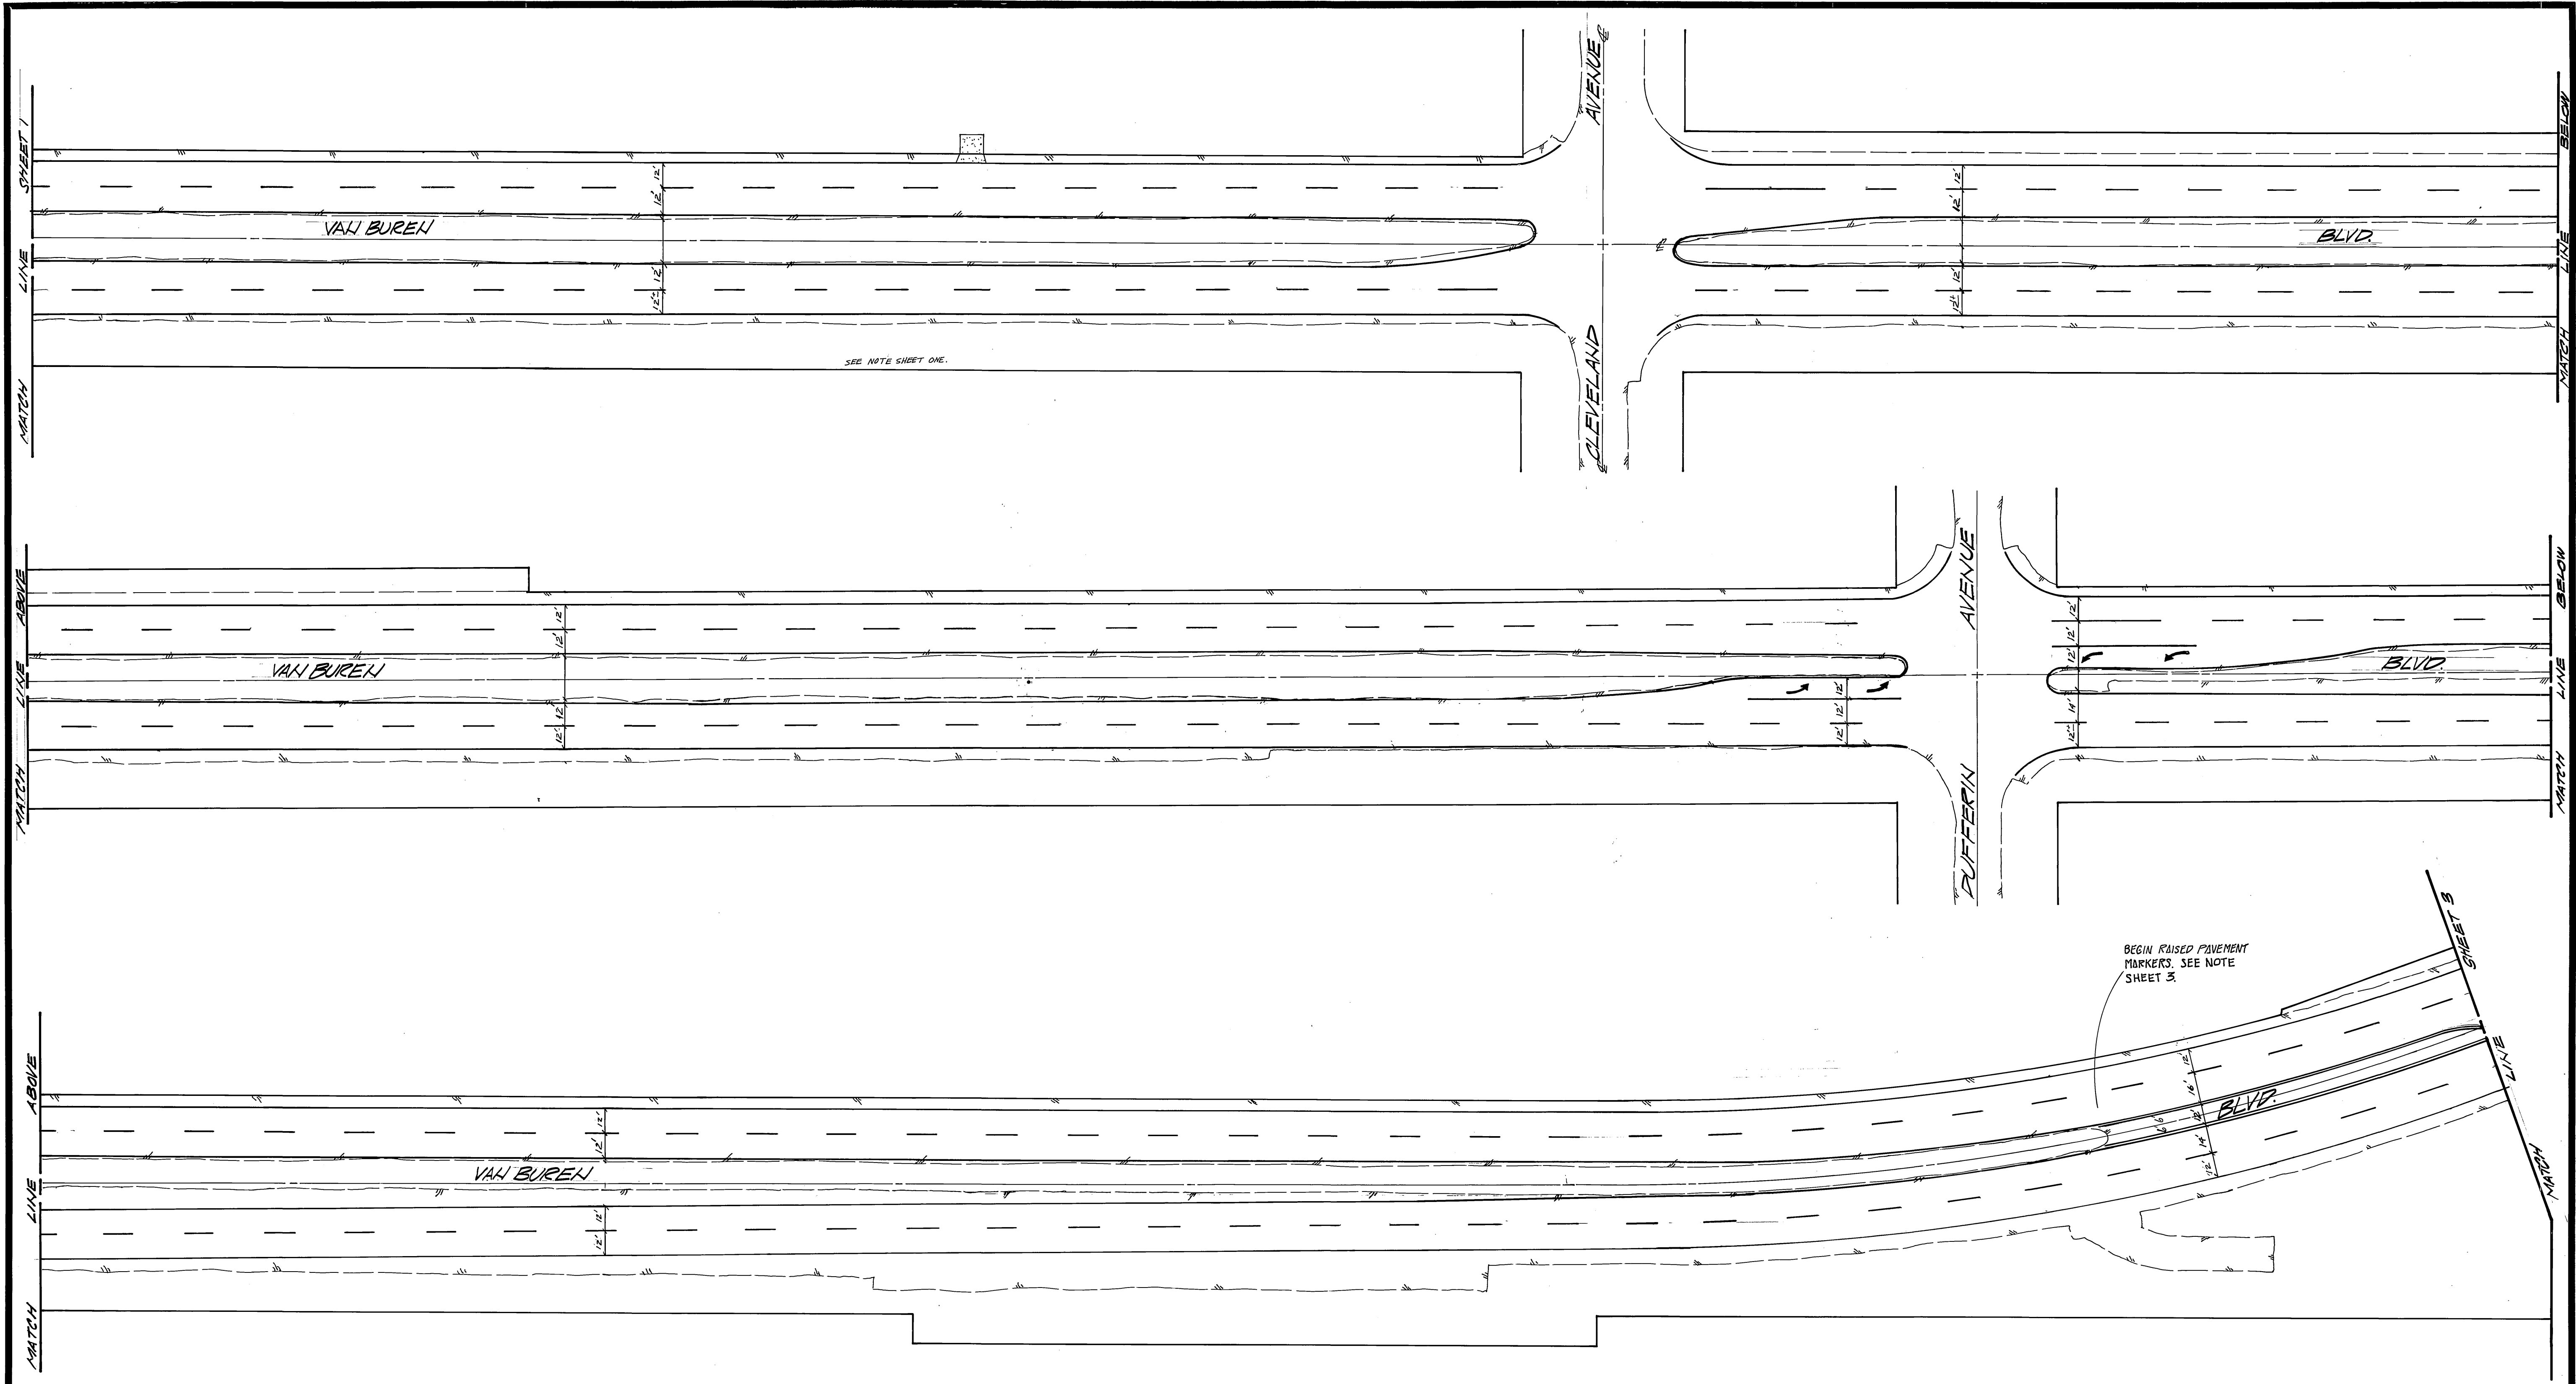


CITY OF RIVERSIDE PUBLIC WORKS DEPARTMENT				VAN BUREN BLVD. STRIPING		ACCOUNT NO. XL-125
APPROVED BY PRINCIPAL ENGINEER PARK DEPARTMENT TRAFFIC DIVISION CHIEF P. W. ENGINEER		BY <i>D. Ray</i>	DATE 12/12/82	APPROVED BY PUBLIC WORKS DIRECTOR DATE 12/28/82		SHEET 2 OF 4
MARK REVISIONS APPR. DATE		ADD'D EDGE LINE & PAVER'S MARKERS <i>D. Ray</i> 12/12/82		HORIZ. SCALE: 1" = 40' VERT. SCALE: 1" =		
DESIGNED BY <i>D. Ray</i>		DRAWN BY <i>G.J.</i>		CHECKED BY <i>D. Ray</i>		


NOTE. INSTALL RAISED PAVEMENT MARKERS ON: FROM SOUTH END OF DIRT MEDIAN TO SOUTHERLY CITY LIMITS.
 DOUBLE YELLOW-2 WAY YELLOW EACH SIDE, 24' OC.
 LANE LINE- 1 WAY WHITE, 48' OC.
 BARRIER LINE- 1 WAY WHITE, 12' OC.
 EDGE LINE - NONE.

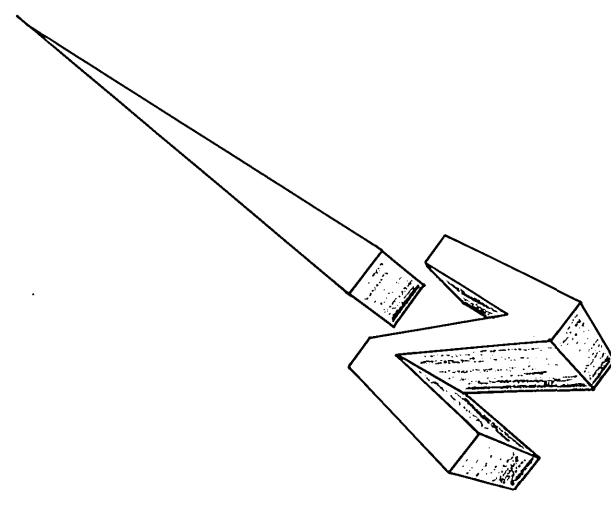

		CITY OF RIVERSIDE			
		PUBLIC WORKS DEPARTMENT			
APPROVED	BY	DATE	APPROVED BY		
PRINCIPAL ENGINEER			PUBLIC WORKS DIRECTOR		
ADDED EDGE LINE & PAVEMENT MARKERS	<i>D.Ray</i>	7/9/83	PARK DEPARTMENT		
TRAFFIC DIVISION					
MARK	REVISIONS	APPR. DATE	CHIEF P.W. ENGINEER	DATE	12/28/02
DESIGNED BY <i>D.Ray</i>	DRAWN BY <i>G.J.</i>	CHECKED BY <i>D.Ray</i>			
			VALBUREN BLVD.		ACCOUNT NO.
			STRIPING		XL-125
					SHEET 3 OF 4
			HORIZ. SCALE: 1" = 40'		VERT. SCALE: 1" =

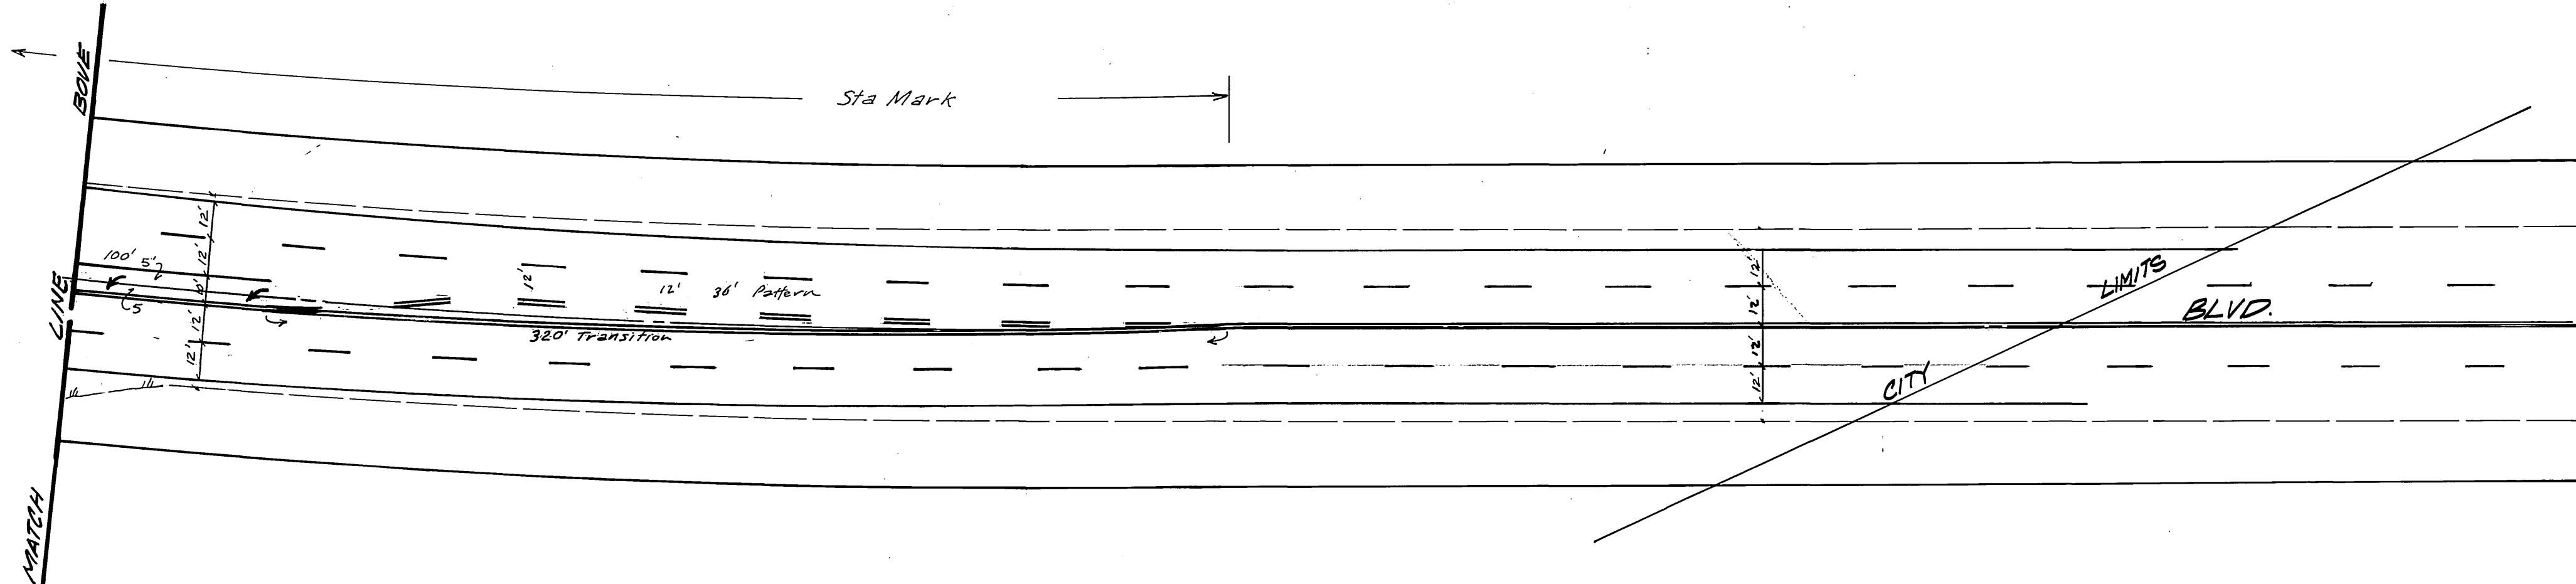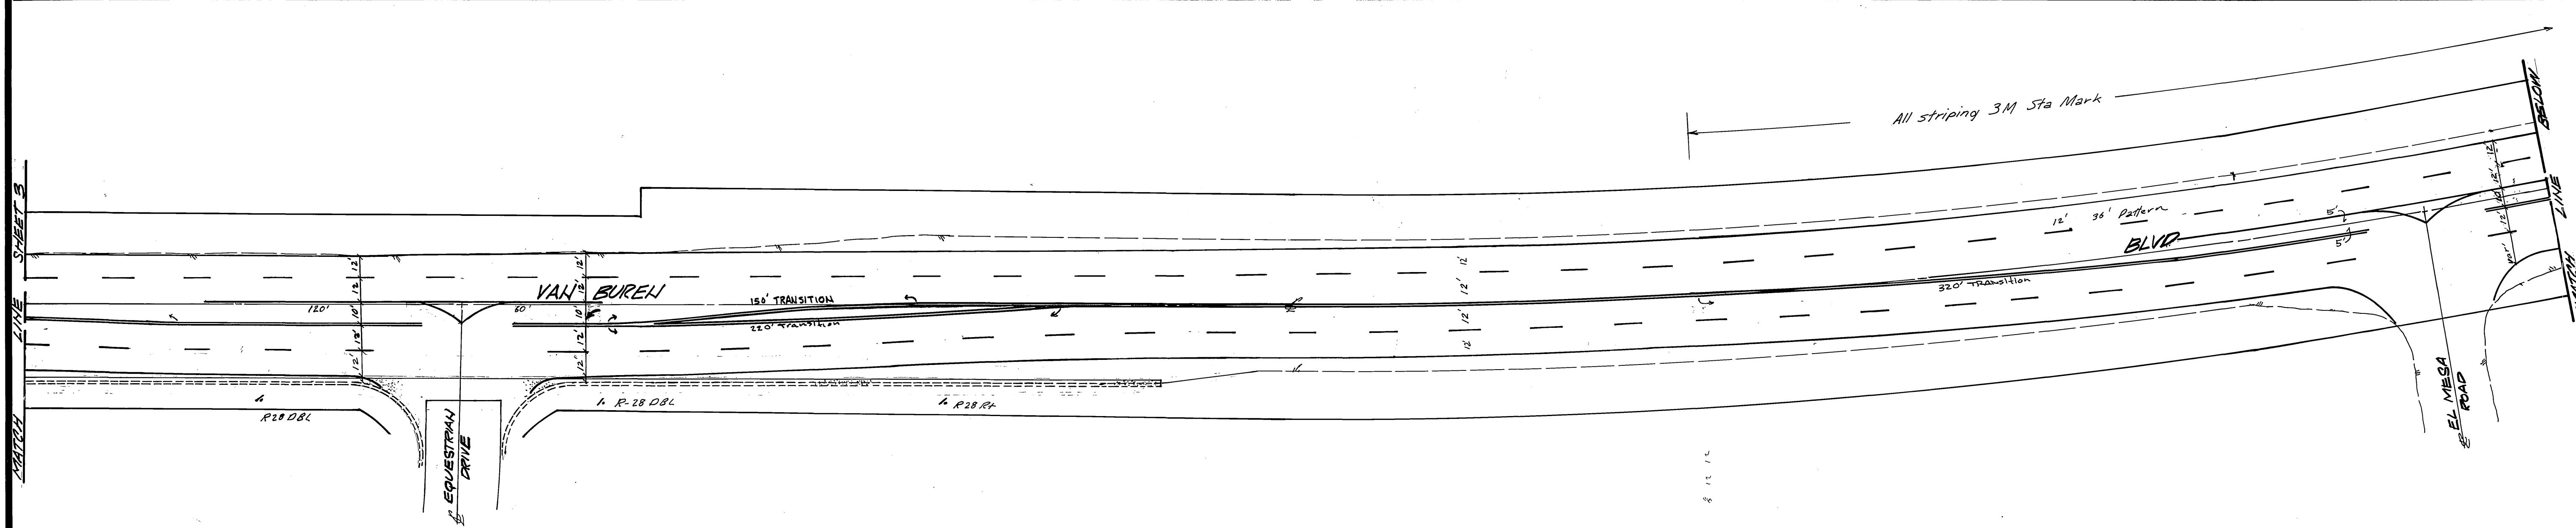

NOTE:
SEE SHEET 3 FOR RAISED PAVEMENT
MARKER REQUIREMENTS.

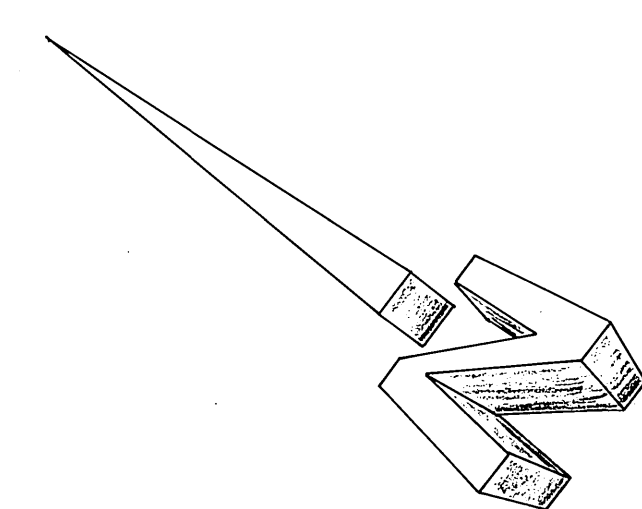

				CITY OF RIVERSIDE				ACCOUNT NO.	
				PUBLIC WORKS DEPARTMENT				VAN BUREN BLVD.	
ADDED EDGE LINE & PAVEMENT MARKERS		D. Ray 3/2/03		APPROVED BY		BY DATE		STRIPING	
Added Sta-Mark Striping at El Mesa		12/4/02		PRINCIPAL ENGINEER		PUBLIC WORKS DIRECTOR			
REVISIONS		APPR. DATE		PARK DEPARTMENT		TRAFFIC DIVISION		XL-125 SHEET 4 OF 4	
DESIGNED BY D. Ray		DRAWN BY G.J.		CHIEF P.W. ENGINEER		DATE 12/20/02			
				HORIZ. SCALE: 1" = 40'				VERT. SCALE: 1" =	

Sta Mark 5 of 5