


See Continuation below

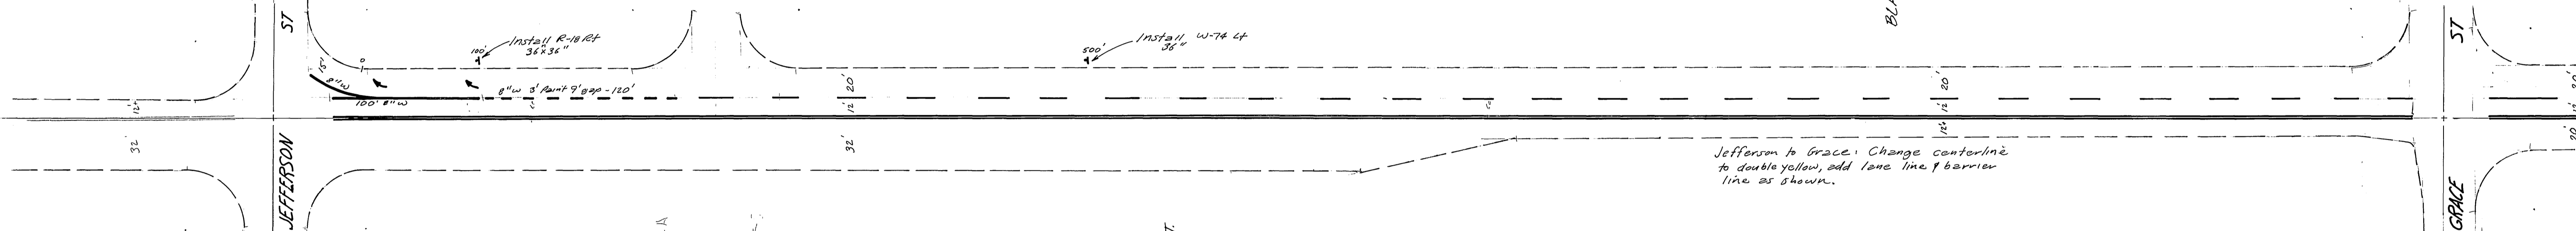

"MARKING" LEGEND  
S = STOP  
A = AHEAD



SPEED LIMIT 40 MPH  
STRIPE 7' GAP 17'

CITY OF RIVERSIDE, CALIFORNIA DEPARTMENT OF PUBLIC WORKS		STRIPING PLAN	ACCOUNT No 30-575-244-07
APPROVED BY PRINCIPAL ENGINEER PARK DEPARTMENT TRAFFIC DIVISION CHIEF P. W. ENGR.	BY DATE 8/13/84	APPROVED BY DIRECTOR OF PUBLIC WORKS DATE 8-27-84	DRAWING NUMBER XL-130 SHEET 1 OF 1
DESIGNED BY D. DeJ DRAWN BY GWT CHECKED BY D. DeJ		SCALE 1"=50'	