

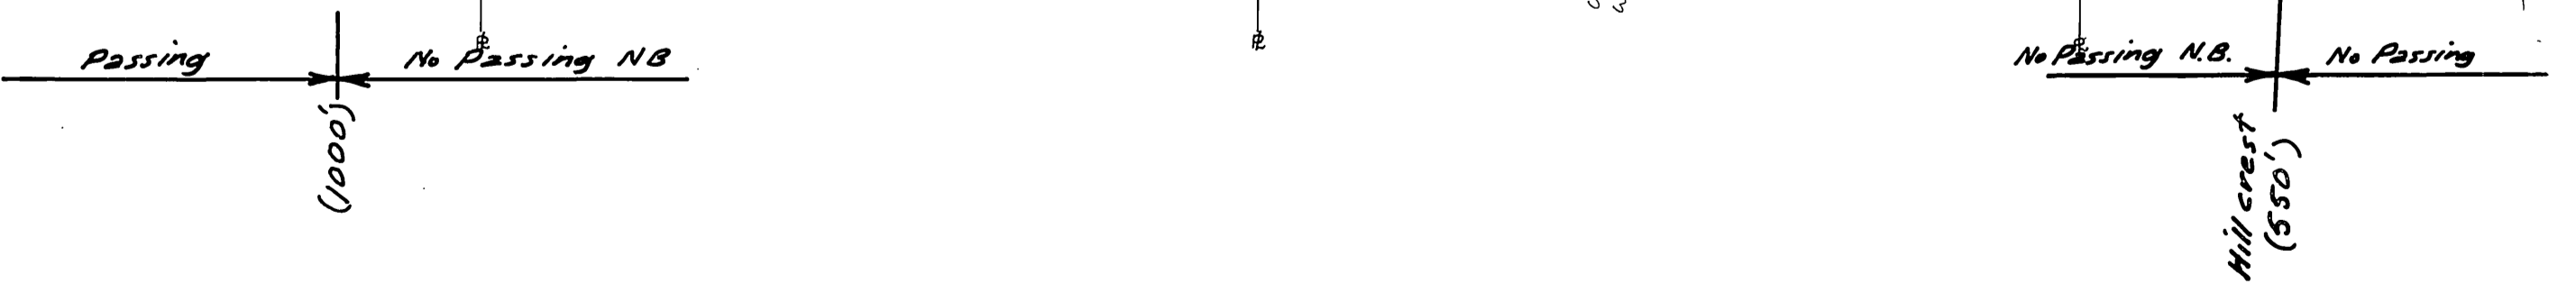
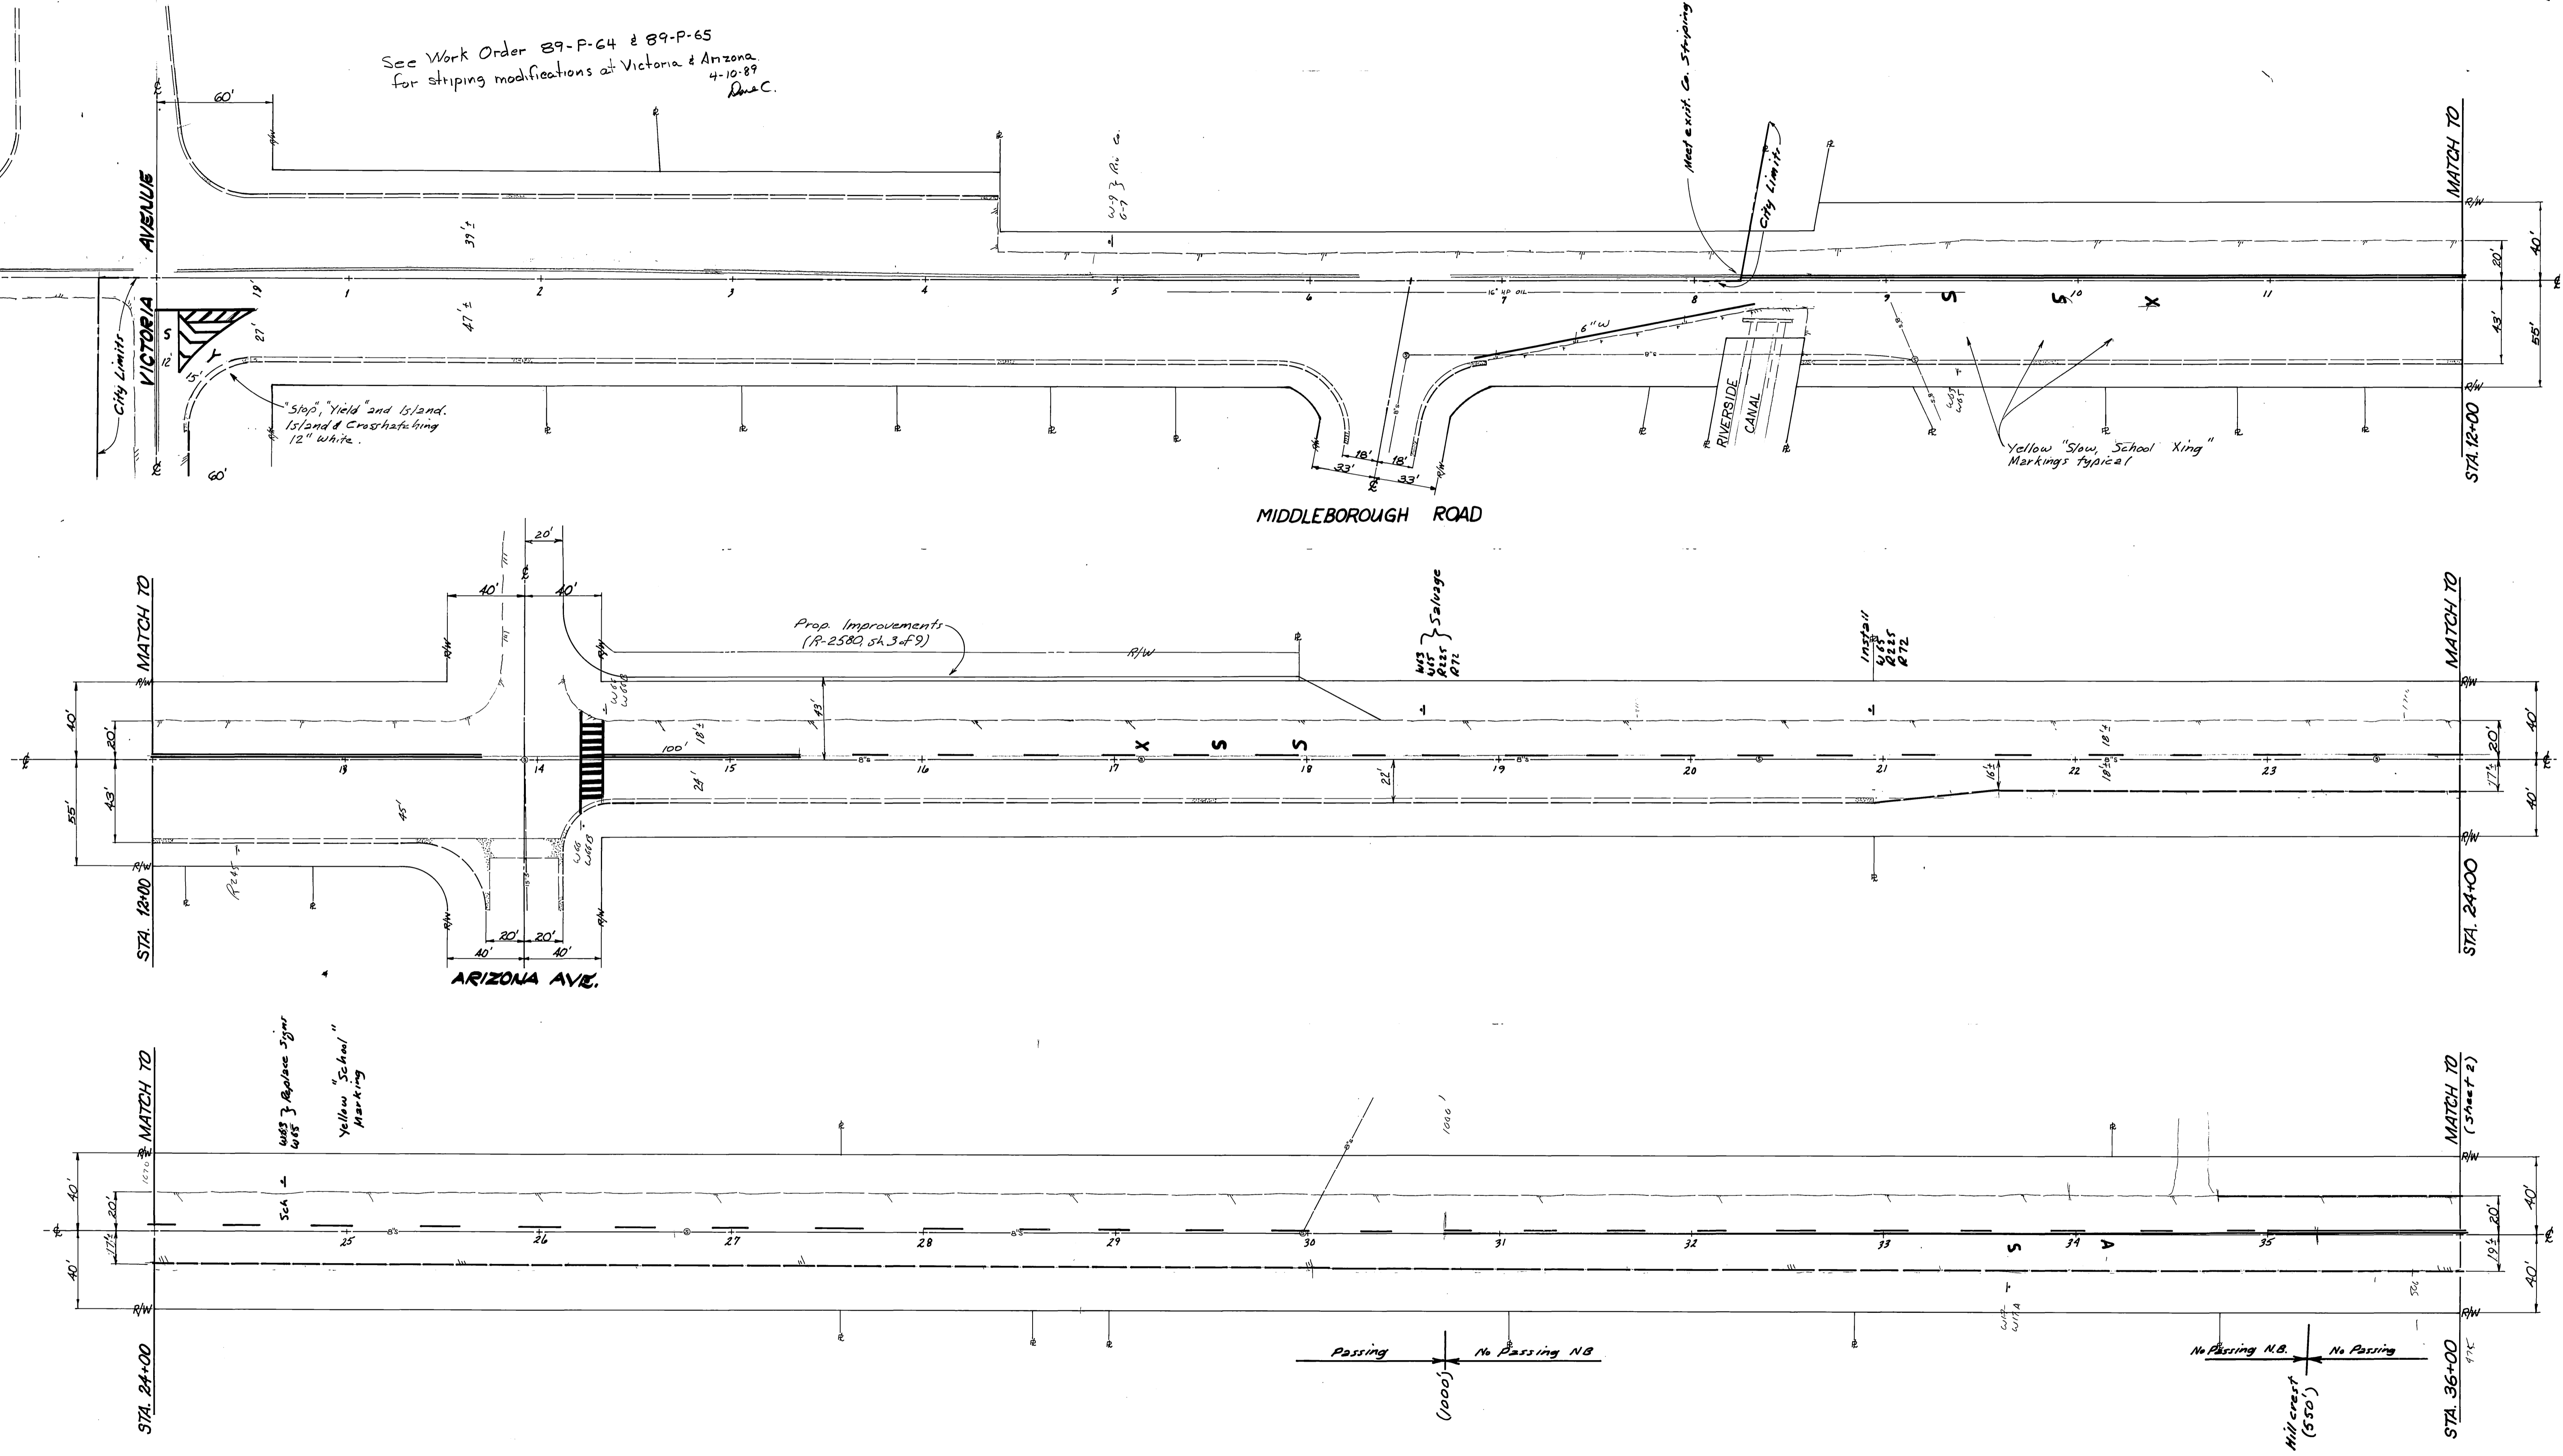
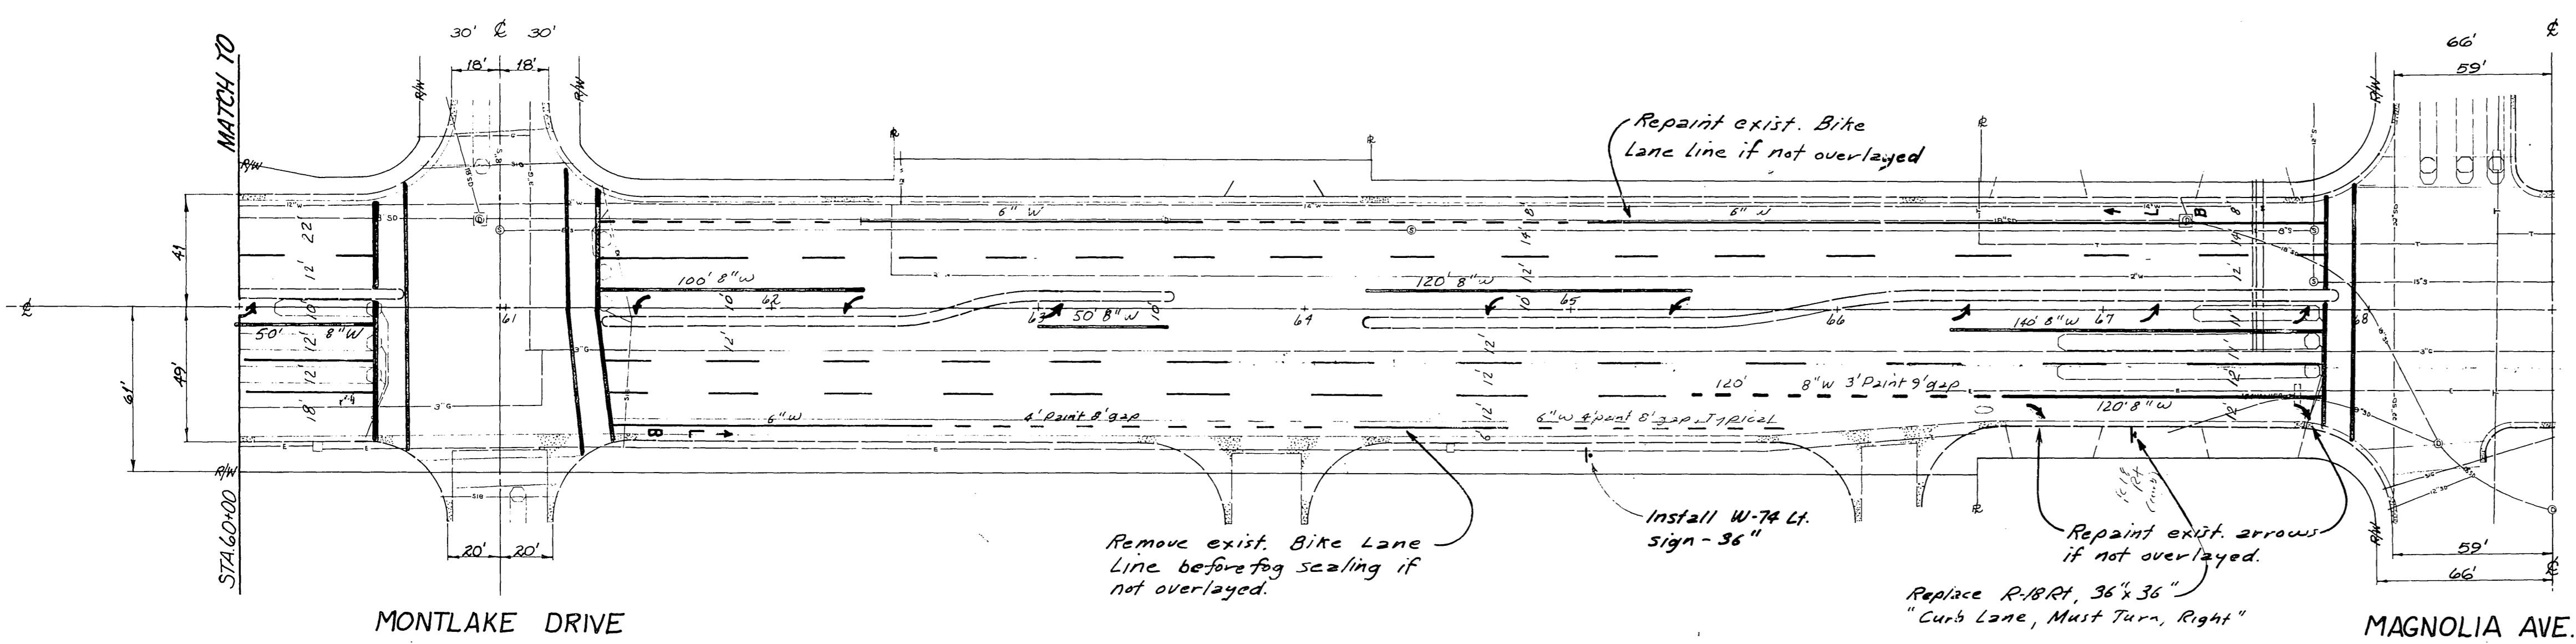
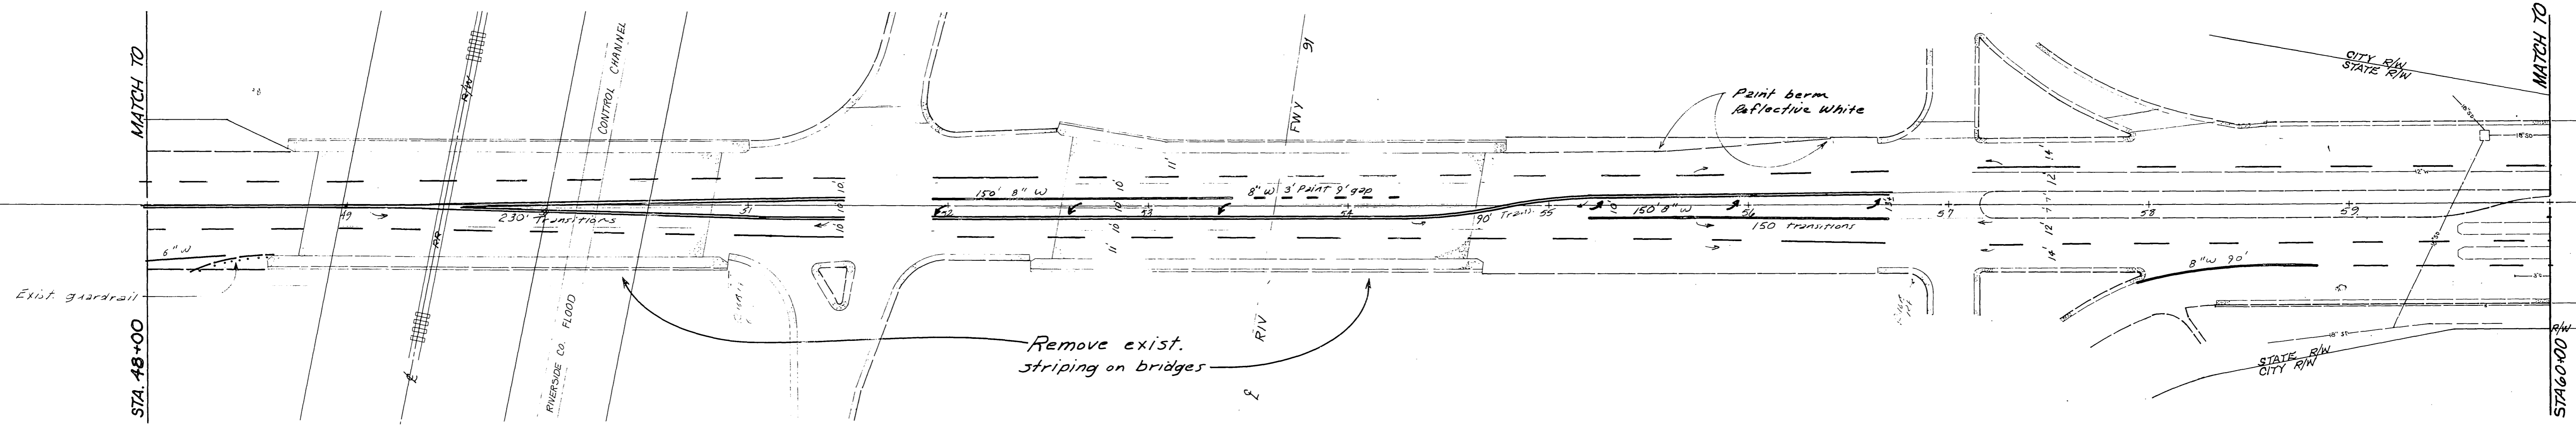


See Work Order 89-P-64 & 89-P-65  
for striping modifications at Victoria & Arizona  
4-10-89  
D.W.C.

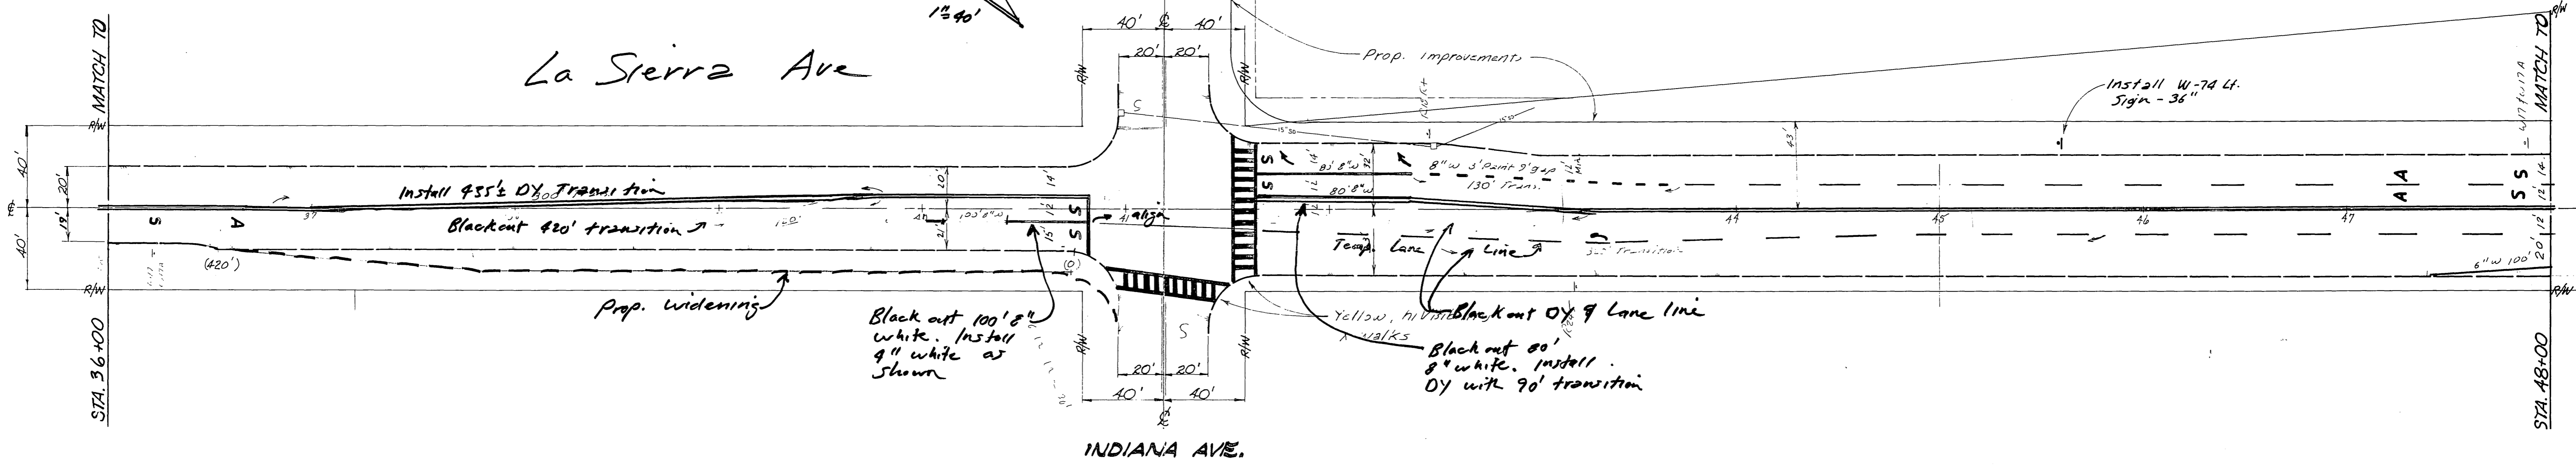

<b>CITY OF RIVERSIDE</b> PUBLIC WORKS DEPARTMENT		<b>REHABILITATION OF MAJOR CITY STREETS 1984</b> <b>LA SIERRA AVENUE</b> <b>VICTORIA TO MAGNOLIA</b>		ACCOUNT NO. 30-515-244-07 <b>XL-147</b> SHEET 1 OF 2
APPROVED BY PRINCIPAL ENGINEER DATE 8-16-85	APPROVED BY PUBLIC WORKS DIRECTOR DATE 8-27-85	DESIGNED BY D. Ray DRAWN BY D.R. CHECKED BY D.P.	HORIZ SCALE 1" = 40' VERT SCALE 1" = 10'	

# La Sierra Ave

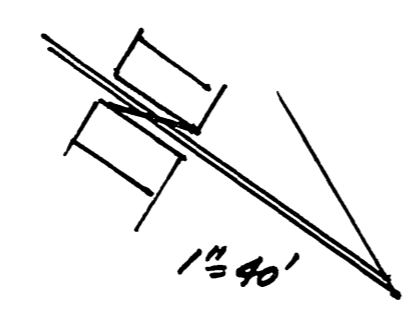

MAY 0 3 1985

<b>CITY OF RIVERSIDE</b> PUBLIC WORKS DEPARTMENT				<b>REHABILITATION OF MAJOR CITY STREETS 1984</b>		ACCOUNT NO. 32-515-261-07	
APPROVED BY	DATE	BY	APPROVED BY	<b>LA SIERRA AVENUE</b> VICTORIA TO MAGNOLIA			
PRINCIPAL ENGINEER	4/16/84	JR	PUBLIC WORKS DIRECTOR				
TRAFFIC DIVISION	DATE	5-16-84	DATE	SHEET <b>2</b> OF <b>2</b>			
DESIGNED BY <i>D. Rey</i>	DRAWN BY <i>D.R.</i>	CHECKED BY <i>D.R.</i>	DATE				
HORIZ SCALE 1" = 40' VERT SCALE 1" = 10'				XL-147			