

SEE SHEET 6 FOR DETAILED CONST. OF INTERSECTION

NOTE: GRANITE CURBS & GUTTERS SHALL BE PROTECTED IN PLACE.

FOR STREET WIDENING PLANS SEE SHEETS 6 & 7

STRIPING/PVMT. MARKING
STA. 52+40 BEGIN

CAUTION!
HIGH PRESSURE GAS

CURVE DATA				
INDEX	R	Δ	T	L
1	12'	30°	12'	19'

CITY OF RIVERSIDE
PUBLIC WORKS DEPARTMENT

APPROVED BY: [Signature]
DATE: 8/12/88


DESIGNED BY: [Signature]
DRAWN BY: SK RUZ
CHECKED BY: EC

STRIPING & SIGNING FOR
REHABILITATION OF MAJOR
CITY STREETS 1988-1989
UNIVERSITY AVENUE
MULLBERRY TO COMER

HORIZ. SCALE: 1" = 40'

ACCOUNT NO. 30-575-240-09

XI-216
(R-2945)
SHEET 1 OF 2

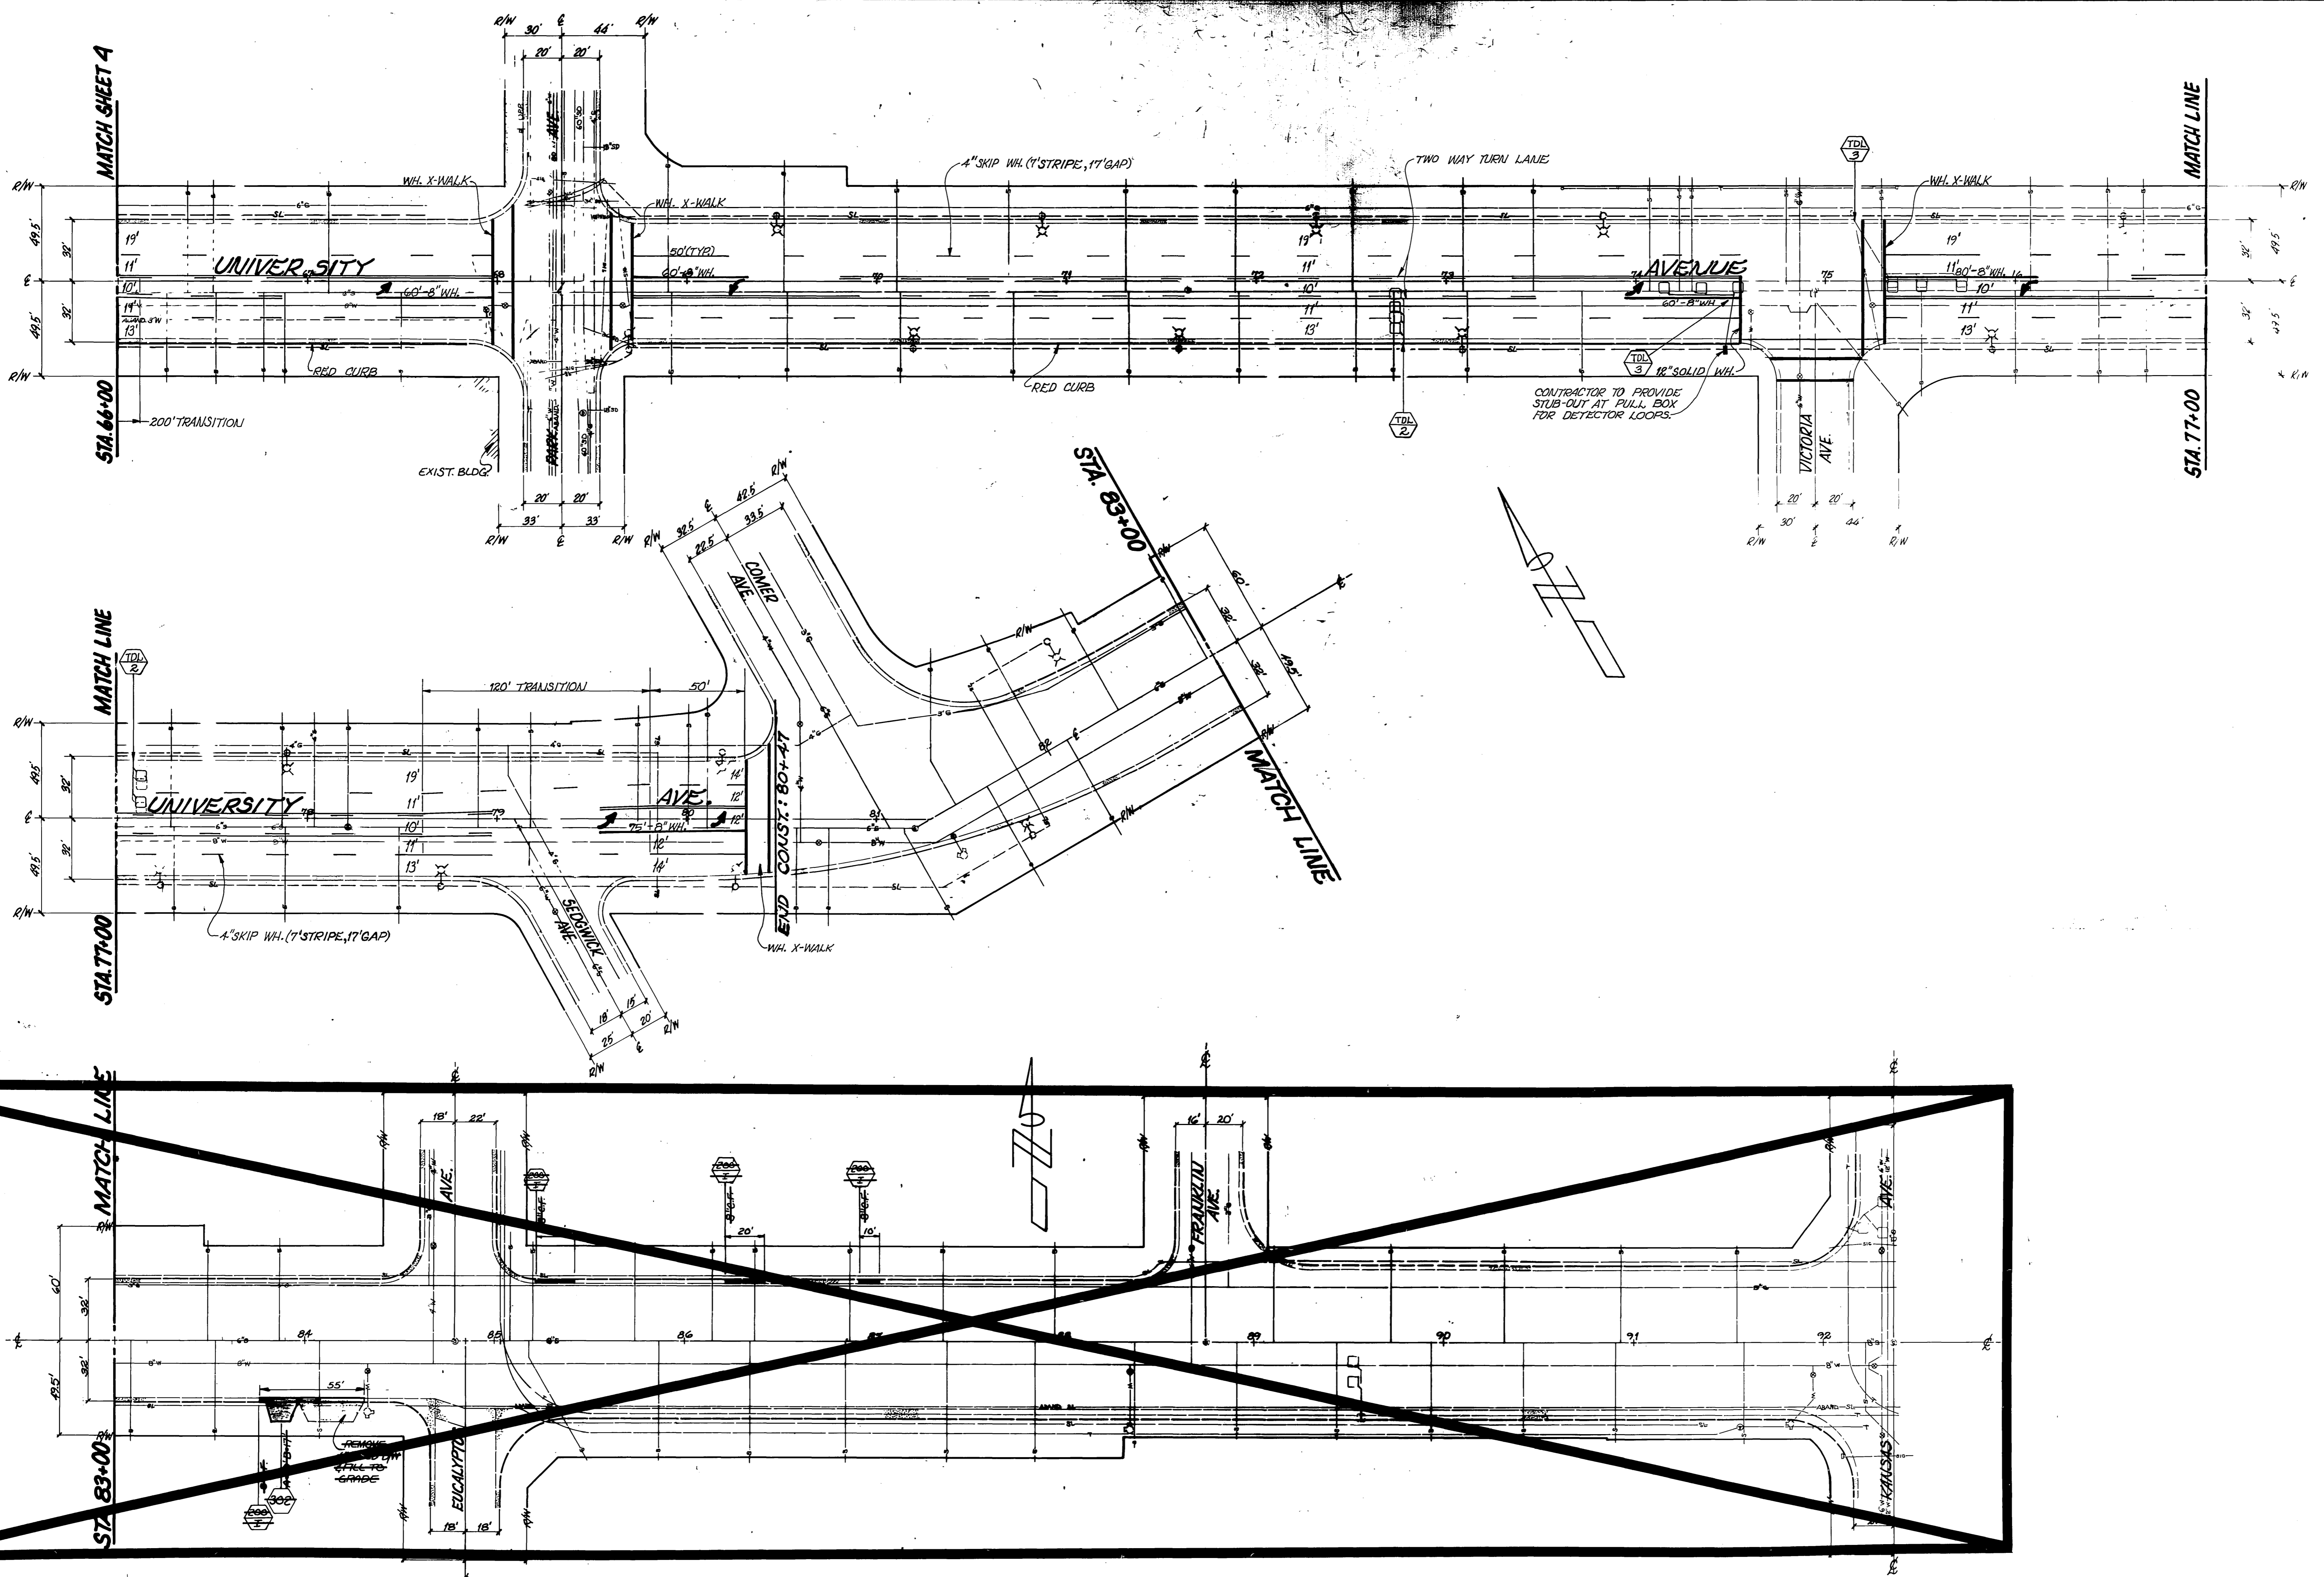

CURVE DATA				
INDEX	R	Δ	T	L
①	27'	90°00'00"	27'	42.41'

CITY OF RIVERSIDE
PUBLIC WORKS DEPARTMENT

APPROVED BY: *[Signature]* DATE: 7-21-88
 PRINCIPAL ENGINEER: *[Signature]*
 TRAFFIC DIVISION: 1/14/88
 CHIEF P.W. INSPECTOR: *[Signature]*
 SURVEYOR: *[Signature]*

STRIPING & SIGNING FOR
REHABILITATION OF MAJOR
CITY STREETS 1988-1989
UNIVERSITY AVENUE
MULBERRY TO COMER

ACCOUNT NO 30-575-240-09
XL-215
 (R-2945)
 SHEET 2 OF 2

HORIZ SCALE: 1" = 40'

DESIGNED BY: *[Signature]* DRAWN BY: *[Signature]* CHECKED BY: *[Signature]*

APPROVED BY: *[Signature]* DATE: 8/12/88
 PUBLIC WORKS DIRECTOR