


VAN BUREN BLVD.

- NOTES**
1. PAINT STRIPING TO BE PER SECTION 210 AND SECTION 310 OF STANDARDS AND SPECIFICATIONS FOR PUBLIC WORKS CONSTRUCTION AND THE CITY OF RIVERSIDE INSPECTOR, TRAFFIC DIVISION.
 2. PAINT MEDIAN NOSES REFLECTIVE YELLOW
 3. PAINT DIRECTIONAL ARROWS AS SHOWN
 4. INSTALL SIGN AS SHOWN BY IDENTIFICATION # C 2. LOCATION PER CITY INSPECTOR.
 5. (R-1) STOP SIGNS TO BE MOUNTED PER ARCHITECTS SITE PLAN # S.D.-1 USING 4x6 OR 4x8 POSTS STAINED TO MATCH BUILDING COLUMNS PER ARCHITECTS BUILDING PLAN.
 6. SIGNS ARE TO BE MOUNTED PER LATEST STATE OF CALIFORNIA TRAFFIC MANUAL AND CITY OF RIVERSIDE TRAFFIC DIVISION, PUBLIC WORKS DEPARTMENT.

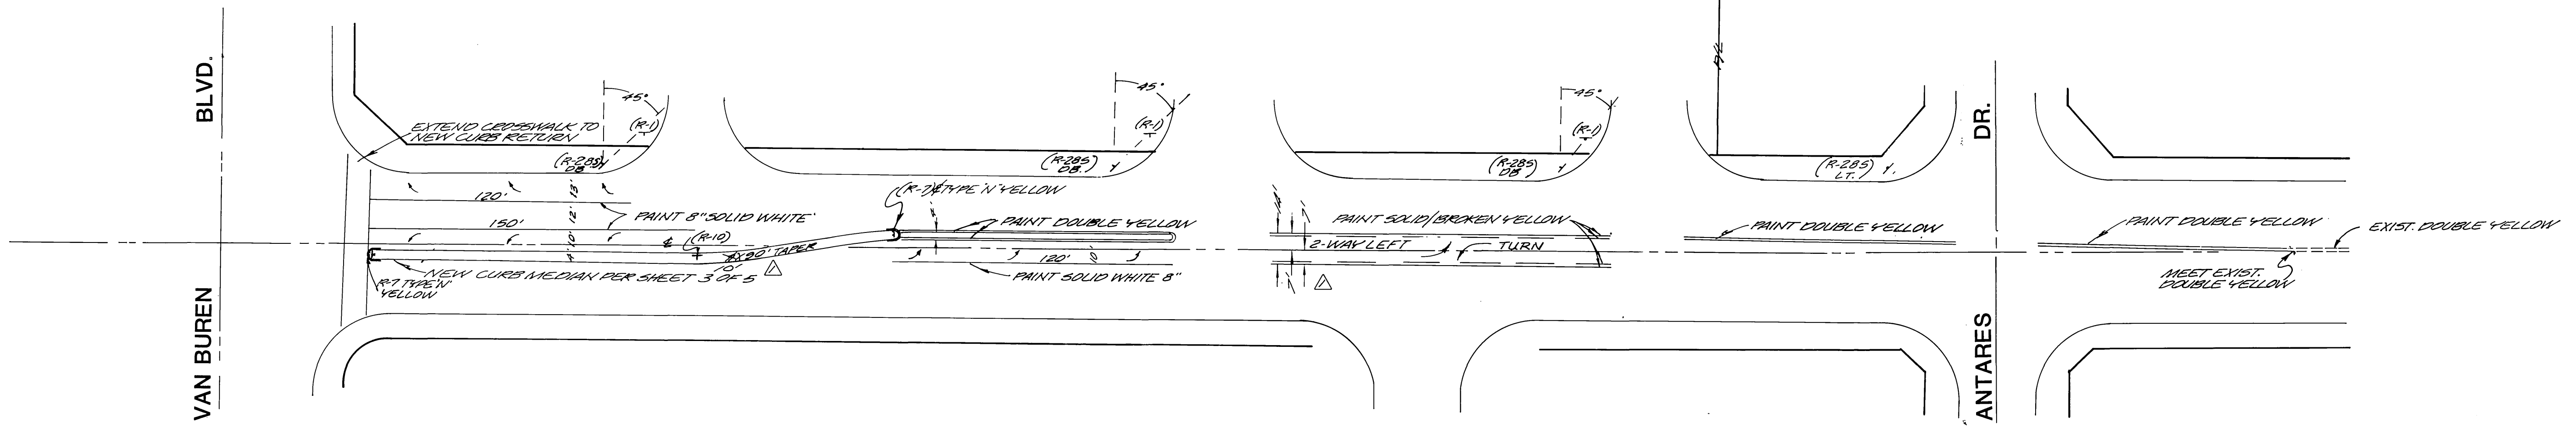

LINCOLN AVENUE

CITY OF RIVERSIDE
PUBLIC UTILITIES DEPT
ELECTRIC DIVISION
John Johnson 5/17/84
CHIEF UTILITIES ENGINEER DATE

CITY OF RIVERSIDE
PUBLIC UTILITIES DEPT
DOMESTIC SYSTEM
Don Parks 5-21-84
CHIEF UTILITIES ENGINEER DATE

SPG
The SP Group
5225 Canyon Crest Drive
6th, 700 Suite 203
Riverside, California 92507
714 351-8328
Engineering, Surveying,
Planning, Architecture,
Construction Management
PLANS PREPARED UNDER THE DIRECTION OF:
David J. Spivey
R.C.E. NO. 30534 DATE 5-18-84

MARK	REVISIONS	APPR DATE
△	CHANGED PAPER & DIMENSIONS 8-20-84	11/18/84
△	CHANGED PAPER ON WEST SIDE	8-20-84
△	2 AND DIM. 8-20-84	8-20-84

CITY OF RIVERSIDE, CALIFORNIA
PUBLIC WORKS DEPARTMENT
APPROVED BY: *[Signature]* BY DATE: 6/11/84
PRINCPAL ENGR. PARK DEPT.
TRAFFIC DIVIN. CHIEF P.W. ENGR.
DATE: 6/11/84

STRIPING & SIGNING PLAN
VAN BUREN BLVD. & LINCOLN AVE.
SCALE: 1" = 40'

ACCOUNT NO. XL-230
DRAWING NUMBER
SHEET 1 OF 1