


PROFILE PLAN

SCALE  
H=40' H  
V=8' V




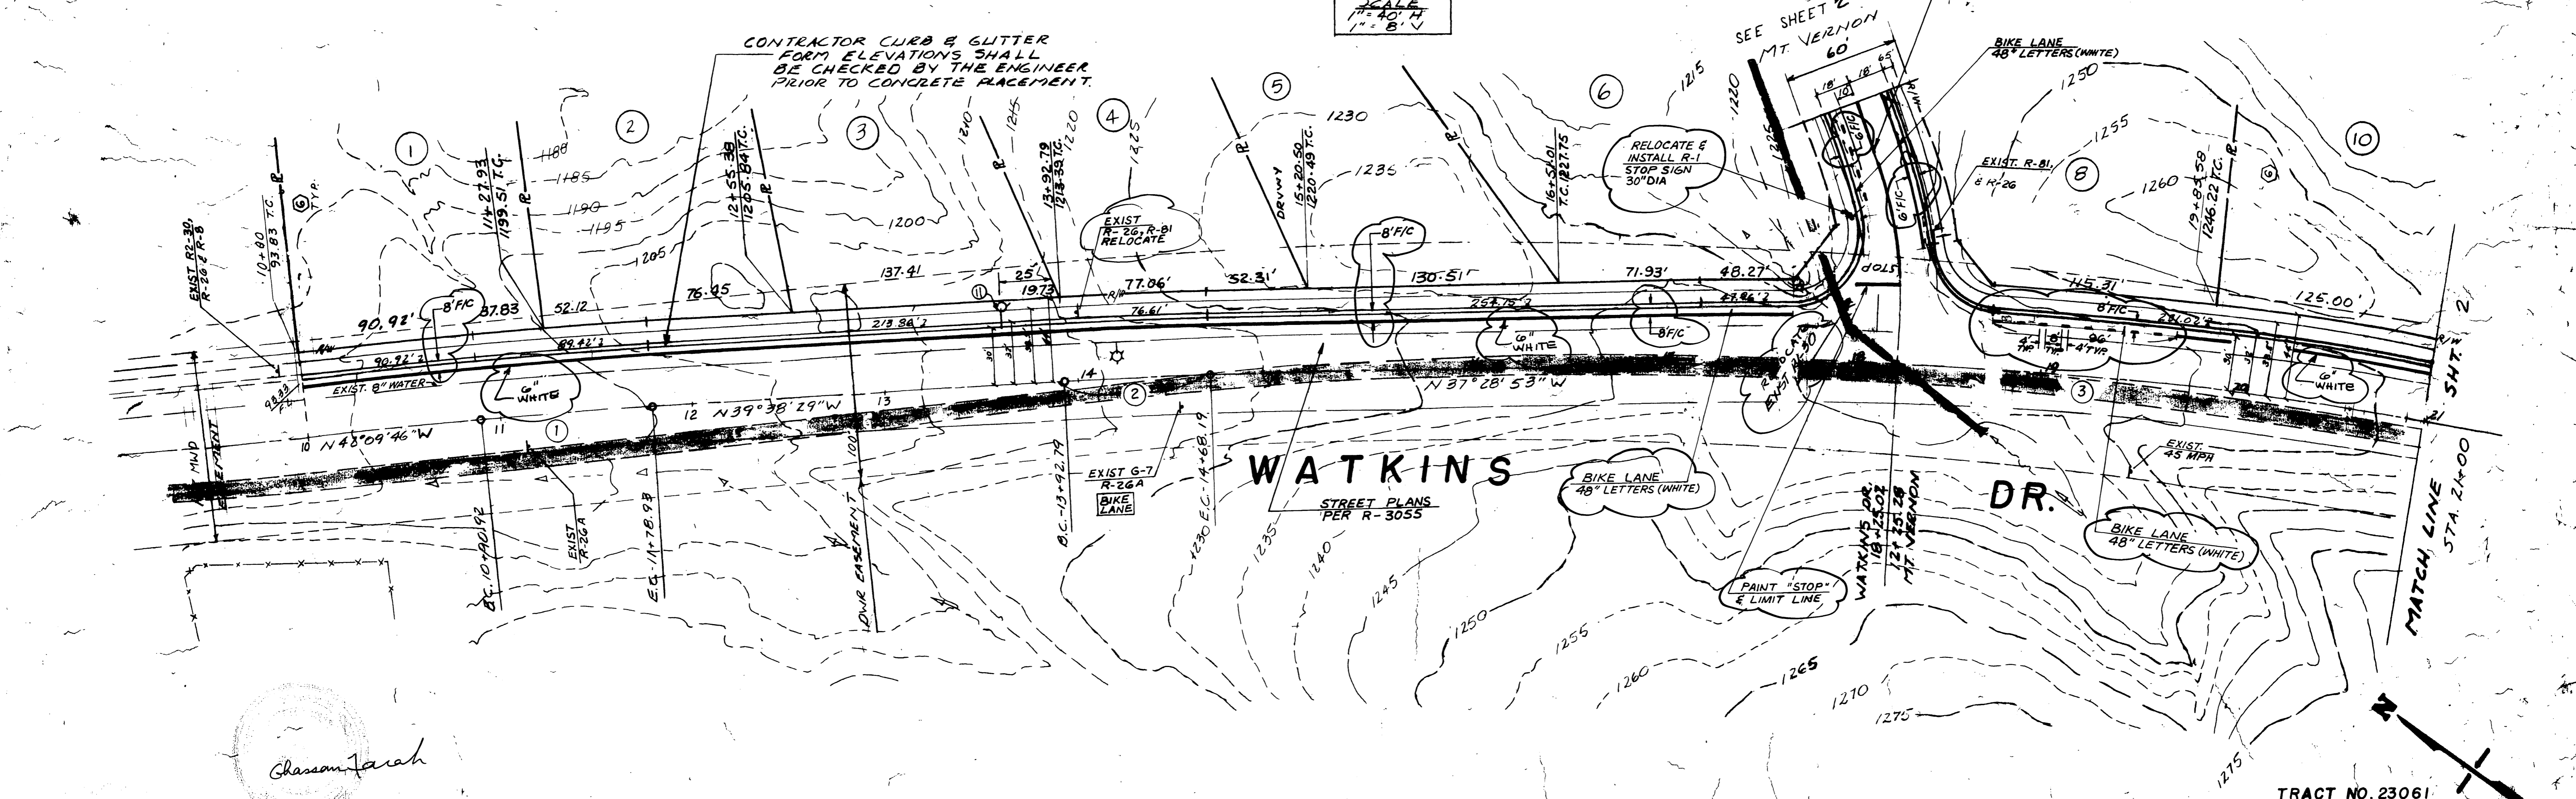


*Chasam Farah*

	DELTA	R	L	T
1	2° 31' 17"	2000	88.01'	44.01'
2	2° 09' 36"	2000	75.40'	37.70'
3	12° 00' 08"	1800	371.06'	189.22'
4	2° 31' 17"	2092	89.42'	44.72'
5	2° 09' 36"	2092	76.61'	38.31'
6	1° 30' 00"	1832	87.96'	23.98'
7	7° 13' 31"	1832	231.02'	115.61'

ACREAGE LAND SYSTEMS Inc.  
102 E. GRAND BLVD.  
CORONA, CA 91719  
(714) 734-0152

CITY OF RIVERSIDE, CALIFORNIA PUBLIC WORKS DEPARTMENT		STREET STRIPING PLANS OF WATKINS DR. & MT. VERNON		ACCOUNT NO. DRAWING NUMBER <b>XL-232</b>
APPROVED BY PRINCIPAL ENGINEER <i>[Signature]</i>	BY DATE 11/26/90	APPROVED BY DIRECTOR OF PUBLIC WORKS <i>[Signature]</i>	DATE 11/26/90	SCALE AS SHOWN
TRAFFIC DIVISION CHIEF PUB. WKS. ENGR.	DATE 11/26/90	DESIGNED BY DWG. NO.	DRAWN BY DATE	CHECKED BY DATE

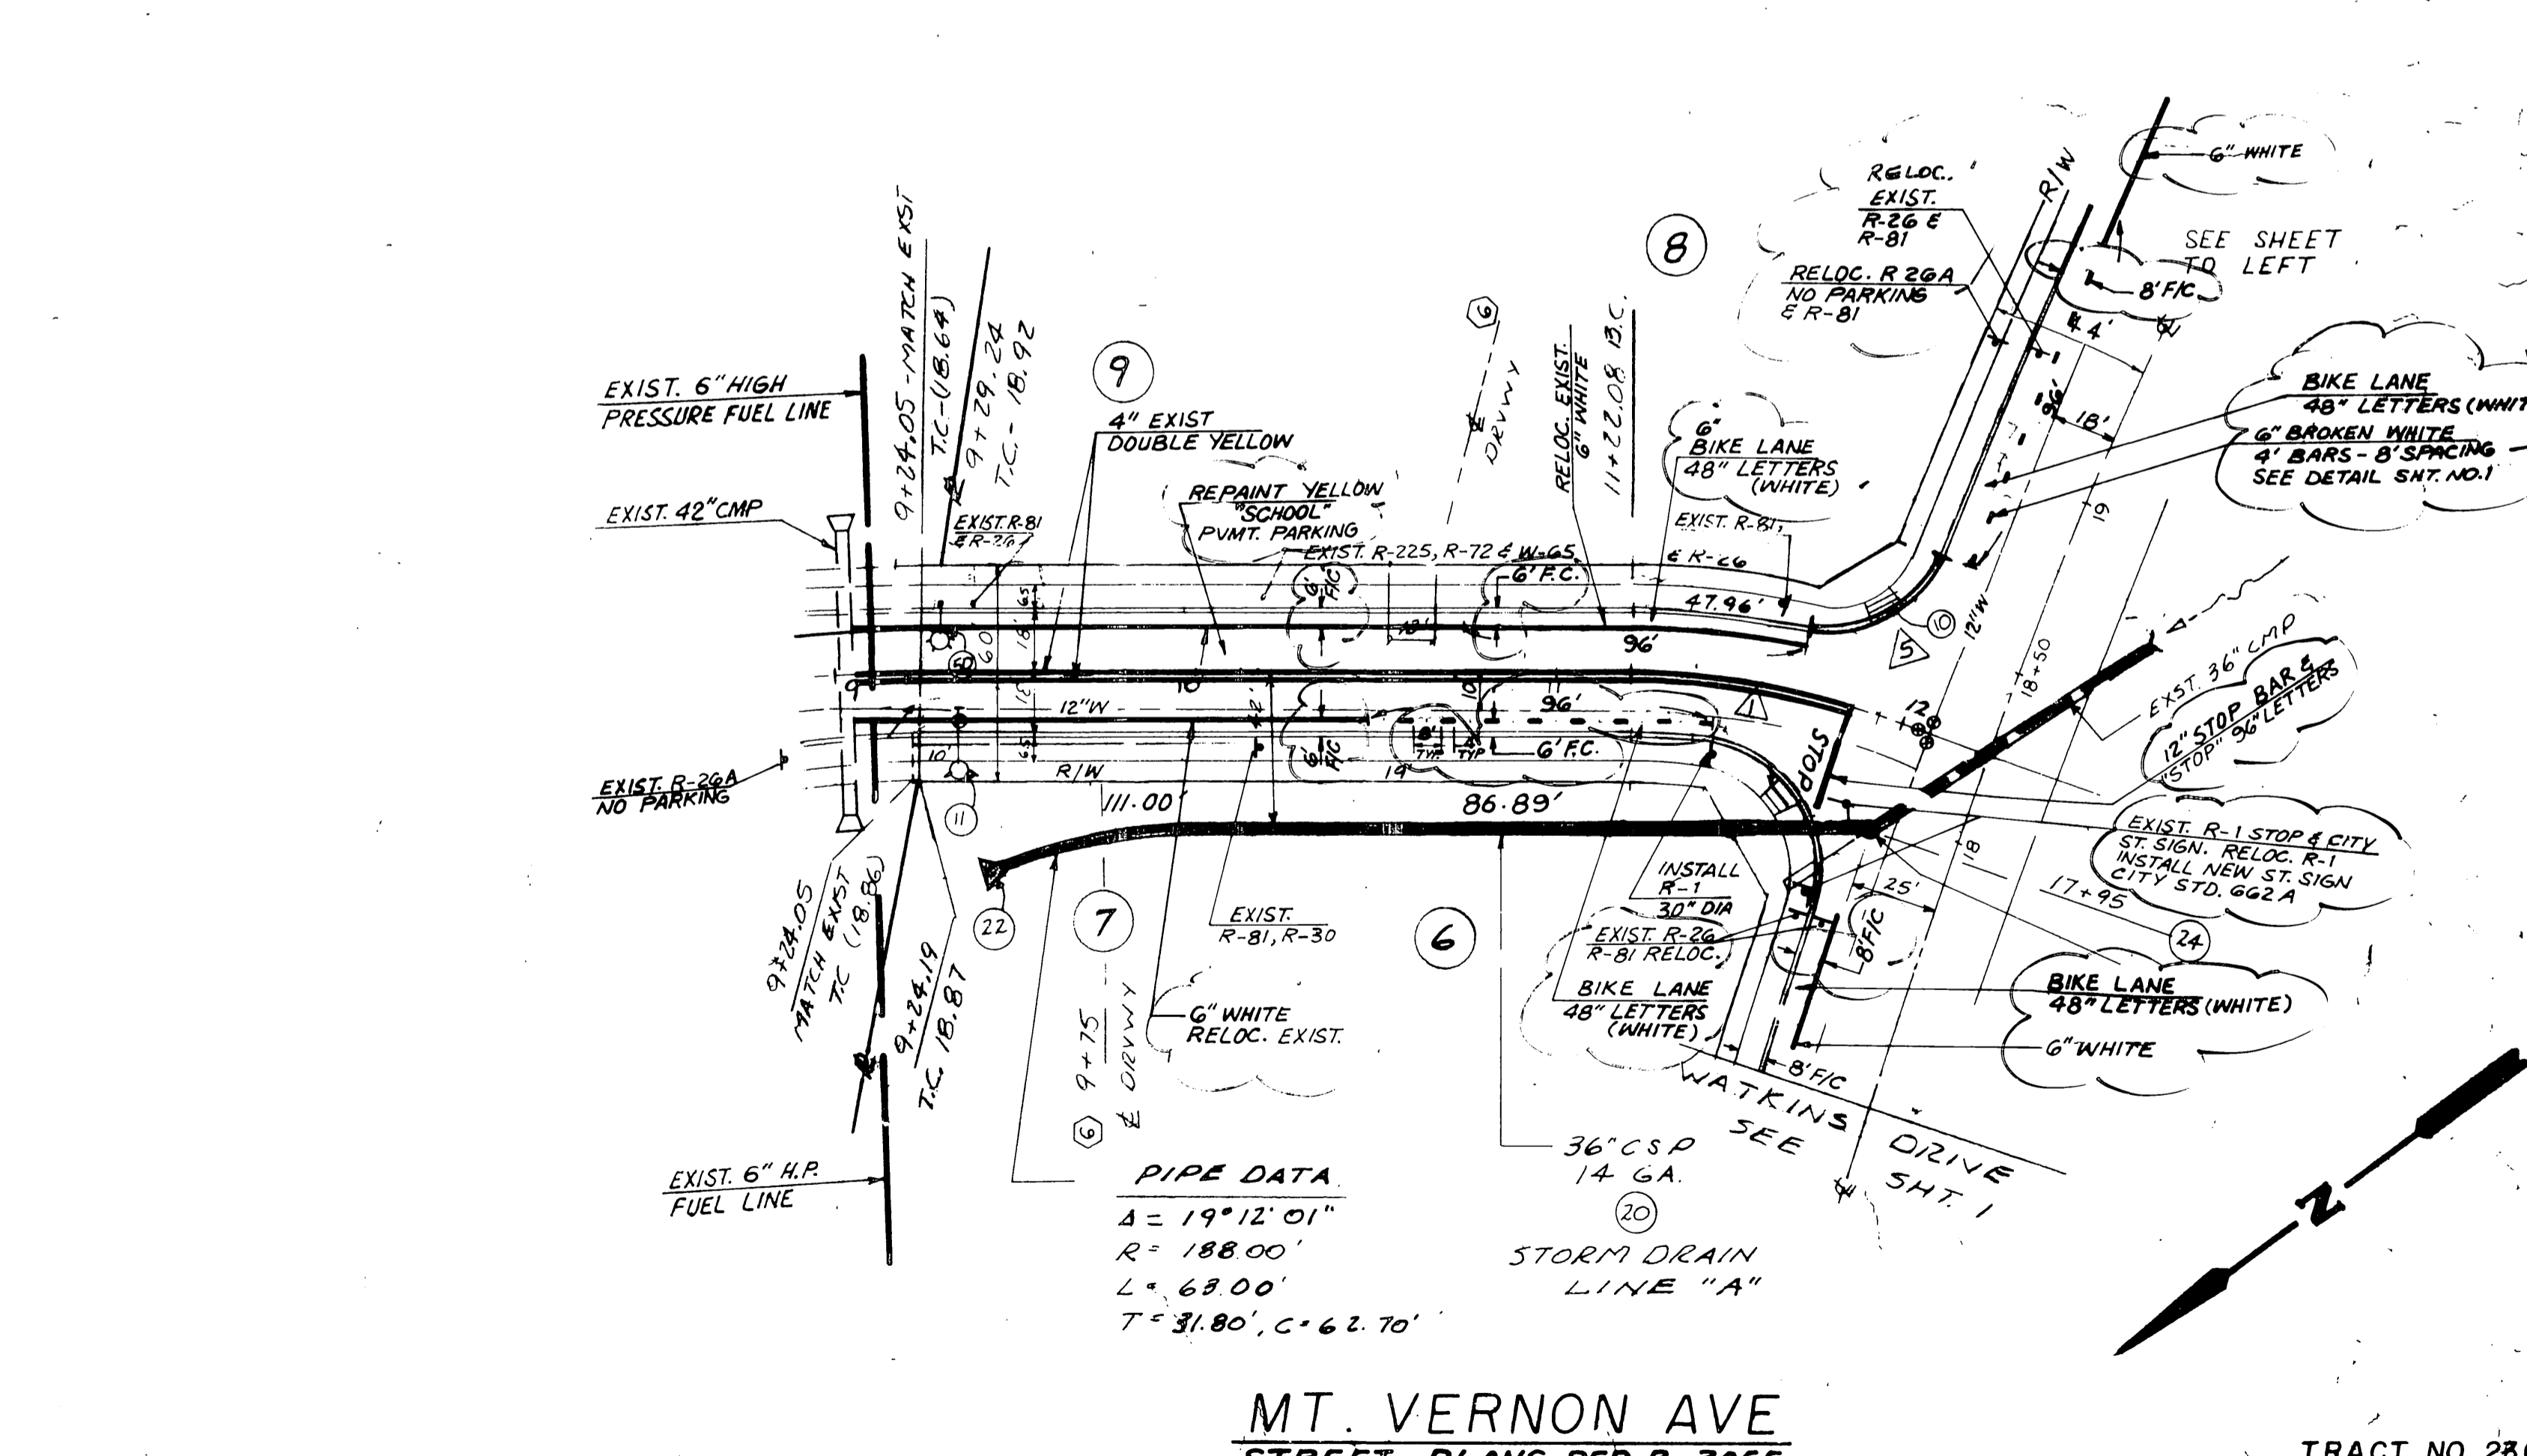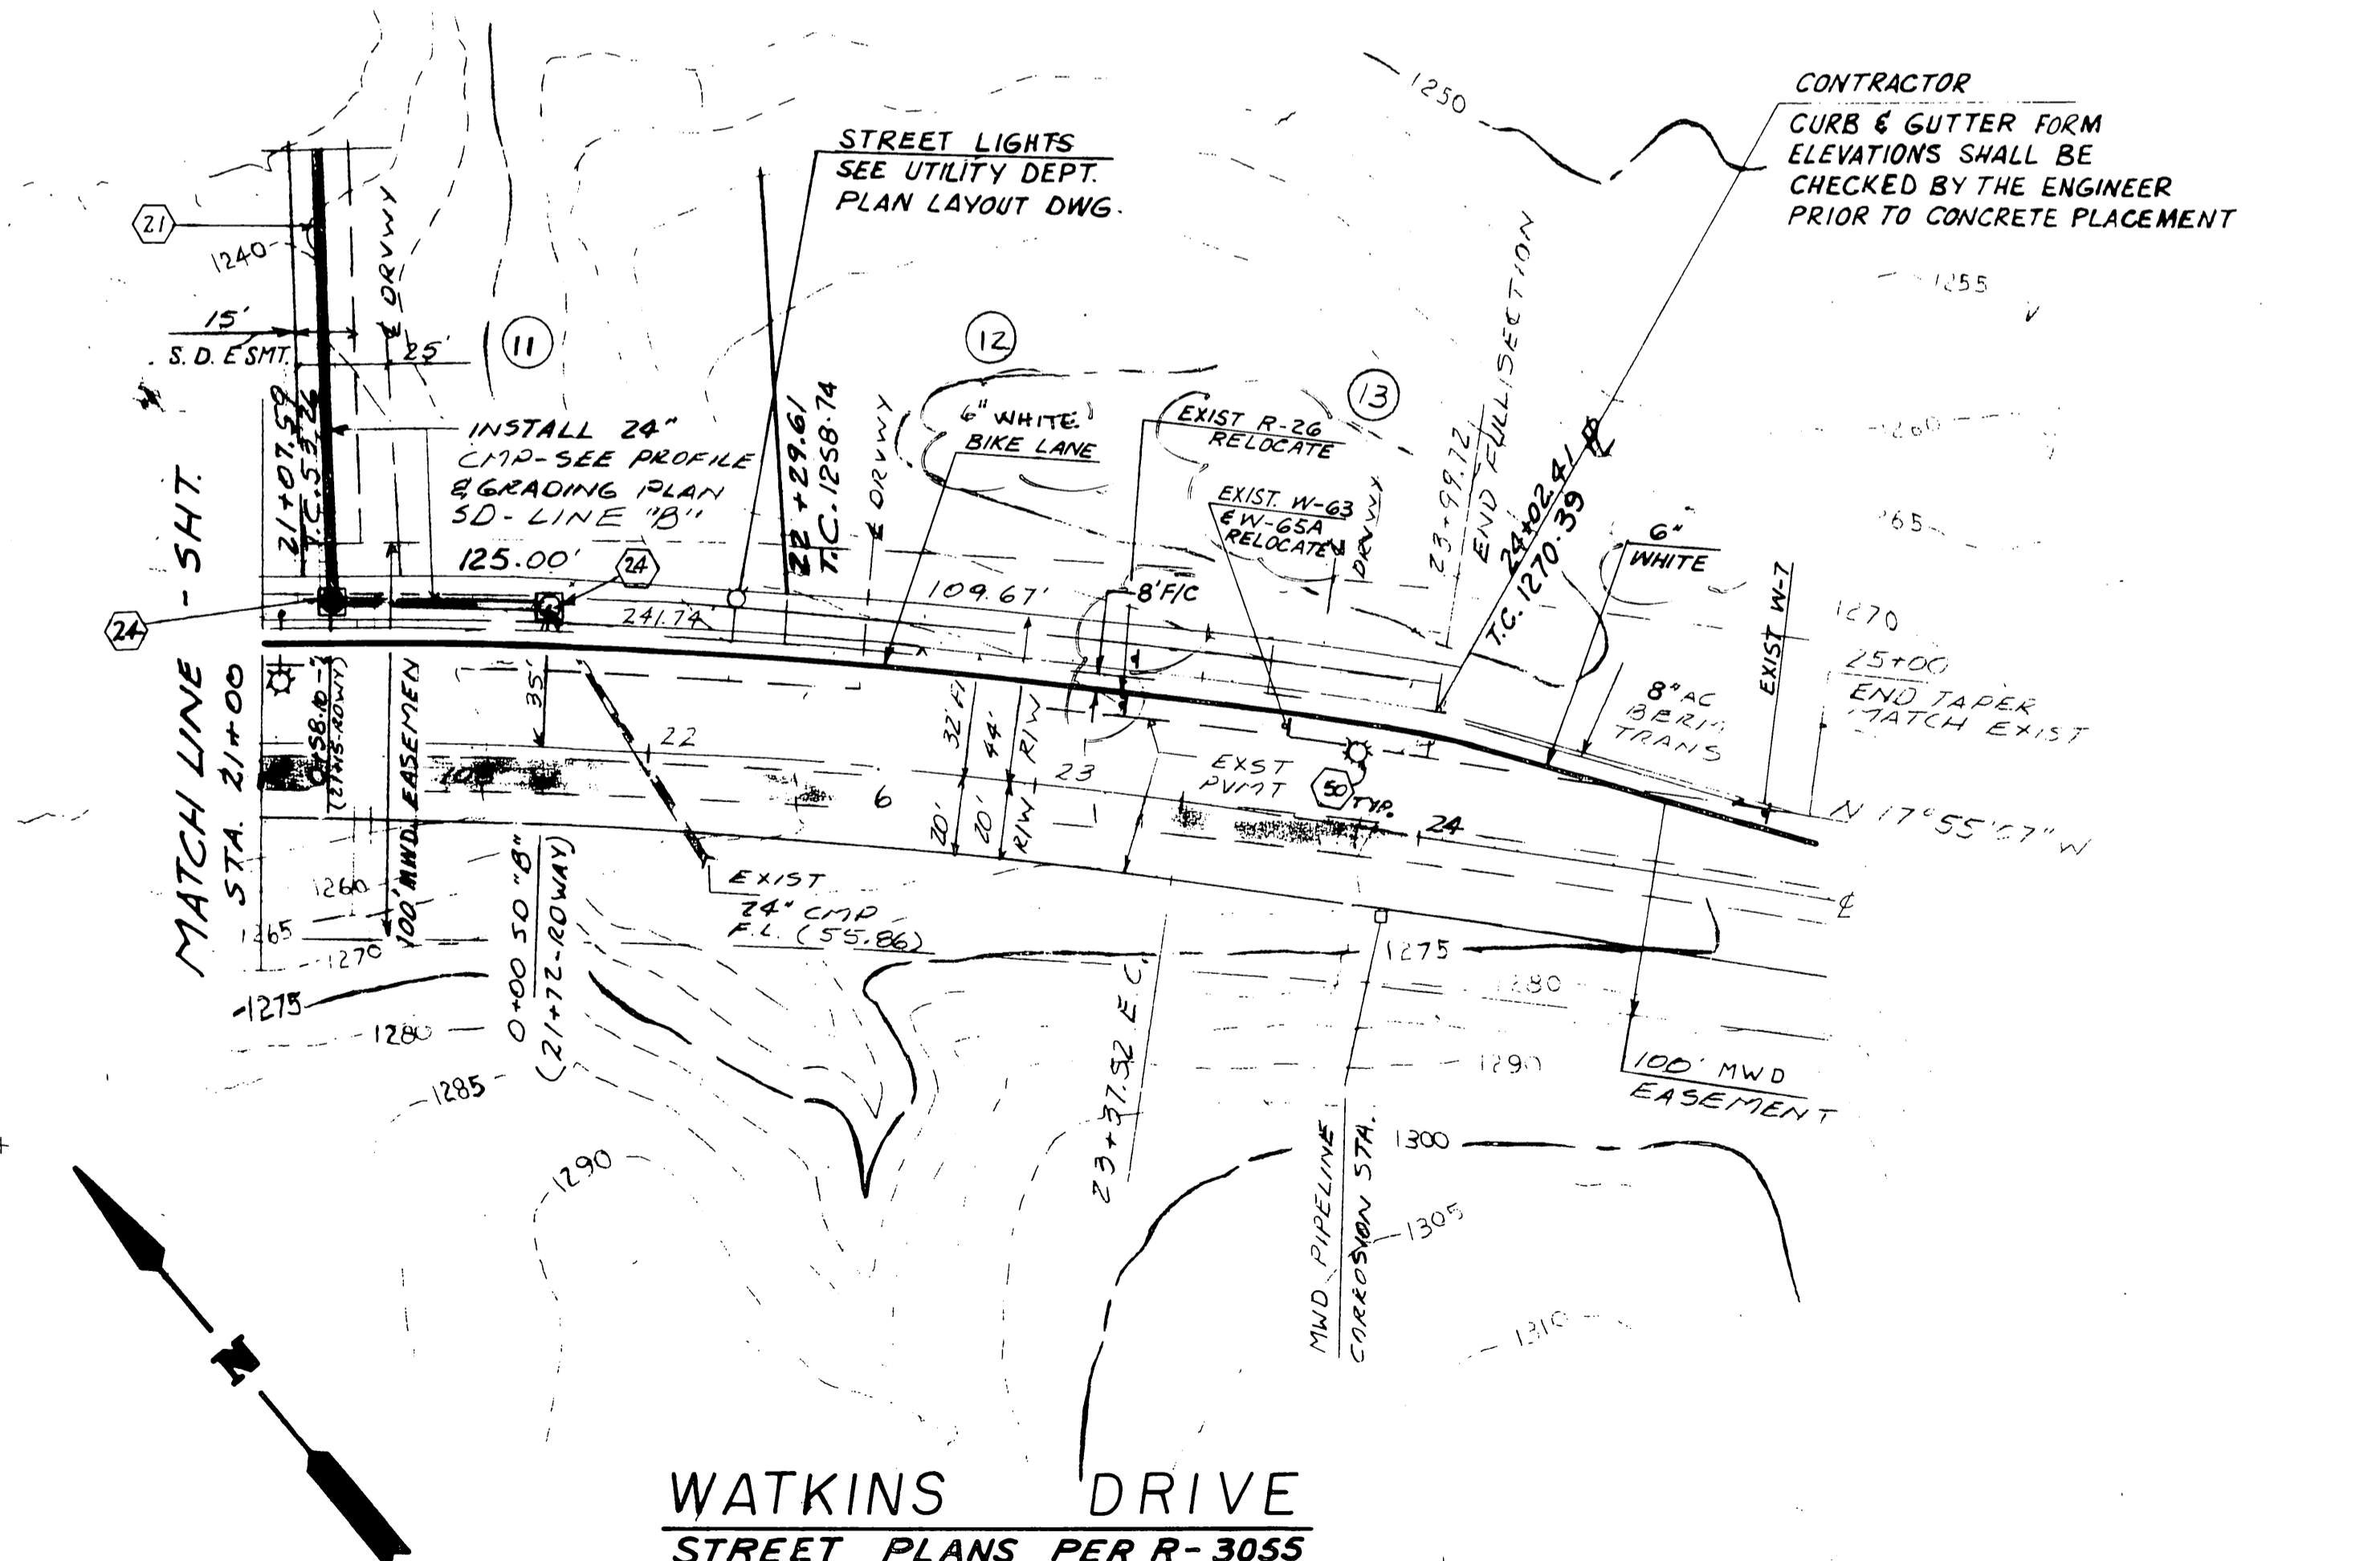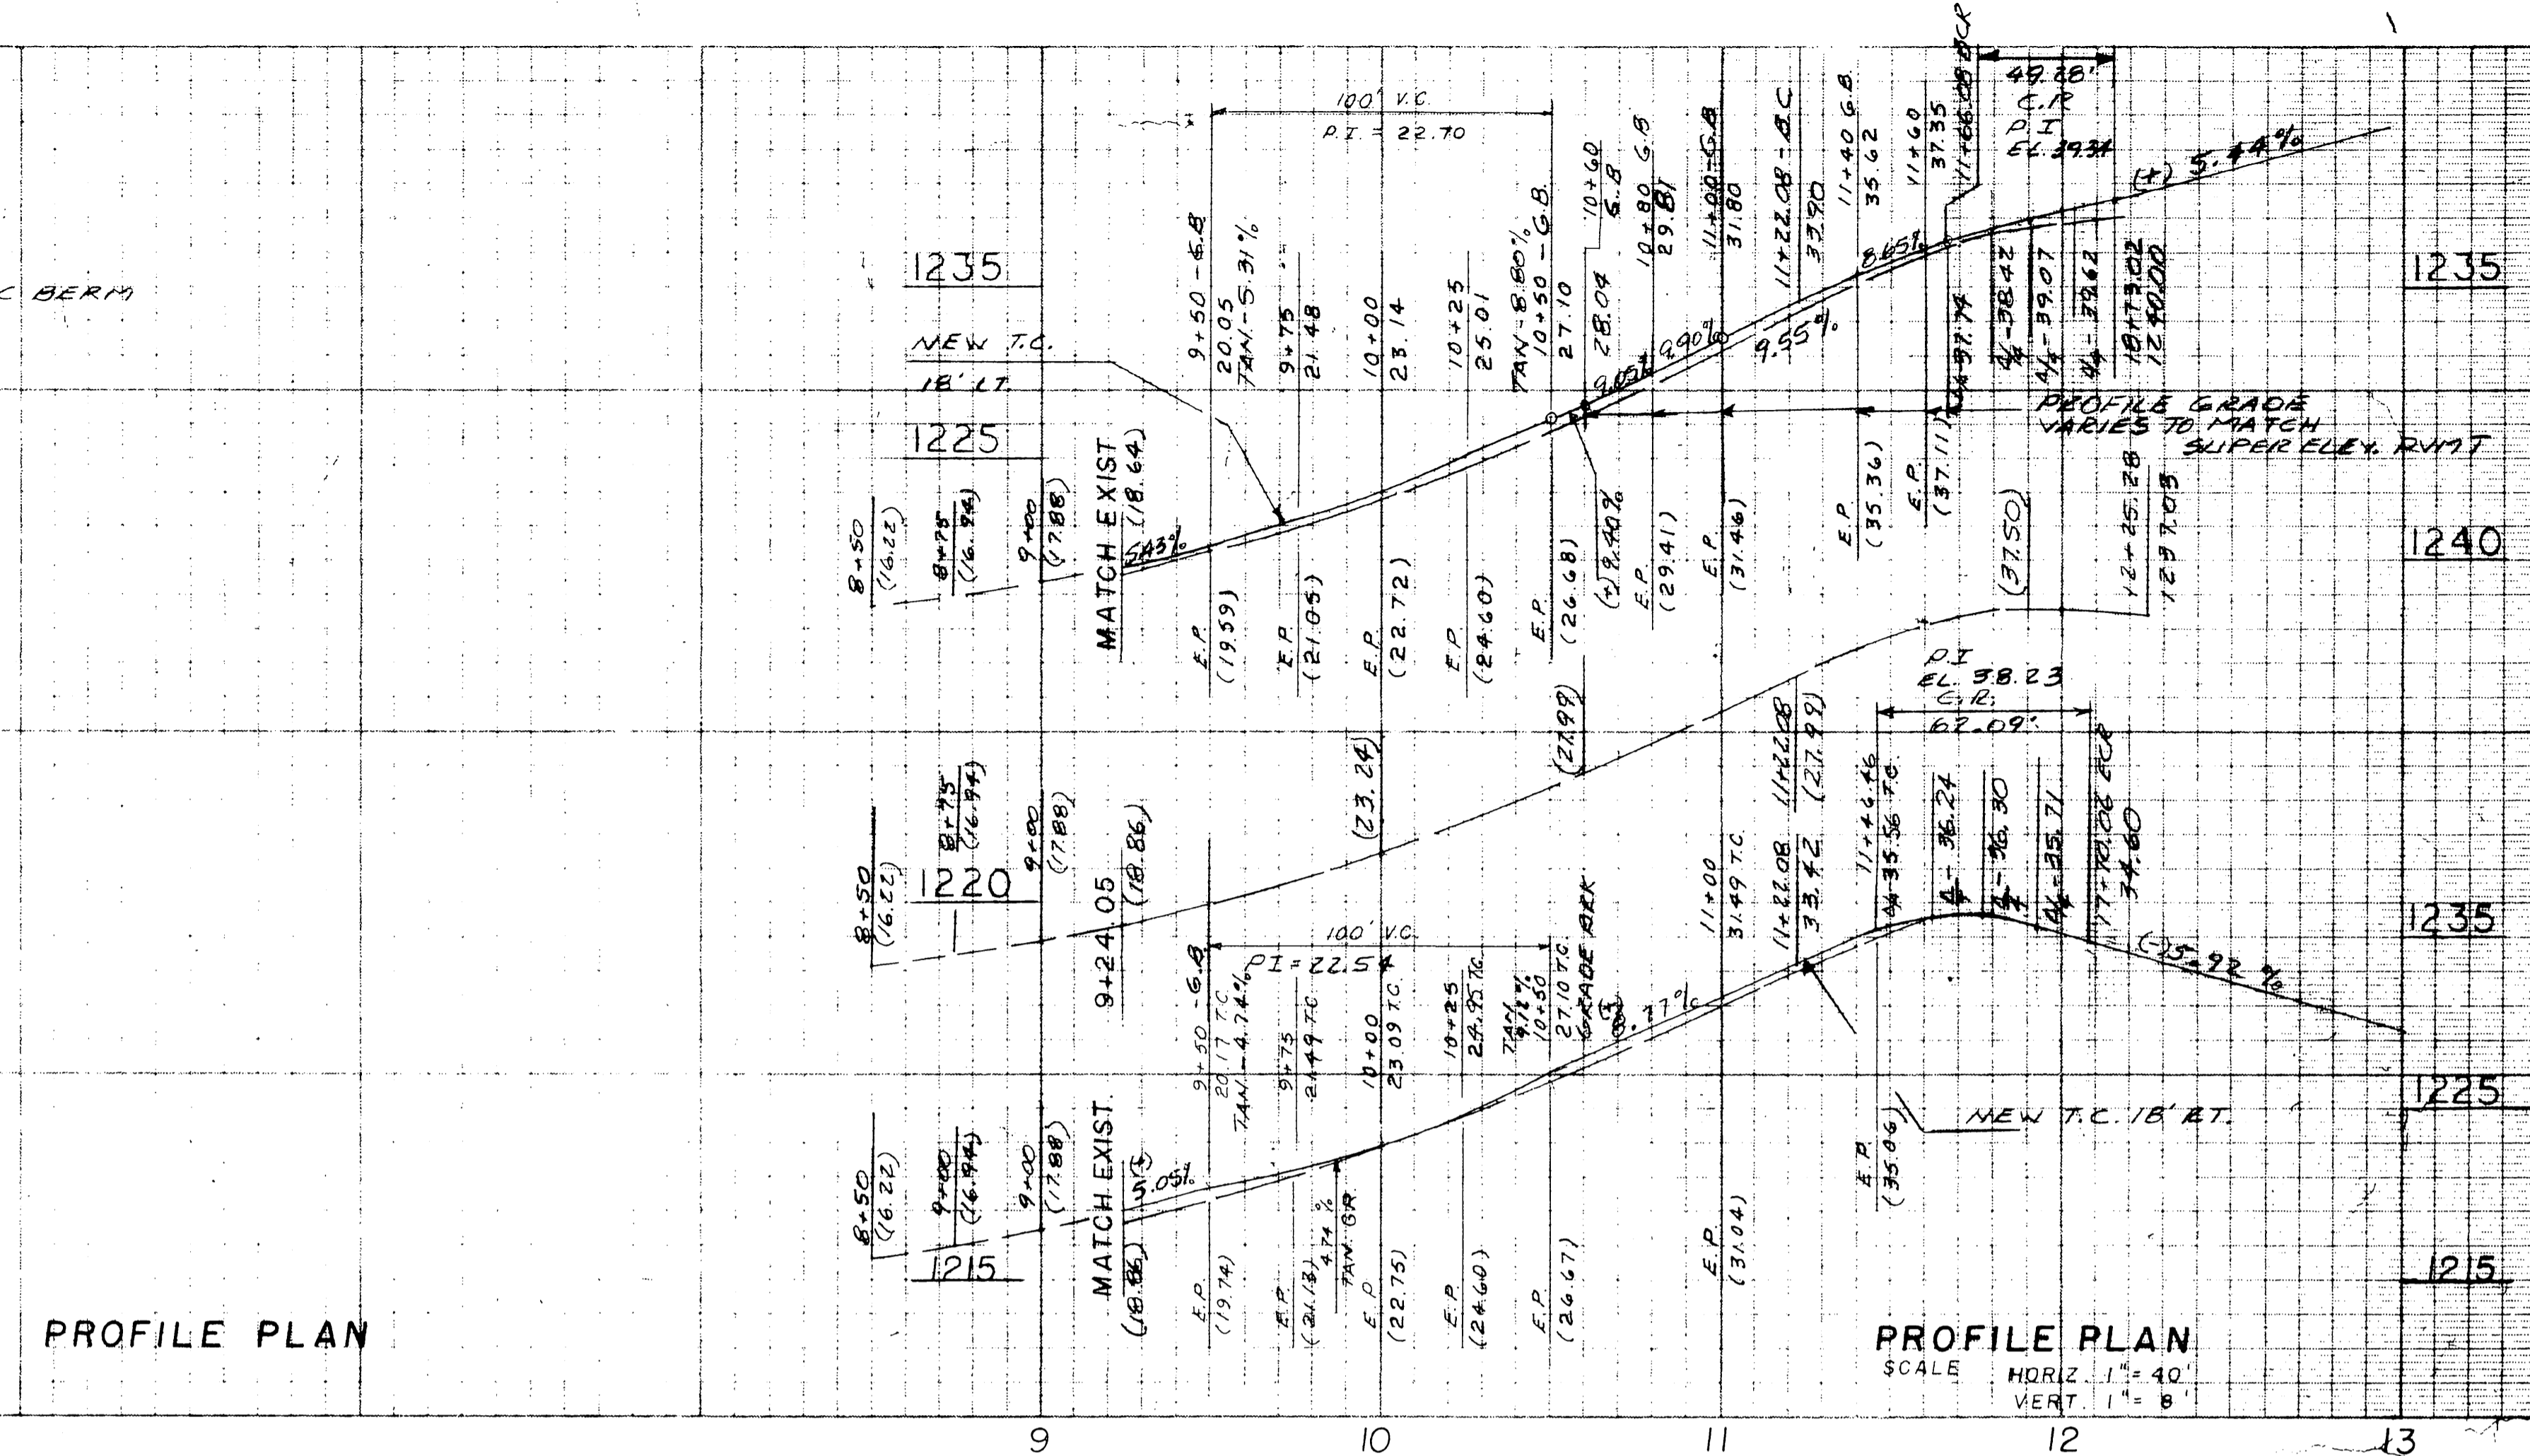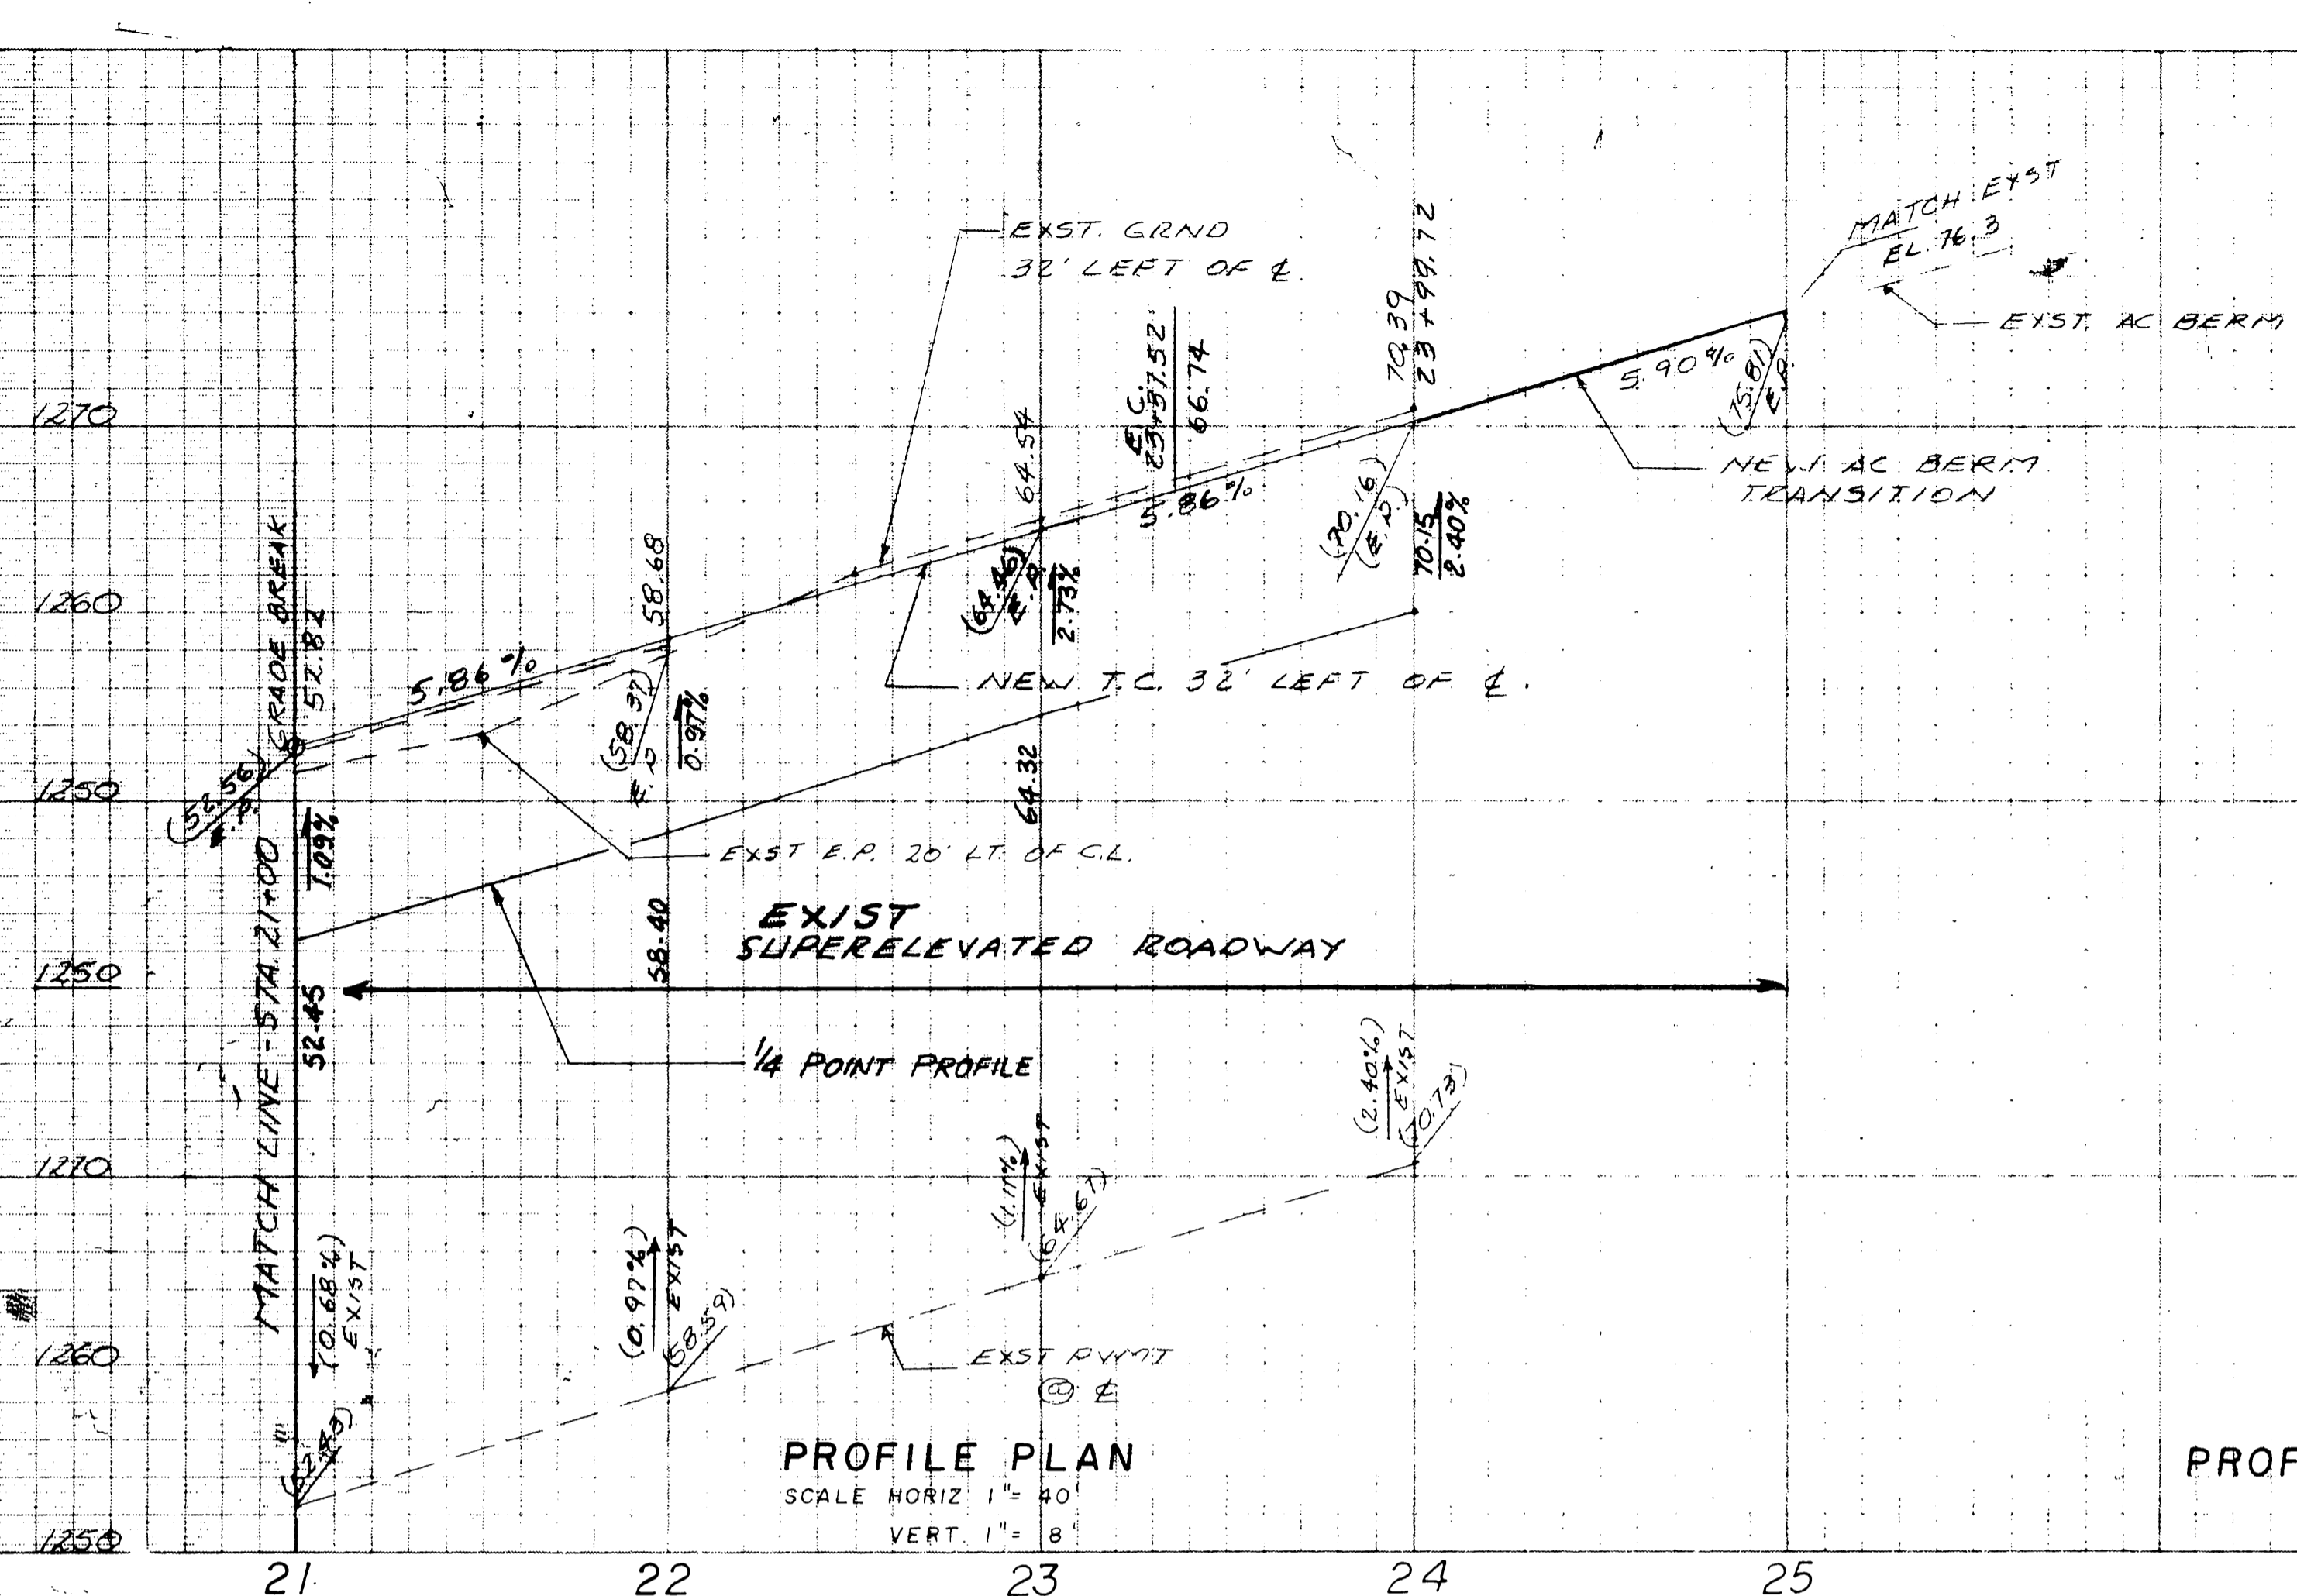

Chassem Farah

**ACREAGE LAND SYSTEMS Inc.**  
102 E. GRAND BLVD.  
CORONA, CA 91719  
(714) 734-0152

Δ	DELTA	R	L	T
1	20° 23' 03"	200	71.15	35.96
2	12° 36' 20"	218	47.96	24.08
3	6° 59' 13"	182	22.19	11.11
4	10° 38' 51"	35	62.09	42.95
5	8° 39' 58"	35	49.28	29.72
6	7° 33' 38"	1800	287.52	118.93
7	7° 33' 38"	1832	241.74	121.04

MARK	REVISIONS	APPR.	DATE

CITY OF RIVERSIDE, CALIFORNIA  
PUBLIC WORKS DEPARTMENT

APPROVED BY: [Signature]  
PRINCIPAL ENGINEER: [Signature]  
DATE: 1/17/88

APPROVED BY: [Signature]  
DIRECTOR OF PUBLIC WORKS: [Signature]  
DATE: 1/26/88

**STREET STRIPING PLANS**  
OF  
**WATKINS DR. & MT. VERNON**

SCALE: HORIZ 1" = 40' VERT SCALE 1" = 8'

TRACT NO 28061

ACCOUNT NO. [Blank]  
DRAWING NUMBER  
**XL-232**  
SHEET **2** OF **2**