


LINCOLN



Paint new  
Highvisibility X-walk  
(old X-walk has been  
removed)

MARY

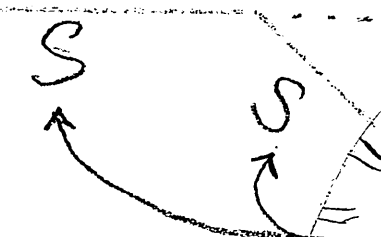

Add limit line  
& STOP message  
(limit line to be  
an extension of  
the curb)

Lincoln - Mary  
Pavement Marking Revisions  
due to widening  
scale: 1" = 20' by Jap

XL-26