


ALESSANDRO BL

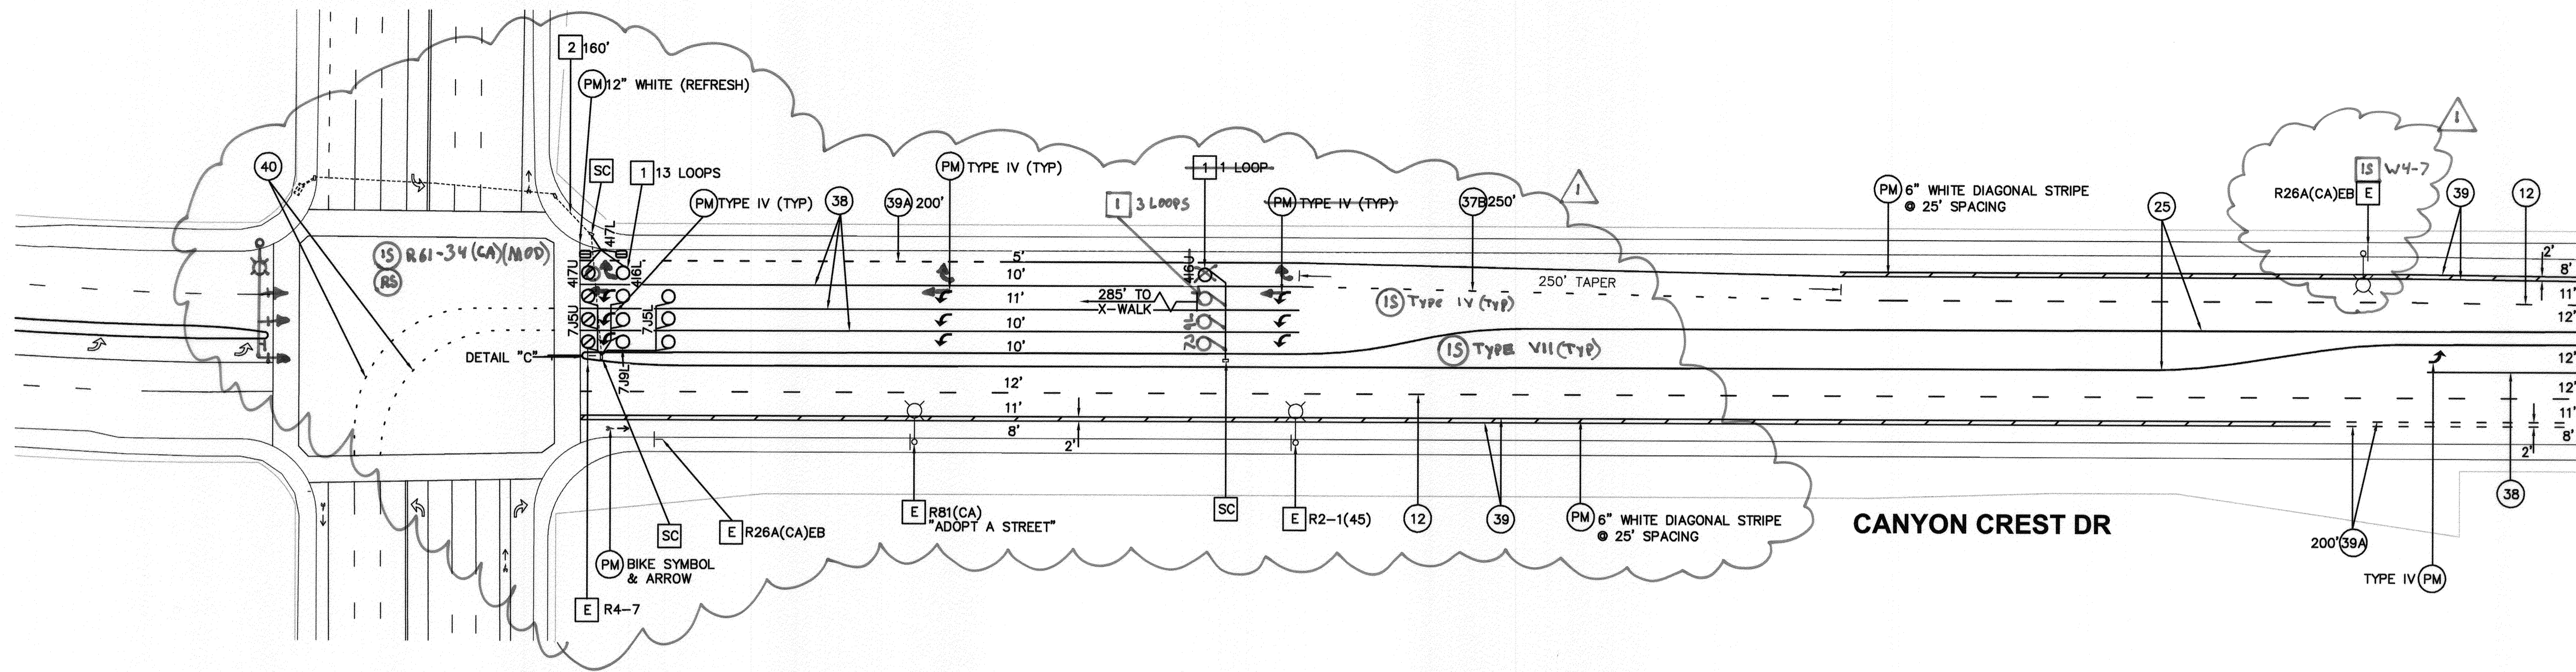




MATCHLINE SEE SHEET No. 2

SIGNING AND STRIPING GENERAL NOTES:


- SIGNING AND STRIPING INSTALLATIONS SHALL CONFORM TO THE 2012 CALIFORNIA MANUAL ON UNIFORM TRAFFIC CONTROL DEVICES (CA MUTCD), THE STATE OF CALIFORNIA DEPARTMENT OF TRANSPORTATION (CALTRANS) STANDARD PLANS AND SPECIFICATIONS DATED 2010, AND ALL ADDENDUMS THERETO, AND THE CITY OF RIVERSIDE PUBLIC WORKS DEPARTMENT STANDARD DRAWINGS, CURRENT EDITION.
- ALL STRIPING, MARKINGS, AND LEGENDS SHALL BE REFLECTORIZED THERMOPLASTIC UNLESS OTHERWISE NOTED. THE CONTRACTOR SHALL PROVIDE AND INSTALL RAISED PAVEMENT MARKERS FOR ALL STRIPING. STRIPING, MARKINGS AND LEGENDS SHALL CONFORM TO THE LATEST CALTRANS STANDARD PLANS A20A THRU A20D AND A24A THRU A24E.
- PRIOR TO FINAL ACCEPTANCE OF STREET IMPROVEMENTS, ALL PAVEMENT STRIPING AND STENCILING WITHIN THE PERIMETER OF THE CONSTRUCTION AREA SHALL BE RESTORED TO LIKE NEW CONDITION, IN A MANNER MEETING THE APPROVAL OF THE CITY OF RIVERSIDE.
- THE CONTRACTOR SHALL RE-STRIP EXISTING STRIPING AND CURB MARKINGS OBLITERATED BY NEW CONSTRUCTION, WHETHER OR NOT SHOWN ON THE PLANS FOR REPLACEMENT, AT NO COST TO THE CITY.
- AT LOCATIONS WHERE EXISTING PAINTED CURB IS TO BE RECONSTRUCTED, THE CONTRACTOR SHALL PAINT THE NEW CURB AS SHOWN ON THE PLANS WITHIN 10 WORKING DAYS OF CURB CONSTRUCTION OR AS DIRECTED BY ENGINEER. THE PAINT SHALL BE WATER-BASED WITH 2-YEAR GUARANTEE AGAINST COLOR FADING. PRIOR TO THE START OF CONSTRUCTION, THE CONTRACTOR SHALL SUBMIT TO THE CITY WRITTEN PROOF OF THE MANUFACTURER'S 2-YEAR GUARANTEE.
- ALL NEW STRIPING SHALL BE "CAT TRACKED" AND APPROVED BY THE ENGINEER PRIOR TO FINAL INSTALLATION. THE CONTRACTOR SHALL NOTIFY THE ENGINEER AFTER COMPLETING LAYOUT AND AT LEAST 3 WORKING DAYS BEFORE COMMENCING INSTALLATION OF STRIPING, MARKINGS AND MARKERS.
- TRAFFIC SIGN FACE SHALL BE 3M DIAMOND GRADE DG3 REFLECTIVE SHEETING (ASTM XI) OR APPROVED EQUAL WITH PROTECTIVE GRAFFITI OVERLAY FILM OR AS OTHERWISE NOTED. ALL WARNING SIGNS SHALL HAVE A FLUORESCENT YELLOW BACKGROUND AND SCHOOL SIGNS NOTED SHALL HAVE A FLUORESCENT YELLOW-GREEN BACKGROUND.
- SIGNS SHALL BE STANDARD SIZE UNLESS NOTED OTHERWISE. PRIOR TO INSTALLATION, NEW SIGNS SHALL BE APPROVED BY THE CITY OF RIVERSIDE. EXACT LOCATIONS OF SIGNS SHALL BE DETERMINED BY THE CITY ENGINEER.
- ALL EXISTING SIGNS AND POSTS TO BE REMOVED SHALL BE DELIVERED TO THE CITY OF RIVERSIDE SIGN DEPARTMENT.
- WHEN PAINT IS SPECIFIED, TRAFFIC STRIPES AND MARKINGS SHALL BE APPLIED IN TWO COATS. A MINIMUM OF SEVEN DAYS SHALL BE PROVIDED BETWEEN FIRST AND SECOND COATS.
- STRIPING SHALL BE APPLIED WITHIN 48 HOURS OF SURFACE COURSE REPLACEMENT ON STREETS OPEN TO THE PUBLIC. IN NO CASE SHALL A NEWLY PAVED STREET OPEN TO THE PUBLIC BE LEFT UNSTRIPED OVER A WEEKEND OR HOLIDAY.
- CONTRACTOR SHALL INSTALL NEW SIGN(S) AND/OR POST(S) PER CITY OF RIVERSIDE STANDARD DRAWING No. 664, SEE SPECIFICATIONS.
- CONTRACTOR SHALL INSTALL NEW STREET NAME SIGNS AND POST PER CITY OF RIVERSIDE STANDARD DRAWING No. 662, SEE SPECIFICATIONS.
- ALL CONFLICTING STRIPING, PAVEMENT MARKINGS, LEGENDS, AND RAISED PAVEMENT MARKERS SHALL BE REMOVED EVEN IF NOT SHOWN ON PLANS. REMOVALS OF PAINTED STRIPING, PAVEMENT MARKINGS AND LEGENDS SHALL BE DONE BY WET SANDBLASTING. REMOVALS OF THERMOPLASTIC STRIPING, PAVEMENT MARKINGS AND LEGENDS SHALL BE REMOVED BY WET SANDBLASTING, GRINDING OR OTHER APPROVED METHOD AND SHALL NOT DAMAGE THE PAVEMENT. "BLACK OUT" OF EXISTING DELINEATION IS NOT PERMITTED. ALL DAMAGED PAVEMENT DUE TO REMOVALS SHALL BE REPAIRED AS NECESSARY TO MAINTAIN A SMOOTH AND UNIFORM SURFACE OR AS DIRECTED BY THE ENGINEER. ALL STRIPING REMOVALS AND LEGENDS SHALL BE "FOG SEALED".
- WHERE APPLICABLE, OUTBOUND LANE LINE DETAILS SHALL COMMENCE AT THE CROSSWALK, MEANING THE PAINTED PORTION OF THE DETAIL SHALL JOIN THE CROSSWALK.

SIGNING AND STRIPING LEGEND AND CONSTRUCTION NOTES:

- E EXISTING TO REMAIN.
- IS FURNISH AND INSTALL ROADSIDE SIGN(S) OR SNS WITH/WTHOUT POST
- RS REMOVE SIGN(S)
- RL RELOCATE EXISTING SIGN(S) TO EXISTING POST OR INSTALL POST (IF APPLICABLE)
- SC SPLICE TO EXISTING
- 1 INTSTALL "TYPE E" DETECTOR LOOPS UNLESS OTHERWISE NOTED.
- 2 CONTRACTOR SHALL INSTALL (2) DLC(S) FROM THE ADJACENT PULL BOX TO THE CONTROLLER CABINET FOR DETECTOR CHANNEL (417U, 417L). THE CONTRACTOR SHALL INSTALL AN ADDITIONAL DETECTOR CARD FOR THE PROPOSED OPERATION.
- # INSTALL CALTRANS STRIPING DETAIL PER NUMBER NOTED, INCLUDING INSTALLATION OF RAISED PAVEMENT MARKERS.
- PM INSTALL PAVEMENT MARKING OR ARROW AS NOTED.
- RP REMOVE ALL EXISTING CONFLICTING TRAFFIC STRIPING AND MARKINGS AS NOTED, INCLUDING RAISED PAVEMENT MARKERS.
- S EXISTING SIGNALIZED INTERSECTION
- + PROPOSED SIGN (ONE POST)
- + EXISTING SIGN (ONE POST)
- PROPOSED SIGN (ON STREET LIGHT)
- EXISTING SIGN (ON STREET LIGHT)
- A PROPOSED STREET NAME SIGN
- A EXISTING STREET NAME SIGN
- SNS STREET NAME SIGN
- (12') EXISTING WIDTH
- 12' PROPOSED WIDTH
- △ ANGLE POINT

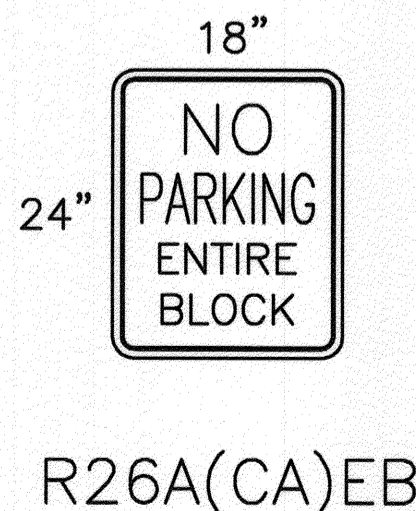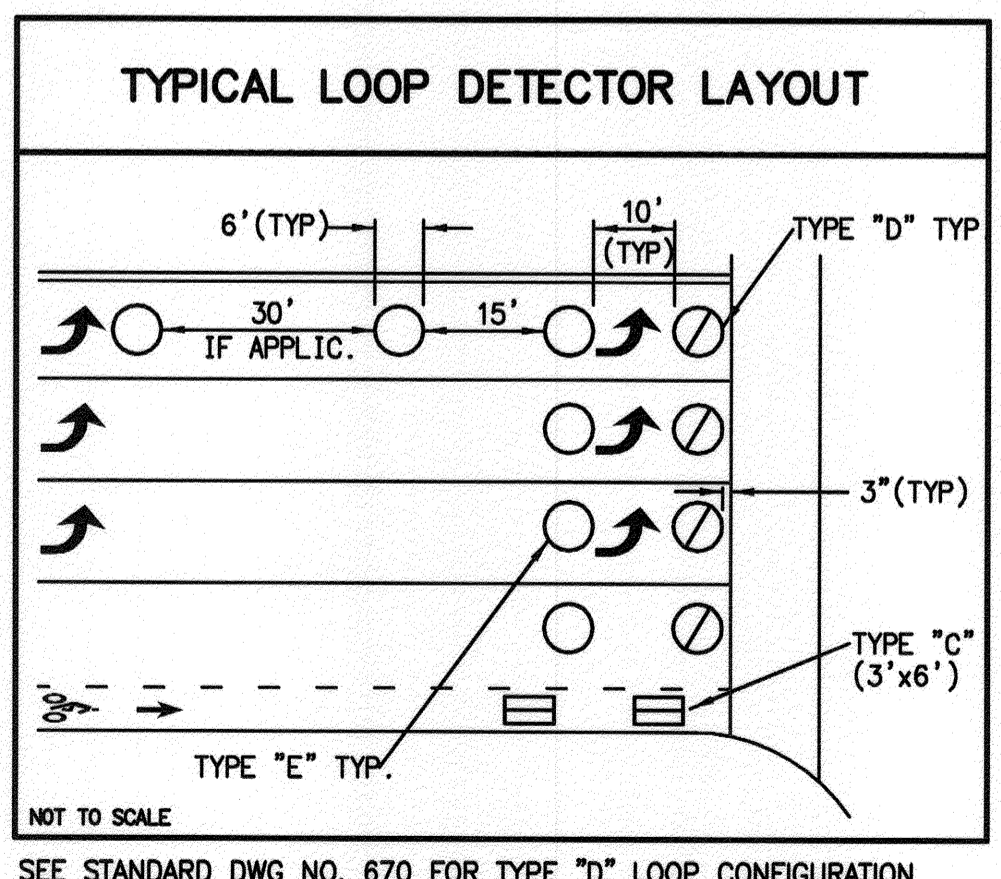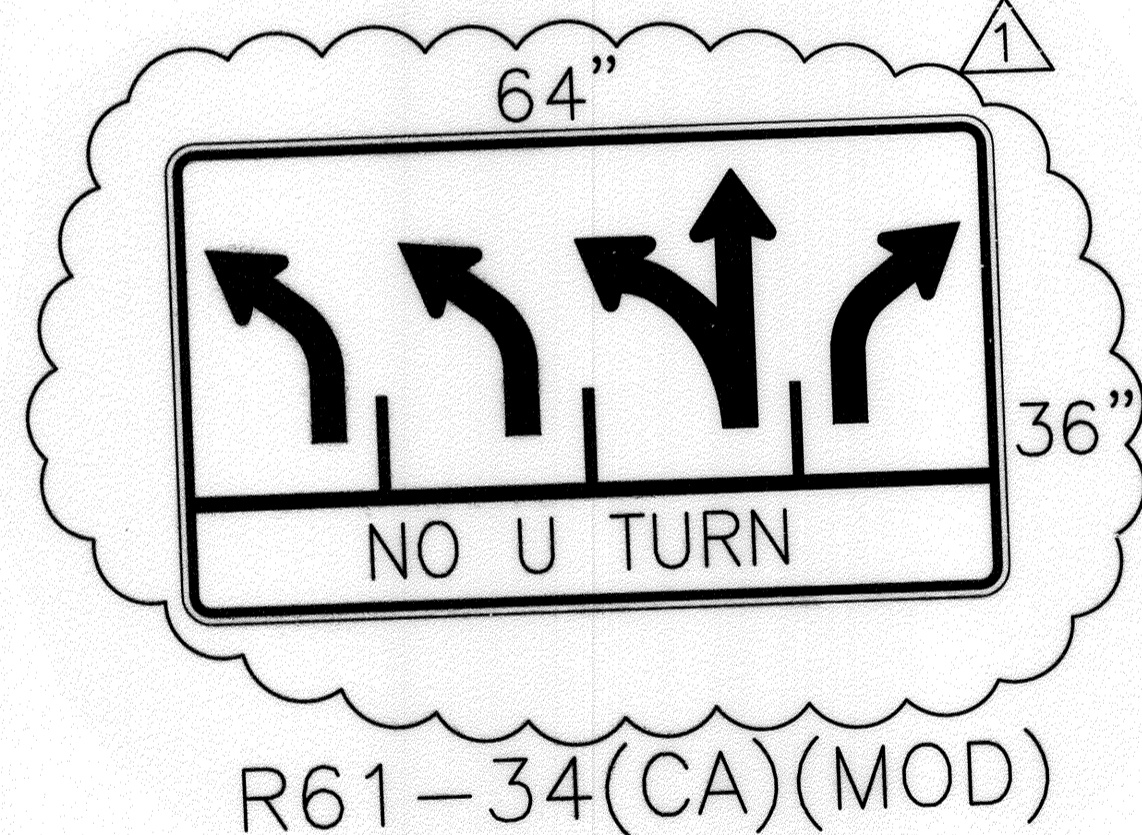

| STRIPING/SIGNAGE QUANTITIES | | | | | | |
|-----------------------------|-------------------------------|--------|--------|--------|----------|------|
| ITEM | DESCRIPTION | SHT. 1 | SHT. 2 | SHT. 3 | QUANTITY | UNIT |
| 1 | DETAIL 2 | - | - | 100 | 100 | LF |
| 2 | DETAIL 9 | - | - | 115 | 115 | LF |
| 3 | DETAIL 12 | 1255 | 3465 | 510 | 5230 | LF |
| 4 | DETAIL 22 | - | - | 55 | 55 | LF |
| 5 | DETAIL 25 | 1,865 | 3820 | 1345 | 7030 | LF |
| 6 | DETAIL 37B | 250 | - | - | 250 | LF |
| 7 | DETAIL 38 | 1,080 | 730 | 195 | 2005 | LF |
| 8 | DETAIL 39 | 2,735 | 6,370 | 2375 | 11480 | LF |
| 9 | DETAIL 39A | 600 | 1,200 | - | 1800 | LF |
| 10 | DETAIL 40 | 255 | - | - | 255 | LF |
| 12 | 4" SOLID YELLOW/WHITE | - | 250 | 50 | 300 | LF |
| 13 | 6" SOLID YELLOW/WHITE | 136 | 369 | 232 | 737 | LF |
| 14 | 12" SOLID YELLOW/WHITE | 95 | 380 | 330 | 805 | LF |
| 15 | DETAIL C - MEDIAN NOSE DETAIL | 1 | 6 | 1 | 8 | EA |
| 16 | PAVEMENT LEGENDS/MARKINGS | 164 | 205 | 128 | 497 | SF |
| 17 | TRAFFIC PAVEMENT REMOVALS | - | 44 | 52 | 96 | SF |
| 18 | TRAFFIC STRIPING REMOVALS | - | - | 330 | 330 | LF |
| 19 | ROADSIDE SIGN - ONE POST | - | - | 1 | 1 | EA |
| 20 | REMOVE SIGN | - | 11 | - | 11 | EA |
| 21 | STREET NAME SIGN | - | 4 | - | 4 | EA |
| 22 | TYPE "E" DETECTOR | 8 | - | - | 8 | EA |
| 23 | TYPE "D" DETECTOR | 4 | - | - | 4 | EA |
| 24 | TYPE "C" DETECTOR | 2 | - | - | 2 | EA |
| 25 | SC - SPLICE CONDUCTORS | 3 | - | - | 3 | EA |
| 26 | DLC - DETECTOR LOOP CABLE | 320 | 0 | 0 | 320 | LF |
| 27 | DETECTOR CHANNEL CARD | 1 | 0 | 0 | 1 | EA |

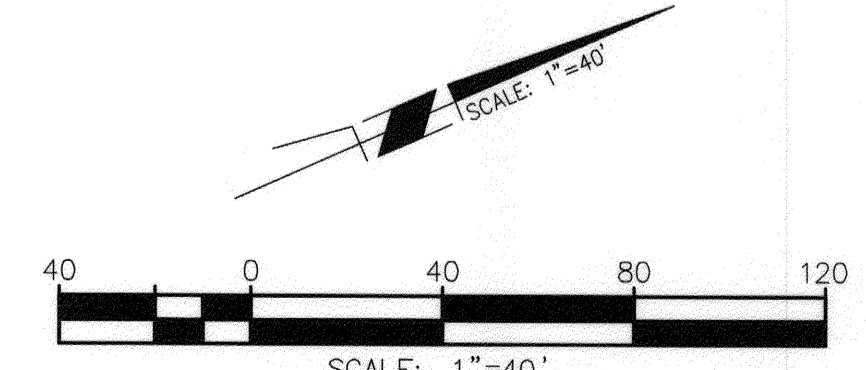

Under Ground Service Alert of Southern California
Call: TOLL FREE 1-800-227-2600
TWO WORKING DAYS BEFORE YOU DIG

ENGINEER IN RESPONSIBLE CHARGE
GILBERT M. HERNANDEZ
R.C.E. No. 69170 EXPIRES: 6-30-14
DATE: 8-13-14




REGISTERED PROFESSIONAL ENGINEER
No. 69170
Exp. 06-30-14
CIVIL
STATE OF CALIFORNIA

MARK: *Markings And Signs*
REVISIONS: *Added Advance Loops, Pavement*
DESIGNED BY: MS
DRAWN BY: AP
CHECKED BY: GMH


CITY OF RIVERSIDE, CALIFORNIA
DEPARTMENT OF PUBLIC WORKS
APPROVED BY: *EM* DATE: 8/15/14
PRINCIPAL ENGINEER
TRAFFIC DIVISION: *DC* DATE: 8/22/14
CONSTRUCTION ADMIN.
PUBLIC UTILITIES

SIGNING AND STRIPING PLAN
CANYON CREST DR
FROM ALESSANDRO
TO VIA VISTA
SCALE: 1" = 40'


XL-350
SHEET 1 OF 3
FILE NAME: XL-350.DWG

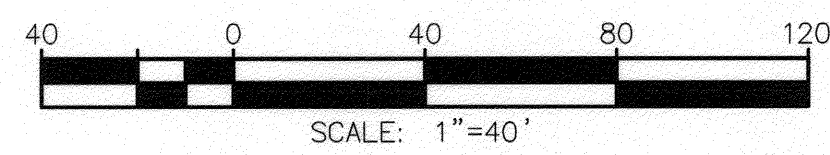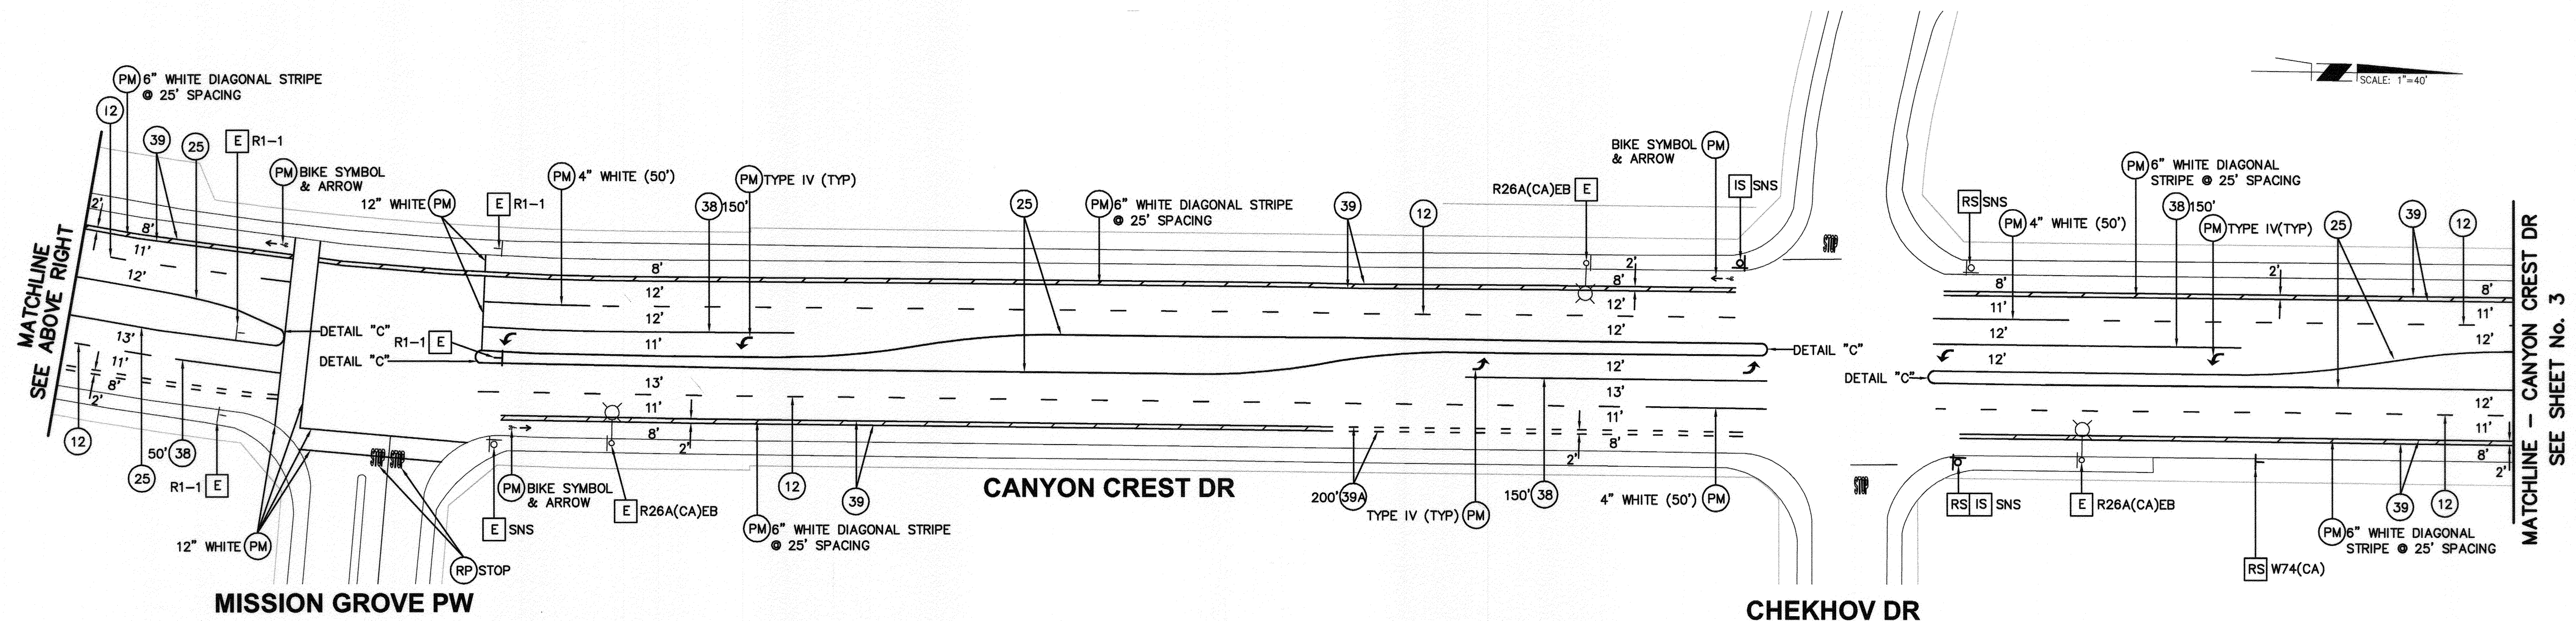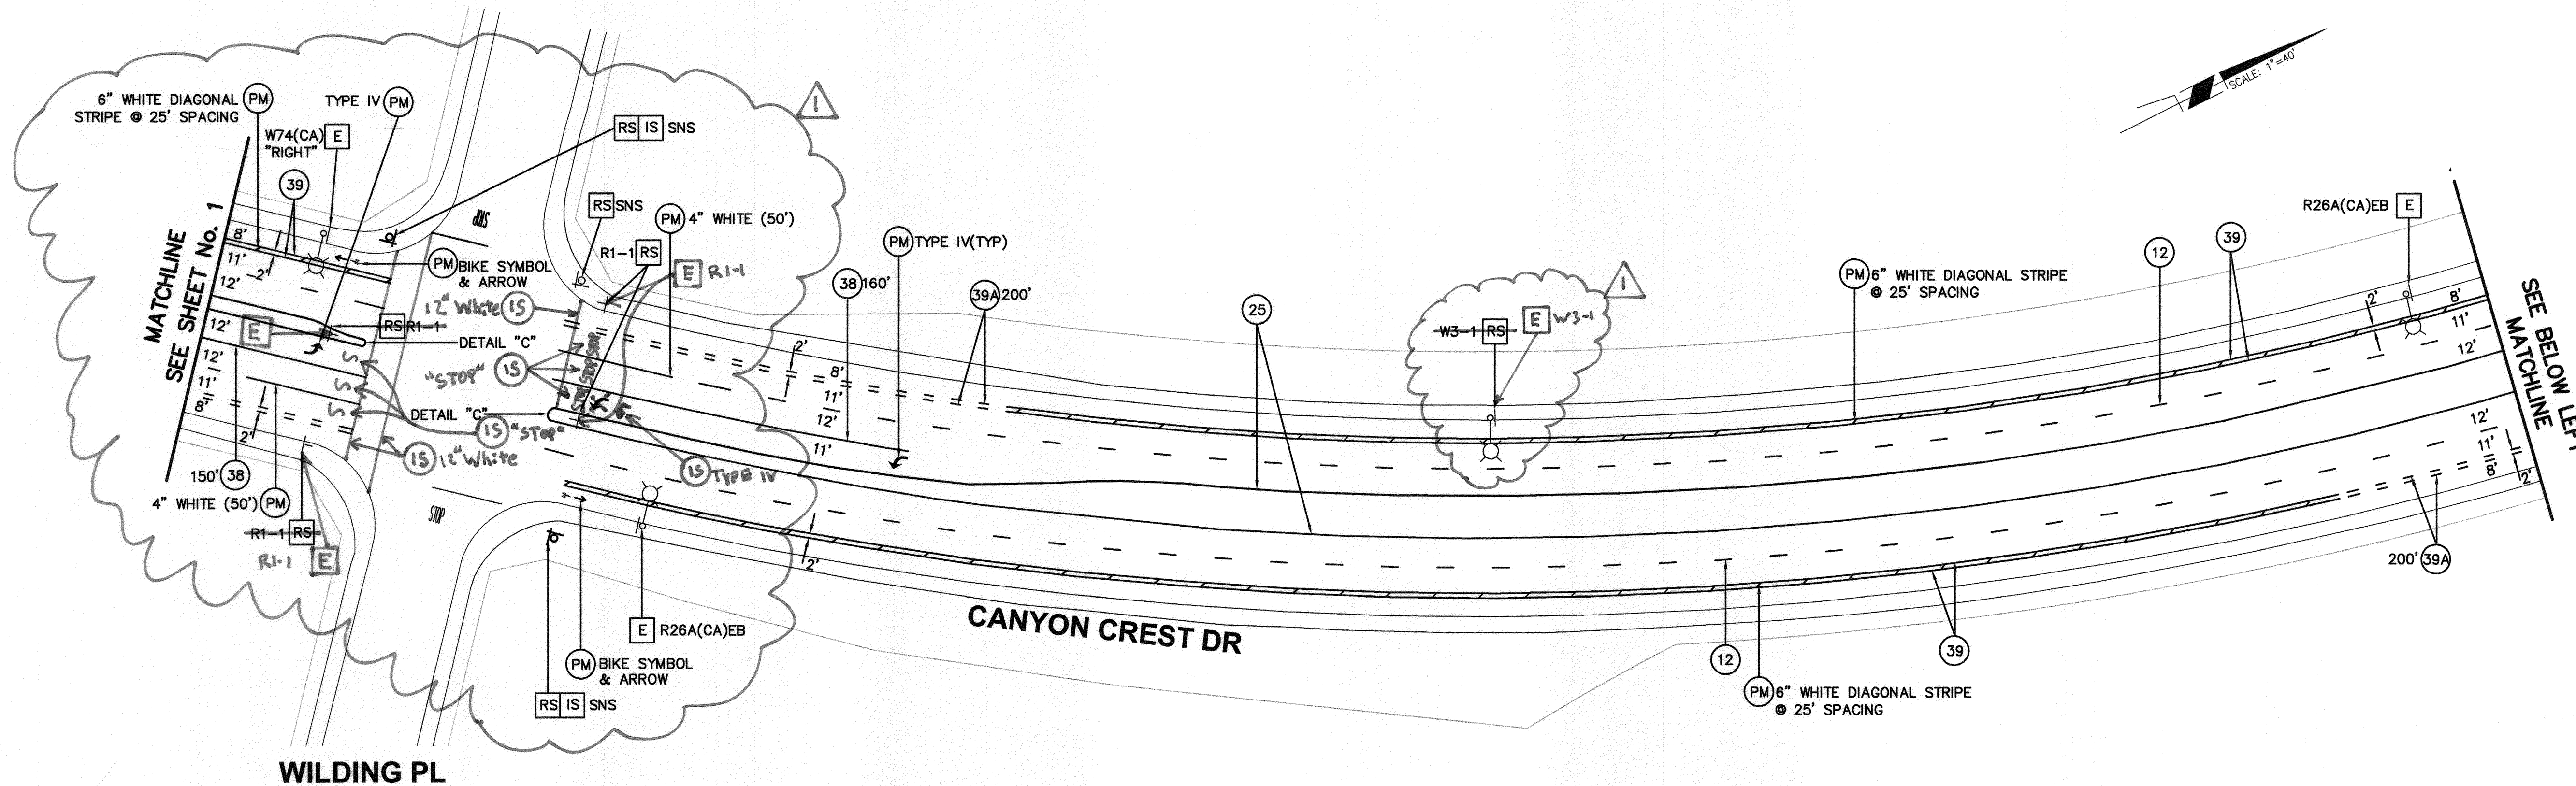

Under Ground Service Alert of Southern California
 Call: TOLL FREE 1-800-227-2600
 TWO WORKING DAYS BEFORE YOU DIG

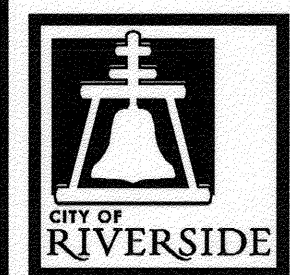

ENGINEER IN RESPONSIBLE CHARGE
 GILBERT M. HERNANDEZ
 R.C.E. No. 69170 EXPIRES: 6-30-14
 DATE: 8-13-14





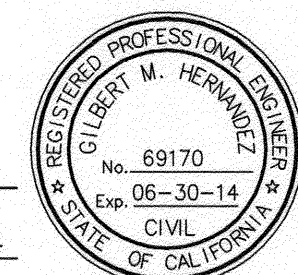


| MARK | REVISIONS | APPR. | DATE |
|----------------------------|-----------|-------|------|
| Stop legends at Wilding | | | |
| Installation of X-walk and | | | |

| CITY OF RIVERSIDE, CALIFORNIA DEPARTMENT OF PUBLIC WORKS | | | |
|---|----|---------|-----------------|
| APPROVED BY | BY | DATE | APPROVED BY |
| ENGINEERING MANAGER | Em | 8/15/14 | CITY ENGINEER |
| PRINCIPAL ENGINEER | | | |
| TRAFFIC DIVISION | | | |
| CONSTRUCTION ADMIN. | DC | 8/22/14 | DATE: 8/22/2014 |
| PUBLIC UTILITIES | | | |


SIGNING AND STRIPING PLAN
CANYON CREST DR
 FROM ALESSANDRO
 TO VIA VISTA
 SCALE: 1" = 40'

XL-350
 SHEET 2 OF 3
 FILE NAME: XL-350.DWG

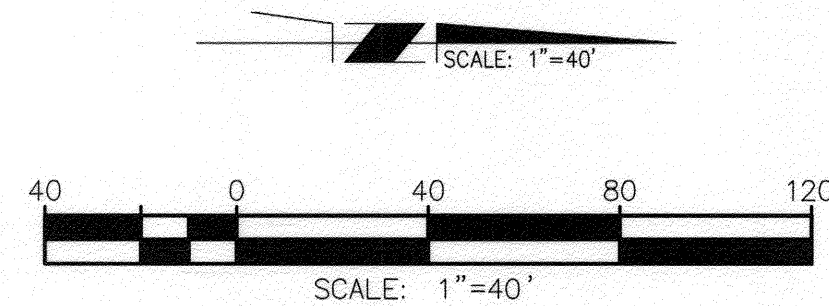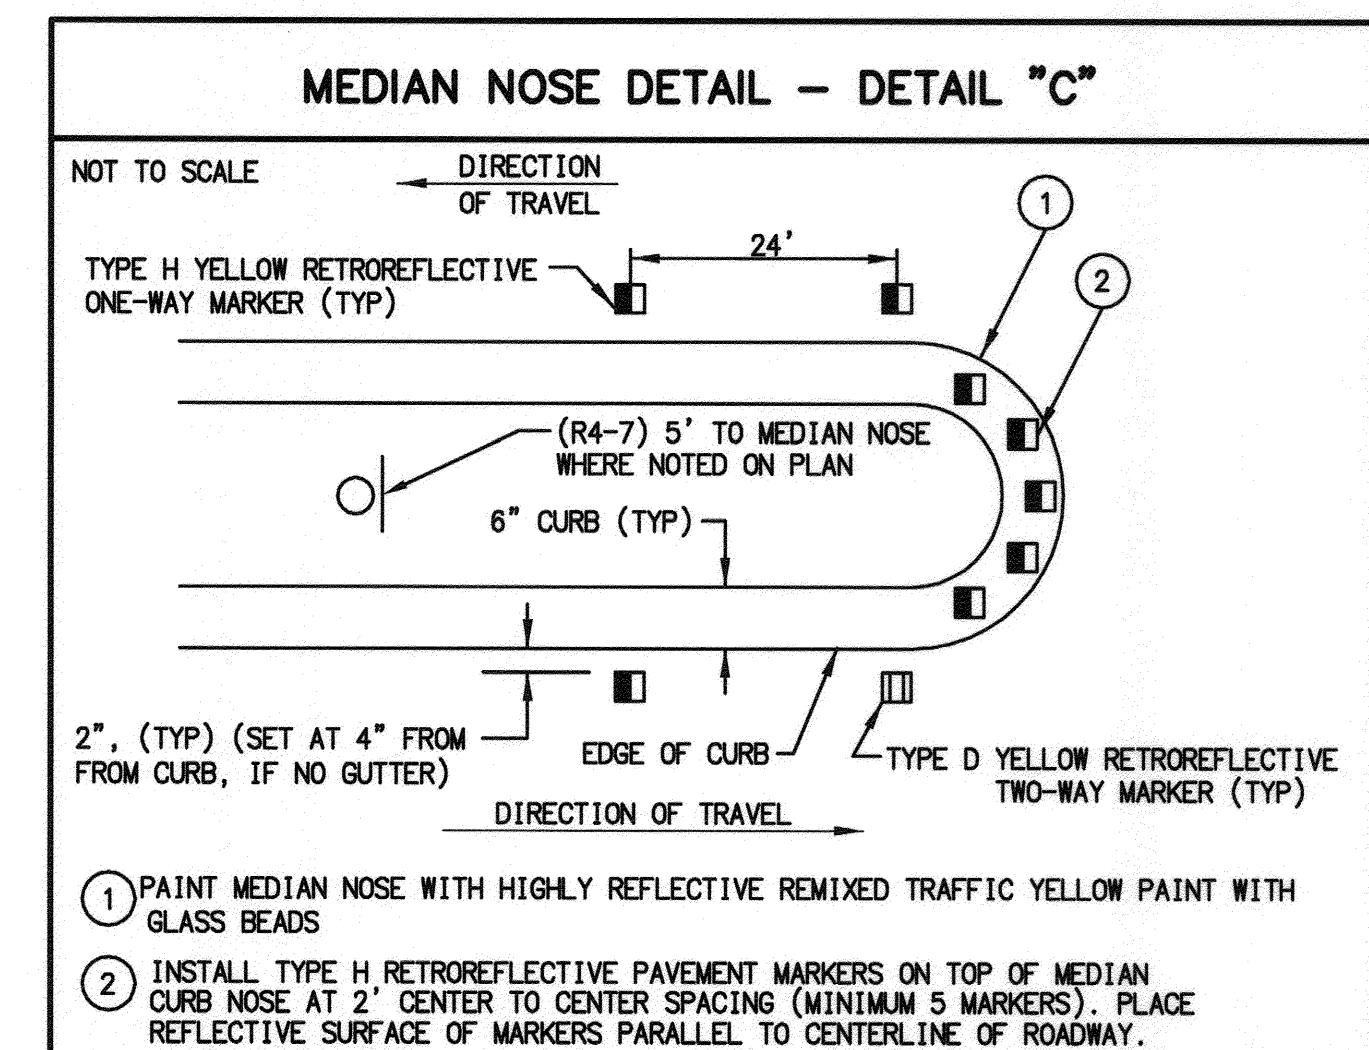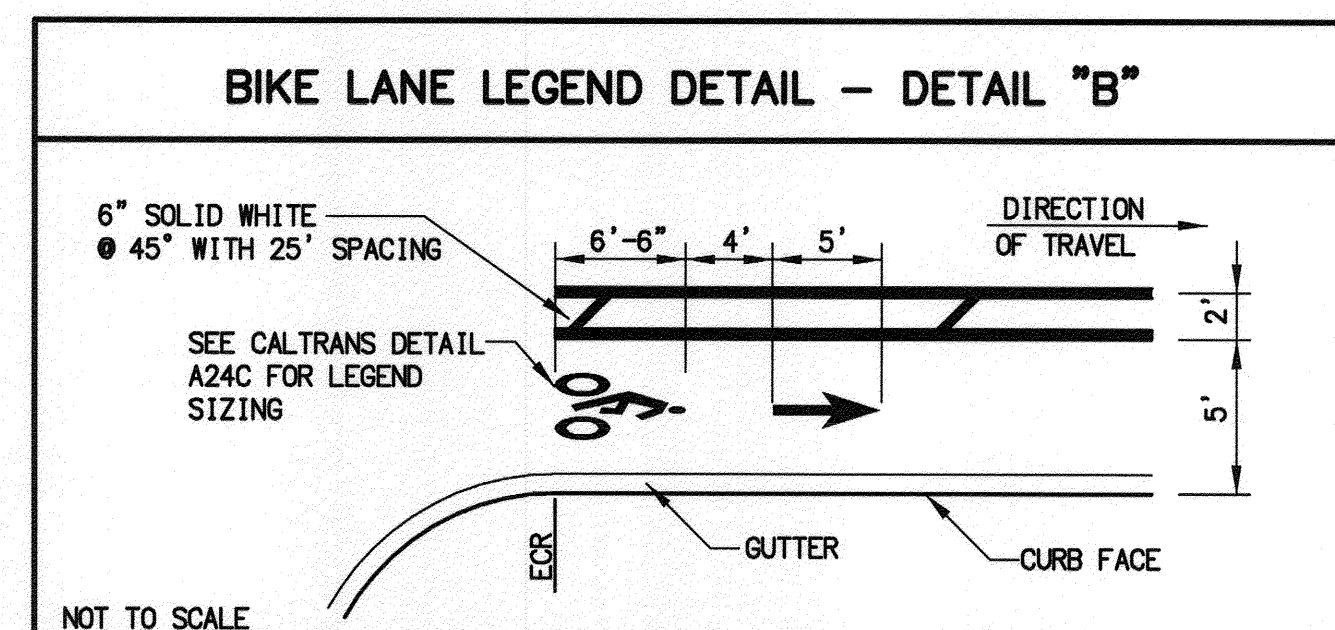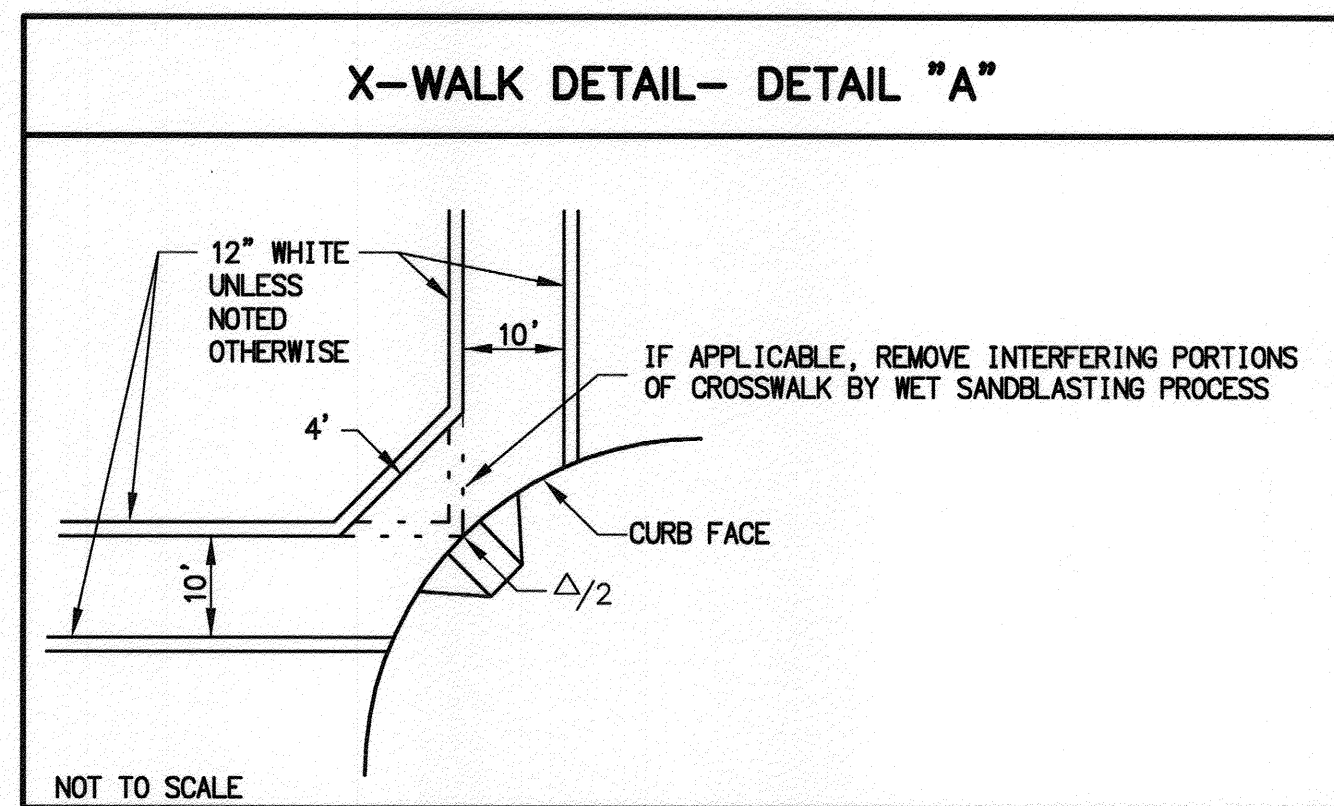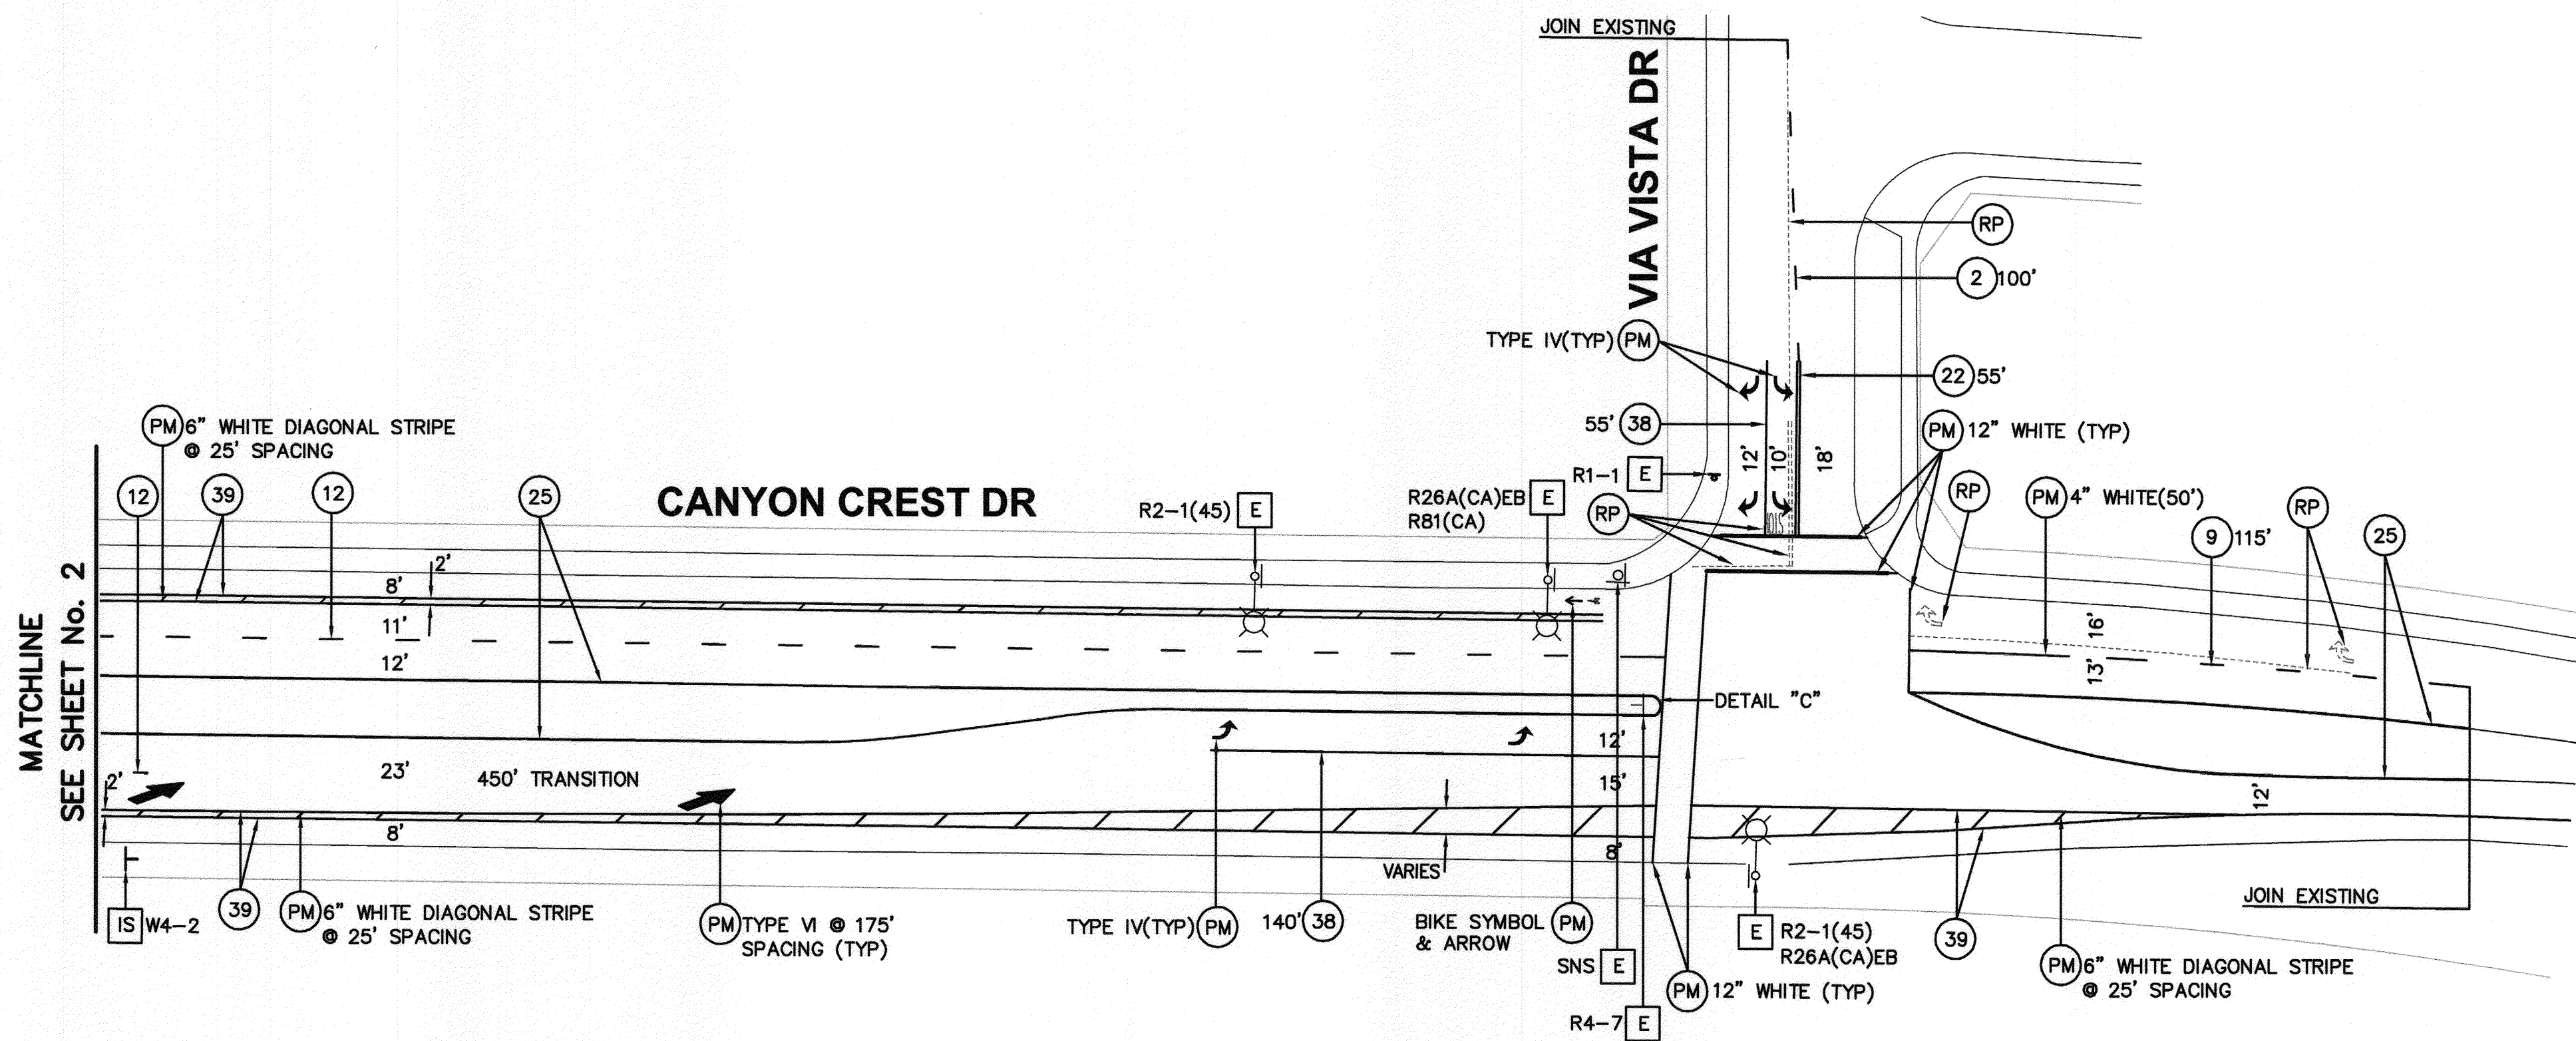

Under Ground Service Alert of Southern California
 Call: TOLL FREE 1-800-227-2600
 TWO WORKING DAYS BEFORE YOU DIG

ENGINEER IN RESPONSIBLE CHARGE
 GILBERT M. HERNANDEZ
 R.C.E. No. 69170 EXPIRES: 6-30-14
 DATE: 8-13-14

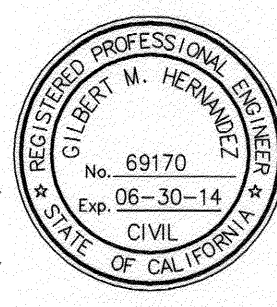

| MARK | REVISIONS | APPR. | DATE |
|------|-----------|-------|------|
| | | | |
| | | | |
| | | | |

CITY OF RIVERSIDE, CALIFORNIA
 DEPARTMENT OF PUBLIC WORKS

| | | | |
|---------------------|----|---------|-----------------|
| APPROVED BY | BY | DATE | APPROVED BY |
| ENGINEERING MANAGER | FM | 8/15/14 | [Signature] |
| PRINCIPAL ENGINEER | | | CITY ENGINEER |
| TRAFFIC DIVISION | DC | 8/22/14 | DATE: 8/22/2014 |
| CONSTRUCTION ADMIN. | | | |
| PUBLIC UTILITIES | | | |

SIGNING AND STRIPING PLAN
 CANYON CREST DR
 FROM ALESSANDRO
 TO VIA VISTA
 SCALE: 1" = 40'

XL-350
 SHEET 3 OF 3
 FILE NAME: XL-350.DWG